ABB	REVIATIONS					SYMBOLS
& L	And Angle	FAB. FAST.	Fabricate Fasten (er)	PEN. PERF.	Penetration Perforate (d)	1 - Key Note Symbol
@ d Ø	At Penny Round	F.D. FDN. F.E.	Floor Drain Foundation Fire Extinguisher	PERI. PG. P.L.	Perimeter Page Property Line	101 — Door Reference
w/ A. A.B.	With Area Anchor Bolt	F.E.C. F.F. F.G.	Fire Extinguisher Cabinet Finished Floor Finished Grade	PL. P.LAM. PLAS.	Plate Plastic Laminate Plaster	TA-10 - Toilet Accessories
ABV. A.C. A / C	Above Asphaltic Conc. Air / Condition	F.H. FILL. FIN.	Fire Hydrant Fillet Finish (ed)	PLUMB. PLYWD. P.N.	Plumbing Plywood Plywood Nails	Symbol Room Name
ACC. ACOUST A.D.	Access Conditioning Acoustic (al) Area Drain	FIXT. F.L. FL. / FLR.	Fixture Flow Line	PNL. PR. PRCST.	Panel Pair Precast	ROOM NAME
ADD. ADD'L. ADJ.	Addendum Additional Adjacent	FLEX. FLSH'G. FLUOR.	Flexible Flashing Fluorescent	PREFAB. PRESS. PRF.	Prefabricate (d) Pressure Preformed	Room Number
ADJT. A.F.F.	Adjustable Abv. Fin. Flr.	F.O.C. F.O.F.	Face Of Concrete Face Of Finish Face Of Masonry	P.S.F. P.S.I. P.T.	Lbs. / Sq. Foot Lbs. / Sq. Inch Pressure Treated	 ⟨D⟩→ Window Reference → (
AGG. ALT. ALUM.	Aggregate Alternate Aluminum	F.O.M. F.O.S. F.O.W.	Face Of Stud Face Of Wall	PT. PTD.	Point(ed) Painted	Revision / Delta Number
ANOD. A.P. APPR.	Anodized Access Panel Approved	F.P. FR. FRMG.	Fireproof (ed) Frame (d) Framing	P.T.D. PVMT.	Paper Towel Dispenser Pavement	PE-1 Finish Symbol
APPROX ARCH. ASPH.	Approximate Architect (ural) Asphalt	F.S. FT. FTG.	Finished Surface Foot, Feet Footing	Q.T. R.	Quarry Tile Riser	Exterior Finish Material Number
AUTO. AVG.	Automatic Average	FURR. FUT.	Furred, Furring Future	R.A. RAD. R.D.	Return Air Radius Roof Drain	P-3 Finish Symbol
B.D. BD. BEL.	Building Dept. Board Below	GA. GALV. G.B.	Gauge Galvanized Grab Bar	REF. REFER. REG.	Reference Refrigerator Register	Material Number Section Number
BIT. BLDG. BLK.	Bituminous Building Block	G.C. GEN. G.I.	General Contractor General Galvanized Iron	REINF. REM. REQ.	Reinforced (ing) Remove Required	X A-5## Sheet Number
BLK'G. BLTUP	Blocking Built-up	GL. GLB.	Glazing, Glass GlueLaminated Beam	RESIL. RET.	Resilient Return	Section Cut Line
B.M. BM. B.N.	Bench Mark Beam Boundary Nailing	GND. GR. GRT.	Ground Grade, Grading Grout	REV. RFG. RFTR.	Revise (ed) Revision Roofing Rafter	Detail Number
BOT. B.P. BRCG.	Bottom Bearing Plate Bracing	GYP. GYP. BD.	Gypsum Gypsum Board	R.H. R.H.B. R.I.	Redhead Bolt Recessed Hose Bibb RoughIn	# A-5##
BRG. BTWN. B.U.R.	Bearing Between Built-up Roofing	H H.B. H.C.	High Hose Bibb Hollow Core	RM. RO. R.O.	Room Rough Rough Opening	Sheet Number
BVL. C	Bevel (ed) Camber	H.D. HD. HDCP.	Heavy Duty Head Handicap	R.O.W. R.S. RWD.	Righť Of Way Resawn Redwood	Elevation
CAB. C.B. C.C.	Cabinet Catch Basin Center To Center	HDR. HDWD. HDWE.	Header Hardwood Hardware	S. S.A.	South Supply Air	T.O.P. Description
CEM. CER.	Cement Ceramic Cubic Feet	HGR. H.M.	Hanger Hollow Metal	S.C. SCHED.	Solid Ćore Schedule	Contraction Datum Symbol
C.F. C.F.M. C.H.B.	Cubic Feet / Min. Concealed H.b.	HORIZ. H.P. HR.	Horizontal High Point Hour	SCR. S.D. SDG.	Screw Storm Drain Siding	1 Interior Elevation Sheet Number
CHAM. C.I. C.I.P.	Chamfer Cast Iron CastInPlace	HT. HTG. HTR.	Height Heating Heater	SEAL. SECT. SEIS.	Sealant Section Seismic	4 # 2
CIR. C.J. C.L.	Circle Control Joint Center Line	HVAC H.W.	Heating, Ventilation, Air Conditioning Hot Water	SEL. S.F. SHT.	Select Sq. Foot / Feet Sheet	3 Elevation Number
CLG. CLK'G. CLR.	Čeiling Caulking Clear	I.D. IN.	Inside Diameter / Dimension Inch(es)	SHTG.	Sheathing Similar Sleeve	Exterior Elevation
CLS. C.M.U. C / O	Closure Concrete Masonry Unit Clean Out	INCL.	Included / Including Information Insulation	SM. SPCG. SPECS	Smooth Spacing	X Number
C.O. COL.	Clear Opening Column	INT. INT. INV.	Interior Invert	SPL. SQ.	Specifications Splash Square	Sheet Number
COMB. COMP. COMPO.		JAN. JST.	Janitor Joist	S.S. S / S S.ST.	Select Str. Service Sink Stainless Steel	
CONC. CONN. CONST.	Concrete Connection Construction	JT. K.B.	Joint Hilti KwikBolt	STAG. STD. STG.	Stagger (ed) Standard Seating	
CONT. CONTR. CORR.	Continuous Contractor Corrugated	KIT. K.PL.	Kitchen Kick Plate	STIFF. STL. STOR.	Stiffener Steel Storage	
CPT. CSK. CTR.	Carpet Countersunk Center	LAG. LAM. LAT.	Lag Bolt Laminated Lateral	STR. SUB. SUSP.	Structural SubContractor Suspended	
C.T. CU. C.YD.	Ceramic Tile Cubic Cubic Yard	LAV. LDGR. LG.	Lavatory Ledger Long	SW.BD. SYM. SYS.	Switch Board Symbol System	VICINITY MAP
D. DBL.	Drain Double	LGTH. L.H.E. L.L.H.	Length Low Hydrogen Electrode Long Leg Horizontal		Tread Top & Bottom	RESORT
DCK'G. DEMO. DEPR.	Decking Demolition / Demolish	L.L.V. L.P. LT.	Long Leg Vertical Low Point Light	TR. T&B T&G TEL. TEMP.	Tongue & Groove Telephone	39
DET. D.F.	Depress (ion) Detail Douglas Fir	LTWT.	Lightweight	THK. THR.	Temper(Ed) Thick(Ness) Threshold	2 2 Garden Grove 2
D.H. DIA. DIAG.	Double Hung Diameter Diagonal	MACH. MAS. MAT'L.	Machine Masonry Material	THRU T. T.O.B.	Through Top Top Of Beam	Westminster
DIM. DISC. D.L.	Dimension Discontinuous Dead Load	MAX. M.B. MECH.	Maximum Machine Bolt Mechanical	T.O.C. T.O.F. T.O.L.	Top Of Curb Top Of Framing Top Of Ledger	ter Midway City
DISP. DN. DIV.	Dispenser Down Division	MED. MEM. MEMB.	Medium Member Membrane	T.O.P. T.O.PVG. T.O.S.	Top Of Parapet Top Of Paving Top Of Sheathing	
DR. D.P. D.S.	Door Dampproofing Down Spout	M. MET. MFR.	Men Metal Manufacture (r)	T.O.SLB. T.O.STL. T.O.W.	Top Of Slab Top Of Steel Top Of Wall	GOLDENWEST
DWG. DWR.	Drawing Drawer	M.H. M.I. MIN.	Manhole Malleable Iron Minimum	T.S.G. TYP.	Tapered Steel Girder Typical	SOUL SOUL
E. EA. E.B.	East Each Expansion Bolt	MIRR. MISC. MLDG.	Mirror Miscellaneous Moulding	U.B.C. UNF. U.N.O.	Uniform Building Code Unfinished Unless Noted Otherwise	18700 Ward Street
E.F. E.J. EL.	Each Face Expansion Joint Elevation	MLDO. M.O. MT. MTD.	Masonry Opening Mount Mounted	UNREINF.	Unreinforced Urinal Utility	(39) Orange Coast
ELECT. ELEV.	Electric (al) Elevator	MULTI.	Multiple	VAR. V.B.	Varies Vapor Barrier Vitragua Clay Ding	T College 55 U
E.N. ENCL. E.	Edge Nailing Enclosure East	N. NAT. N.G.	North Natural Natural Grade	V.C.P. VERT. V.G.	Vitreous Clay Pipe Vertical Vertical Grain	Beach Ne Bay
EA. E.B. E.F.	Each Expansion Bolt Each Face	N.I.C. NO. NOM.	Not In Contract Number Nominal	VNR. VOL. V.T.	Veneer Volume Vinyl Tile	D COBTA MESA Costa Mesa
E.J. EL. ELECT.	Expansion Joint Elevation Electric (al)	N.S. N.T.S.	Near Side Not To Scale	V.T.R. W	Vent Thru Roof West	1 Newport
ELEV. E.N. ENCL.	Elevator Edge Nailing Enclosure	O / O.A. OBS.	Over Overall Obscure	W / W / C WD.	With Water Closet Wood	Beach
ENG. EQ. EQUIP.	Engineer Equal Equipment	O.C. O.D. OFD.	On Center Outside Dia. / Dim. Overflow Drain	WDW. W.H. WH.	Window Water Heater Wall Hung	Balboa Pier 😳
EGOII E.S. EST. E.W.	Each Side Estimate Each Way	OFS. O.H. O.H.D.	Overflow Drain Overflow Scupper Overhead Overhead Door	W.I. W / O W.	Wrought Iron Without Women	
EXH. EXIST.	Exhaust Existing	O.H.D. OPG. OPP.	Opening Opposite	WP. W.R.	Waterproof (ed) (ing) Water Resistant	
EXP. EXPO. EXT	Expand Expose (d) Exterior	PAR. PART.	Parallel Partition	WSCT. WT. WTH.	Wainscot Weight Width	
(0.L.	Óccupant Load)	P.C. P.C.F.	Pipe Column Lbs. / Cubic Feet	YD.	Yard	


MUNICIPAL WATER DISTRICT OF ORANGE COUNTY

18700 WARD STREET

FOUNTAIN VALLEY, CALIFORNIA 92708

ADMINISTRATIVE BUILDING - SEISMIC RETROFIT, ADA COMPLIANCE AND TENANT IMPROVEMENT

	PROJECT DIRECTOR	Y	PROJECT INFORMAT	ION		SHEET IN	DEX	
	OWNER: Municipal Water District of Orange County		TITLE: Municipal Water District of Or				IBERDRAWING DESCRIPTION	
Wall Type Symbol		18700 Wards st, Fountain valley, CA 92708 Street Address City, State & Zip Tel: 714.963.3058 Contact: Cathy Harris	ADDRESS:	Administration Build Compliance 18700 Ward Street Fountain Valley, Ca	ling Seismic Retrofit, ADA lifornia 92708	ARCHITECTUR G-001 G-002	Cover Sheet General Notes	
Wall Type Number		Contact: Cathy Harris Email: charris@MWDOC.com	CONSTRUCTION CLASSIFICATIO	ON: VB		G-003 G-004 G-005	Accessibility Notes Accessibility Notes Accessibility Details	
Grid Letter	ARCHITECT OF RECORD:	IDS Group John Silber 1 Peters Canyon Road, Suite 130 Irvine, California 92606	OCCUPANCY CLASSIFICATION:	B & A		G-006 A-101 A-102	Exit & Occupancy Analysis Demolition Site Plan Site Plan	
Grid Number		Tel: 949.387.8500 X 156 Contact/PM: ANNIE N. BACTOL Email: ANNIELYN.BACTOL@ idsgi.com	SPRINKLERS:	FULLY SPRINKLE)	A-103 A-104 A-105	Enlarged Site Plan Proposed Phasing Plan Life Safety Plan	
Grid Line	STRUCTURAL ENGINEER:	IDS Group DR. SAID HILMY	NUMBER OF STORIES:	1		A-106 A-107 A-108 A-108.1	Demolition Floor Plan New Work Floor Plan Demolition Reflected Ceiling Plan Demolition Seismic Retrofit Plan	
	MEP ENGINEER:	1 Peters Canyon Road, Suite 130 Irvine, California 92606 IDS Group	PROJECT AREA:	13,421 SF.		A-108.1 A-109 A-110 A-111	New Work Reflected Ceiling Plan Furniture Layout Plan Finish Floor Plan	
		Rob O'Neil 1 Peters Canyon Road, Suite 130 Irvine, California 92606	TOTAL AREA:	13,421 + 296 = 13,7	717 SF.	A-201	Interior Elevations, Door and Finish Schedules	
	AUTHORITY HAVING JURISDICT	TION (AHJ) : CITY OF FOUNTAIN VALLEY	APPLICABLE CODES			A-401 A-402	Enlarged Floor Plan Enlarged Reflected Ceiling Plan	
			LEGAL JURISDICTION: CIT	Y OF FOUNTAIN VALLE	Y	A-403 A-501	Enlarged Floor Plan Details	
				 16 California Code of Re 16 California Building State 16 California Building State 	egulations andards Code (Title 24) andards Administrative Code	A-502 A-503 A-504 A-505	Details Details Details Details	
	CONCURRENCE BY:		20 [°] 20 [°]	 16 California Building Co 16 California Electrical C 16 California Mechanical 	ode code	STRUCTURAL T0.0	Cover Sheet	
			20 ⁷ 20 ⁷	16 California Plumbing C16 California Energy Coo16 California Fire Code	Code	S1.0 S1.1 S2.2	General Notes General Notes Roof Framing Plan	
			20	16 California Existing Bui16 California Green Build16 California Reference S	ing Code	S2.3 S3.1 S5.1 S5.2	Existing Fire Sprinkler Plan Corner Blocking Plan Details and Sections Details and Sections	
	PROPERTY OWNER		THIS PROJECT SHALL COMPLY		EQ	S5.3	Details and Sections	
	FIRE ALARM / FIRE S	PRINKLER	SCOPE OF WORK		со.	MECHANICAL M-001 M-002 M-201 M-202	Mechanical General Notes, Legend, and Abbreviations and Sheet Index Mechanical Schedules Demolition Floor Plan New Floor Plan	
	-WILL BE SUBMITTED SEPARA		SEISMIC RETROFIT AND TENA			M-202 M-401 M-801 M-802	Details Title 24 Title 24	
	AS STANDPIPES, SPRINKLER		MUNICIPAL WATER DISTRICT ADMINISTRATION BUILDING (MIMPROVEMENTS-TO IMPROVE	MWDOC). NON STRUCTU	MANCE	ELECTRICAL		
	SYSTEMS, MUST BE SUBMITT AND APPROVED BY THE FIRE EQUIPMENT IS INSTALLED.	ED TO THE BUILDING DIVISION DEPARTMENT BEFORE THIS	OF LIMITED NON-STRUCTURA UPGRADE OF BRACING, SUPP DEMOLITION OF WALLS, CEILI	PORTS, OR RESTRAINTS	S. CTRICAL.	E-001 E-002 E-003	General Notes, Abbreviations, Symbols, List and Sheet Index Single Line Diagram Panel Schedule Demolition Power Plan	
			NEW PARTITIONS FINISHES, E	LECTRICAL AND CEILIN	IGS.	E-101 E-102 E-201 E-202	Demolition Fower Flan Demolition Lighting Plan Power Floor Plan Lighting Plan and Lighting Fixture Schedule	
						E-401 E-402 E-403	Photometric Calculation Emergency Photometric Calculation Lobby Photometric Calculation	
						E-600	Title 24 Indoor Compliance Forms	
	LOCATION MAP		OCCUPANCY LOAD C	CALCULATIONS		P-001 P-401	Plumbing General Notes Plumbing Enlarged Plan	
5	Samias mais on	Sano	6049 SF 10	ODE PER. 10 GROSS	OCCUPANT LOAD 82 PERSONS			
Orange 55 El M	Sloux River Cir	Chefs' Toys Pountain Valley		GROSS	140 PERSONS			
	Placer River Cir	Ellis Ave Ellis Ave	1540 SF TOTAL BLDG AREA = 13,421SF					
Santa Ana Tustin			TOTAL OCCUPANTS = 180 PEF TOTAL OCCUPANT LOAD (CBC TABLE 1104.1.1) = 222 PE					
	Antonio St PROJECT	Orange County O Alaska Ave						
55 Dill Destroy		Califo						
Bill Barber Metreo John Wayne Airport Irvine	a. St	a dua Blue						
Print Irvine		and A						
Upper T3 University Newport Of California	San Antonio St							
Preserve Furthe Furthe								
NEWPORT								
CENTER San Joaquin Hills								
DEL MAR NEWPORT COAST								
N		N						

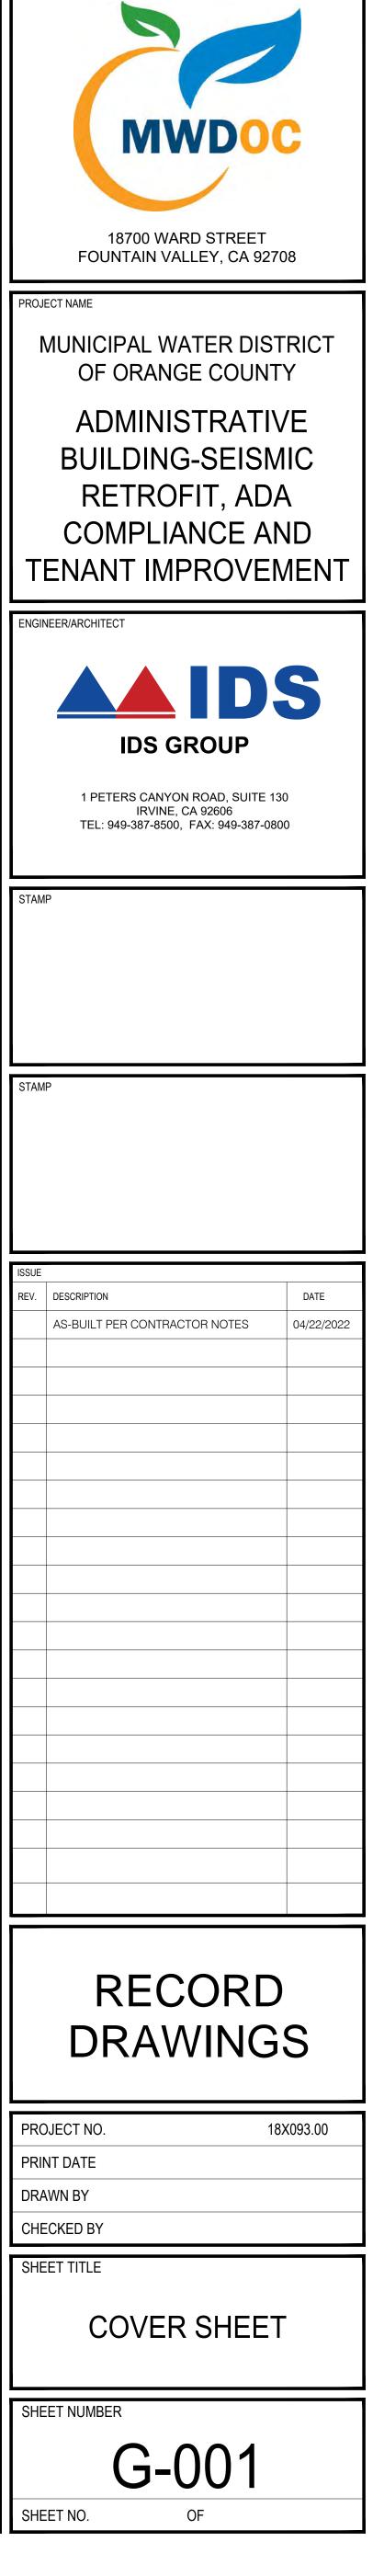

18. FIELD APPLICATION OF PEDESTRIAN PROTECTION

Construction activities including additions, alterations, and demolitions shall provide pedestrian protection pursuant to section 3306 of the California building code. To determine the type of protection required for pedestrians, measure the ultimate height of construction with consideration for building setbacks and projections from the building. For sloping sites, measure the height of the building from construction edge of the walkway and the setback distance between the walkway and the building line.

Below are requirements to be addressed in the design of pedestrian protections:

Walkways shall provide sufficient width with the minimum of 4 ft. Clear.

- Directional barricades shell be provided as needed where the walkway extends into the street.
- Construction railings shall be at least 42 inches in height.
- Barriers shall be a minimum of 8 ft. In height and be designed to resist loads required.
- Such protection shall be maintained in place and kept in good order. Until work is completed.
- Whenever a walkway must extend into the roadway, a railing is required on the street side.

INSTRUMENTS OF SERVICE 16.

project, such as: models

sketches and drawings

specifications The instruments of service are also known as design documents and construction documents.

According to the Architect's Practice Act, Business and Professions Code section 5536.4, no person may use an architect's instruments of service, as those professional services are described in paragraph (2) of subdivision (b) of section 5500.1, without the consent of the architect in a written contract, written agreement, or written license specifically authorizing that use.

The plans and specifications are complimentary and intended to convey the design intent of the project. They are not intended to supplant the general contractor's construction expertise, and, in fact, rely on the contractor to clarify and/or obtain any elements of needed information PRIOR to the submission of a bid. The contractor's bid shall be assumed to include the sufficient costs to construct all work shown on the documents, whether or not adequately described in the documents, in order to provide the owner a safe, complete and fully functional project.

The scope of this project is as generally depicted in these instruments of service as part of the contract documents. Work including: points of connection, not specifically depicted, that need to be made are the responsibility of the general contractor. All work performed even in remote areas of the building or site, pertaining to this project shall comply with the intent of contract documents.

These contract documents cover the furnishing and installation of materials and work as called for on the drawings or in the specifications (or in both) which are bound separately and are a part of the contract. It shall be the responsibility of each contractor to check with the architectural drawings before finalizing their bid and before the installation of their work. Any discrepancy between the architectural and the consulting engineer(s) drawings shall be brought to the architects attention by written request for clarification. Any work installed in conflict with the architectural drawings shall be corrected by the contractor at his own expense and at no expense to the owner or architect.

General requirements, describing the project's administrative requirements and the physical aspects of construction, are provided within each professional discipline's project specification and general notation. General requirements are not limited to the instrument of services and may extend to the contract documents and owner requirements.

The project specifications consisting of the written requirements for material, equipment, systems, standards and workmanship for the work, and performance of related services are contained within each of the architect and the architect's instrument of services. Refer to general notes for additional project standards information. Documents indicated as 'reference document' are not considered instruments of services and are being issued to provide assistance during the regulatory agency contract document review.

Refer to life safety and accessibility diagrams that indicate provisions within existing conditions.

These drawings are based on field observation and/or documents furnished by the owner. The architect shall be notified immediately by the contractor of any discrepancies or other questions pertaining to the contract documents. If obvious omissions or contradictory situations in the contract documents are discovered to exist, they should be immediately called to the attention of architect for clarification.

All dimensions take precedence over scale unless otherwise noted by a plus/minus dimension. Contractor shall check accuracy of dimensions on plans with actual field dimensions. The contractor shall report to the architect all conditions which prevent the proper execution of its work. Contractor shall not start any construction or any off-site fabrication of materials until the drawings dimensions are verified with actual field conditions. Do not scale drawings.

The contractor shall be held responsible for the results of any errors discrepancies or omissions that the contractor failed to notify the architect of before construction and/or fabrication of the work.

Work includes demolition, removal and reinstallation where required. Remove, revise, relocate and reinstall as required.

It is not the responsibility of the architect or general contractor to insure that areas of the building, not described within the scope of this project, comply with current building codes. It is the responsibility of the owner to maintain the building, so as to provide for the safety and comfort of the occupants. This includes all life safety features such as fire alarm, fire-sprinklers, nurse call, exit enclosure, accessibility, etc.. This also includes maintaining the building free of hazardous materials i.e., chemicals as described by state or federal agencies as 'hazardous' including asbestos.

HAZARDOUS MATERIALS

The removal of hazardous materials is not intended to be included as part of this project unless specifically noted otherwise.

If hazardous materials are discovered during the course of construction, the contractor shall stop all affected work and notify the owner and architect immediately

The Instruments of Services are any expression, whether tangible or intangible, of creative worked performed by a design professional for a

14.	COORDINATION OF DEVICES	8
A.	Exact locations and heights of electrical, low voltage, mechanical and plumbing devices, including but not limited to smoke detectors, pull stations, switches, outlets, phone jacks, and thermostats, shall be coordinated by the contractor per the applicable code for alignment and	A.
	coordination with each other and other building features prior to	В.

installation

15. CONTRACTOR OBLIGATIONS Contractor for the project shall be responsible for obtaining all required building permits prior to commencing work. The contractor shall insure that all work is done in a professional work-man-like manner by skilled mechanics and shall replace any new and/or existing materials or items indicated to remain damaged by any cause during construction. The contractor and/or subcontractor shall, prior to the submission of their bid or performance of work, notify the owner of any work called out on the drawings or in the specifications in their trade that cannot be fully guaranteed or warranted from defective workmanship or material defects The contractor shall notify the architect if details are considered unsound, unsafe, not waterproof, or not within customary trade practice. If work is performed, it will be assumed that there is no objections to the detail. Details are intended to show end result of design, minor modifications may be required to suit job conditions and current trade practice and shall be included as part of this project.

Contractor shall be responsible for all finishes at point of connections for all work (architectural, structural, mechanical and electrical) finishes will match those specified or existing in line, texture and finish. Spot painting is not acceptable. New finishes shall be from corner to corner, floor to ceiling, etc.

- Unless otherwise noted, all materials shall be new and of good quality. Where existing materials are indicated to be salvaged, contractor shall inventory, clean,box protect, and store items for reuse on the project. Items not reused shall be returned to owner.
- Coordination: the general and each sub-contractor shall be responsible for verification and coordination with other sub-contractors to assure compliance with drawings and specifications, and the accurate location of architectural, structural, mechanical and electrical building elements Their required openings clearances support systems are all interconnected and coordinated.
- Contractor shall be responsible for coordinating the work of all trades and for being aware of all conditions that affect their work. Notify owner, in writing, within 3 working days of award of contract, of the proposed delivery schedule, of any equipment, finishes or material, for which that schedule will prevent the installation from being completed at the time of the scheduled project completion.
 - Coordination of work: the contractor shall provide and coordinate the exact dimensions sizes and positions of all systems, equipment, mounting, and attachments relating to the work.
 - the contractor shall provide and coordinate all dimensions sizes and positions of openings in slabs and walls necessary the installation of the work.
 - all equipment, controls and terminations shall be positioned for safe, direct and easy access.
- The contractor shall verify all dimensions and conditions of existing site. The contractor shall report to the architect all conditions which prevent the proper execution of its work. The drawings shall not be scaled.
- Construction shall comply with applicable edition of California Building Code, all applicable local, state and federal codes, ordinances, laws, regulations and protective covenants governing the work. In case of conflicts, the more stringent requirement shall govern.
- General contractor to arrange inspections as necessary or required.
- All contractor's work shall be of the quality to pass inspections by local and state authorities, lending institutions, the architect and his engineers, inspector of record, and owner. Any one or all of the above mentioned inspectors may inspect trade(s) at any time, and any corrections needed to meet the required quality of construction shall be done immediately after notifying the architect and the owner for approval.
- The contractor/sub contractors shall inspect the site prior to start of construction and notify owner and the architect of any existing conditions that may affect the work including elements that may be subject to damage during demolition and renovation. The contractor shall field verify existing dimensions, prior to start of construction and notify owner and architect of any discrepancies between the existing dimensions and the drawing dimensions that may affect the work. The contractor shall obtain direction from owner on resolution of the discrepancies between the existing conditions and dimensions and drawings prior to starting any work that may be affected by such discrepancies.
- Cleanup: typically each subcontractor is held responsible for cleanup of the work of their trade by the general contractor. However, the general contractor shall be held solely responsible for continuous cleanup as the job progresses, and final cleanup upon substantial completion. The contractor shall be responsible for cleaning up and removing from the job site all trash and debris, immediately upon completion of his daily work. Continuous cleanup shall keep the job free at all times from unreasonable buildup of debris, wrappers, containers, waste materials, etc., which may cause accidents, undue hardship on the tradesman, and work progress. Final cleanup includes cleaning of all surfaces to a 'like new' condition and preparing the building for its intended use.
- The contractor shall at all times maintain the site and adjacent areas in a clean, neat, and orderly manner. The contractor shall be responsible only for debris that is a result of the work, including any that may result from the workers. The contractor shall be responsible for providing his own refuse containers and shall at no time use the building refuse containers.
- The contractor shall be responsible for the complete security of the site Q. while the job is in progress and until the job is completed.
- Contractor shall provide a portable fire extinguisher with a rating of not less than 2-a or 2-10bc within 75 feet of travel distance to all portions of the build out area during construction.
- Obtain all cal / OSHA construction activity permits, prior to obtaining the building permit, as required by and in accordance with applicable codes.
- Demarcate and notify the regional notification center (Dig Alert, 811) at least two working days prior to making any excavations
- Contractor will need to have the fire suppression inspected, and any necessary supplemental seismic bracing and stamped by a certified fire protection engineer per city fire department requirements.
- Contractors scope of work for their sub-contractor to review and address any outstanding issues and or work items related to the structural and non structural works and tenant improvement and obtain approval from the city authority for that work.

		4
8. EXITS		1
	f the pivoted or side-hinged swinging type. Exit doors rection of exit travel when the area served has an or more.	A.
•	Il be openable from the inside without the use of a key ledge or effort. Note also that flush bolts or surface	_
	ll be provided on exit doors of rooms, corridors, an occupant capacity of 50 or more persons.	B.
÷	stalled at required exit doorways and where otherwise indicate the direction of egress in compliance with the	C.
door shall swing to t	be set in motion when subjected to a 30lb. force. The he fully open position when an opening force not applied to the latch side.	D.
	ns of egress from a group 'a' occupancy shall not be n or lock unless it is panic hardware or fire exit 0.1.9).	E.
H. Door handles, lock a 34" and a max. 48" a	and other operating devices shall be installed at a min. a.F.F.	F.
5	onnected to an emergency power system that will on of not less that 90min. in case of primary power	
Ţ.	s, including the exit discharge, shall be illuminated at g space served by the means of egress is occupied.	2 A.
9. FIREPRO	OFING	В.
A. Fire protection of strue regulations.	ctural members shall be in compliance with state	3
B. Steel fireproofing thicl the CBC .	ness shall be in compliance with the current edition of	A.
fireproofing to the req and Tests. The inspec	hall be provided for all required sprayed-on uirements of CBC Chapter 17a Special Inspections ctor shall submit a signed affidavit that all sprayed-on quired, is applied according to code and cations.	4
10. RATED A	SSEMBLY PENETRATIONS	Α.
be correspondingly etc. Recessed into	tc. Penetrating fire-rated ceilings and fire walls shall rated or dampered. Cabinets, electrical panels, lights, fire rated walls or ceilings shall be backed with esistive construction as required to maintain the rotection.	В.
CBC.Penetration of	blies for protection of openings shall comply with fire rated assemblies which require opening protection . Fire stopping shall be identical to an approved	C.
Penetrations must a penetrations fire sto	ories (UL) listed assembly with an "f" of "t" rating. Iso consist of approved materials for through wall p systems as prescribed in CBC standard 7-5 fire	D.
rating for fire stop sy	stems shall be equal to the assembly penetrated.	E.
		F.
		G.
11. DISSIMIL	AR METALS	
	shall be effectively isolated.	5.
12. FI FCTRI	CAL BACKBOARDS	A.

Refer to

location plywoo These archited overall 13. SIGNAGE Furnish and install supports and other necessary finish materials for a Α. complete signage installation. Accessible signage / identification 1. The international symbol of accessibility shall be the standard used to identify facilities that are accessible to and useable by physically disabled persons.

> 3. Characters and symbols shall contrast with their background, either light characters on a dark background or dark characters on a light background.

4. All building entrances that are accessible to and usable by physically handicapped persons shall be identified with at least one standard sign and with additional directional signs as required to be visible to persons along approaching pedestrian ways.

5. All sanitary facilities will be provided with appropriate identification svmbols.

Area and occupancy signage requirements occupant load sign shall be posted in each classroom, assembly room or similar purpose room having an occupant load of 50 or more.

12. ELECTRICAL BACKBOARDS

o electrical, telephone/data and security electronics drawings for
n of and specifications for the installation of fire retardant treated
d backboards required in electrical and communication rooms.
required plywood backboards have not been shown on the
ctural drawings, but must be furnished and installed as a part of the
contract. Backboards shall be painted white.

2. Letters and numbers on signs have a width to height ratio of between 3:5 and 1:1 and stroke width to height ratio of between 1:5 and 1:10.

GENERAL

All work shall conform to contract documents. No cha	anges therefrom shall
be made without written approval of the architect. W	/here more
information or when an interpretation of the contract	documents is needed,
the contractor before proceeding with work, shall refe	er the matter to the
architect who will furnish information or interpretation	n in the form of
supplemental information or other written form or dra	awing.

Where only part of the work is indicated, similar parts shall be considered repetitions. Where any detail is shown and the components are described elsewhere, similar details shall be constructed as described in the original details.

Drawings are generic in nature. Contractor shall fully coordinate all aspects of the work to be performed. Details are not intended to show method and manner of accomplishing the work.

- All dimensions originating at, connected to, or continuing through existing conditions, including previous phases, must be coordinated and field verified by the contractor prior to fabrication installation, and construction of building elements or systems.
- Verify all dimensions, elevations, and all existing conditions at the site before commencing work and report any discrepancies to the architect and owner.

Should a conflict be discovered within the contract documents, the contractor shall be deemed to have included in his work the highest quality way of doing the work unless he shall have asked for and obtained a decision in writing from the architect and owner.

CODES

All construction is to comply with the applicable codes as adapted by the regional, state, and national authorities having jurisdiction.

For list of codes applicable to this project, see 'applicable codes' on cover

PERMITS

The contractor shall procure all permits, and licenses required for the completion of the work. The cost of these notices, permits, and licenses is incidental to other items of work and no additional payment will be made for costs incurred in obtaining notices, permits, and licenses or in conforming to the requirements thereof.

COORDINATION & VERIFICATION

- The drawings are divided into separate sheets and the project manual into separate sections for general convenience only. Sheet designation or numbers shall not be considered to limit areas of the work or responsibility of trades. Coordinate the work shown on the drawings and in the project manual in order to complete the project as designed.
- Verify all sizes of and prepare work for equipment of others and coordinate work on this contract with items of work not in contract (N.I.C.) or work furnished by others.
- Locations and sizes of equipment are based on available information. Provide and coordinate the exact dimensions, sizes, and positions.
- Provide and coordinate the exact dimensions, sizes and positions of openings in slabs and walls necessary for the installation of the work.
- Provide reinforcing steel, mesh, and dowels required by the structural general notes and drawings for architectural details indicated on the architectural drawings.
- Quantities indicated on the drawings are approximate. Contractor shall verify quantities and include accurate quantities as part of the work.
- Notes and details: specific notes or keynotes on details apply to similar conditions on other details on all drawings unless specifically noted otherwise

UTILITIES AND DEMOLITION

The drawings show diagrammatically the approximate location of underground utilities where information is available, but the drawings are not exact as to the quantity, extent or location.

- Prepare surfaces of floor areas which have finishes demolished to receive new finish material as specified.
- For additional demolition requirements, see specifications.

DIMENSIONS

6.

D

F.

G.

Overall dimensions are to face of finish, and/or nominal face of masonry unless noted otherwise.

- Elevations and vertical dimensions are to top of finish floor material. Thickness of all floor finish material must be fully coordinated.
- Grid line to center of column.
- Dimension to center of column & grid line.
- Exterior dimensions are from face to face of concrete stem walls.
- Interior dimensions are from finish to finish.
- Do not scale drawings.

FIRE PROTECTION

The contractor shall provide portable fire extinguishers as required by code, and authority having jurisdiction, at all portions of the building on each floor. These extinguishers shall be installed in the locations approved by the fire department and the architect.

Where testing laboratory design numbers are listed for fire rated construction, the components and installation details must conform with the design number specified.



CLEAR FLOOR SPACE FOR WHEELCHAIRS

- Minimum clear floor or ground space required to accommodate a single, stationary wheelchair and occupant is 30" x 48". Minimum clear floor or ground space for wheelchairs may be positioned for forward or parallel approach to an object. Floor or ground space for wheelchairs may be part of the knee space required under some objects.
- 2. Provide an additional 12" width on one side for alcoves greater than 15" deep and designed for side approach.
- 3. Provide additional 6" width on one side for alcoves greater than 24" deep and designed for front approach.

HAZARDS AND PROTRUDING OBJECTS

- Objects projecting from walls with their leading edges between 27" and 80" above the finished floor shall protrude no more than 4" into walks, halls, corridors, passageways or aisles.
- Objects mounted with their leading edges at or below 27" above the finished floor may protrude any amount.
- Free standing objects mounted on posts or pylons may overhang 12" maximum from 27" to 80" above the ground or finished floor.
- Protruding objects shall not reduce the required clear width of an accessible route or maneuvering space.
- Any obstruction overhanging a pedestrian way shall be a minimum of 80" above the walking surface as measured to the bottom of the obstruction.

WALKS AND SIDEWALKS

- Walks and Sidewalks shall have a continuous common surface not interrupted by steps or by abrupt changes in level which exceed 1/2", and shall be a minimum of 48" width.
- Surface cross slope shall not exceed 1/4 inch per foot.
 Walks, sidewalks, and pedestrian ways shall be free of grating whenever possible. Grid openings within gratings located in the surface of any of these areas shall be limited to 1/2" in the direction of the traffic flow.
 When the slope in the direction of travel of any walk exceeds 1 vertical to 20

horizontal, it shall comply with the provisions of pedestrian ramps.

ENTRANCES / DOORS

- 1. All primary entrances and exterior ground floor exit doors to buildings and facilities shall be made accessible to the physically disabled
- 2. All accessible entrances shall be identified with at least (1) standard sign and with additional directional signs, as required, visible from approaching pedestrian ways.
- 3. Every required entrance or passage doorway shall be of a size as to permit the installation of a door not less than 36" in width, and not less than 80" in ht. Doors shall be capable of opening at least 90 degrees and shall be mounted so that the clear width of the doorway is not less than 32". Latching and locking doors that are hand activated and which are in a path of travel, shall be operable with a single effort by lever type hardware, panic bars, push pull.
- 4. Activating bars, or other hardware designed to provide passage without requiring the ability to grasp the opening hardware. Lever hand activated door opening shall be centered between 30" and 44" maximum above the floor.
- 5. The floor or landing length on each side of an entrance or passage door shall be level and clear at least 60" in the direction of the door swing, and at least 48".
- 6. Opposite the direction of the door swing as measured at right angles to the face of the door in the closed position. The side of the level and clear area on the side which the door swings shall extend a minimum of 18" (24" at exterior doors) past the strike edge of the door for doors with front approach, 24" for doors requiring latch side approach, and 36" for doors with hinge side approach. Refer to detail no. 3 on this drawing for additional clearance requirements
- 7. The floor or landing shall not be more than 1/2" lower than the threshold of the doorway. Changes in level between 1/4" and 1/2" shall be leveled with a slope not greater than 1:2.
- 8. The bottom 10" of all doors (except automatic and sliding) shall have a smooth uninterrupted surface to allow the door to be opened by a wheelchair foot rest without creating a trap or hazardous condition. Where narrow frame doors are used, a 10 inch high smooth panel shall be installed on the push side of the door, which will allow the door to be opened by a wheelchair footrest.
- 9. Maximum effort to operate doors shall not exceed 5 pounds for exterior doors and 5 pounds for interior doors. Such pull or push effort being applied at right angles to hinged doors and at the center plane of sliding or folding doors. Compensating devices or automatic door operators may be increased to the minimum allowable by the appropriate administrative authority, not to exceed 15 pounds. CBC section 1133b. 2. 5
- 10. All hand activated door opening hardware shall meet the following requirements:A. Shall be centered between 30" and 44" above the floor
- B. Latching and locking doors shall be operated with a single effort by lever type hardware, panic bars, push - pull activating bars or other hardware designed to provide passage without the ability to grasp.
- 11. Thresholds shall not exceed 1/2" in height.
- 12. The tenant space, a primary entrance to the building, the primary path of travel from the entrance to the tenant space and the sanitary facilities, drinking fountains and public telephones serving the tenant space must be accessible to the handicapped.
- 13. Food service aisles shall be 36" minimum clear width with a preferred width of 42" where passage around stopped wheelchairs by others is desired.
- 14. Entrance (s) to the building or facility and the primary path of travel to the specific area of new work, alteration, structural repair or addition shall be accessible. Path of travel incorporated all elements from the exterior arrival site to the remodeled area. Section 1114b.1.2 and 1114b.1.3.

EXIT / MEANS OF EGRESS notes

- 1. a. Exit signs shall be internally or externally illuminated.
- Internally illuminated exit signs shall be listed and labeled and shall be installed in accordance with manufacturer's instructions and section 2702.
- c. Externally illuminated exit signs shall comply with the graphics and power source requirements in sections 1011. 5. 1 and 1011. 5. 3, respectively. When the face of an exit sign is illuminated from an external source, it shall have an intensity of not less than 5 foot candles (54 lux) (1011. 2) exit signs shall be located so that they are clearly visible.
- 2. Exit signs shall be illuminated at all times. (1011.3)
- 3. Any time a building or a portion of a building is occupied, the means of egress serving the occupied portion shall be illuminated at an intensity of not less than 1 foot candle (54 lux) at the walking surface level.
- 4. The power supply for means of egress illumination shall be provided by the premise's electrical supply. In the event of power supply failure, illumination shall be automatically provided from an emergency system for aisles and unenclosed egress stairways in rooms and spaces that require two or more means of egress.
- 5. The EXIT sign shall also be connected to an emergency electrical system which is to provide continued illumination for a duration of not less than 1 1/2 hours in case of primary power loss. Continued illumination is to be provided from storage batteries, unit equipment, or an on site generator and the installation of the emergency power system shall be installed in accordance with Chapter 27. (1006.3)
- Emergency lighting facilities shall be arranged to provide initial illumination that is at least an average of 1 - foot - candle (11 lux) and a minimum at any point of 0.1 foot - candle (1 lux) measured along the path of egress at floor level. A maximum - to - minimum illumination uniformity ratio of 40 to 1 shall not be exceeded. (1006.4)
- 7. Exit signs shall be connected to an emergency power system that will provide an illumination of not less than 90 min. In case of primary power loss (1011.6.3).
- 8. Egress doors shall be readily openable from the egress side without the use of a key or special knowledge or effort. See 1008.1.9 for exceptions.
- 9. Door handles, lock and other operating devices shall be installed at a minimum 34" and a maximum 48" above finished floor.
- 10. This door to remain unlocked when building is occupied.
- 11. All egress door operation shall also comply with section 1008.1.9 1008.1.9.12.
- 12. The means of egress, including the exit discharge, shall be illuminated at all times the building space served by the means of egress is occupied.

RAMPS

- 1. All ramps used as exits and any path of travel having a slope greater than 1:20 shall comply with the requirements of this section. Ramps shall have the least possible slope.
- 2. Pedestrian ramps serving primary entrances to a building shall have a minimum width of 48". Ramps serving an occupancy load greater than 300 shall have a minimum width of 60".
- 3. All ramps in areas accessible to persons with disabilities on a path of travel or serving exits shall have a 1:12 maximum slope with cross slopes no greater than 1:50.
- 4. The level landing width of any ramp shall extend past the strike edge of any door or gate as shown on detail no. 3 on this drawing.
- 5. Doors in any position shall not reduce the minimum dimension of the ramp landing to less than 42", and shall not reduce the required width by more than 3", when fully open.

SANITARY FACILITIES (GENERAL)

- All doorways leading to sanitary facilities shall have clear unobstructed openings of 32" minimum.
- 2. All sinks, faucet controls, and operating mechanisms shall be operable with one hand and shall not require tight grasping, pinching, or twisting of the wrist. The force required to activate controls shall be no greater than 5 lbs, lever operated, push type, and electronically controlled mechanisms are examples of acceptable designs. Self closing valves are allowed if the faucet remains open for at least 10 seconds.
- 3. Lavatories shall be mounted with a minimum distance of 18" from a wall or partition to the center of the fixture. Accessible lavatories shall be mounted with the rim or counter surface no higher than 34" above the floor.
- 4. Switches for control of lights, ventilation, fire alarms, etc. Shall be installed minimum 36" and maximum 48" above the finished floor. Electrical outlets shall be installed not less than 15" above the finished floor.

TOILET ROOM FIXTURES AND ACCESSORIES

- The height of accessible water closets shall be a minimum of 17" and a maximum of 19" measured to the top of the toilet seat.
- 2. Provide 18" from the centerline of the water closet to the adjacent wall.
- 3. Toilet and urinal flush controls shall be operable with one hand and shall not require tight grasping, pinching, or twisting of the wrist. Controls for the flush valves valves shall be mounted on the open (wide) side of the toilet stall, no more than 44" above the floor. The force required to activate controls shall be no greater than 5 lbs.
- 4. Where urinals are provided, at least one shall have a clear space 30" wide by 48" long in front of the urinal. At least one urinal with a rim projecting a minimum of 14" from the wall and a maximum of 17" above the floor shall be installed.
- 5. A clear floor space 30" wide by 48" long shall be provided in front of a lavatory to allow forward approach. Such clear space shall adjoin or overlap an accessible route and shall extend into knee and toe space underneath lavatory. See detail no. 6 on this drawing.
- 6. Lavatories shall be mounted with a clearance of at least 29" from the floor to the bottom of the apron with knee clearance under the front lip extending a minimum of 30" in width with 8" minimum depth at the top. Toe clearance shall be same width and minimum of 9" high from the floor and a minimum of 17" deep from the front of the lavatory.
- 7. Hot water and drain pipes under lavatories shall be insulated or otherwise covered. There shall be no sharp or abrasive surfaces under lavatories.
- 8. Mirrors shall be mounted with bottom edge of the reflective surface not more than 40" from the floor.
- 9. Locate paper towel dispensers, sanitary napkin dispensers and waste receptacles with all operable parts not more than 40" from the floor.
- 10. Locate toilet tissue dispensers on the wall within 12" of the front edge of toilet seat. Dispensers that control delivery or that do not permit continuous paper flow shall not be

MULTIPLE ACCOMMODATION TOILET FACILITIES

- 1. A clear space measured from the floor to a height of 27" above the floor, within the sanitary facility room, of sufficient size to inscribe a circle of a diameter not less than 60", or a clear space not less than 56" x 63" in size shall be provided. Doors other than the door to the disabled toilet compartment, in any position, may encroach into this space by not more than 12".
- 2. An accessible individual toilet stall shall provide at least 28" clear space from a fixture or 32" clear space from a wall at one side of the water closet. A 48" long clear space in front of water closet shall be provided if the compartment has an end opening door (facing the water closet). A 60" long clear space shall be provided when door is located at the side of compartment. Grab bars shall not project more than 3" into clear space specified above.
- 3. Water closet compartment shall be equipped with a door that has an automatic closing device, and shall provide a clear unobstructed opening width of 32" when located at the end, and 34" when located at the side (measured when when the door is positioned at an angle of 90 degrees from its closed position)
- 4. Toilet partitions for the accessible toilet shale be provided with a latch that does not require grasp of twisting, and a u-shape or loop immediately below the latch on the inside and outside of the partition door. CBC 1115b. 3. 1. 4. 5.
- 5. Except for door openings, a clear unobstructed access not less than 44" shall be provided to all water closet compartments designed for use by the disabled. The space immediately in front of a water closet compartment shall be not less than 48" as measured at right angles to the compartment door in its closed position.

GRAB BARS

- 1. Grab bars shall be located on one side and the back of the physically disabled toilet stall or compartment and shall be securely attached 33" above and parallel to the floor.
- Grab bars at the side shall be minimum 42" long with the front end positioned 24" from front of the water closet. Grab bars at the back shall not be less than 36".
- 3. The diameter or width of the gripping surfaces of a grab bar shall be between 1 1/4" and 1 1/2" or the shape shall provide an equivalent gripping surface. If the grab bars are mounted adjacent to a wall. The space between the wall and the grab bars shall be 1 1/2".
- 4. Grab bars, and any wall or other surface adjacent to it, shall be free of any sharp or abrasive elements. Grab bar edges shall have a minimum radius of 1/8".
- 5. Grab bars shall not rotate within their fittings.
- 6. Grab bars shall be designed to support a 250 pound force.

- Braille symbols. Contracted grade 2 braille shall be used used wherever braille symbols are specifically required. Dots shall be 1/10 inch on center in each cell with 2/10 inch space between cells. Dots shall be raised a minimum of 1/40 inch above the background.
- Proportions. Letters and numbers on signs shall have a width to height ratio of between 3:5 and 1:1 and a stroke width to height ratio of between 1:5 and 1:10.
- 3. Character height. Characters and numbers on signs shall be sized according to the viewing distance from which they are to be read, the minimum height is measured using an uppercase 'x'. Lowercase characters are permitted. For signs suspended or projected above the finish floor the minimum character height shall be 3".
- 4. Contrast of symbol. Characters and symbols shall contrast with their background, either light characters on a dark background or dark characters on a light background.
- 5. Raised characters and pictorial symbol signs. When raised characters or symbols are used, they shall conform to the following:a. Letter type. Letters and numbers on signs shall be raised 1/32 inch minimum and
- b. Symbol size. Raised characters or symbols shall be a minimum of 5/8 inch high.

shall be sans - serif uppercase characters accompanied by grade 2 braille.

- c. Pictorial symbol signs (pictograms). Pictorial symbol signs (pictograms) shall be accompanied by the equivalent verbal description placed directly below the pictogram. The border dimension of the pictogram shall be a minimum of 6" in height.
- 6. Mounting location and height. Where permanent identification is provided for rooms and spaces, raised letters shall be provided and shall be accompanied by braille. Signs shall be installed on the wall adjacent to the latch outside of the door. Where there is no wall space on the latch side, including at double leaf doors, signs shall be placed on the nearest adjacent wall, preferably on the right. Mounting height shall be 60" above the finish floor to the center line of the sign. Mounting location shall be determined so that a person may approach the swing of a door. Within 3" of the signage encountering protruding objects.

SEATING

 If seating spaces for person in wheelchairs are provided at fixed tables or counters, clear floor space complying with section 1118b.4 shall be provided. Such clear floor space shall not overlap knee and 19" deep shall be provided section 1122b.2.

KNEE CLEARANCE

- If seating for person in wheelchairs are provided at fixed tables or counters, knee space at least 27" height, 30" wide and 19" deep shall be provided section 1122b.3.
- HEIGHT OF WORK SURFACES
- The tops of tables and counters shall be 28" to 34" from the floor ground. Section 1122b.4
 REACH REQUIREMENTS
- 1. Public cashier counters shall be 34" in height.
- Relationship of maneuvering clearances to wheelchair spaces. One full unobstructed side of the clear floor or ground space for a wheelchair shall adjoin another wheelchair clear floor space. If a clear floor space is located in an alcove or otherwise confined all or part of three sides, additional maneuvering clearances shall be provided.
- Forward reach. If the clear floor space allows only forward approach to an object, the maximum high forward reach allowed shall be 48". The minimum low forward reach is 15".
- 4. Side reach. If the clear floor space allows parallel approach by a person in a wheelchair, the maximum high side reach allowed shall be 54" and the low side reach shall be no less than 9" above the floor.
- 5. The operating part of all accessories shall be installed at 40' maximum to the centerline of the operating part from finished floor surface. CBC 1115b. 8. 3
- ELECTRICAL NOTES
- Controls and switches intended to be used by the occupant of the room or area to control lighting and receptacle outlets, appliances, or cooling, heating, and ventilating equipment, shall be located no more than 48" measured from the top of the outlet box nor less than 15" measured from the bottom of the outlet box to the level of the finish floor or working platform. (1117b. 6. 5. 1)
- Electrical receptacle outlets on branch circuits of 30 amperes or less and communication system receptacles shall be located no more than 48" measured from the top of the receptacle outlet box or receptacle housing nor less than 15" measured from the bottom of the receptacle outlet box or receptacle housing to the level of the finish floor or working platform. (1117b. 6. 5. 2)
- 3. The power supply for means of egress illumination shall be provided by the premise's electrical supply. In the event of power supply failure, illumination shall be automatically provided from an emergency system for aisles and unenclosed egress stairways in rooms and spaces that require two or more means of egress.

NOTIFICATION APPLIANCES FOR THE HEARING IMPAIRED

 If emergency warning systems are provided, they shall include both audible alarms and visual alarms complying with NFPA 72 and Chapter 9, Sections 907. 5. 2. 1 and 907. 5. 2. 3. (1114B. 2. 2)

- ENTRANCES AND EXITS
- Exit as defined is "that portion of a means of egress system which is separated from other interior spaces of a building or structure by fire-resistance-rated construction and opening protective's as required to provide a protected path of egress travel between the exit access and the exit discharge. Exits include exterior exit doors at ground level, exit enclosures, exit passageways, exterior exit stairs, exterior exit ramps and horizontal exits." (1002.1).
- Public way as defined is "a street, alley or other parcel of land open to the outside air leading to a street, that has been deeded, dedicated or otherwise permanently appropriated to the public for public use and which has a clear width and height of not less than 10 feet. (1002.1).
- 1. All entrances and exterior ground floor exit doors to buildings and facilities shall be made accessible to persons with disabilities. (1133b.1.1.1.1).
- 2. Revolving doors shall not be used as a required entrance for persons with disabilities. (1133b.2.3.3).
- 3. During periods of partial or restricted use of a building or facility, the entrances used for primary access shall be accessible to and usable by persons with disabilities. (1133b.1.1.1.2).
- 4. Recessed doormats shall be adequately anchored to prevent interference with wheelchair traffic. (1133b.1.1.1.3, fig. 11b-25).
- All gates, including ticket gates, shall meet all applicable accessibility specifications of doors. (1133b.1.1.1.4).
- 6. Every required exit doorway shall be capable of opening at least 90 degrees, shall have a minimum clear opening of 32", and shall be of a size as to permit the installation of a door not less than 3 feet in width and not less than 6'-8" in height. (1133b.2.2).
- 7. The space between two consecutive door openings in a vestibule, serving other than a required exit stairway, shall provide a minimum of 48" of clear space from any door opening into such vestibule when the door is positioned at an angle of 90 degrees from its closed position. Doors in a series shall swing either in the same direction or away from the space between the doors. See figures 11b-30 & 11b-31. (1133b.2.4.4).

DOORS

- Door handles, pulls, latches, locks and other operating devices on doors required to be accessible shall not require tight grasping, tight pinching or twisting of the wrist to operate. Manually operated bolts or surface bolts are not permitted. The unlatching of any door or leaf shall not require more than one operation. (1008).
- 2. Latching and locking doors that are hand activated and which are in a path of travel shall be operable with a single effort by lever type hardware, by panic bars, push-pull activating bars, or other hardware designed to provide passage without requiring the ability to grasp the opening hardware. (1133b.2.5.2).
- 3. Hand-activated door opening hardware shall be centered between 30" and 44" above the floor. (1133b.2.5.2).
- 4. When installed, doorways shall have a minimum clear opening of 32" with the door open 90 degrees. (1133b.1.1.1.1, fig 11b -5b & 11b-33).
- 5. For hinged doors, the opening width shall be measured with the door positioned at an angle of 90 degrees from its closed position. (1133b.2.3, fig 11b-5b).
- 6. Where a pair of doors is utilized, at least one of the doors shall provide a clear, unobstructed opening width of 32" with the leaf positioned at an angle of 90 degrees from its closed position. (1133b.2.3.1).
- 7. When an automatic or power assisted door operator is utilized to operate a pair of doors, at least one of the doors shall provide a clear, unobstructed opening width of 32" with the door positioned at an angle of 90 degrees from its closed position. Automatic doors shall comply with BHMA a156.10 or BHMA a156.19. (1133b.2.3.2).
- Minimum maneuvering clearances at doors shall be as shown in figure 11b-26a & 11b-26b. The floor or ground area within the required clearances shall be level and clear. (1133b.2.4.2).
- 9. There shall be a level and clear floor or landing on each side of a door. The level area shall have a length in the direction of door swing of at least 60" and the length opposite the direction of door swing of 48" as measured at right angles to the plane of the door in the closed position. Where the plane of the doorway is offset or located in an alcove a distance more than 8" measured from the plane of the doorway to the face of the wall, the door shall be provided with 60" maneuvering clearance for front approach. (1133b.2.4.2, 1133b.2.5.3, fig. 11b-26, fig. 11b-33a).
- 10. The width of the level area on the side to which the door swings shall extend 24" past the strike edge of the door for exterior doors and 18" past the strike edge for interior doors. Where the plane of the doorway is offset 8 or more" from any obstruction within 18" measured laterally on the latch side, the door shall be provided with maneuvering clearance for front approach. (1133b.2.4.3, 1133b.2.4.5, 1133b.2.5.3, fig. 11b-33(a)).
- 11. Provide clear space of 12" past strike edge of the door on the opposite side to which the door swings if the door is equipped with both a latch and a closer. (fig 11b-26 (a)).
- The floor or landing shall be not more than ½ inch lower than the threshold of the doorway. (1133b.2.4.1).
- 13. The bottom 10" of all doors except automatic and sliding shall have a smooth, uninterrupted surface to allow the door to be opened by a wheelchair footrest without creating a trap or hazardous condition. Where narrow frame doors are used, a 10" high smooth panel shall be installed on the push side of the door, which will allow the door to be opened by a wheelchair footrest without creating a trap or hazardous condition. (1133b.2.6, fig 11b-29).
- 14. Maximum effort to operate exterior and interior doors shall not exceed 5 pounds, with such pull or push effort being applied at right angles to hinged doors and at the center plane of sliding or folding doors. Compensating devices or automatic door operators may be utilized to meet the above standards. When fire doors are required, the maximum effort to operate the door may be increased to the minimum allowable by the appropriate administrative authority, not to exceed 15 lbf. (1133b.2.5).
- 15. When the door has a closer, then the sweep period of the closer shall be adjusted so that from an open position of 70 degrees, the door will take at least 3 seconds to move to a point 3" from the latch, measured to the landing edge of the door. (1133b.2.5.1).
- 16. Where turnstiles and crowd control barriers are utilized in a facility for the purpose of providing fully controlled access, such as where an admission price is charged, a door or gate that is accessible to persons with disabilities shall be provided adjacent to each turnstile exit or entrance. This alternate passageway shall be maintained in an unlocked condition during business hours and the door or gate shall not activate a publicly audible alarm system. The door or gate may be latched where all gates are restricted and controlled by an attendant and a sign is posted stating, "all gates are restricted and controlled by an attendant." the accessible door or gate shall provide the same use pattern. Where posts, rails, or other pedestrian controls are utilized to create crowd control aisles or lanes, a minimum aisle width not less than indicated in figure 11b-5e (a) and (b) with 32" of clear opening. (1133b.2.3.4).

FLOORS AND LEVELS

- Level area is defined as "a specified surface that does not have a slope in any direction exceeding 1/4 inch in one foot from the horizontal (2.083% gradient)." (1102b).
- 1. In buildings and facilities, floors of a given story shall be a common level throughout, or shall be connected by pedestrian ramps, passenger elevators, or special access lifts. (1120b.1).
- Ground and floor surfaces along accessible routes and in accessible rooms and spaces, including floors, walks, ramps, stairs, and curb ramps, shall be stable, firm, and slip-resistant. (1120b.2 & 1124b.1).
- 3. Changes in level up to 1/4" may be vertical and without edge treatment. (1124b.2, fig . 11b-5e (c)).
- 4. Changes in level between 1/4" inch and 1/2" shall be beveled with a slope no steeper that 1:2. (1124b.2, fig 11b-5e (d)).
- 5. If carpet or carpet tile is used on a ground or floor surface, it shall be securely attached; have a firm cushion, pad or backing or no cushion or pad; and have a level loop, textured loop, level cut pile, or level cut/uncut pile texture. The maximum pile height shall be 1/2" exposed edges of carpet shall be fastened to floor surfaces and have trim along the entire length of the exposed edge. Carpet edge trim shall comply with section 1124b.2. (1124b.3, fig. 11b-7e).
- 6. F gratings are located on floors, then they shall have spaces no greater than 1/2" wide in one direction. If gratings have elongated openings, they shall be placed so that the long dimension is perpendicular to the dominant direction of travel. (1124b.4, fig 11b-7e).

CORRIDORS AND AISLES

- Every corridor and hallway serving an occupant load of 10 or more shall not be less than 44" in width. (1133b.3.1).
- Corridors and hallways serving an occupant load of less than 10 shall not be less than 36" in width. (1133b.3.1).
- Corridors which are located on accessible route and exceed 200 feet in length shall: (1133b.3.2, fig 11b-34).
- a. Have a minimum clear width of 60" ; or
- b. Have, at reasonable intervals, a 60" by 60" minimum wheelchair turning space or passing alcove; not to exceed 200 feet; or
- c. Have, at a central location, an intervening crossing or tee corridor, a minimum of 44" in width.
- 4. Circulation aisles and pedestrian ways shall be sized according to functional requirements and in no case shall be less than 36" in clear width. (1105b.3.6).
- 5. Every portion of every building in which are installed seats, tables, merchandise, equipment, or similar materials shall be provided with aisles leading to an exit. (1133b.6.1).
- 6. Every aisle shall be not less than 36" wide if serving only one side, and not less than 44" wide if serving both sides. (1133b.6.2).

HAZARDS AND PROTRUDING OBJECTS

- 1. Abrupt changes in level, except between a walk or sidewalk and an adjacent street or driveway, exceeding 4" in a vertical dimension, such as at planters or fountains located in or adjacent to walks, sidewalks, or other pedestrian ways, shall be identified by warning curbs projecting at least 6" in height above the walk or sidewalk surface to warn the blind of a potential drop off. (1133b.8.1).
- 2. When a guard or handrail is provided, no curb is required when a guide rail is provided centered 3" plus or minus 1 inch above the surface of the walk or sidewalk, the walk is 5 percent or less gradient or no adjacent hazard exists. (1133b.8.1, fig. 11b-27 (c)).
- 3. Objects projecting from walls with their leading edges between 27" and 80" above the finished floor shall protrude no more than 4" into walks, halls, corridors, passageways, or aisles. (1133b.8.6.1, fig 11b-7a).
- 4. Objects mounted with their leading edges at or below 27" above the finished floor may protrude any amount into walks, halls, corridors, passageways, or aisles. (1133b.8.6.1, fig 11b-7a).
- Free standing objects mounted on posts or pylons may overhang 12" maximum from 27" to 80" above the ground or finished floor. (1133b.8.6.1, fig. 11b-7b).
- Protruding objects shall not reduce the clear width of an accessible route or maneuvering space. (1133b.8.6.1, fig 11b-7d).
 Walks, halls, corridors, passageways, aisles, or other circulation spaces shall have 80"
- 8. Any obstruction that overhangs a pedestrian way shall be a minimum of 80" above the
- walking surface as measured from the bottom of the obstruction. (1133b.8.2, fig. 11b-28).
- 9. Where a guy support is used parallel to a path of travel, including, but not limited to sidewalks, a guy brace, sidewalk guy or similar device shall be used to prevent an overhanging obstruction as defined. (1133b.8.2).
- 10. If a walk crosses or adjoins a vehicular way, and the walking surfaces are not separated by curbs, railings, or other elements between the pedestrian areas and vehicular areas, the boundary between the areas shall be defined by a continuous detectable warning which is 36" wide, complying with section 1121b.3.1, item 8(a). (1133b.8.5).
- Transit boarding platforms shall conform to the requirements of section 1121b.3.1, item 8(b). Only approved dsa/ac detectable warning products and directional surfaces shall be installed as provided in the California code of regulations, title 24, part 1, articles 2, 3, and 4. (1133b.8.4 &1133b.8.5).

- 1. The minimum clear floor or ground space required to accommodate a single, stationary wheelchair and occupant is 30" by 48". The minimum clear floor or ground space for wheelchairs may be positioned for forward or parallel approach to an object. Clear floor or ground space for wheelchairs may be a part of the knee space required under some objects. (1117b.2.3, 1118b.4.1, fig 11-b-5a).
- 2. One full unobstructed side of the clear floor or ground space for a wheelchair shall adjoin or overlap an accessible route or adjoin another wheelchair clear floor space. If a clear floor or ground space is located in an alcove or otherwise confined on all or part of three sides, additional maneuvering clearances shall be provided. (1117b.2.4, 1118b.4.2, fig. 11-b-5a).
- 3. The space required for a wheelchair to make a 180 degree turn is a clear space of 60" diameter or a t-shaped space. (1118b.3, fig. 11b-12 (a) & (b)).
- 4. The minimum clear width required for a wheelchair to turn around an obstruction shall be 36" where the obstruction is 48" or more in length and 42" and 48" where the obstruction is less than 48" in length. (fig. 11b-5e).
- 5. The minimum clear width for single wheelchair passage shall be 32" at a point and 36" continuously. (1118b.1, fig. 11b-10).
- The minimum width for two wheelchairs to pass is 60". (1118b.2, fig 11b-11).
 If the clear floor space only allows forward approach to an object, the maximum high forward reach allowed shall be 48". See figure 11b-5c (a). The minimum low forward reach is 15". If the high forward reach is over an obstruction, reach and clearances shall be as shown in figure 11b-5c (b). (1118b.5).
- 8. If the clear floor space allows parallel approach by a person in a wheelchair, the maximum high side reach allowed shall be 54" and the low side reach shall be no less than 9" above the floor as shown in figures i 1 b-5d(a) & (b). If the side reach is over and obstruction, the reach and clearances shall be as shown in figure 11b-5d (c). (1118b.6).
- EMPLOYEE WORK AREAS AND WORKSTATIONS
- Work station is defined as "an area defined by equipment and / or work surfaces intended for use by employees only, generally for one or a small number of employees at a time..." (1102b).
- 1. Employee areas shall conform to all requirements of the division of the state architect access compliance in the california building code, plumbing code, and electrical code. (1123b.1).
- Specific workstations need only comply with aisle width and floors and levels, and entry-ways shall be 32" in clear width. Aisles shall not be less than 36" if serving only one side, and not less than 44" wide if serving both sides. (1123b.2,1133b.6.2).
- Employee work areas shall be accessible by means of 36 inch minimum aisle and 32 inch minimum clear opening door width. (1105b.3.2.3).

FIXED OR BUILT - IN SEATING, TABLES AND COUNTERS


- . Where fixed or built-in seating, tables, or counters are provided for the public, and in general employee areas, five percent but never less than one must be accessible, as required in section 1122b. (1122b.1).
- If seating spaces for persons in wheelchairs are provided at fixed tables or counters, clear floor space complying with section 1118b.4 shall be provided. Such clear floor space shall not overlap knee space by more than 19". (1122b.2, fig 11b-13).
- 3. If seating for persons in wheelchairs is provided at fixed tables or counters, knee spaces at least 27" high, 30" wide, and 19" deep shall be provided. (1122b.3, fig 11b-13).
- 4. The tops of tables and counters shall be 28" to 34" from the floor or ground. (1122b.4).
- 5. Where a single counter contains more than one transaction station, such as a bank counter with multiple teller windows or a retail sales counter with multiple cash register stations, at least 5 percent, but never less than one of each type of station shall be located at a section of counter that is at least 36" long and no more than 28 to 34" high. (1122b.4).

SIGNS AND IDENTIFICATION

- California's standards for signage are more stringent and are significantly larger and wider than federal law, americans with disabilities act (ADA) section 4.30. (1117b.5). The international symbol of accessibility shall be the standard used to identify facilities that are accessible to and usable by physically disabled persons as set forth in title 24 and as specifically required in this section. (1117b.5.8.1, fig 11b-6).
- 1. The international symbol of accessibility shall consist of a white figure on a blue background. The blue shall be equal to color no. 15090 in federal standard 595b. (1117b5.8.1.1).
- 2. All building and facility entrances that are accessible to and usable by persons with disabilities and at every major junction along or leading to an accessible route of travel shall be identified with a sign displaying the international symbol of accessibility and with additional directional signs, as required, to be visible to persons along approaching circulation paths. (1117b.5.8.1.2. & 1127b.3).
- 3. When permanent identification is provided for rooms and spaces of a building or site, raised letters shall be provided and shall be accompanied by braille in conformance with section 1117b.5.2 through 1117b.5.7. Signs shall be installed on the wall adjacent to the latch outside of the door. Where there is no wall space on the latch side, including at double leaf doors, signs shall be placed on the nearest adjacent wall, preferably on the right. Mounting height shall be 60" above the finished floor to the centerline of the sign. Mounting location shall be determined so that a person may approach within 3inches of signage without encountering protruding objects or standing within the swing of a door. (1117b.5.1, 1117b.5.7).
- 4. When signs direct to or give information about permanent rooms and functional spaces of a building or site, they shall comply with sections 1117b.5.2, 1117b.5.3, 1117b.5.4. Means of egress signs and identification for visual exit signs, graphics, illumination, power source, tactile exit signage, tactile stair level identification and special egress control devices shall comply with sections 1003.2.8.1, 1003.2.8.5, 1003.2.9, 1003.2.10 and 1003.3.1.10. (1117b.5.1.2).
- 5. When raised characters or when pictogram symbols are used, they shall conform to the following: (1117b.5.5).
 - Characters on signs shall be raised or recessed 1/32 inch minimum and shall be sans - serif uppercase characters accompanied by grade 2 braille complying with section 1117b.5.6. (1117b.5.5.1).
 - b. Raised characters or symbols shall be a minimum of 5/8 inch high and a maximum of 2" high. (1117b.5.5.2).
 - c. Pictorial symbol signs (pictograms) shall be accompanied by the verbal description placed directly below the pictogram. The outside dimension of the pictogram field shall be a minimum of 6" in height. (1117b.5.5.3).
 - d. Characters and braille shall be in a horizontal format. Braille should be placed a minimum of 3/8" and a maximum of 1/2" directly below the tactile characters; flush left or centered. When tactile sign is multi-lined, all braille shall be placed together below all lines of tactile text. (1117b.5.5.4).
- 6. Characters on signs shall have a width-to-height ratio of between 3:5 and 1:1 and a stroke width-to-height ratio between 1:5 and 1:10. (1117b.5.3).
- 7. Characters, symbols and their background shall have a non-glare finish. Characters and symbols shall contrast with their background, either light characters on a dark background or dark characters on a light background. (1117b.5.2).
- 8. Characters and numbers on signs shall be sized according to the viewing distance from which they are to be read. The minimum height is measured using an upper case 'x'. Lower case characters are permitted. For signs suspended or projected above the finish floor in compliance with section 1133b.8.6, the minimum character height shall be 3 ". (1117b.5.4).
- Contracted grade 2 braille shall be used wherever braille is required in other portions of these standards. Dots shall be 1/10" on centers in each cell with 2/10" space between cells. Dots shall be raised a minimum of 1/40 inch above the background. (1117b.5.6).
- 10. Pole supported pedestrian traffic control buttons shall be identified with color coding consisting of a textured horizontal yellow band 2" in width encircling the pole, and a 1 inch wide dark border band above and below this yellow band. Color-coding should be placed immediately above the control button. Control buttons shall be located no higher than 48" above the surface adjacent to the pole. (1117b.5.9).
- ELECTRICAL
- 1. The highest operable part of all controls, dispensers, receptacles and other operable equipment shall be shall be installed at an accessible location meeting the clearances and reach range requirements of section 1118b.5 and 1118b.6 and not less than 15" above the floor or working platforms. (1117b.6.3).
- 2. The center of the grip of the operating handle of controls or switches intended to be used by the occupant of the room or area to control lighting and receptacle outlets, appliances, or cooling, heating, and ventilating equipment shall be 48" above the floor or working platform. (1117b.6, 5.1).
- 3. The center of electrical receptacle outlets on branch circuits of 30 amperes or less shall be installed not more than 48" nor less than 14" above the floor or working platform. (1117b.6.5.2).

CONTROLS AND OPERATING MECHANISMS

- 1. Controls and operating mechanisms in accessible spaces, along accessible routes or as part of accessible elements and those in section 109.1 are required to be accessible. (1117b.6.1).
- 2. Clear floor space complying with section 1118b.4 that allows a forward or parallel approach by a person using a wheelchair shall be provided at controls, dispensers, receptacles, and other operable equipment. (1117b.6.2).
- 3. The highest and lowest operable part of all controls, dispensers, receptacles, and other operable equipment shall be placed within one of the reach ranges specified in sections 1118b.5 and 1118b.6. Electrical and communication system receptacles on walls shall be mounted no less than 15" above the floor. (1117b.6.3).
- 4. Controls and operating mechanisms shall be operable with one hand and shall not require tight grasping, punching, or twisting of the wrist. To force required to activate controls shall be no greater than 5 pounds of force. (1117b.6.4).
- 5. For accessible lavatories, faucet controls and operating mechanisms shall be operable with one hand and shall not require grasping, pinching, or twisting of the wrist. The force required to active faucet controls and operating mechanisms shall be no greater than 5 lbf. Lever-operated, push-type, and electronically controlled mechanisms are examples of acceptable designs. Self-closing valves are allowed if the faucet remains open for at least 10 seconds. (1115b.4.3).

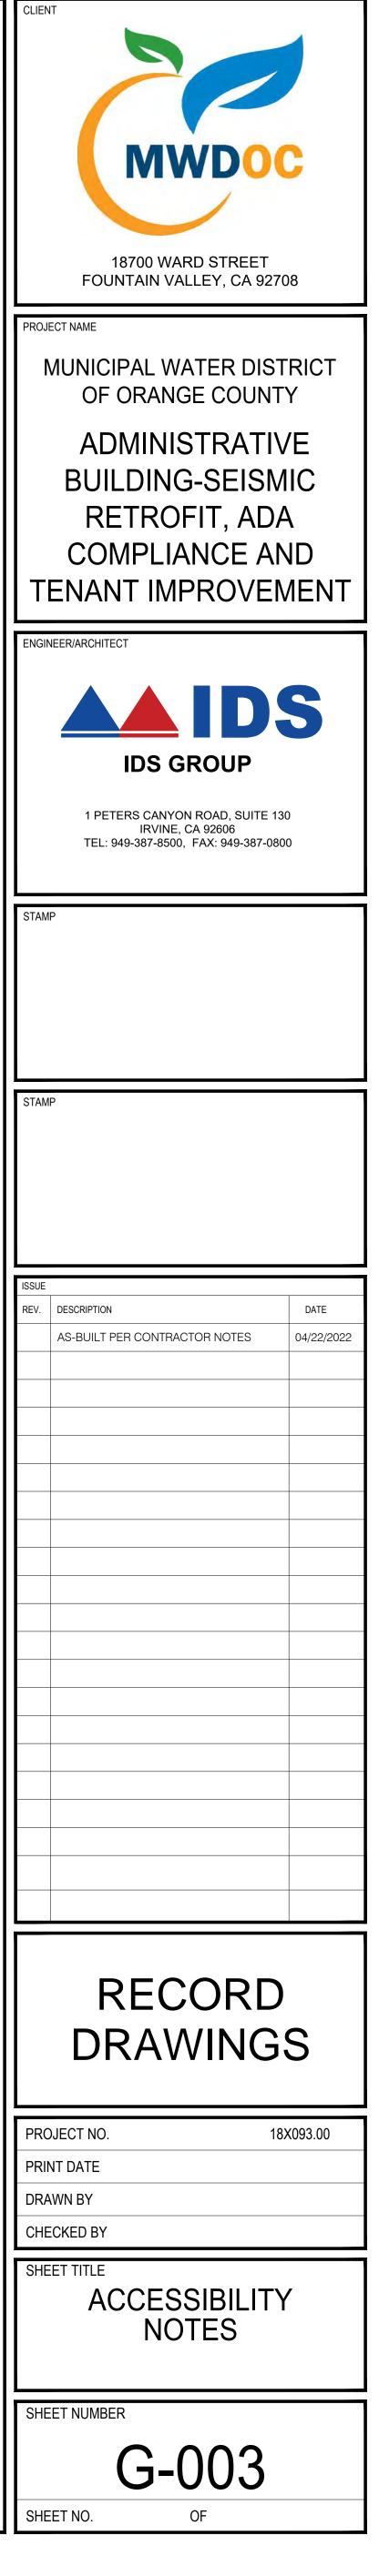

Exit as defined is "that portion of a means of egress system which is separated from other interior spaces of a building or structure by fire-resistance-rated construction and opening protective's as required to provide a protected path of egress travel between the exit access and the exit discharge. Exits include exterior exit doors at ground level, exit enclosures, exit passageways, exterior exit stairs, exterior exit ramps and horizontal exits." (1002.1).

Public way as defined is a street, alley or other parcel of land open to the outside air leading to a street, that has been deeded, dedicated or otherwise permanently appropriated to the public for public use and which has a clear width and height of not less than 10 feet. (1002.1).

- 1. All entrances and exterior ground floor exit doors to buildings and facilities shall be made accessible to persons with disabilities. (1133b.1.1.1.1).
- 2. Revolving doors shall not be used as a required entrance for persons with disabilities. (1133b.2.3.3).
- 3. During periods of partial or restricted use of a building or facility, the entrances used for primary access shall be accessible to and usable by persons with disabilities. (1133b.1.1.1.2).
- 4. Recessed doormats shall be adequately anchored to prevent interference with wheelchair traffic. (1133b.1.1.1.3, fig. 11b-25).
- 5. All gates, including ticket gates, shall meet all applicable accessibility specifications of doors. (1133b.1.1.1.4).
- 6. Every required exit doorway shall be capable of opening at least 90 degrees, shall have a minimum clear opening of 32", and shall be of a size as to permit the installation of a door not less than 3 feet in width and not less than 6'-8" in height. (1133b.2.2).
- 7. The space between two consecutive door openings in a vestibule, serving other than a required exit stairway, shall provide a minimum of 48" of clear space from any door opening into such vestibule when the door is positioned at an angle of 90 degrees from its closed position. Doors in a series shall swing either in the same direction or away from the space between the doors. See figures 11b-30 & 11b-31. (1133b.2.4.4).

ENTRANCES AND EXITS

- 1. All entrances and all exterior ground floor exit doors to buildings and facilities shall be made accessible to persons with disabilities.
- 2. All accessible entrances shall be identified with at least one standard sign and with additional directional signs, as required, visible from approaching pedestrian ways.
- 3. All gates, including ticket gates, shall meet all applicable accessibility specifications of
- 4. Every required exit doorway which is located within an accessible path of travel shall be capable of opening at least 90 degrees, shall have a minimum clear opening of 32", and shall be of a size as to permit the installation of a door not less than 3' in width and not less then 6'-8" in height.
- 5. Latching and locking doors that are hand activated and which are in a path of travel shall be operable with a single effort by lever type hardware, by panic bars, push-pull activating bars, or other hardware designed to provide passage without requiring the ability to grasp the opening hardware.
- 6. Hand-activated door opening hardware shall be centered between 30" and 44" above the
- 7. The floor and landing on each side of an entrance or passage door shall be level and clear. The level and clear area shall have a length in the direction of door swing of at least 60" and the length opposite the direction of door swing of 44" as measured at right angles to the plane of the door in its closed position.
- 8. The floor or landing shall be not more than 1/2" lower than the threshold of the doorway. Change in level between 1/4" and 1/2" shall be beveled with a slope no greater than 1:2.
- 9. The bottom 10" of all doors except automatic and sliding shall have a smooth uninterrupted surface to allow the door to be opened by a wheelchair footrest without creating a trap or hazardous condition. Where narrow frame doors are used, a 10" high smooth panel shall be installed on the push side of the door, which will allow the door to be opened by a wheelchair footrest without creating a trap or hazardous condition.
- 10. Maximum effort to operate interior and exterior doors shall not exceed 5 pounds, with such pull or push effort being applied at right angles to hinged doors and at the center plane of sliding or folding doors. Compensating devices or automatic door operators may be utilized to meet the above standards. When fire doors are required, the maximum effort to operate the door may be increased to the minimum allowable by the appropriate administrative authority, not to exceed 15 pounds.
- 11. For hinged doors, the opening width shall be measured with the door position at an angle of 90 degrees from the closed position.
- 12. Where a pair of doors is utilized, at least one of the doors shall provide a clear, unobstructed opening width of 32" with the leaf positioned at an angle of 90 degrees from its closed position.
- 13. When an automatic door operator is utilized to operate a pair of doors, at least one of the doors shall provide a clear unobstructed opening width of 32" with the door positioned at an angle of 90 degrees from its closed position.
- 14. Minimum maneuvering clearances at doors shall be as shown in figure 11b-26. The floor or ground area within the required clearances shall be level and clear.
- 15. There shall be a level and clear floor or landing on each side of a door. The level area shall have a length in the direction of door swing of at least 60" and the length opposite the direction of door swing of 48" as measured at right angles to the plane of the door in the closed position. Where the plane of the doorway is offset or located in an alcove a distance more than 8" measured from the plane of the doorway to the face of the wall, the door shall be provided with 60" maneuvering clearance for front approach.
- 16. Provide clear space of 12" past strike edge of the door on the opposite side to which the door swings if the door is equipped with both a latch and a closer.
- 17. Where the door opens into a stair of a smoke proof enclosure, the landing need not have
- 18. When the door has a closer, then the sweep period of the closer shall be adjusted so that from an open position of 70 degrees, the door will take at least 3 seconds to move to a point 3" from the latch, measured to the landing edge of the door.
- 19. Where turnstiles and crowd control barriers are utilized in a facility for the purpose of providing fully controlled access, such as where an admission price is charged, a door or gate that is accessible to persons with disabilities shall be provided adjacent to or within a distance not to exceed 30' from each turnstile exit or entrance. This alternate passageway shall be maintained in an unlocked condition during business hours and the door or gate shall not activate a publicly audible alarm system. A sign is posted stating "the door or gate may be latched where all gates are restricted and controlled by an attendant and a sign". "all gates are restricted and controlled by attendant." the accessible door or gate shall provide the same use pattern. Where posts, rails, or other pedestrian controls are utilized to create crowd control aisles or lanes, an minimum aisle width not less than indicated in figure 11b-5e (a) and (b) with 32" of clear opening.
- 20. Accessible entrances to and from exits from a building must be provided, according to ADA ag 4.1.3 (8) and applicable codes.
- 21. Maneuvering clearances at doors shall be level (1:50 max. Slope) and clear if doors are not automatic or power assisted.
- 22. Revolving doors shall not be used as a required entrance for persons with disabilities.
- 23. All doors in alcoves shall comply with the clearances for front approaches.
- 24. Provide tactile exit sign per section.

a length of 60".


25. Accessible stall in multi-accommodation toilet facilities shall be a minimum of 60" wide per

AISLES

- 1. Every corridor shall be as shown on the plans and shall be determined as per CBC chapter 10, but shall not be less than 44" in width.
- 2. Every portion of every building in which are installed seats, tables, merchandise, equipment or similar materials shall be provided with aisles leading to an exit.

NOTIFICATION APPLIANCES FOR THE HEARING IMPAIRED

1. Approved notification appliances for the hearing impaired shall be installed in accordance with the provisions of NFPA 72 and CBC, chapter 9, section 907.9.1 and 907.9.2.

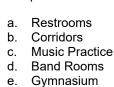

4-4.4.1).

a. Restrooms

f. Multipurpose Rooms

- c. Music Practice Rooms
- Noise impairs hearing of the Fire Alarm. Lobbies Meeting Rooms

k. Classrooms

g. Occupational Shops

h. Occupied Rooms where Ambient

- 2. Strobe signaling devices required for the hearing impaired shall be state fire marshall, NFPA 72: per chapter 6, section 6-4, visible characteristics, public mode.
- 3. The flash rate shall not exceed 3 flashes per second nor be less than 1 flash every three
- seconds NFPA 72: per chapter 6, section 6-4.2, light pulse characteristics. 4. Audible signals intended for operation in the public mode shall have a sound level of not less than 75 dba at 10' or more than 130 dba at the minimum hearing distance from the
- audible appliance. NFPA 72: per chapter 6, section 6-3, audible characteristics, public 5. Audible signals intended for operation in the private mode shall have a sound level of not
- less than 45 dba at 10' or more than 130 dba at the minimum hearing distance from the audible appliance. NFPA 72: per chapter 6, section 6-3.2, audible characteristics, private
- 6. The light source color shall be clear or nominal white and shall not exceed 1000 candela (effective intensity). (NFPA 72 sec 4-4.2.2).
- 7. Wall mounted appliances shall be mounted such that the entire lens is not less than 80" and not greater than 96" above the finished floor. Ceiling-mounted appliances shall be installed per table 4-4.4.1.1. (NFPA 72 sec 4-4.4).
- 8 Notification appliances installed in rooms shall be spaced as follows: (NFPA 72 sec4-4.4.1)
- 1). Spacing shall be in accordance with figure 4-4.4.1. And tables 4-4.4.1 and (b). The separation between appliances shall not exceed 100'. (NFPA 72 sec 4-4.4.1).
- 2). Visible notification appliances shall be installed in accordance with table 4-4.4.1.1 (a), using one of the following: (NFPA 72 sec 4-4.4.1.1).
- a. A single visible notification appliance. b. Two visible notification appliances located on opposite walls.
- c. In rooms 80' x 80' or greater, where there are more than two appliances in any field of view, they shall be spaced a minimum of 55' from each other.
- d. More than two visible notification appliances that flash in synchronization. Note: Where a room configuration is not square, the square room size that entirely
- 9. Notification appliances installed in corridors shall be spaced as follows: (NFPA 72 sec.
 - a. Table 4-4.4.2.1 shall apply to corridors not exceeding 20' in width. For corridors greater than 20' in width, refer to figure 4-4.4.1.1 and tables 4-4.4.1.1 (a) and (b). (NFPA 72 sec 4-4.4.2.1)

- b. Visual appliances shall be rated not less than 15 candela. (NFPA 72 sec 4-4.4.2.1). c. The visible appliances shall be located no more than 15' from the end of the corridor with a separation no greater than 100' between appliances. (NFPA 72 sec 4-4.4.2.2).
- d. Where there is an interruption of the concentrated viewing path, such as a fire door, an elevation change, or any other obstruction, the area shall be considered as a separate corridor. (NFPA 72 sec 4-4.4.2.2). 10. An electrical plan check and fire dept. Plan check is required prior to installation of visual

SANITARY FACILITIES

- 1. Toilet facilities that serve buildings, facilities or portions of buildings or facilities that are required by these standards to be accessible to persons with disabilities, shall be on an accessible route and shall conform to the requirements of section 1115b. (1115b.1).
- 2. Where separate facilities are provided for persons of each sex, these facilities shall be accessible to persons with disabilities. Where unisex facilities are provided, these facilities shall be accessible to persons with disabilities. (1115b.1.1, fig. 11b-1a). a. Toilet centering from wall 18" 15"* 12" toilet seat height 17"-19" 15" 10"-12" grab
 - bar height (side) 33" 27"* 20"-22" toilet paper in front of toilet 12" maximum 6" maximum
- b. 6" max napkin disposal in front of toilet 12" max 12" maximum n/a dispenser or
- c. Height 40" max 36" max 32" max lavatory/sink top height 34" max 29" max 24"
- d. Lavatory/sink knee clearance 27" min 24" min 19" min urinal lip height 17" max
- e. 13" min urinal flush handle height 44" max 37" max 32" max drinking fountain
- f. 13" min urinal flush handle height 44" max 37" max 32" max drinking fountain bubbler min
- g. Ramp/stair handrail height 34"-38" 27" 22"
- 3. Doorways leading to men's sanitary facilities shall be identified by an equilateral triangle 1/4" thick with edges 12" long and a vertex pointing upward. Women's sanitary facilities shall be identified by a circle 1/4" thick and 12" in diameter. (1115b.6).
- 4. Unisex sanitary facilities shall be identified by a circle 1/4" thick, 12" in diameter, with a 1/4" thick triangle superimposed on the circle and within the 12" diameter. (1115b.6). 5. Geometric (circle & triangle) symbols on sanitary facility doors shall be centered on the door at a height of 60" and their color and contrast shall be distinctly different from the
- color and contrast of the door. (1115b.6). Note: See also section 1117b.5.1 for additional signage requirements applicable to sanitary facilities.

SINGLE ACCOMMODATION SANITARY FACILITIES

- Note: Single accommodation sanitary facility is defined as "a room that has not more than one of each type of sanitary fixture, is intended for use by only one person at a time, has no partition around the toilet, and has a door that can be locked on the inside by the room occupant". (202).
- 1. Show sufficient space in the toilet room for a wheelchair measuring 30" wide by 48" long to enter the room and permit the door to close. (1115.B.3.2.1).
- 2. Show a clear floor space of at least 60" in diameter, or a t-shaped space complying with figures 11b-12(a) and (b). No door shall encroach into this space for more than 12". (1115b.3.2.1, fig 11b-1a).
- 3. Doors shall not swing into the clear floor space required for any fixture. (1115b.3.2.2). 4. Show that the centerline of the water closet fixture shall be 18" from the side wall or partition. On the other side of the water closet, provide a minimum 28" wide clear floor space if the water closet is adjacent to a fixture or a minimum of 32" wide clear floor space if the water closet is adjacent to a wall or partition. This clear space shall extend from the
- rear wall to the front of the water closet. (1115b.4.1, fig 11b-1a). 5. All doors, fixtures, and controls shall be on an accessible route with a minimum clear width of 36" except at doors. If a person in a wheelchair must make a turn around an obstruction, the minimum clear width of the accessible route shall be as shown in figure 11b-5e. (1115b.3.2.4).
- 6. The entrance door shall contain a privacy latch which complies with section 1117b.6. (
- 7. Provide 18" clearance on the strike side of the door. (1115b.3.1).
- 8. In existing buildings, a single accommodation toilet water closet may be located in an area which provides a clear space of 36"wide by 48" long in front of the water closet. (1115b.3.2).

MULTIPLE ACCOMMODATION SANITARY FACILITIES

- Note: Multiple accommodation sanitary facility is defined as "a room that has more than one sanitary fixture, is intended for the use of more than one person at a time, and which usually is provided with privacy compartments or screens shielding some fixtures from view". (202).
- 1. Show a clear space measured from the floor to a height of 27" above the floor, within the sanitary facility room, of sufficient size to inscribe a circle with a diameter not less than 60". Doors shall not swing into the floor space required for any fixture. Other than the door to the accessible water closet compartment, a door, in any position, may encroach into this space by not more than 12". (1115b.3.1.1 & 1115b3.1.2, fig 11b-1b).
- 2. A water closet fixture located in a compartment shall provide a minimum 28" wide clear space from a fixture or a minimum 32" wide clear space from a wall at one side of the water closet. The other side of the water closet shall provide 18" from the centerline of the water closet to the wall. Grab bars shall not project more than 3" into these clear spaces. The stall shall be minimum of 60" wide. (1115b.4.1.1, fig 11b-1b).
- 3. If the compartment has a side-opening door, show a minimum 60" wide and 60" deep clear floor space in front of the water closet. (1115b.3.1.4.2).
- 4. If the compartment has an end-opening door, show a minimum 60" wide and 48" deep clear floor space in front of the water closet. The door shall be located in front of the clear floor space and diagonal to the water closet, with a maximum stile width of 4". (1115b.3.1.4.3, fig. 11b-1a & b).
- 5. Note that the water closet compartment shall be equipped with a door that has an automatic-closing device, and shall have a clear, unobstructed opening width of 32" when located at the end and 34" when located at the side with the door positioned at an angle of 90 degrees from its closed position. (1115b.3.1.4.4, fig 11b-1a & b).
- 6. Note that the inside and outside of the compartment door shall be equipped with a loop or u-shaped handle immediately below the latch. The latch shall be flip-over style, sliding, or other hardware not requiring the user to grasp or twist. (1115b.3.1.4.5).
- 7. Except for door opening widths and door swings, show a clear unobstructed access not less than 44" shall be provided to water closet compartments designed for use by persons with disabilities. The space immediately in front of a water closet compartment shall be not less than 48" as measured at right angles to compartment door in its closed position. 1115b.3.1.4.5, fig 11b-1b).
- 8. Where six or more compartments are provided within a multiple accommodation toilet room, in addition to the standard accessible stall required above, at least one additional ambulatory accessible compartment shall be 36" wide with an outward swinging self closing door and parallel grab bars complying with sections 1115b.4.1, item 3. (1115b.3.1.5).
- 9. Provide an 18" clearance at the strike side of water closet compartment doors (no exception) (1115b.3.1, item 4.4).

SANITARY FACILITY FIXTURES AND ACCESSORIES

- 1. Show the height of accessible water closets shall be a minimum of 17" and a maximum of 19" measured to the top of a maximum 2" high toilet seat, except that 3" seats shall be permitted only in alterations where the existing fixture is less than 15" high. (1115b.4.4).
- 2. Show a clear floor space 30" by 48" in front of a lavatory to allow a forward approach. Such clear floor space shall adjoin or overlap an accessible route and shall extend a maximum of 19" into knee and toe space underneath the lavatory. A door swing shall not encroach into this clear space. (1115b.4.3.3, 1115b.3.2.2, fig. 11b-1b).
- 3. Show that all lavatories, when located adjacent to a side wall or partition, shall be a minimum distance of 18" to the center line of the fixture. (1115b.4.3.2, fig. 11b-1a).
- 4. Show that lavatories that are designated to be accessible shall be a minimum 17" in horizontal depth and mounted with the rim or counter edge no higher than 34" above the finished floor and with vertical clearance measured from the bottom of the apron or the outside bottom edge of the lavatory of 29", reducing to 27" at a point located 8" back from the front edge. In addition, a minimum 9" high toe clearance must be provided extending back toward the wall to a distance no more than 6" from the back wall. The toe clearance space must be free of equipment or obstructions. (1115b.4.3.2, fig.11b-1d).
- 5. Show that hot water and drain pipes under accessible lavatories shall be insulated or otherwise covered. There shall be no sharp or abrasive surfaces under lavatories. (1115b.4.3.4).
- 6. Where urinals are provided, at least one shall have a clear floor space 30" by 48" in front of the urinal to allow forward approach. (1115b.4.2.3).
- 7. Show that urinals shall be floor mounted, stall-type or wall hung. Where one or more wall hung urinals are provided, at least one with an elongated rim projecting a minimum of 14" from the wall, a maximum of 17" from the wall, and a maximum of 17" above the floor shall be provided. (1115b.4.2.1).
- 8. Note that controls for water closet flush valves shall be mounted on the wide side of toilet areas. Automatic spring to lifted position seats are not allowed. (1115b.4.1.5, 1115b.4.1.7
- 9. Note that water closet and urinal flush valve controls, and faucet and operating mechanism controls, shall be operable with one hand, shall not require tight grasping,
- pinching, or twisting of the wrist, and shall be mounted no more than 44" above the floor. 1115b.4.1.5, 1115b.4.2.2, 1115b.4.3.1).
- 10. Note the force required to activate water closet and urinal flush valve controls, and faucet and operating mechanism controls, shall be no greater than 5 lbf. Electronic or automatic flushing controls are acceptable and preferable. (1115b.4.1.5, 115b.4.2.2, 1115b.4.3.1).

notification appliances

encompasses the room or subdivides the room into multiple squares shall be

- 11. Note that self-closing faucet control valves are allowed if the faucet remains open for at least 10 seconds. (1115b.4.3.1).
- 12. Show that mirrors shall be mounted with the bottom edge of the reflecting surface no higher than 40" from the floor. (1115b.8.1).
- 13. If medicine cabinets are provided, at least one shall be located with a usable shelf no higher than 44" above the floor. A clear floor space 30" by 48" complying with section 1118b.4 shall be provided in front of a medicine cabinet to allow a forward or parallel approach. (1115b.8.2).
- 14. Where towel, sanitary napkins, waste receptacles, dispensers, or other equipment and controls are provided, show at least one of each type shall be located on an accessible route, with all operable parts, including coin slots, within 40" from the finished floor and shall comply with section 1117b.6. (1115b.8.3).
- 15. Show that toilet tissue dispensers shall be located on the wall within 12" of the front edge of the toilet seat, mounted below the grab bar at a minimum height of 19", and 36" maximum to the far edge from the rear wall. Dispensers that control delivery or that do not permit continuous paper flow shall not be used. (1115b.8.4, fig. 11b-1a).
- 16. Show that toilet room floors shall have a smooth, hard, non-absorbent surface such as portland cement, concrete, ceramic tile or other approved material which extends upward onto the walls at least 5". Walls within water closet compartments and walls within 24" of the front and sides of urinals shall be similarly finished to a height of 48" and, except for structural elements, the materials used in such walls shall be a type which is not adversely affected by moisture. (1115b.3.1.6).
- MULTIPLE ACCOMMODATION SANITARY FACE. GRAB BARS
- 1. Show that grab bars for water closets not located within a compartment shall comply with section 1115b.7 and shall be provided on the side wall closest to the water closed and on the rear wall. (1115b.4.1.3).
- 2. Show that grab bars for water closets located within an accessible compartment shall comply with section 1115b.7 and shall be provided on the side wall closest to the water closet and on the rear wall. (1115b.4.1.3).
- 3. How that grab bars for water closets located within ambulatory accessible compartments shall be provided on both sides of the compartment. (1115b.4.1.3).
- 4. Show that the side grab bars shall be 42" long minimum, located 12" maximum from the rear wall, and extend 54" minimum from the rear wall. The front end shall be positioned 24" minimum in front of the water closet, and shall be securely attached and centered 33" above and parallel to the floor. (1115b.4.1.3.1, fig 11b 1a & 1b).
- 5. Show that the rear grab bars shall be 36" long minimum and extend from the centerline of the water closet 12" minimum on one side and 24" minimum on the other side. The rear grab bar shall be securely attached and centered 33" above and parallel to the floor, except that where a tank-type toilet is used, which obstructs placement at 33", the bar may be as high as 36", with 1 1/2" minimum between the bar and top of tank. 1115b.4.1.3.2, fig 11b-1a).
- 6. Show the diameter or width of the gripping surfaces of a grab bar shall be 1 1/4" to 1 1/2" nominal, or the shape shall provide an equivalent gripping surface. If grab bars are mounted adjacent to a wall, the space between the wall and the grab bars shall be 1 1/2". (1115b.7.1, fig 11b-1c).
- 7. Note that the structural strength of grab bars, tub and shower seats, fasteners, and mounting devices shall meet the following specifications: (1115b.7.2).
 - a. Bending stress in a grab bar or seat induced by the maximum bending moment from the application of a 250 lb. Point load shall be less than the allowable stress for the material of the grab bar or seat. (1115b.7.2.1).
 - b. Shear stress induced in a grab bar or seat by the application of a 250 lb. Point load shall be less than the allowable shear stress for the material of the grab bar or seat, and its mounting bracket or other support is considered to be fully restrained, then direct and torsional shear stresses shall not exceed the allowable shear stress. (1115b.7.2.2).
 - c. Shear force induced in fastener or mounting devices from the application of a 250 b Point load shall be less than the allowable lateral load of either the fastener or mounting device or the supporting structure, whichever has the smaller allowable load. (1115b.7.2.3).
 - d. Tensile force induced in a fastener by a direct tension force of a 250 lb. Point load, plus the maximum moment from the application of a 250-lb point load, shall be less than the allowable withdrawal load between the fastener and supporting structure. (1115b.7.2.4). e. Grab bars shall not rotate within their fittings. (1115b.7.2.5).
- 8. Note that the grab bar and any wall or other surface adjacent to it shall be free of any sharp or abrasive elements. Edges shall have a minimum radius of 1/8". (1115b.7.3).

DRINKING FOUNTAIN (as required by CBC Section 1117B.1)

- Where only one drinking fountain area is provided on a floor, there shall be a drinking fountain which is accessible to individuals who use wheelchairs, and one accessible to those who have difficulty bending or stooping. This can be accommodated by the use of "hi-low" fountains, or by such other means as would achieve the required accessibility for each group on each floor. (1117b.1.1).
- Where more than one drinking fountain is provided on a floor, 50% of those provided shall comply with items 1, 2, 4, and 5 of section 1115b.4.6 and shall be on an accessible route. All drinking fountains shall comply with section 1117b.1.1.
- 3. Shall have a clear knee space between the bottom of the apron and the floor or ground not less than 27" in height, 30" in width, and 8" in depth. The depth shall be taken from the front edge of the fountain back toward the wall or mounting post. (1117b.1.2).
- 4. Note that the knee and toe clearance space shall be free of equipment or obstructions. (2010 CBC 1117b.1.2).
- 5. Show a toe clearance of 9" in height above the floor, and 17" in depth from the front edge of the fountain. (1117b.1.2).
- 6. Show a clear floor space at least 30" by 48" shall be provided in front of the drinking fountain to allow forward approach. A side approach drinking fountain is not acceptable. (1117b.1.2).
- All drinking fountains shall be located completely within alcoves or otherwise positioned so as not to encroach into pedestrian ways. The alcove in which the drinking fountain is located shall not be less than 32" in width and 18" in depth. Protruding objects located in alcoves or encroaching into pedestrian ways are permitted to project 4" into walks, halls, corridors, passageways, or aisles. (1117b.1.3, fig 11b-3).
- 8. Show that the drinking fountain bubbler shall be activated by a manually operated system not requiring a force greater than 5 lbf., that is front mounted or side mounted and located within 6" of the front edge of the fountain or preferably an electronically controlled device. (1117b.1.4, fig 11b-3).
- 9. Note that the bubbler outlet orifice shall be located within 6" of the front of the drinking fountain and shall be within 36" of the floor. The water stream from the bubbler shall be substantially parallel to the front edge of the drinking fountain. (1115b.1.4, fig 11b-3).
- 10. Note that the spout shall provide a flow of water at least 4" high so as to allow the insertion of a cup or glass under the flow of water. On an accessible drinking fountain with a round or oval bowl, the spout must be positioned so the flow of water is within 3" of the front edge of the fountain. (1117b.1.7).

ACCESSIBLE SINKS

- . Where provided, show that accessible kitchen sinks and noncommercial kitchen and counter bar sinks shall have a clear floor space at least 30" by 48" complying with 1118b.4 and providing a forward approach. The clear floor space shall be on an accessible route and shall extend a maximum of 19" underneath the sink. (1115b.4.3.1, fig 11b-1d).
- 2. Show that each accessible sink shall be a maximum of 6 1/2" deep. Sinks shall be mounted with the counter or rim no higher than 34" above the finish floor. Show knee clearance that is at least 27" high, 30" wide, and 19" deep under sinks. (1115b.4.3.2, item
- Note that hot water and drain pipes exposed under sinks shall be insulated or otherwise configured so as to protect against contact. There shall be no sharp or abrasive surfaces under sinks. (1115b.4.3.4, item 1).
- 4. Note that faucet controls and operating mechanisms shall be operable with one hand and shall not require tight grasping, pinching, or twisting of the wrist. The force required to activate controls shall be not greater than 5 lbs. Lever-operated, push-type, and electronically controlled mechanisms are examples of acceptable designs. (1115b.4.3.1, item 1).
- Note that self-closing faucet control valves are allowed if the faucet remains open for at least 10 seconds. (1115b.4.3.1, item 1).

RAMPS (EXTERIOR OR INTERIOR)


- 1. Any path of travel shall be considered a ramp if its slope is greater than 1' rise in 20' of horizontal run. (1133b.5.1).
- 2. The maximum slope of a ramp that serves any exit way, provides access for persons with physical disabilities, or is in the accessible route of travel shall be 1 foot rise in 12 feet of horizontal run (8.3 percent gradient). The least possible slope shall be used for any ramp. (1133b.5.3).
- 3. The cross slope of ramp surfaces shall be no greater than 1:50. (1133b.5.3.1).
- 4. Pedestrian ramps shall have a minimum clear width of 48", unless required to be wider by some other provision of this code. (1133b.5.2) (1133b.5.2).
- Where a pedestrian ramp is the only exit discharge path serving entrances to buildings or when it serves an occupant load of 300 or more, the ramp shall have a minimum clear width of 60". (1133b.5.2).
- 6. Level landings shall be provided at the top and bottom of each ramp. (1133b.5.4.1, fig. 11b-38 & 39). Intermediate landings shall be provided at intervals not exceeding 30" of vertical rise and
- at each change of direction. (1133b.5.4.1, fig 11b-38 & 39). Top landings shall be not less than 60" wide and shall have a length of not less than 60" in the direction of ramp run. Landings at the bottom of ramps shall have a dimension in the


direction of ramp run of not less than 72". (1133b.5.4.2, fig. 11b-38 & 39).


- 9. Doors in any position shall not reduce the minimum dimension of the landing to less than 42" and shall not reduce the required width by more than 3" when fully open. (1133b.5.4.3, fig 11b-39(b)).
- 10. The width of the landing shall extend 24" past the strike edge of any door or gate for exterior ramps and 18" past the strike edge for interior ramps. (1133b.5.4.4, fig. 11b-39).
- 11. All ramp landings shall be level with maximum slope in any direction not to exceed 1/4" per foot (2.083 percent slope). (1133b.5.4.1, 1102b).
- 12. At bottom and intermediate landings, the width shall be at least the same as required for the ramp. (1133b.5.4.5, fig 11b-38 & 39).
- 13. Intermediate and bottom landings at a change of direction in excess of 30 degrees shall have a dimension in the direction of ramp run of not less than 72" to accommodate the handrail extension. (1133b.5.4.6, fig 11b-38).
- 14. Other intermediate landings shall have a dimension in the direction of ramp run of not less than 60". (1133b.5.4.7, fig 11b-38).
- 15. Handrails are required on ramps that provide access if the ramp slope exceeds 1 foot rise in 20 feet of horizontal run (5 percent gradient), except that at exterior door landings, handrails are not required on ramps less than 6" rise or 72" in length. (1133b.5.5.1).
- 16. Handrails shall be placed on each side of each ramp, shall be continuous the full length of the ramp, shall be 34 to 38" above the ramp surface to the top of the handrails, shall extend a minimum of 1 foot beyond the top and bottom of the ramp, and shall parallel the floor or ground surface. Handrails shall always be continuous and the ends of handrails shall be either rounded or returned smoothly to the floor, wall or post. (1133b.5.5.1, fig 11b-27(b) & (c)).
- 17. The grip portion of handrails shall be not less than 1 1/4" nor more than 1 1/2" in cross sectional nominal dimension, or the shape shall provide an equivalent gripping surface, and all surfaces shall be smooth with no sharp corners. Handrails shall not rotate within their fittings. (1133b.5.5.1, fig 11b-36).
- 18. Handrail projecting from a wall shall have a space of 1 1/2" between the wall and the handrail. (1133b.5.5.1, fig. 11b-36).
- a. Handrails may be located in a recess if the recess is a maximum of 3" deep and extends at least 18" above the top of the rail. (1133b.5.5.1, fig. 11b-36).
- b. Any wall or other surface adjacent to handrails shall be free of sharp or abrasive elements. Edges shall have a minimum radius of 1/8 i inch. (1133b.5.5.1, fig. 11b-36)
- 19. Where the ramp surface is not bounded by a wall, the ramp shall comply with one of the following requirements. (1133b.5.6, fig. 11b-27(b) & (c)). a. A guide curb a minimum of 2" in height shall be provided at each side of the


ramp; (1133b.5.6.1) or

- b. A wheel guide rail shall be provided, centered 3", plus or minus 1 inch above the surface of the ramp. (1133b.5.6.2).
- 20. In existing buildings or facilities where the extension of the handrail in the direction of the ramp run would create a hazard, the extension may be turned 90 degrees to the run of the ramp. (1133b.5.5.1.1, 1133b.4.2.4).
- 21. Ramps more than 30" above the adjacent ground shall be provided with guards that comply with section 1013. Such guards shall be continuous from the top of the ramp to the bottom of the ramp. (1133b.5.7).

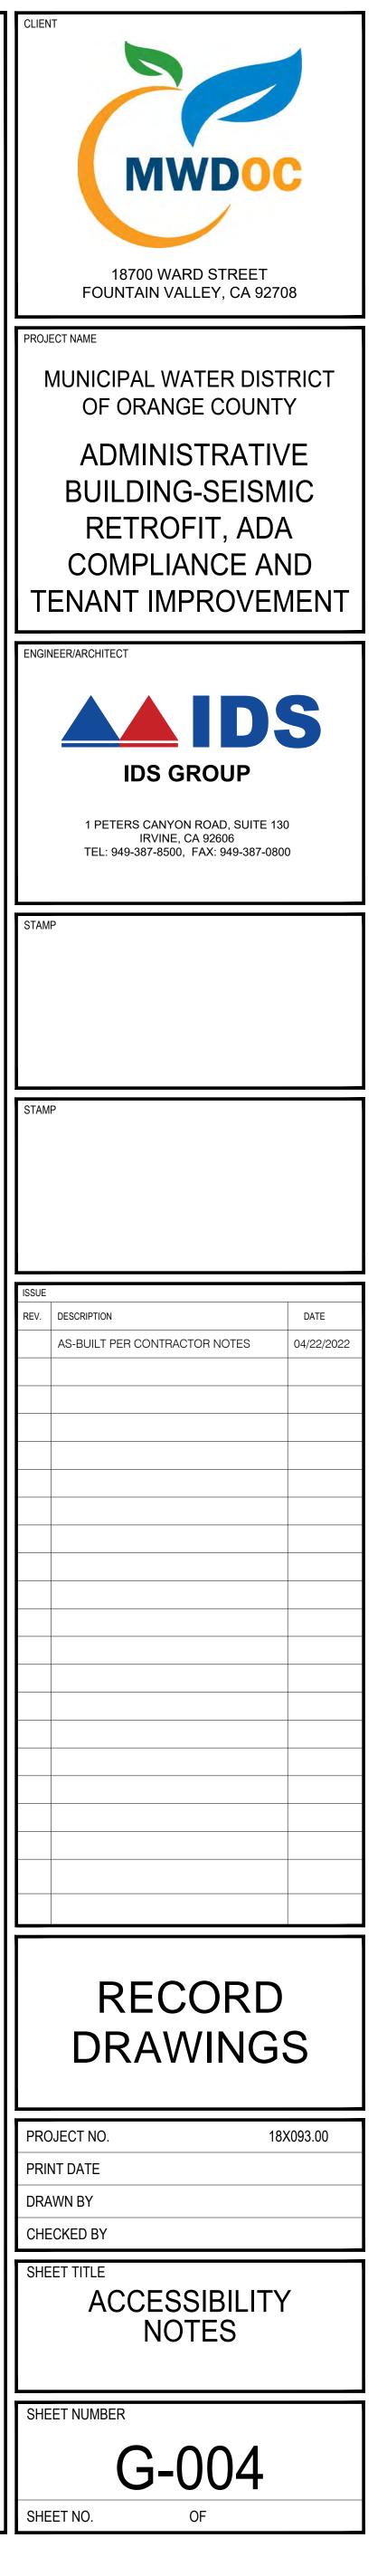

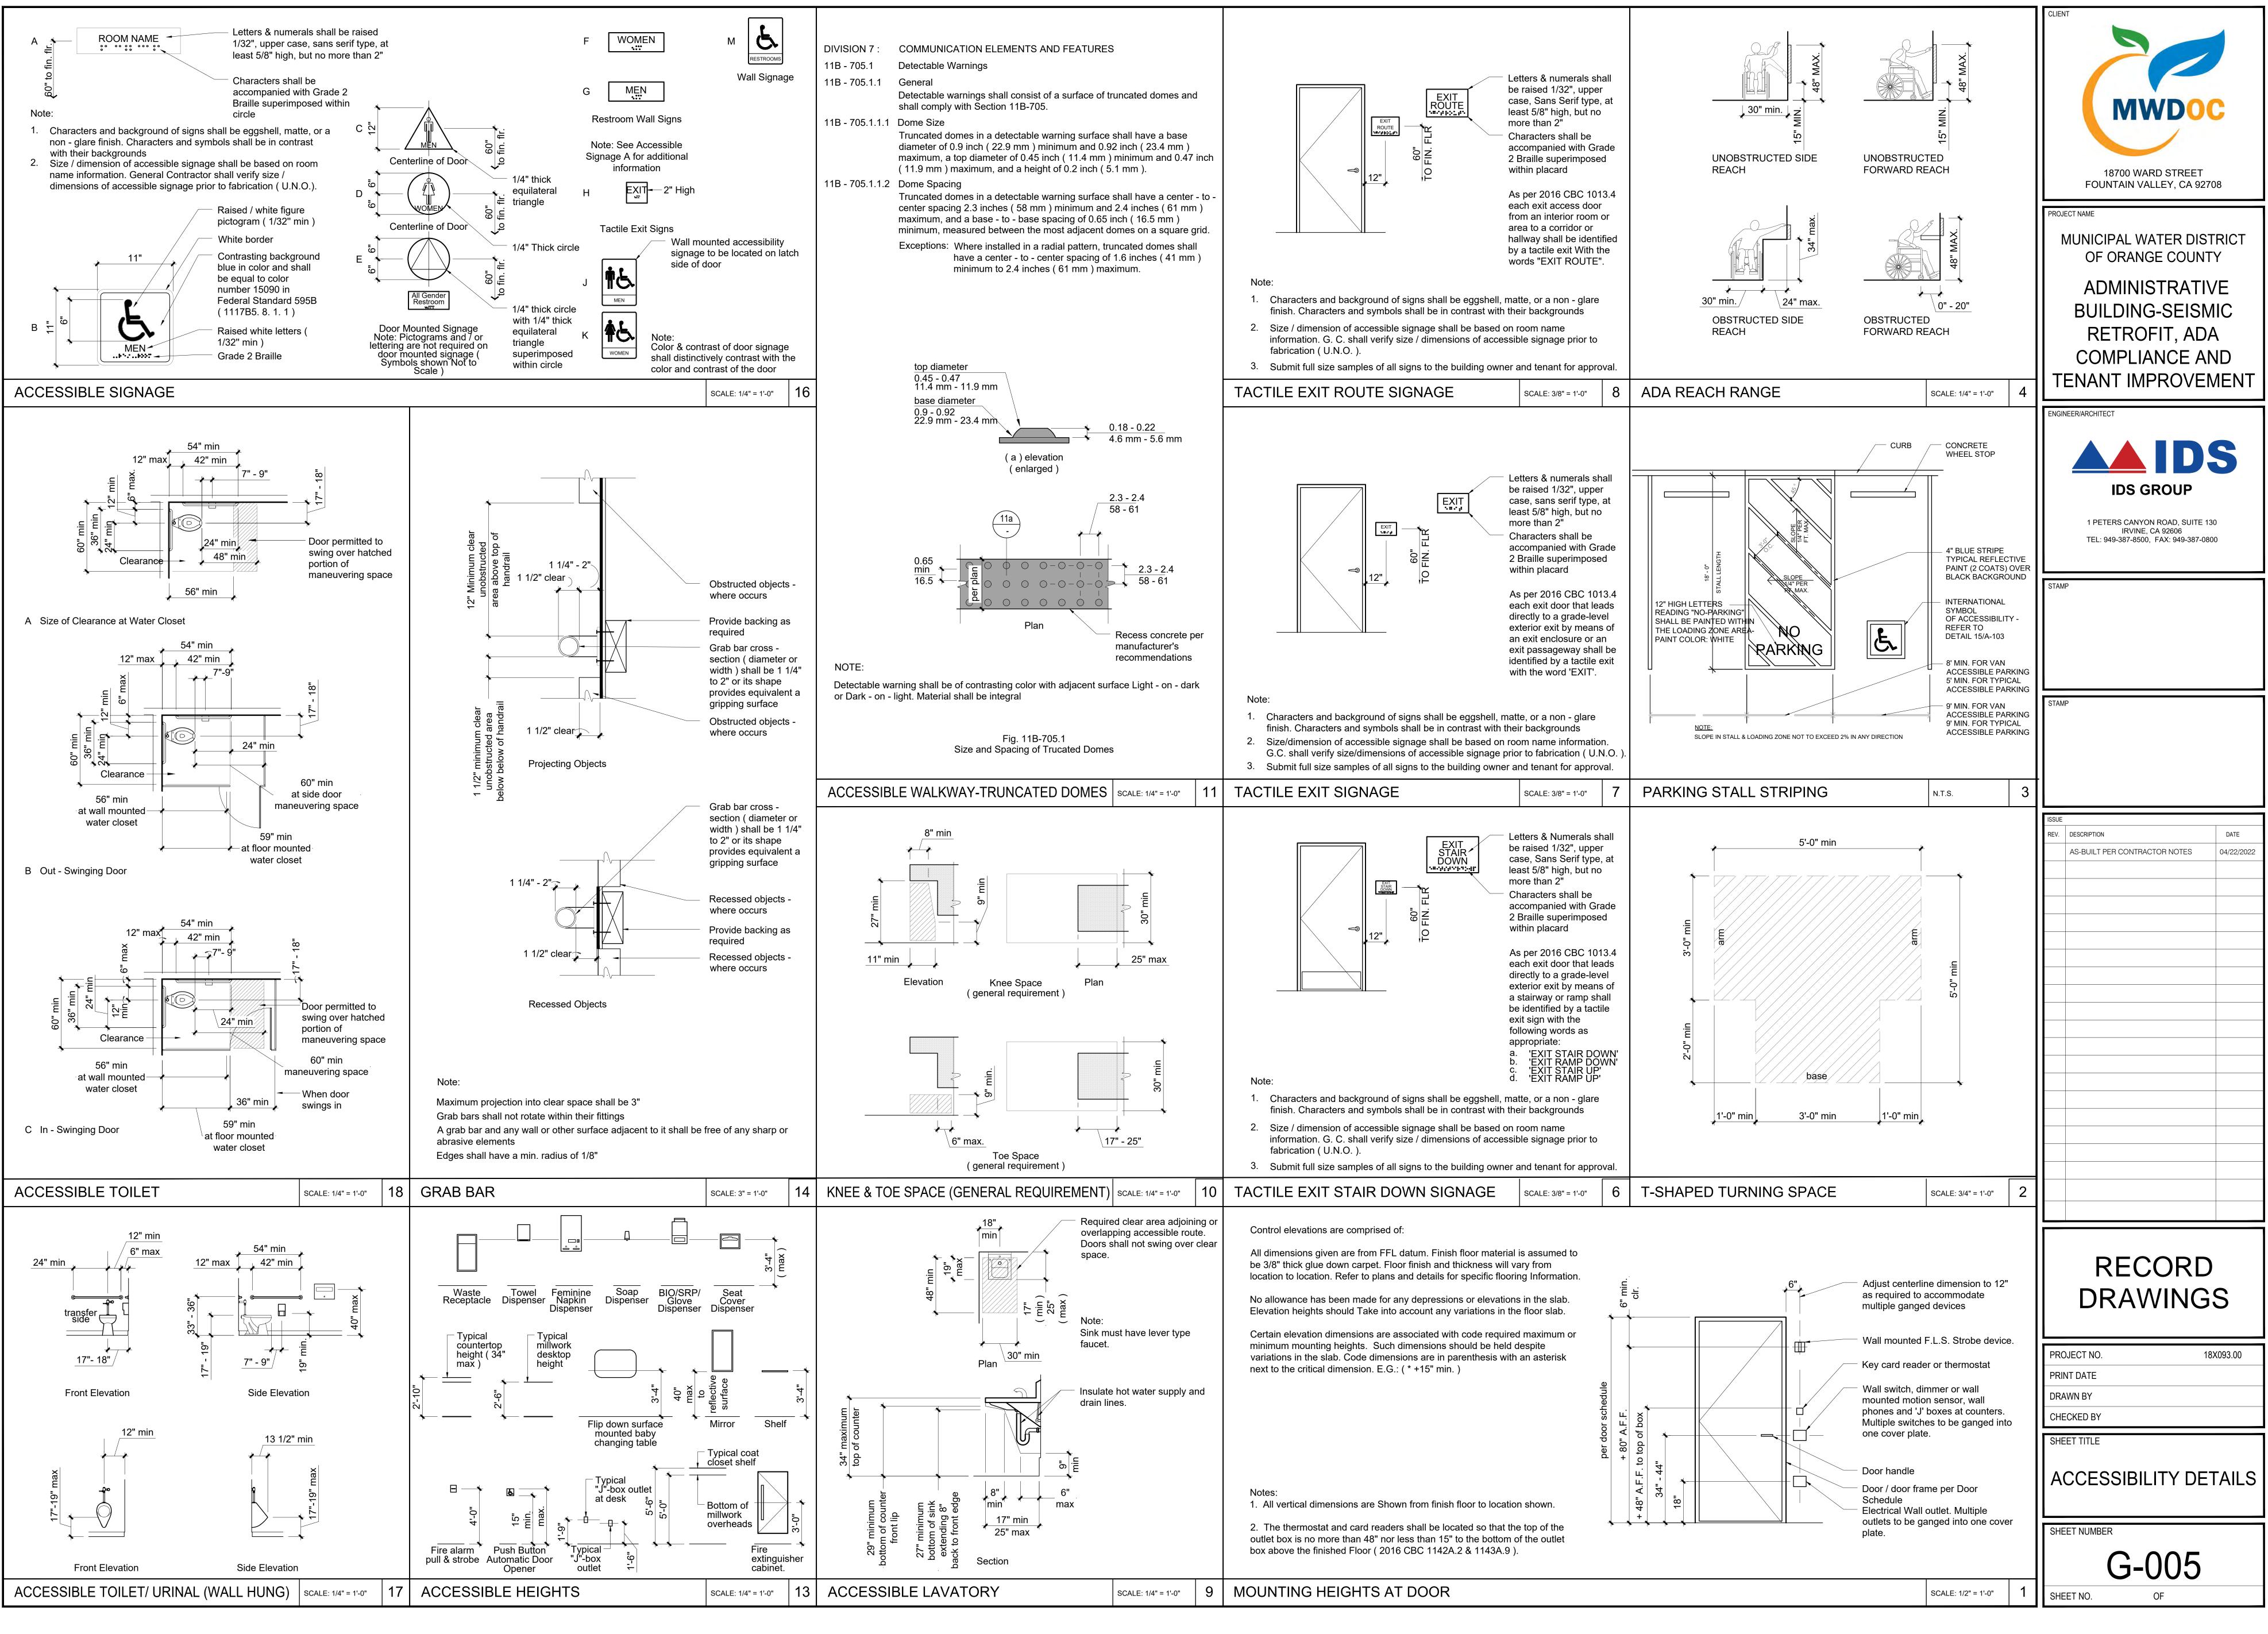


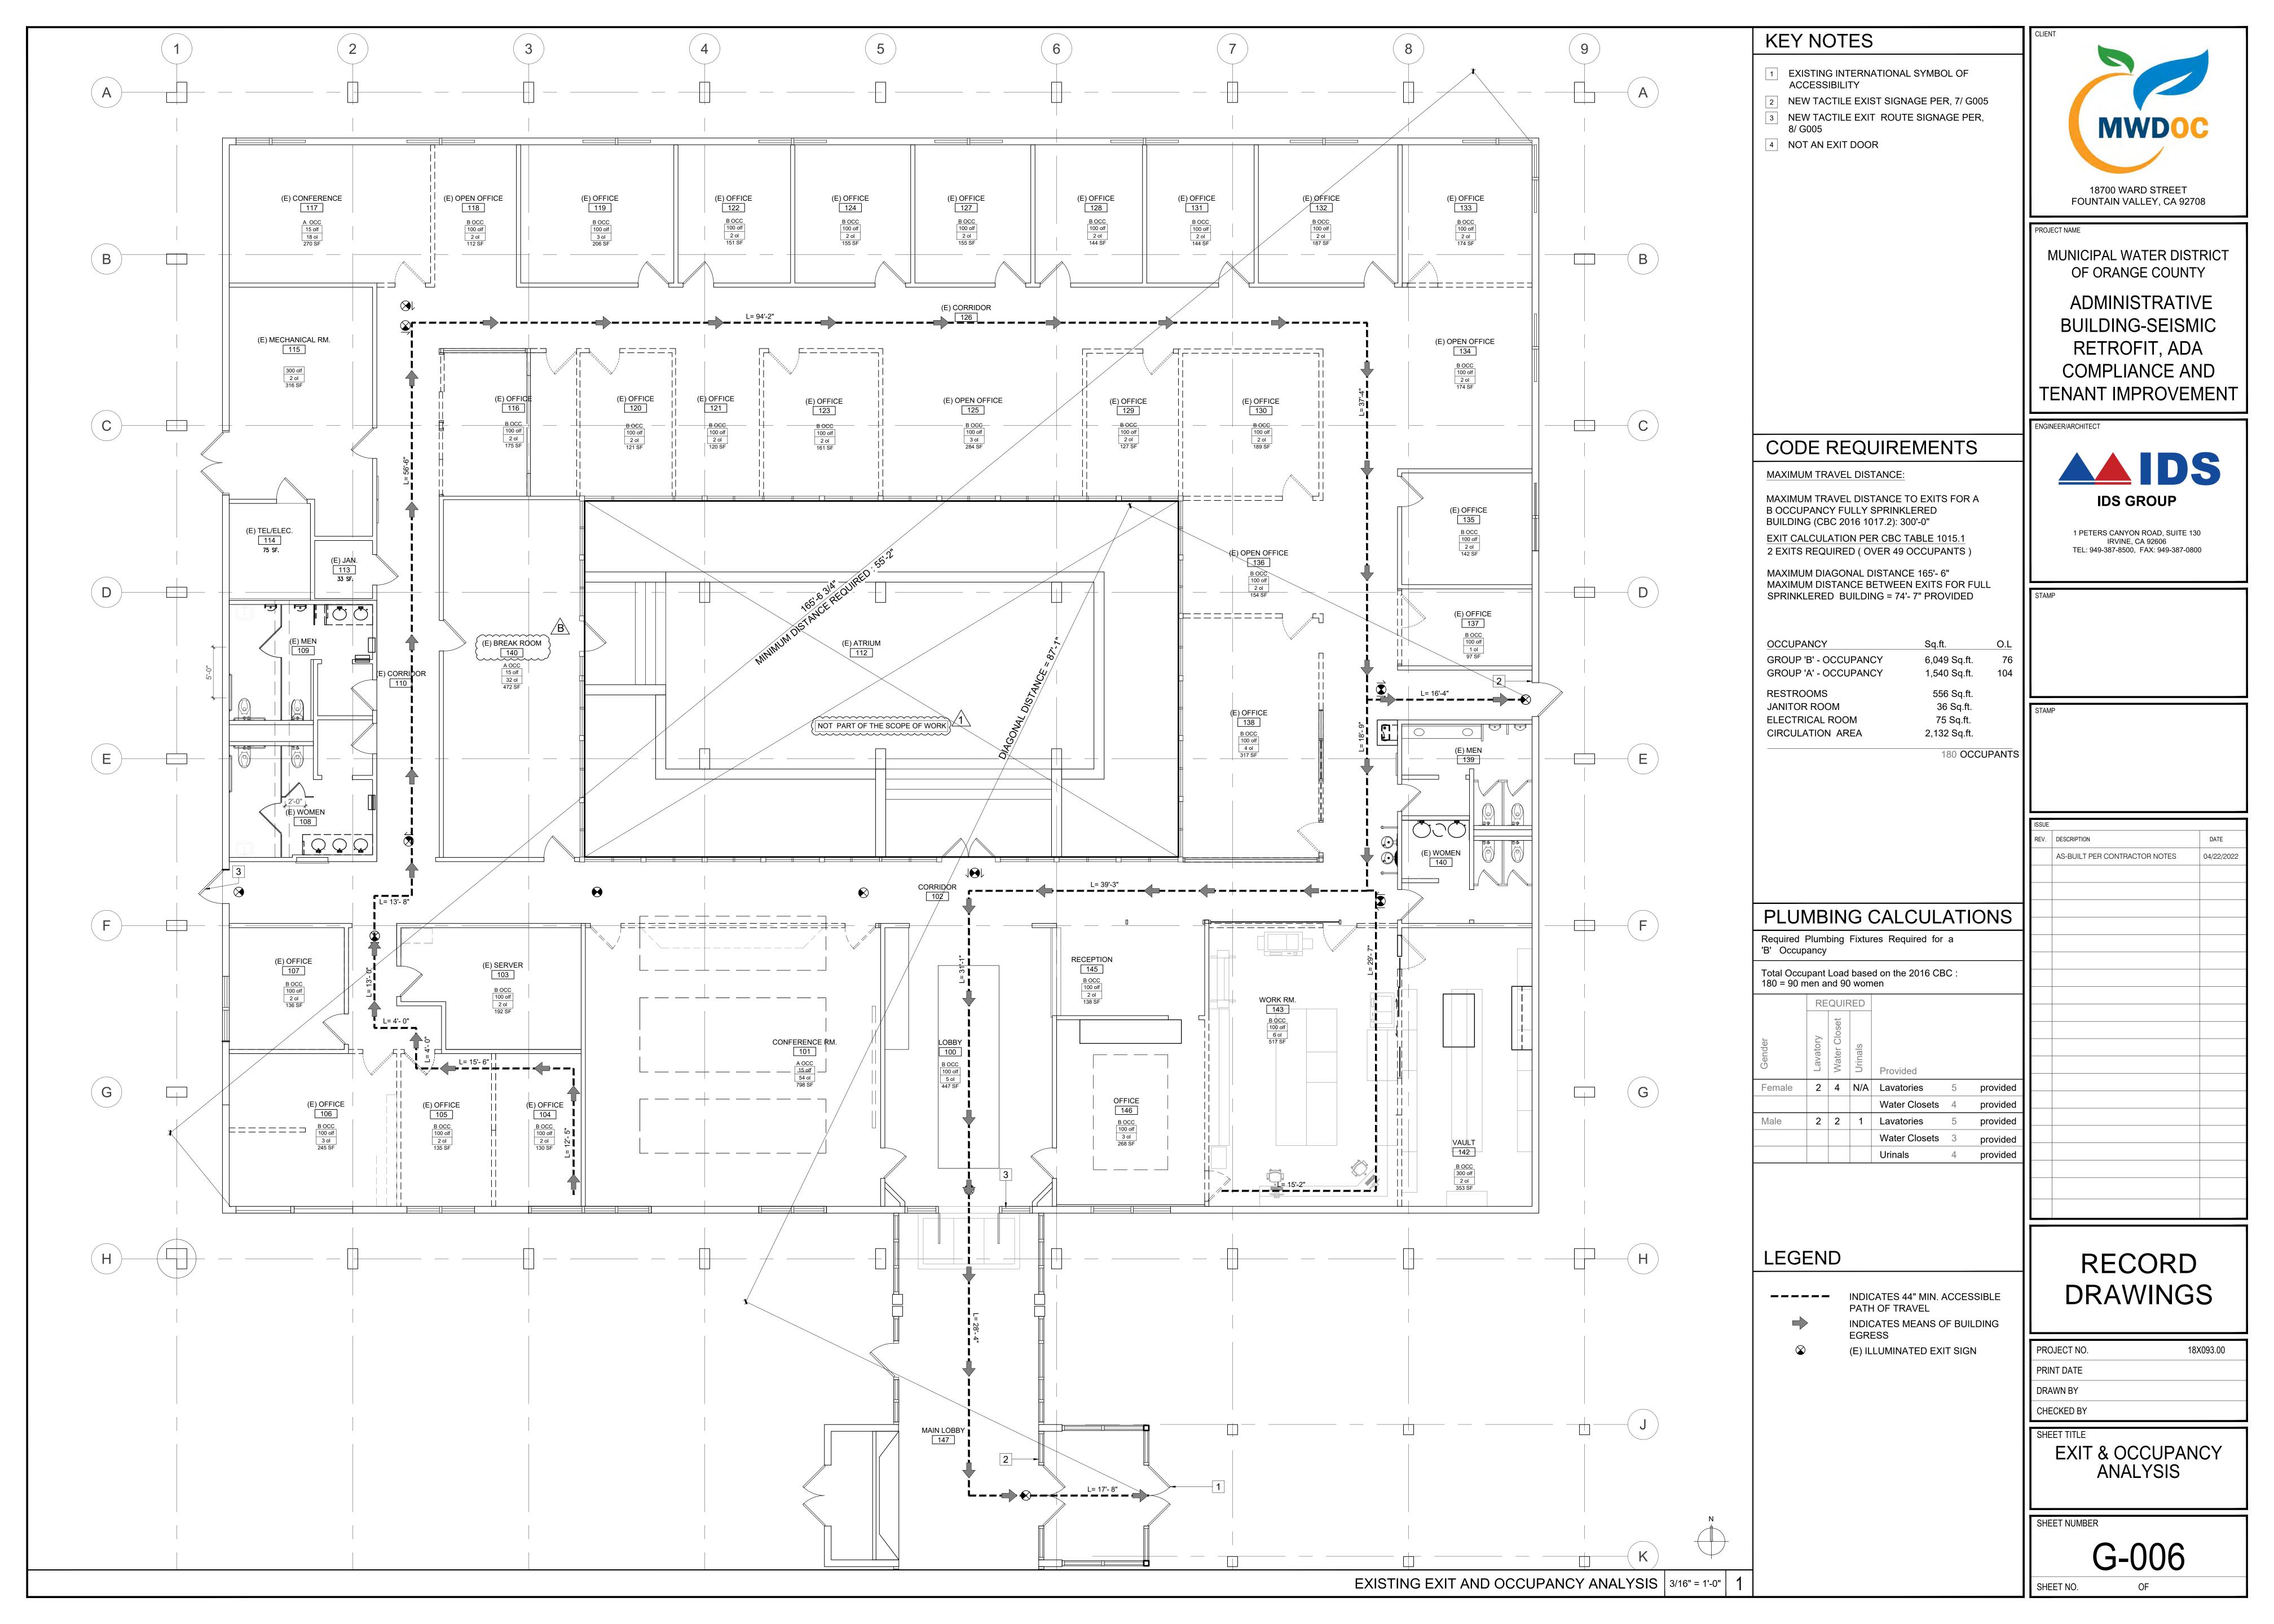


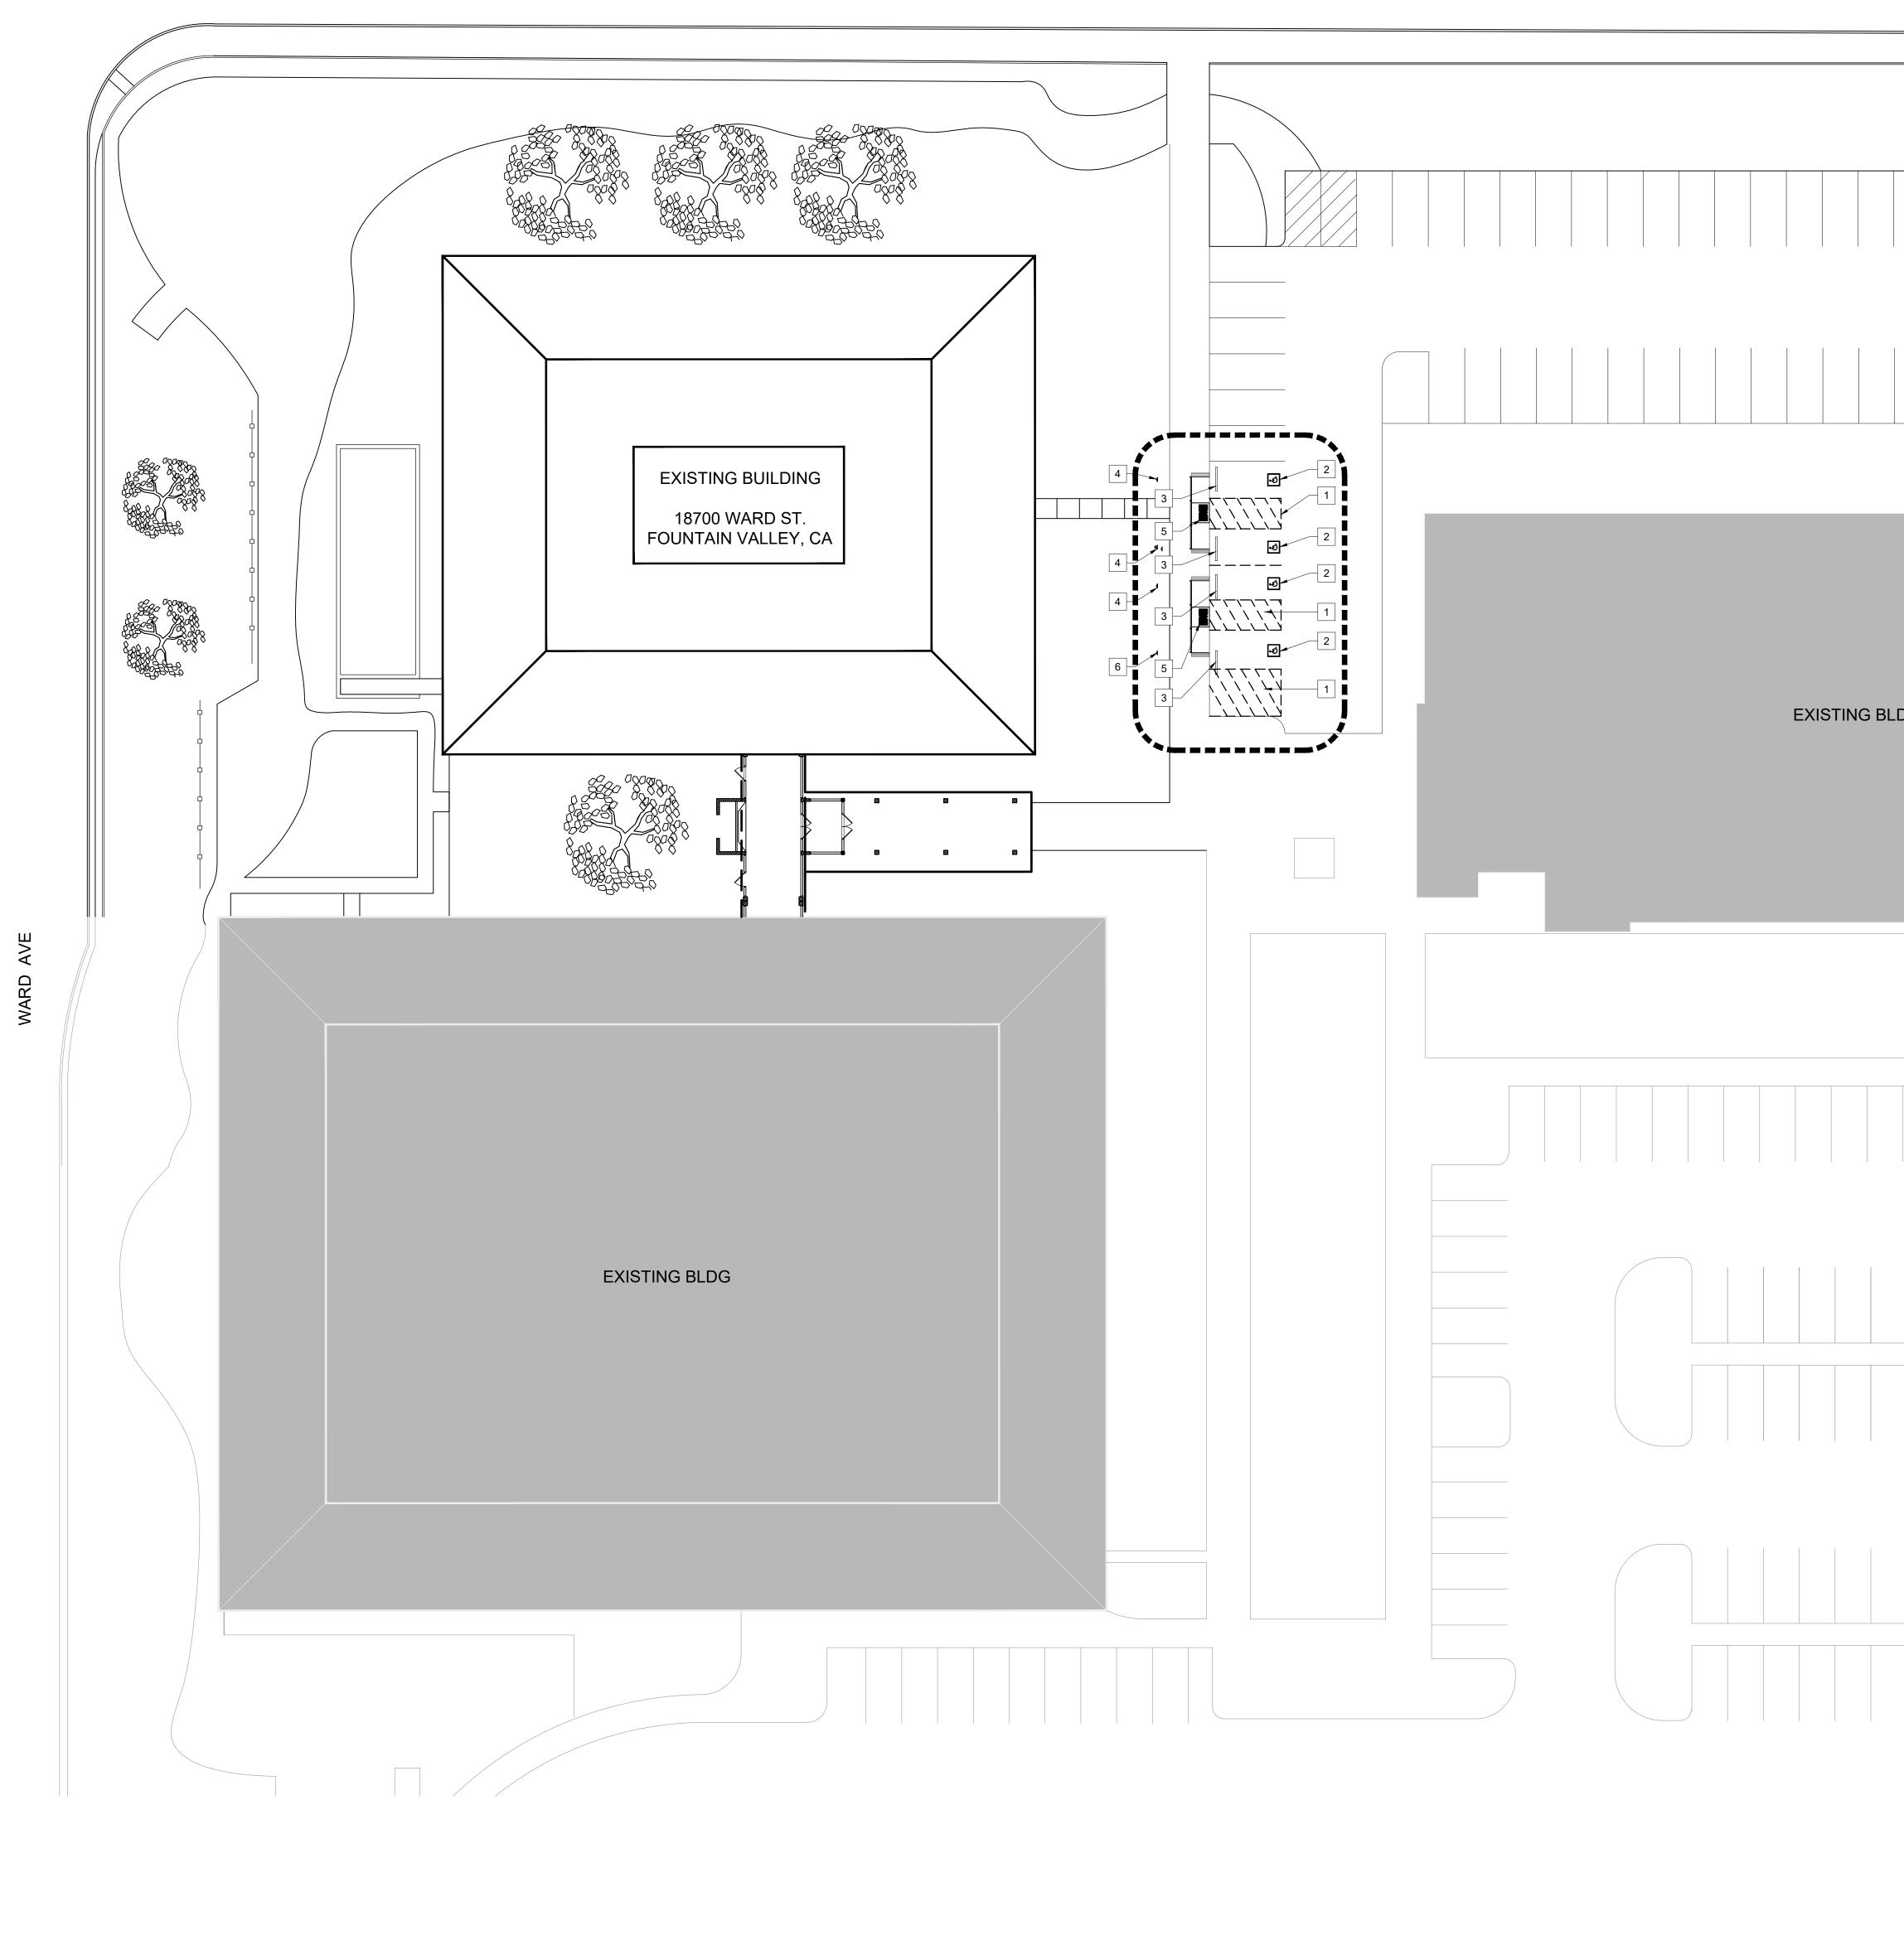


ELLIS AVE

	KEYNOTES
	(E) PARKING LOT FLOOR MARKS TO BE REMOVED
	2 (E) INTERNATIONAL SYMBOL OF ACCESSIBILITY TO BE REMOVED
	3 (E) CONCRETE WHEEL STOP TO BE REMOVED FOR REUSE
	4 (E) ACCESSIBILITY SIGN TO REMAIN
	5 (E) TRUNCATED DOMES TO BE REMOVED
	6 (E) ACCESSIBILITY SIGN TO BE REMOVED, POST TO REMAIN
	GENERAL NOTES
	- CONTRACTOR TO CLEAN ALL AREA OF THE PARKING LOT PAVEMENT AFTER WORK HAVE BEEN DONE
	- THE DISCHARGE OF POLLUTANTS TO ANY STORM DRAINAGE SYSTEM IS PROHIBITED. NO SOLID
	WASTE PETROLEUM BYPRODUCTS, SOIL PARTICULATE, CONSTRUCTION WASTE MATERIALS
	OR WASTE WATER GENERATED ON CONSTRUCTION SITE OR BY CONSTRUCTION
	ACTIVITIES SHALL BE PLACED, CONVEYED OR DISCHARGE INTO THE STREET OR STORM DRAIN SYSTEM.
OG	
	LEGEND
	INDICATES THE AREA OF WORK/DEMOLITION
	ĨĨ
SITE DEMOLITION PLAN 1" = 20' 1	

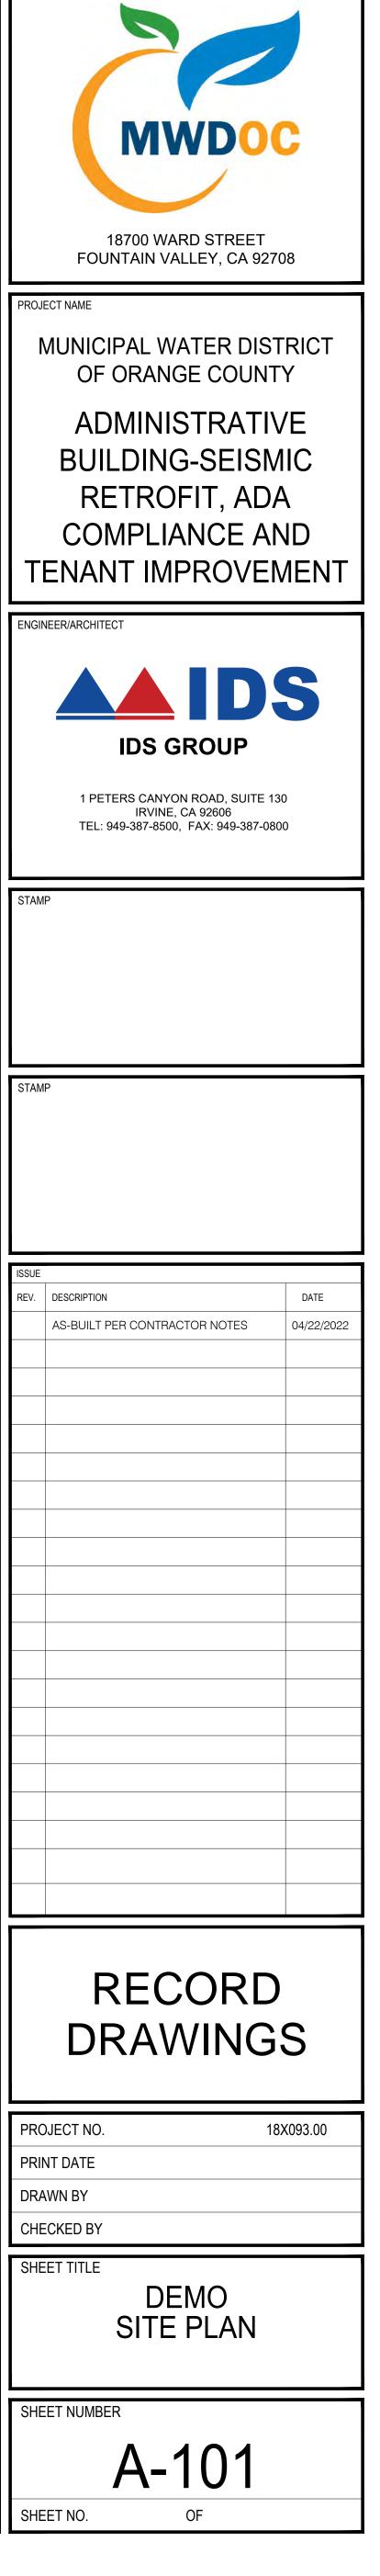

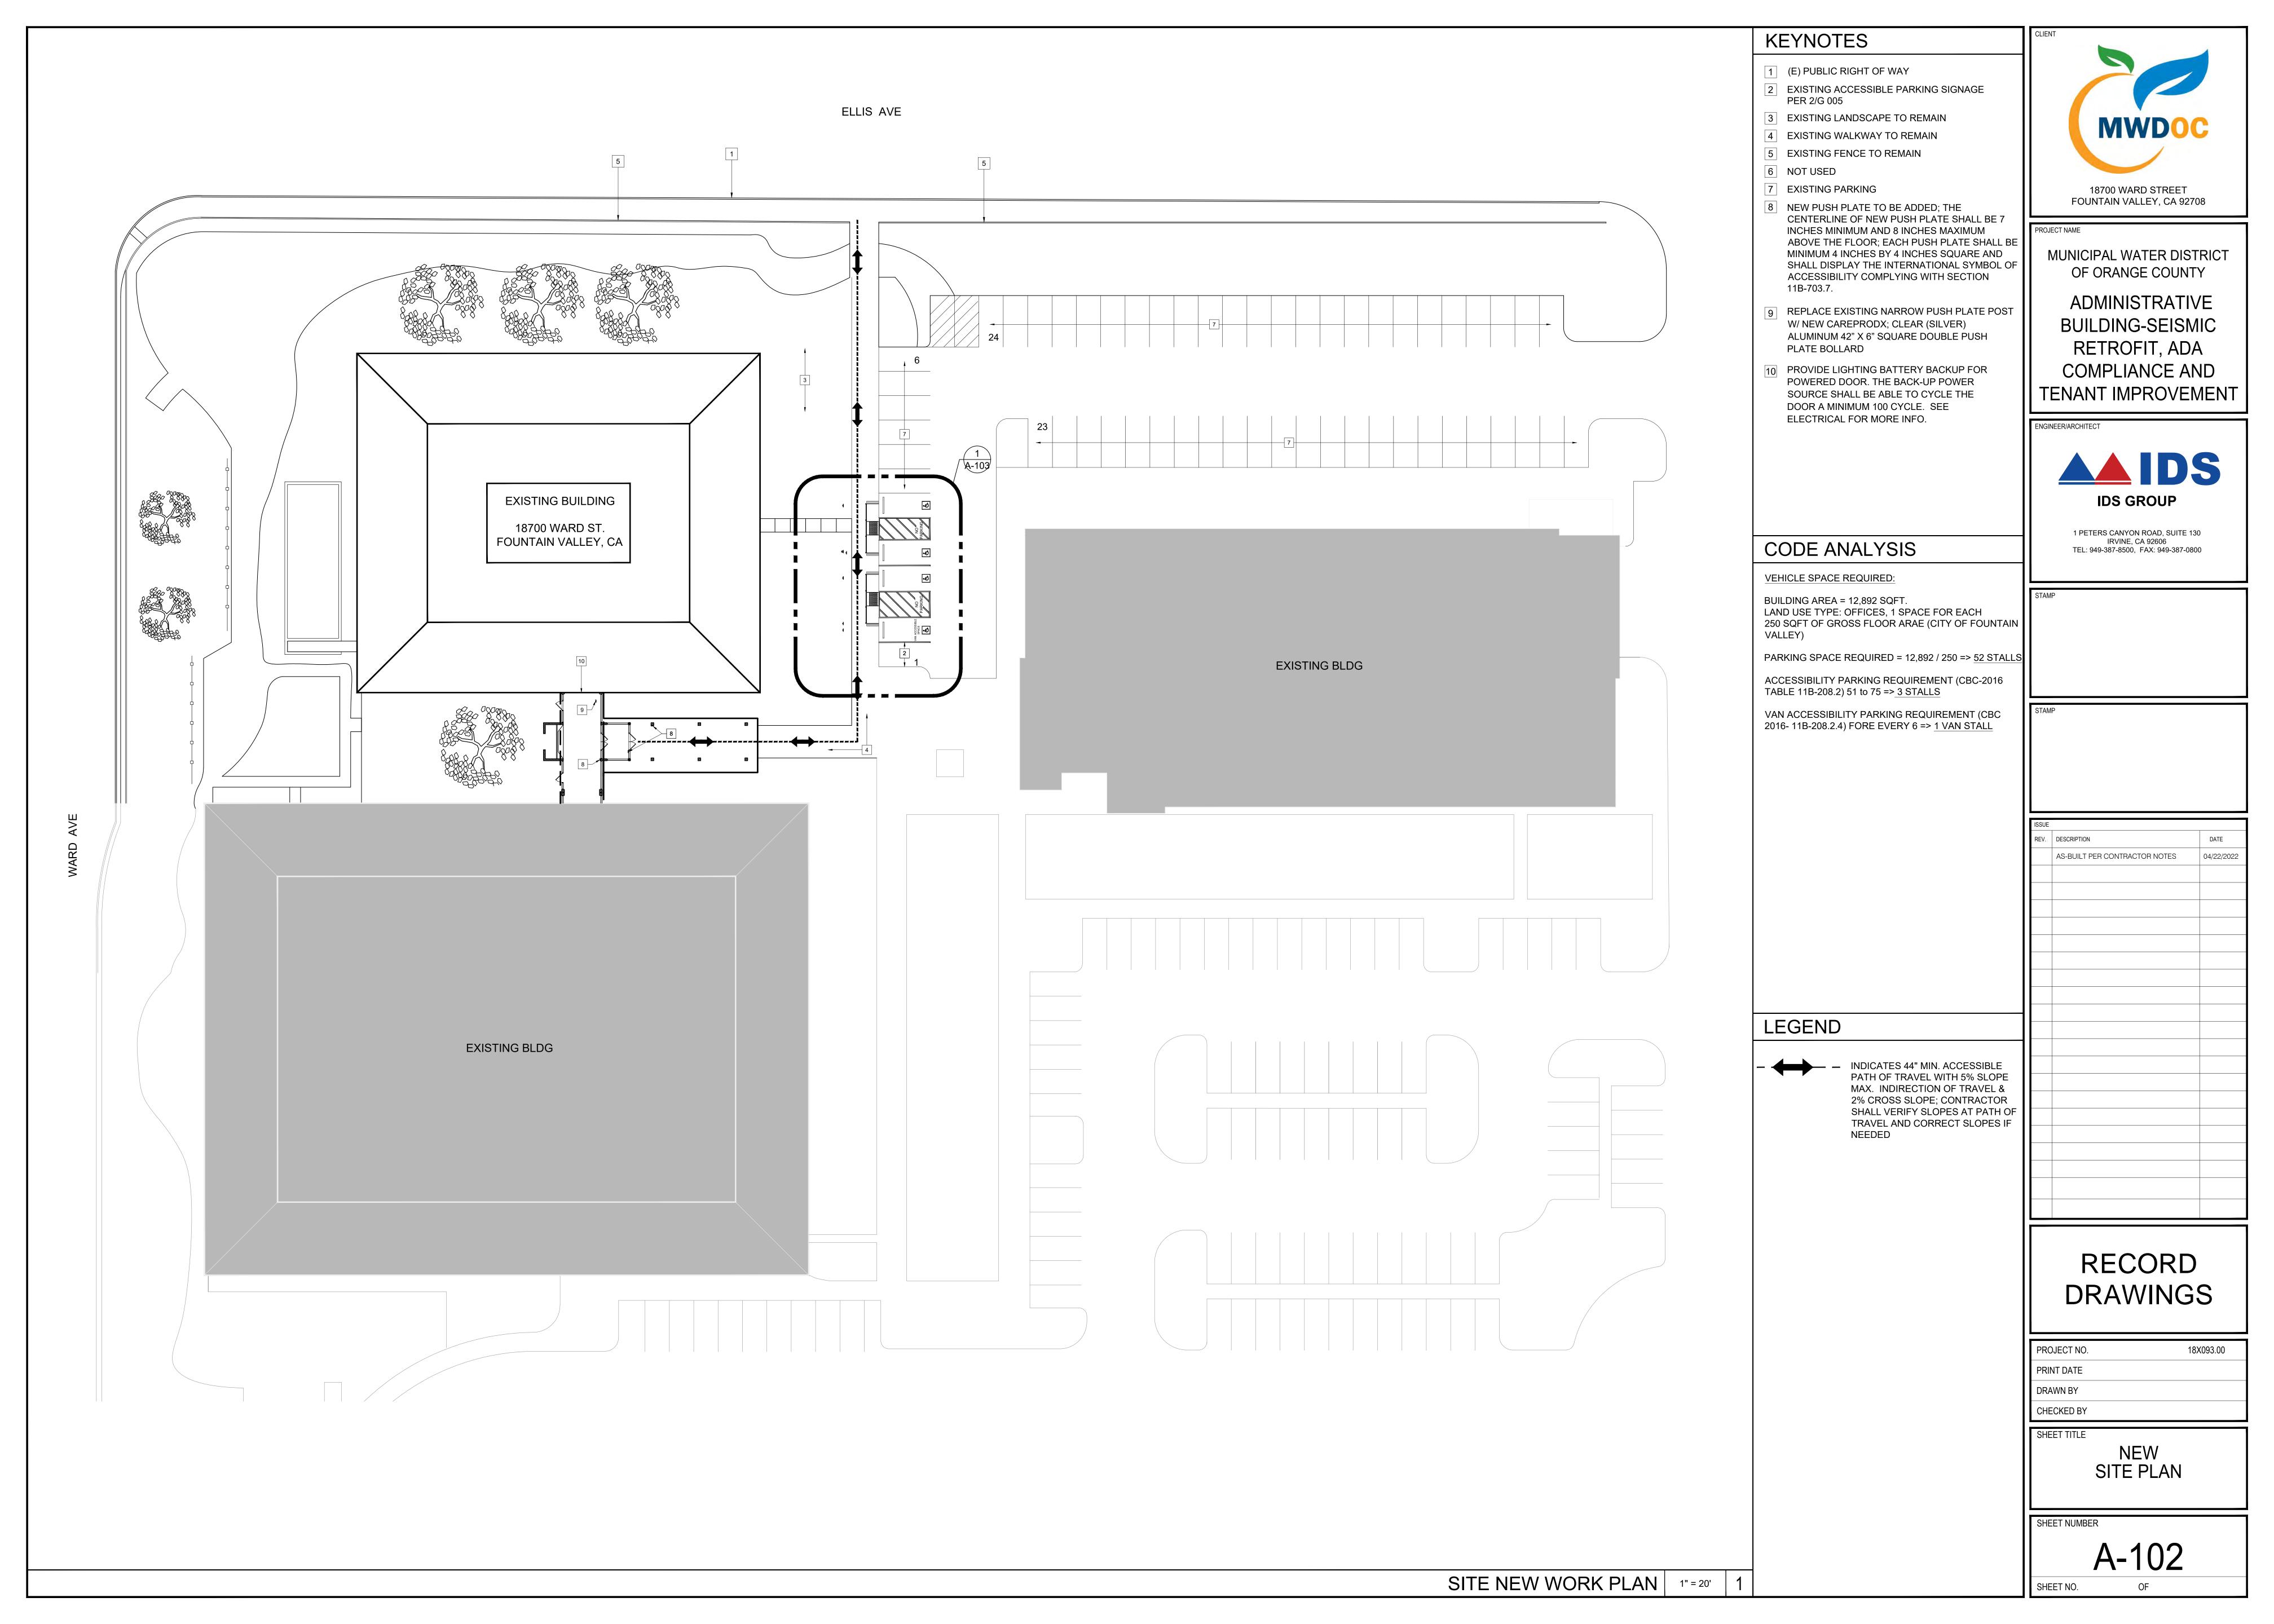

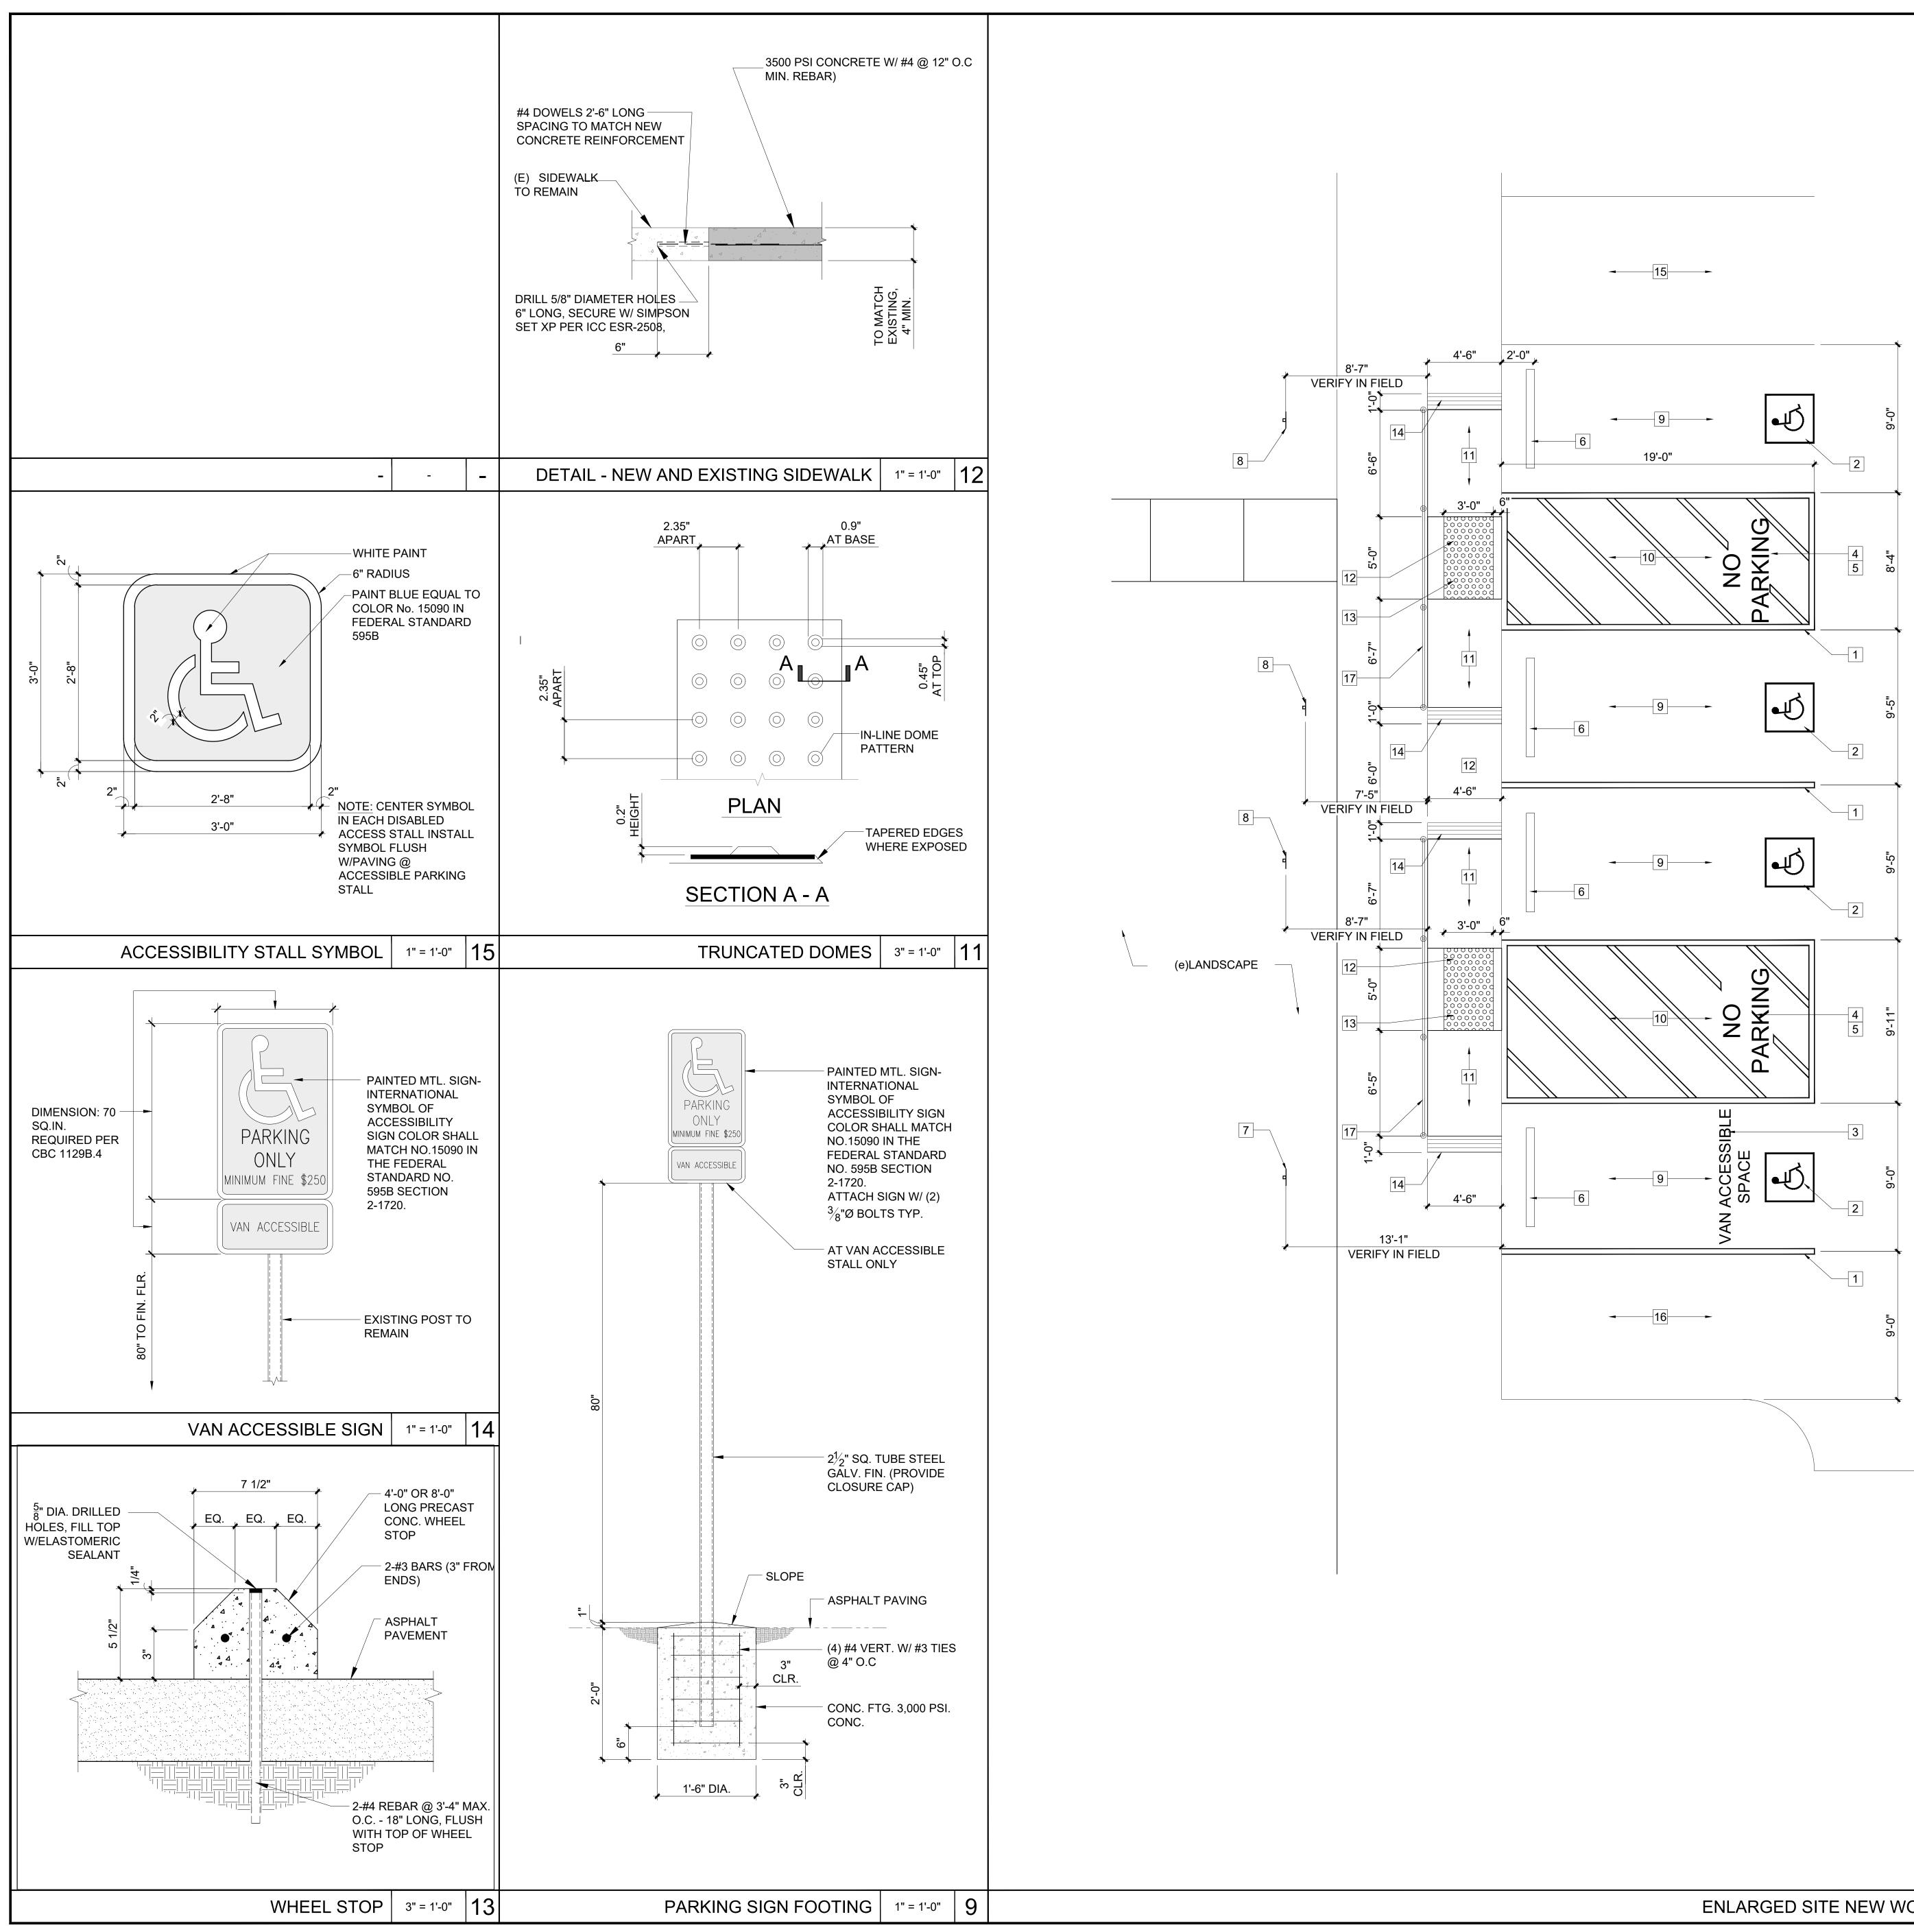





KEYNOTES


- 1 4" WIDE MARKING INTERNATIONAL SYMBOL OF ACCESSIBILITY,
- 2 36"x36", COLOR BLUE, SEE DETAIL 15/-
- 3 LETTERING "VAN ACCESSIBLE", COLOR WHITE
- 4 PARKING STALL MARKING SEE DETAIL 3/G005
- 5 LETTERING " NO PARKING", 12" MIN. HEIGHT, COLOR WHITE
- 6 CONCRETE WHEEL STOP, SEE DETAIL 13/-
- IDENTIFICATION SIGN FOR ACCESSIBLE VAN
- PARKING, SEE DETAIL 9/A103 & 14/A103
- 8 EXISTING IDENTIFICATION SIGN FOR ACCESSIBLE PARKING TO REMAIN
- 9 ACCESSIBLE PARKING STALL, SLOPE IN ALL DIRECTION 1:48 MAX.
- 10 ACCESS AISLE SEE DETAIL 3/ G-005
- (E) CONCRETE RAMP, SLOPE 1:12 MAX, AND CROSS SLOPE 1:48 MAX.
- 12 LEVEL LANDING AREA
- 13 TRUNCATED DOMES, SEE DETAIL 11/-, PROVIDE CONCRETE SUB-BASE PER DETAIL 12/-
- 14 DETECTABLE WARNING GROOVE
- 15 (E) PARKING STALL
- 16 PARKING STALL
- 17 (E) GUARD RAILING TO REMAIN


GENERAL NOTES

- 1. SEE SHEET G-005 FOR ADDITIONAL ACCESSIBILITY DETAILS
- 2. CONCRETE SPECIFICATIONS A. CONCRETE SIDEWALK SHALL BE 4" THICK B. FORM EDGES WITH NEAT TROWELED CORNER C. FC'=3,000 PSI MINIMUM; SUBMIT MIX DESIGN FOR REVIEW PRIOR TO CONSTRUCTION
 - D. REINFORCE WITH #4 BARS AT 12" EACH WAY CENTERED IN THE SLAB
 - E. PROVIDE $\frac{1}{8}$ "X1" DEEP TROWELED CRACK CONTROL JOINT AT MAXIMUM SPACING OF 2X SLAB WIDTH; REINFORCING SHALL BE CONTINUOUS THROUGH JOINTS
- F. PROVIDE $\frac{1}{2}$ " FULL DEPTH EXPANSION JOINT (NOMACO NOMAFLEX OR EQUAL WITH HIGH GRADE SEALANT INFILL AT $\frac{1}{2}$ "X $\frac{1}{2}$ " TOP VOID) AT SPACING NO GREATER THAN 3X SLAB WIDTH
- G. BROOM FINISH

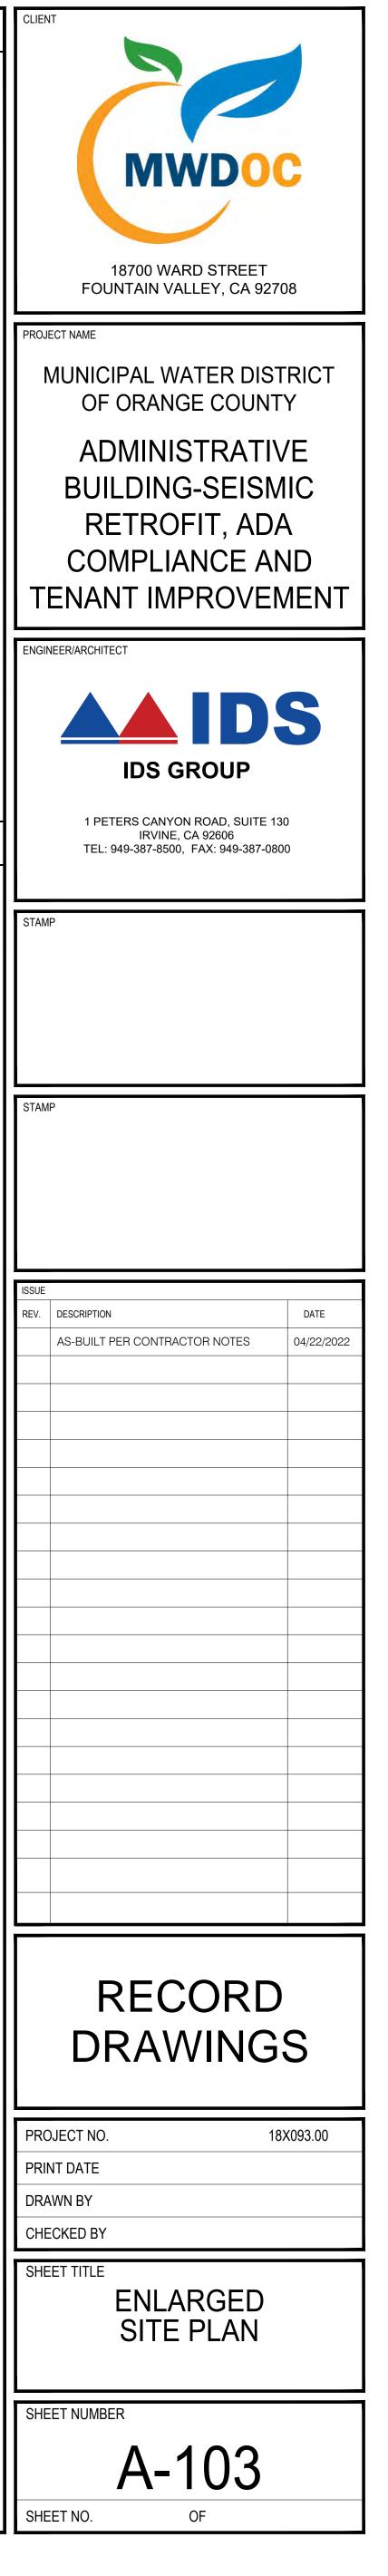

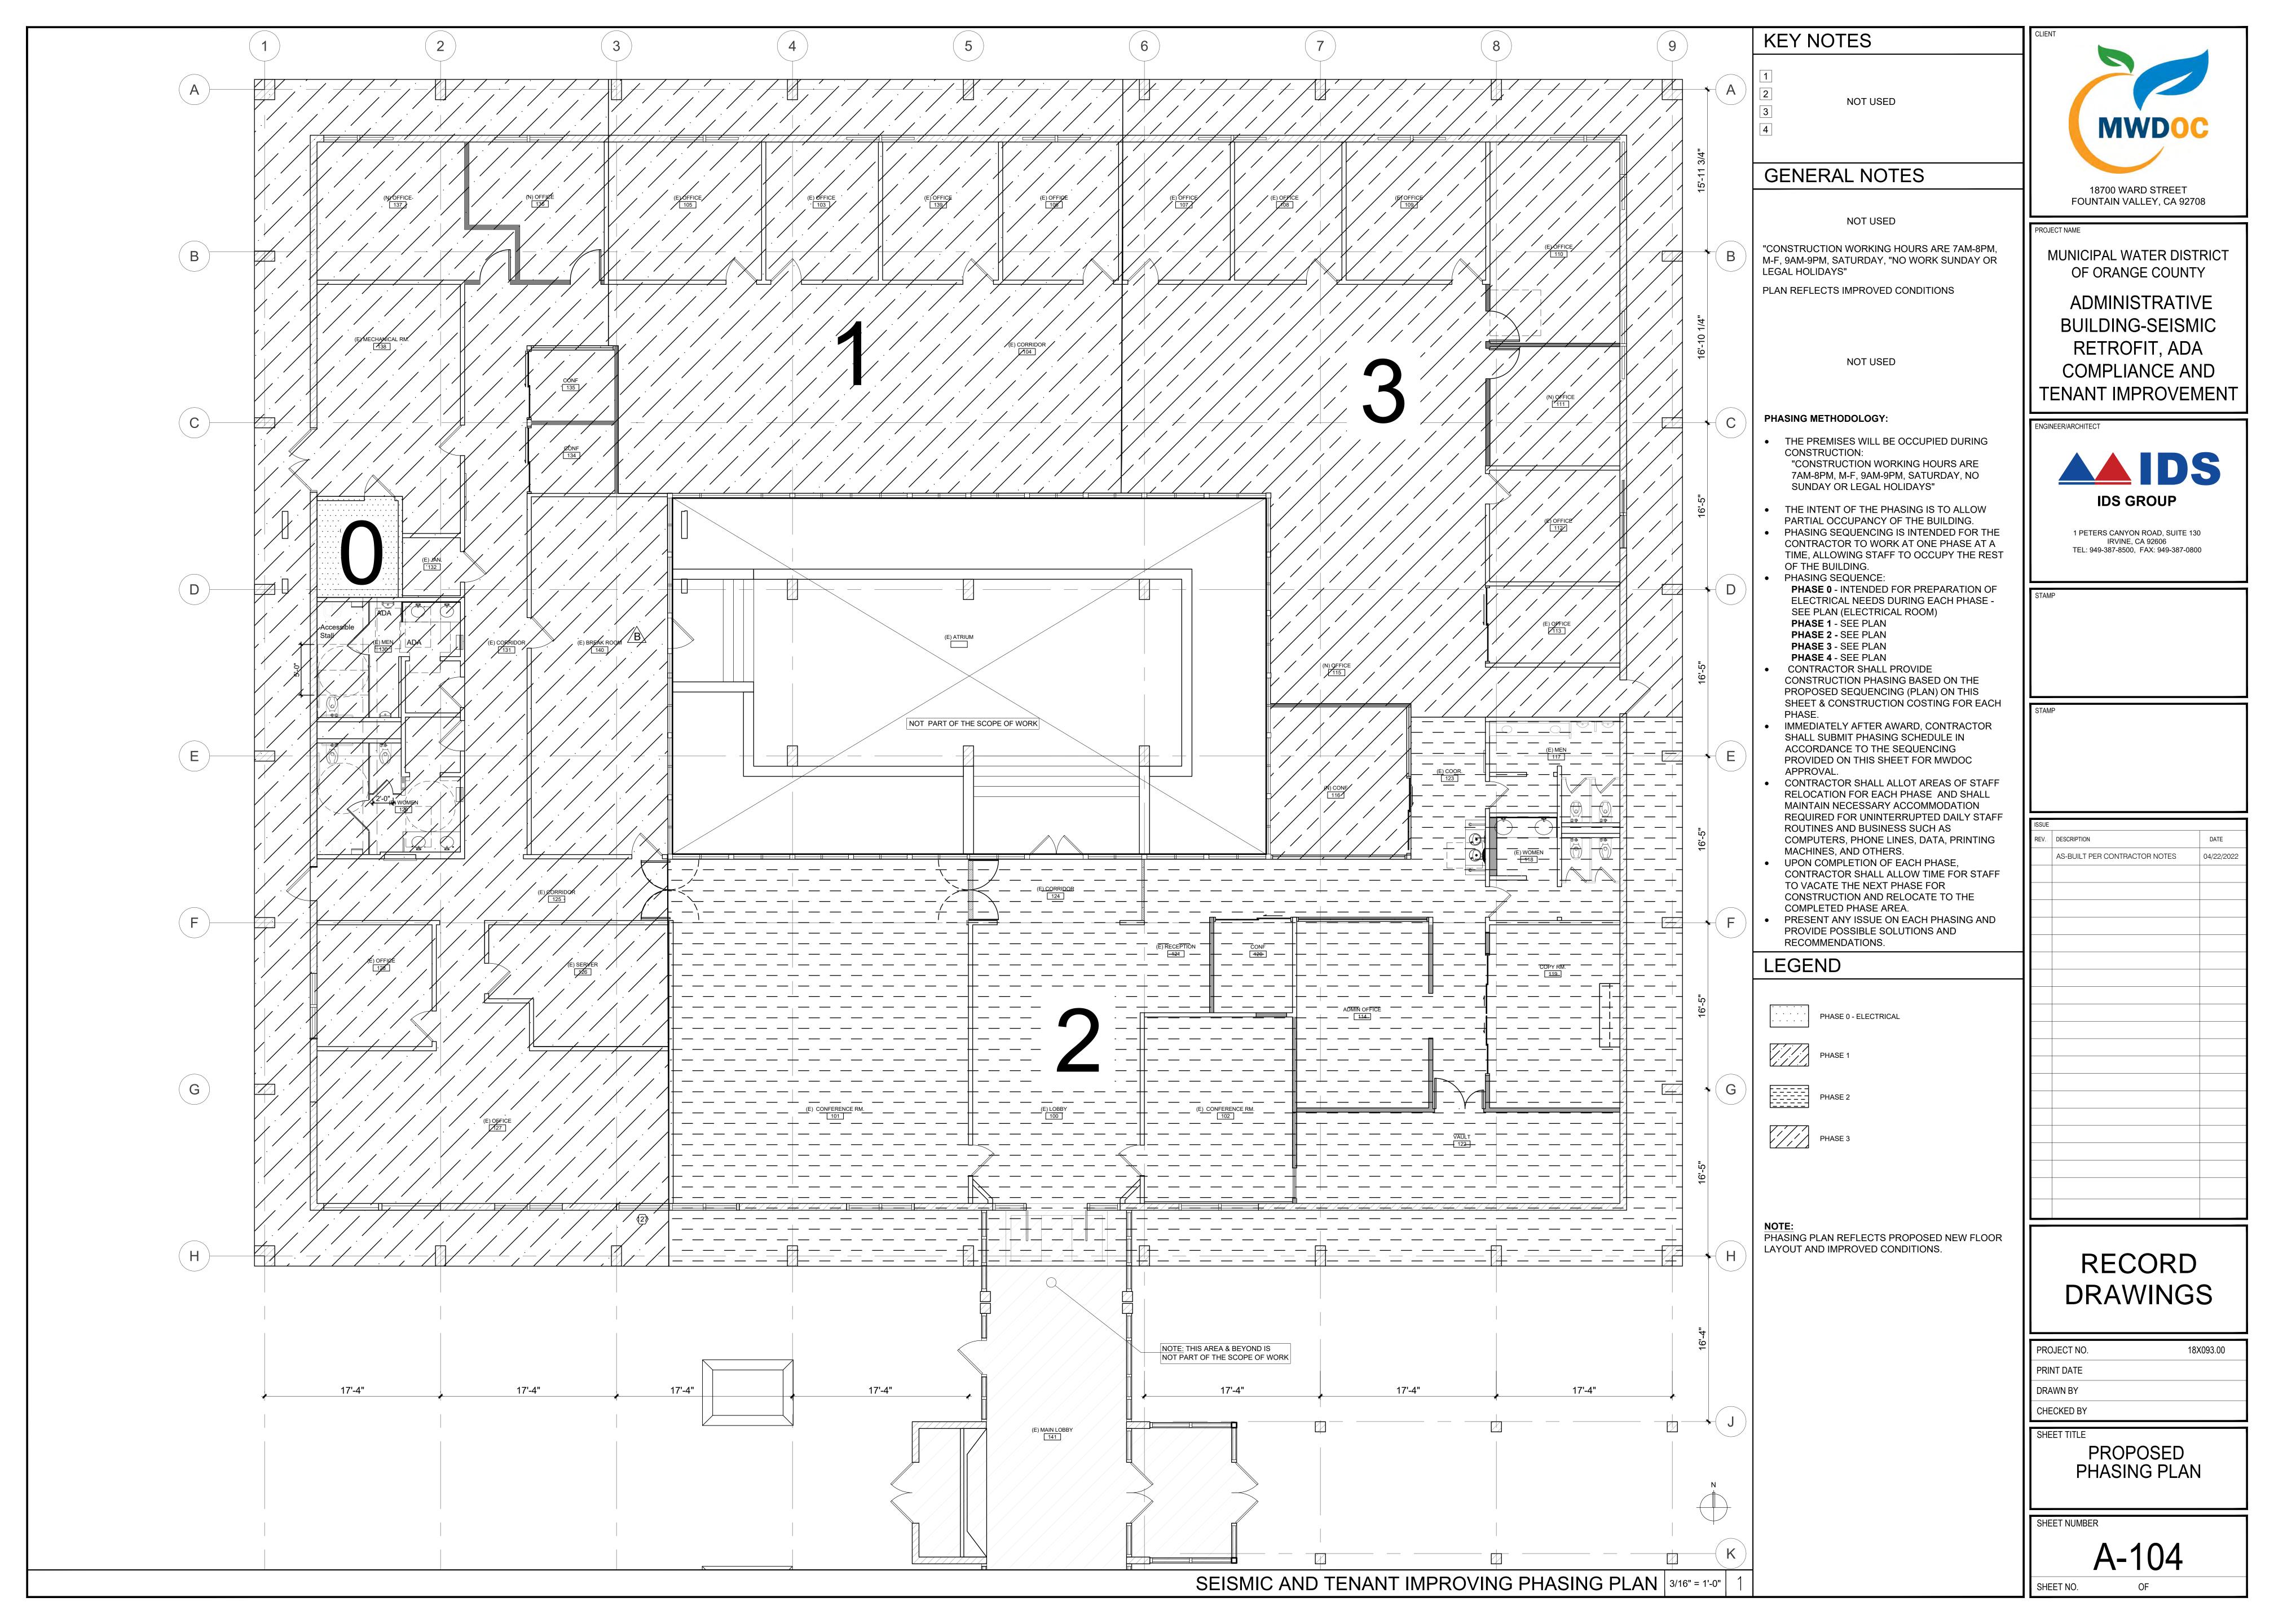

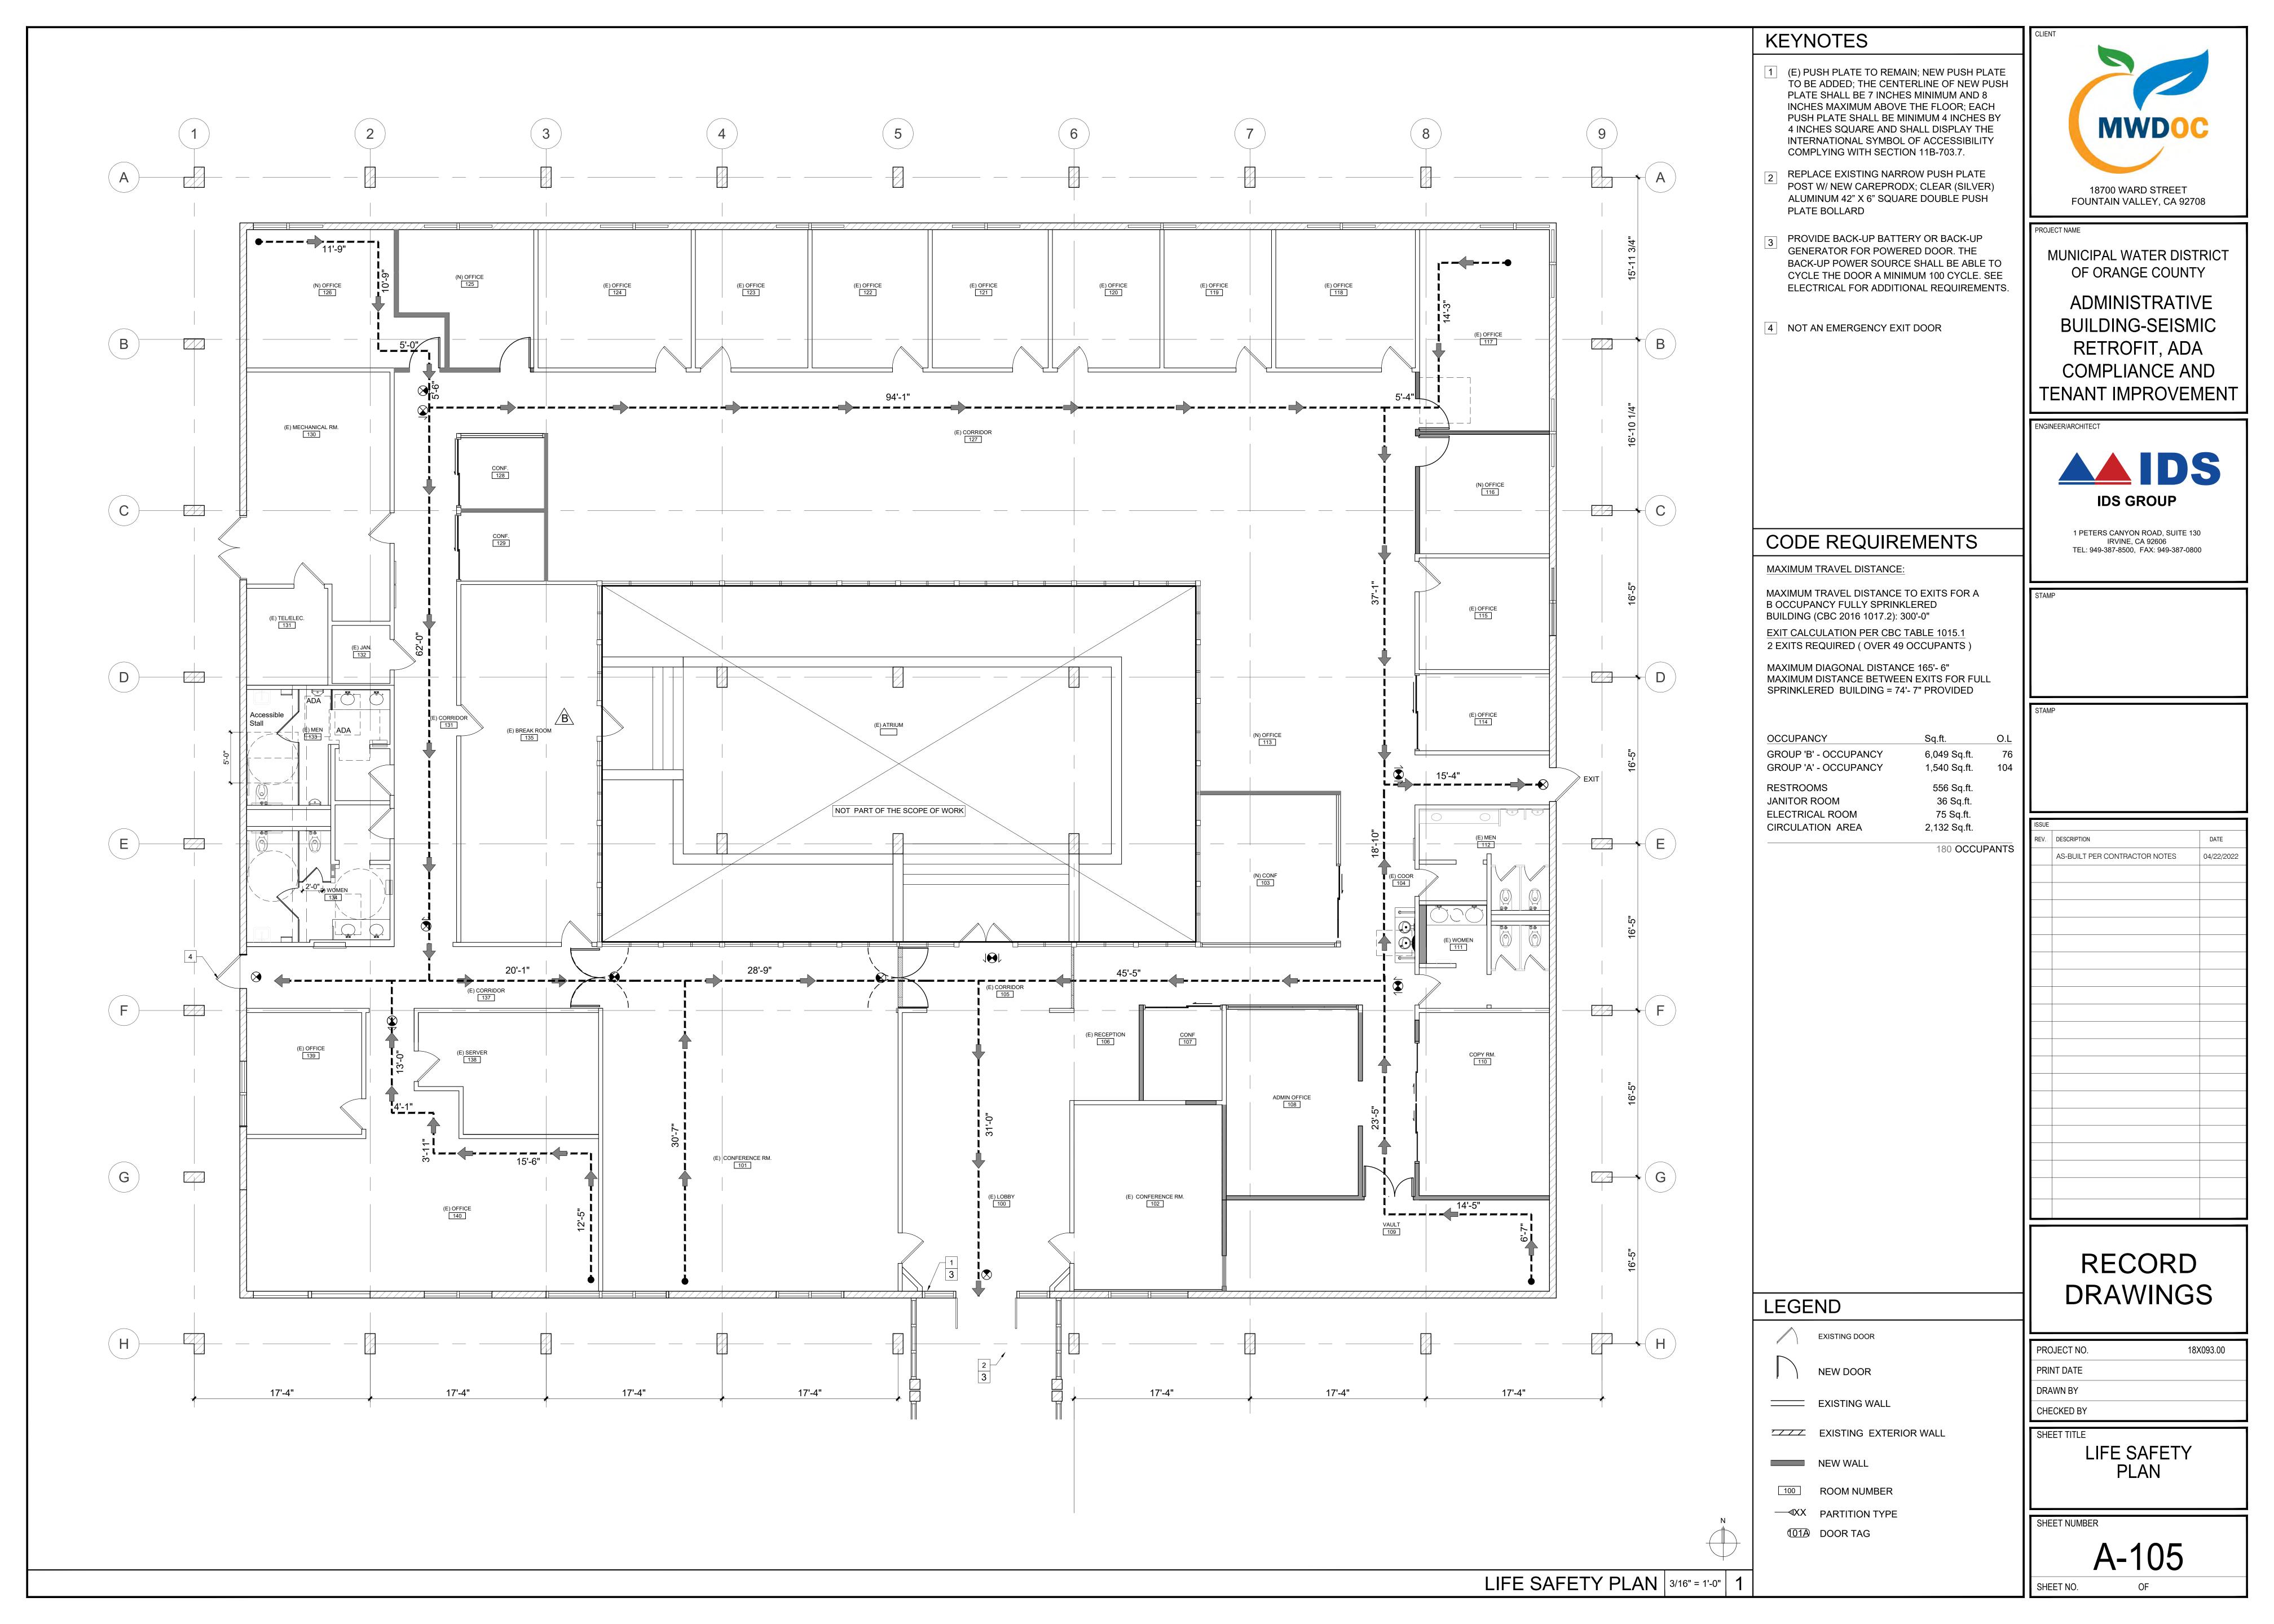


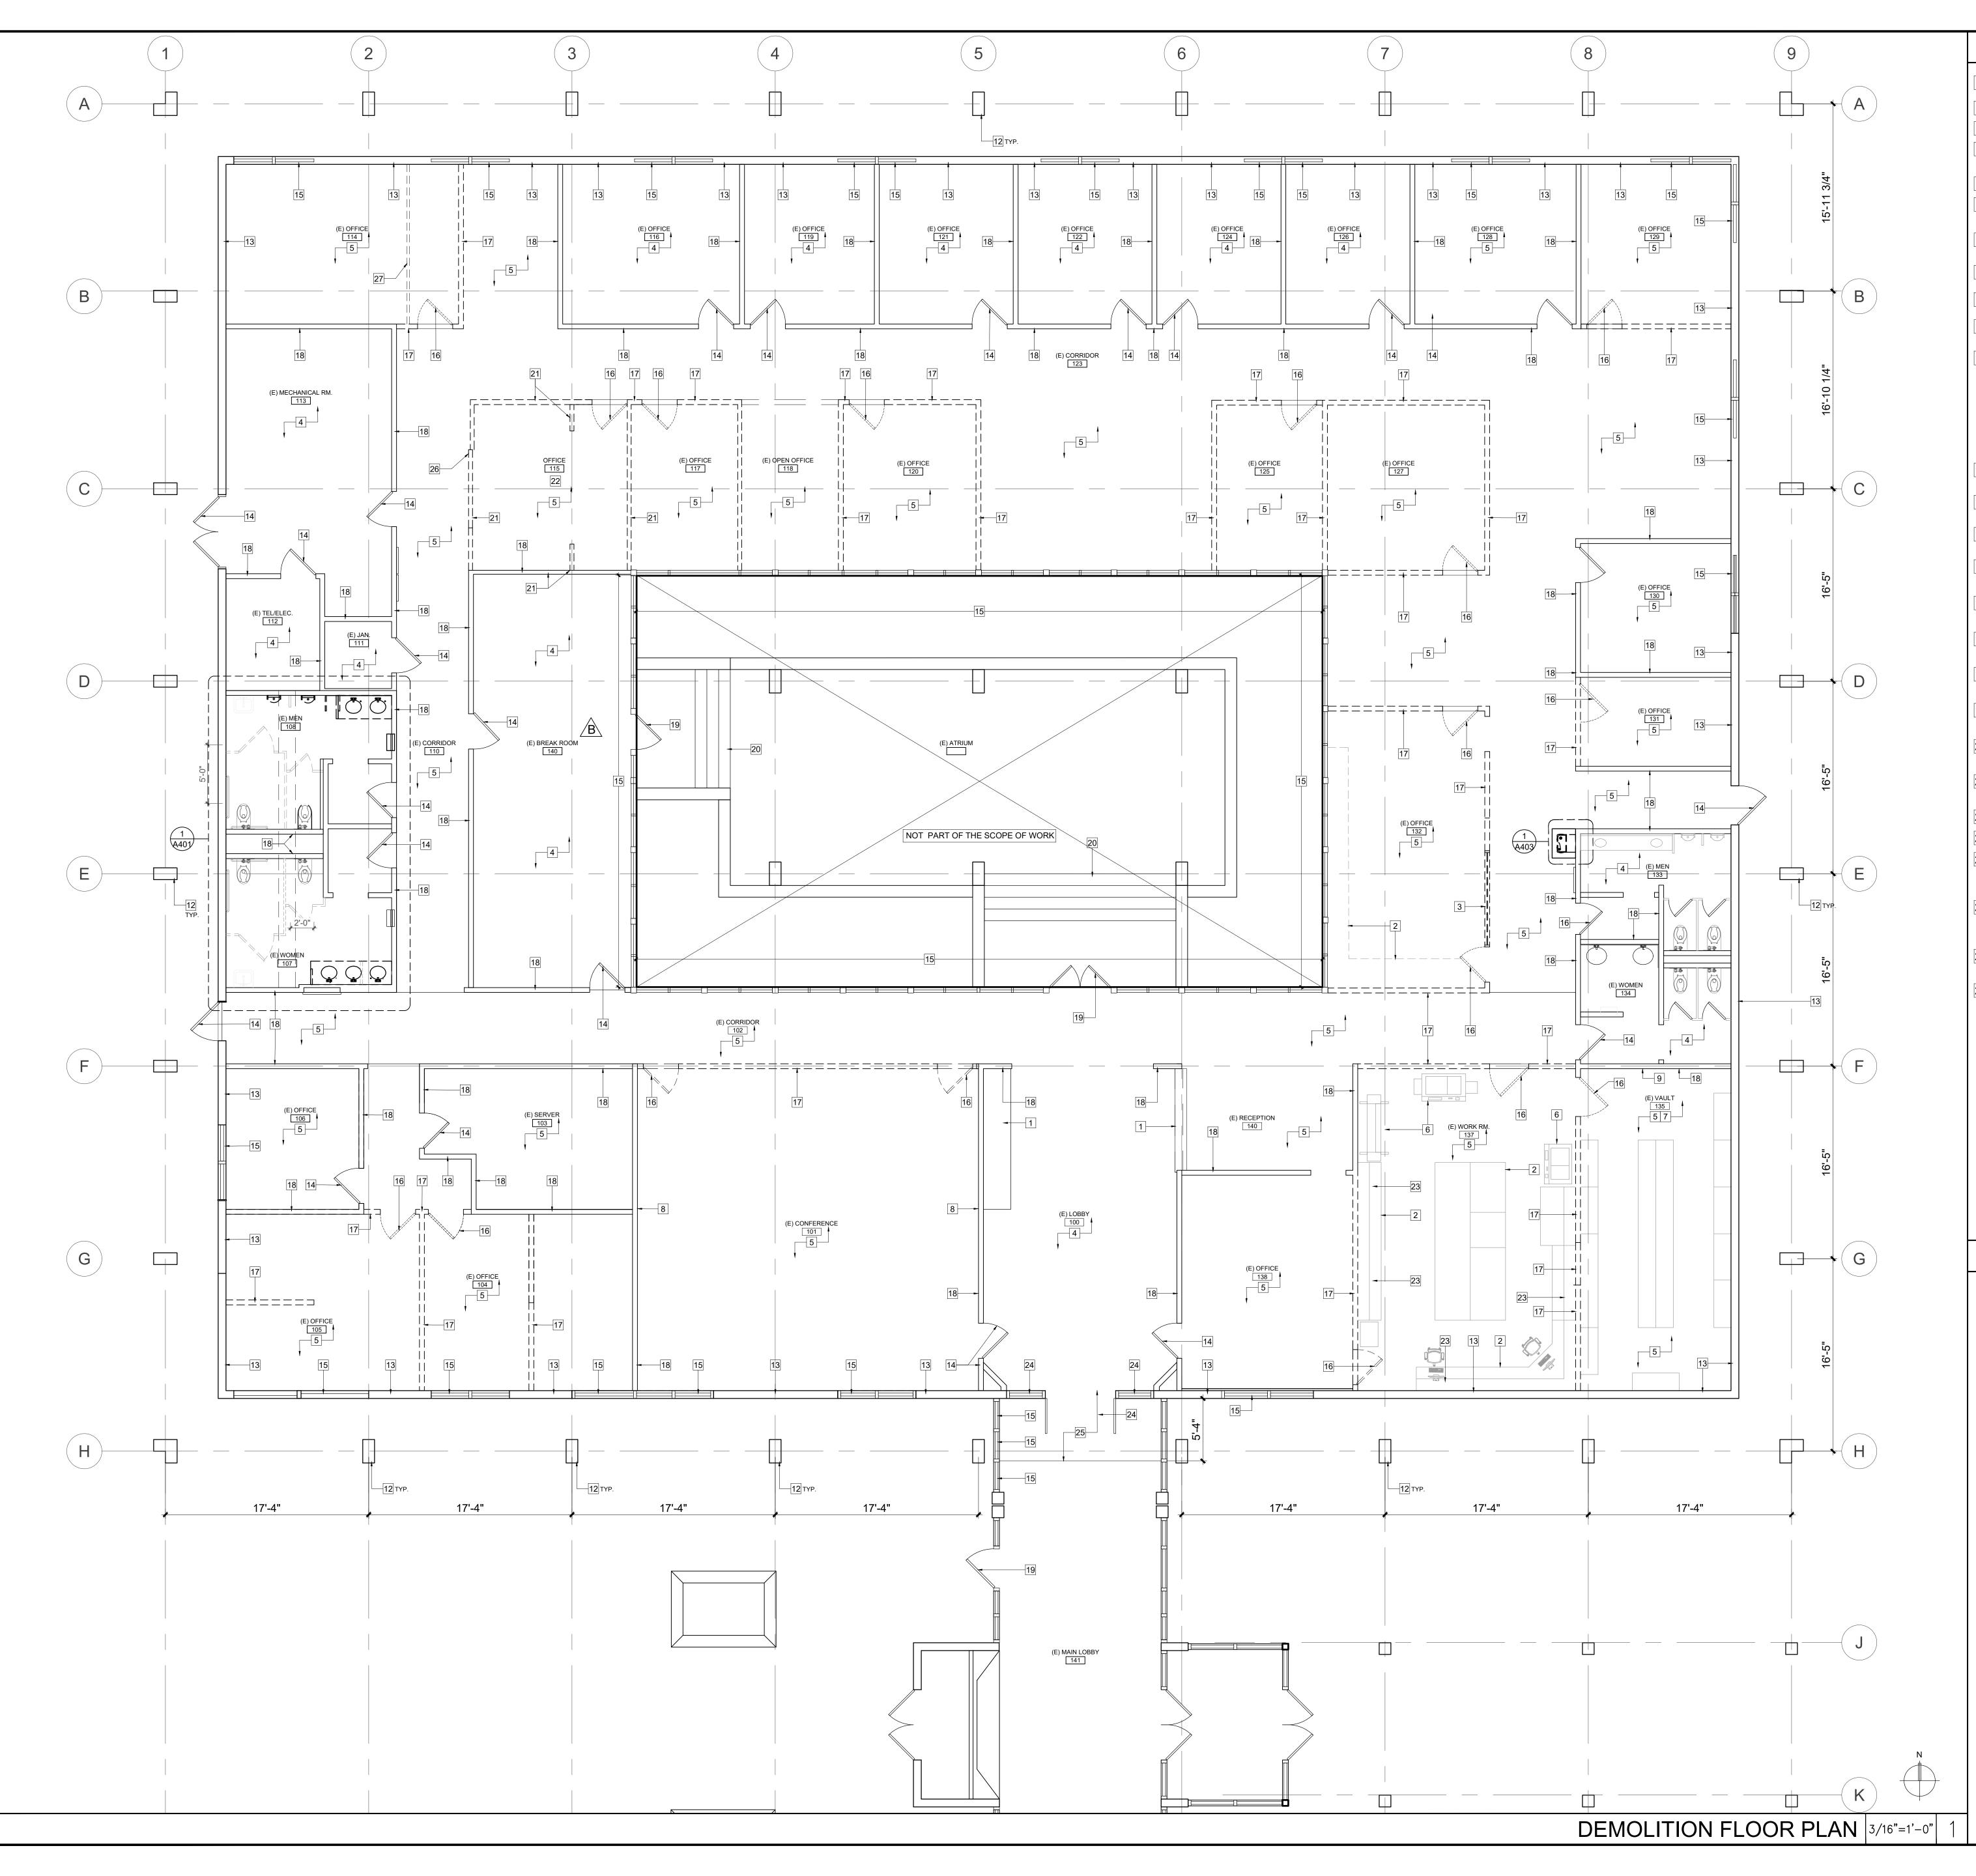



KEYNOTES 1 EXISTING MILLWORK TO REMAIN. PROTECT IN PLACE. 2 DEMOLISH EXISTING MILLWORK DEMOLISH EXISTING GLAZING/WINDOW. EXISTING FLOOR FINISH TO REMAIN. PROTECT IN PLACE. 5 DEMOLISH EXISTING FLOOR FINISH REMOVE EXISTING PRINTER. SAVE FOR RELOCATION REMOVE EXISTING VAULT SHELVING. SAVE FOR RELOCATION REMOVE EXISTING ACOUSTICAL BAFFLES FROM WALL REMOVE EXISTING KEY CABINET AND SAVE FOR RELOCATION 10 NOT USED SAW-CUT PORTION OF (E) CONCRETE SLAB TO ACCOMMODATE (N) 6" HIGH CONCRETE CURB AND WALL FOOTING, REFER TO STRUCTURAL DRAWINGS FOR ADDITIONAL INFORMATION. (NOTE: CONTRACTOR TO VERIFY EXISTING CONDITION PRIOR TO COMMENCE WITH THE DEMOLITION.) 12 (E) BRICK VENEER COLUMN TO REMAIN PROTECT-IN-PLACE, TYP. 13 (E) CONCRETE MASONRY WALL TO REMAIN PROTECT-IN-PLACE, TYP. 14 EXISTING DOOR AND FRAME TO REMAIN PROTECT-IN-PLACE, TYP. (E) STOREFRONT WINDOW SYSTEM TO ŘÉMAIN, PROTECT-IN-PLACE, TYP. (V.I.F.) 16 REMOVE EXISTING DOOR AND FRAME COMPLETE, TYP. 17 REMOVE EXISTING STUD WALL AND FINISHES TYP. 18 EXISTING STUD WALL AND FINISHES TO REMAIN, PROTECT-IN-PLACE, TYP. 19 EXISTING STOREFRONT SYSTEM DOOR AND FRAME TO REMAIN, PROTECT-IN-PLACE, TYP. 20 EXISTING STAIRS TO REMAIN, PROTECT-IN-PLACE, V.I.F. 21 REMOVE EXISTING MASONRY WALL AND FINISHES. 22 REMOVE EXISTING 6" CONCRETE CEILING 23 EXISTING SOFFIT TO BE DEMOLISHED 24 EXISTING STOREFRONT DOOR AND SIDELITES TO BE REMOVED, PROTECT SILL AND HEADWALL IN PLACE. 25 EXISTING TILE FLOORING TO BE REMOVED AND PREPARED FOR INSTALLATION OF NEW TILE FLOORING. REMOVE EXISTING UTILITY BOX AND ALL ASSOCIATED CONDUIT AND WIRING.


27 REMOVE 3X9 RAFTER THAT IS NOT CARRYING LOAD.


LEGEND

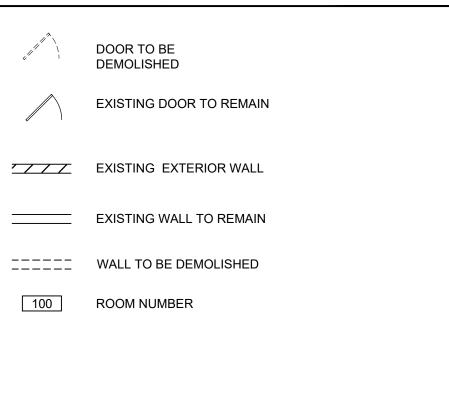

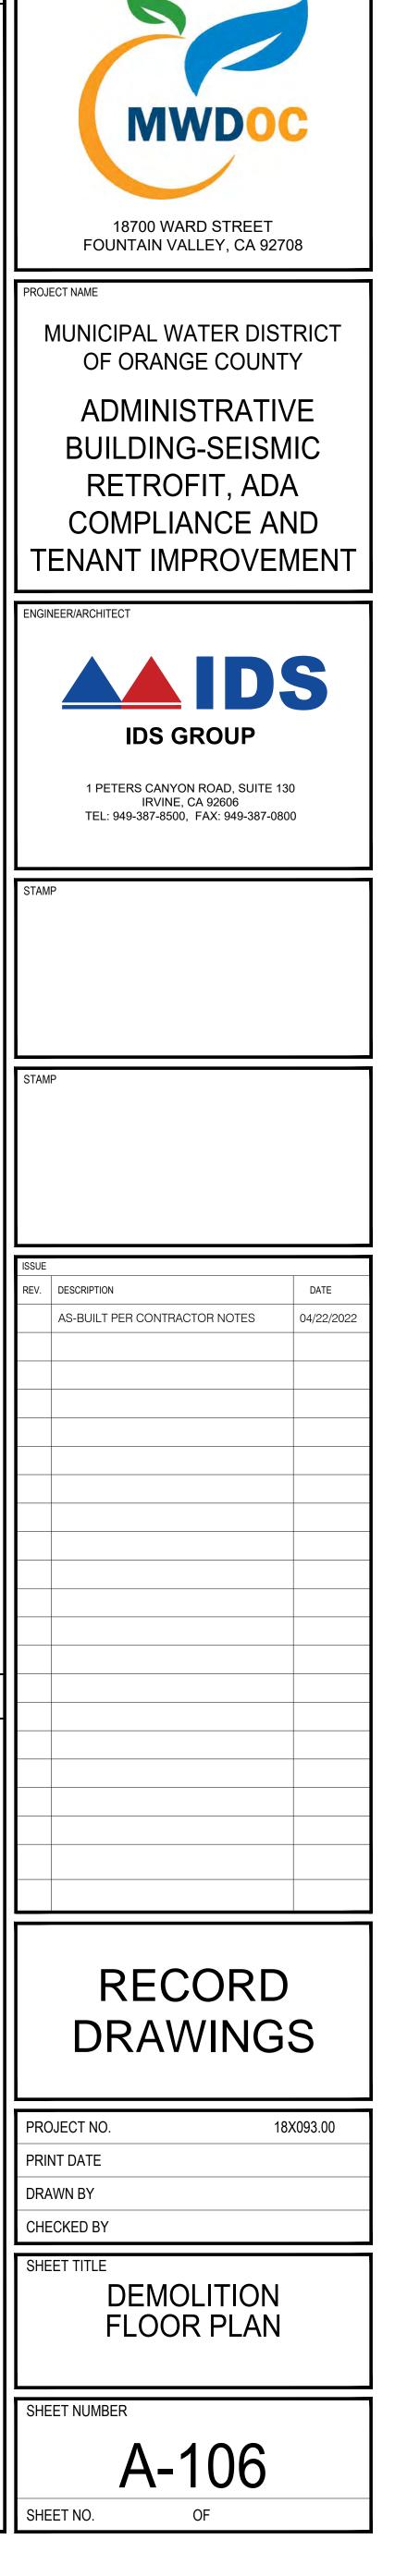

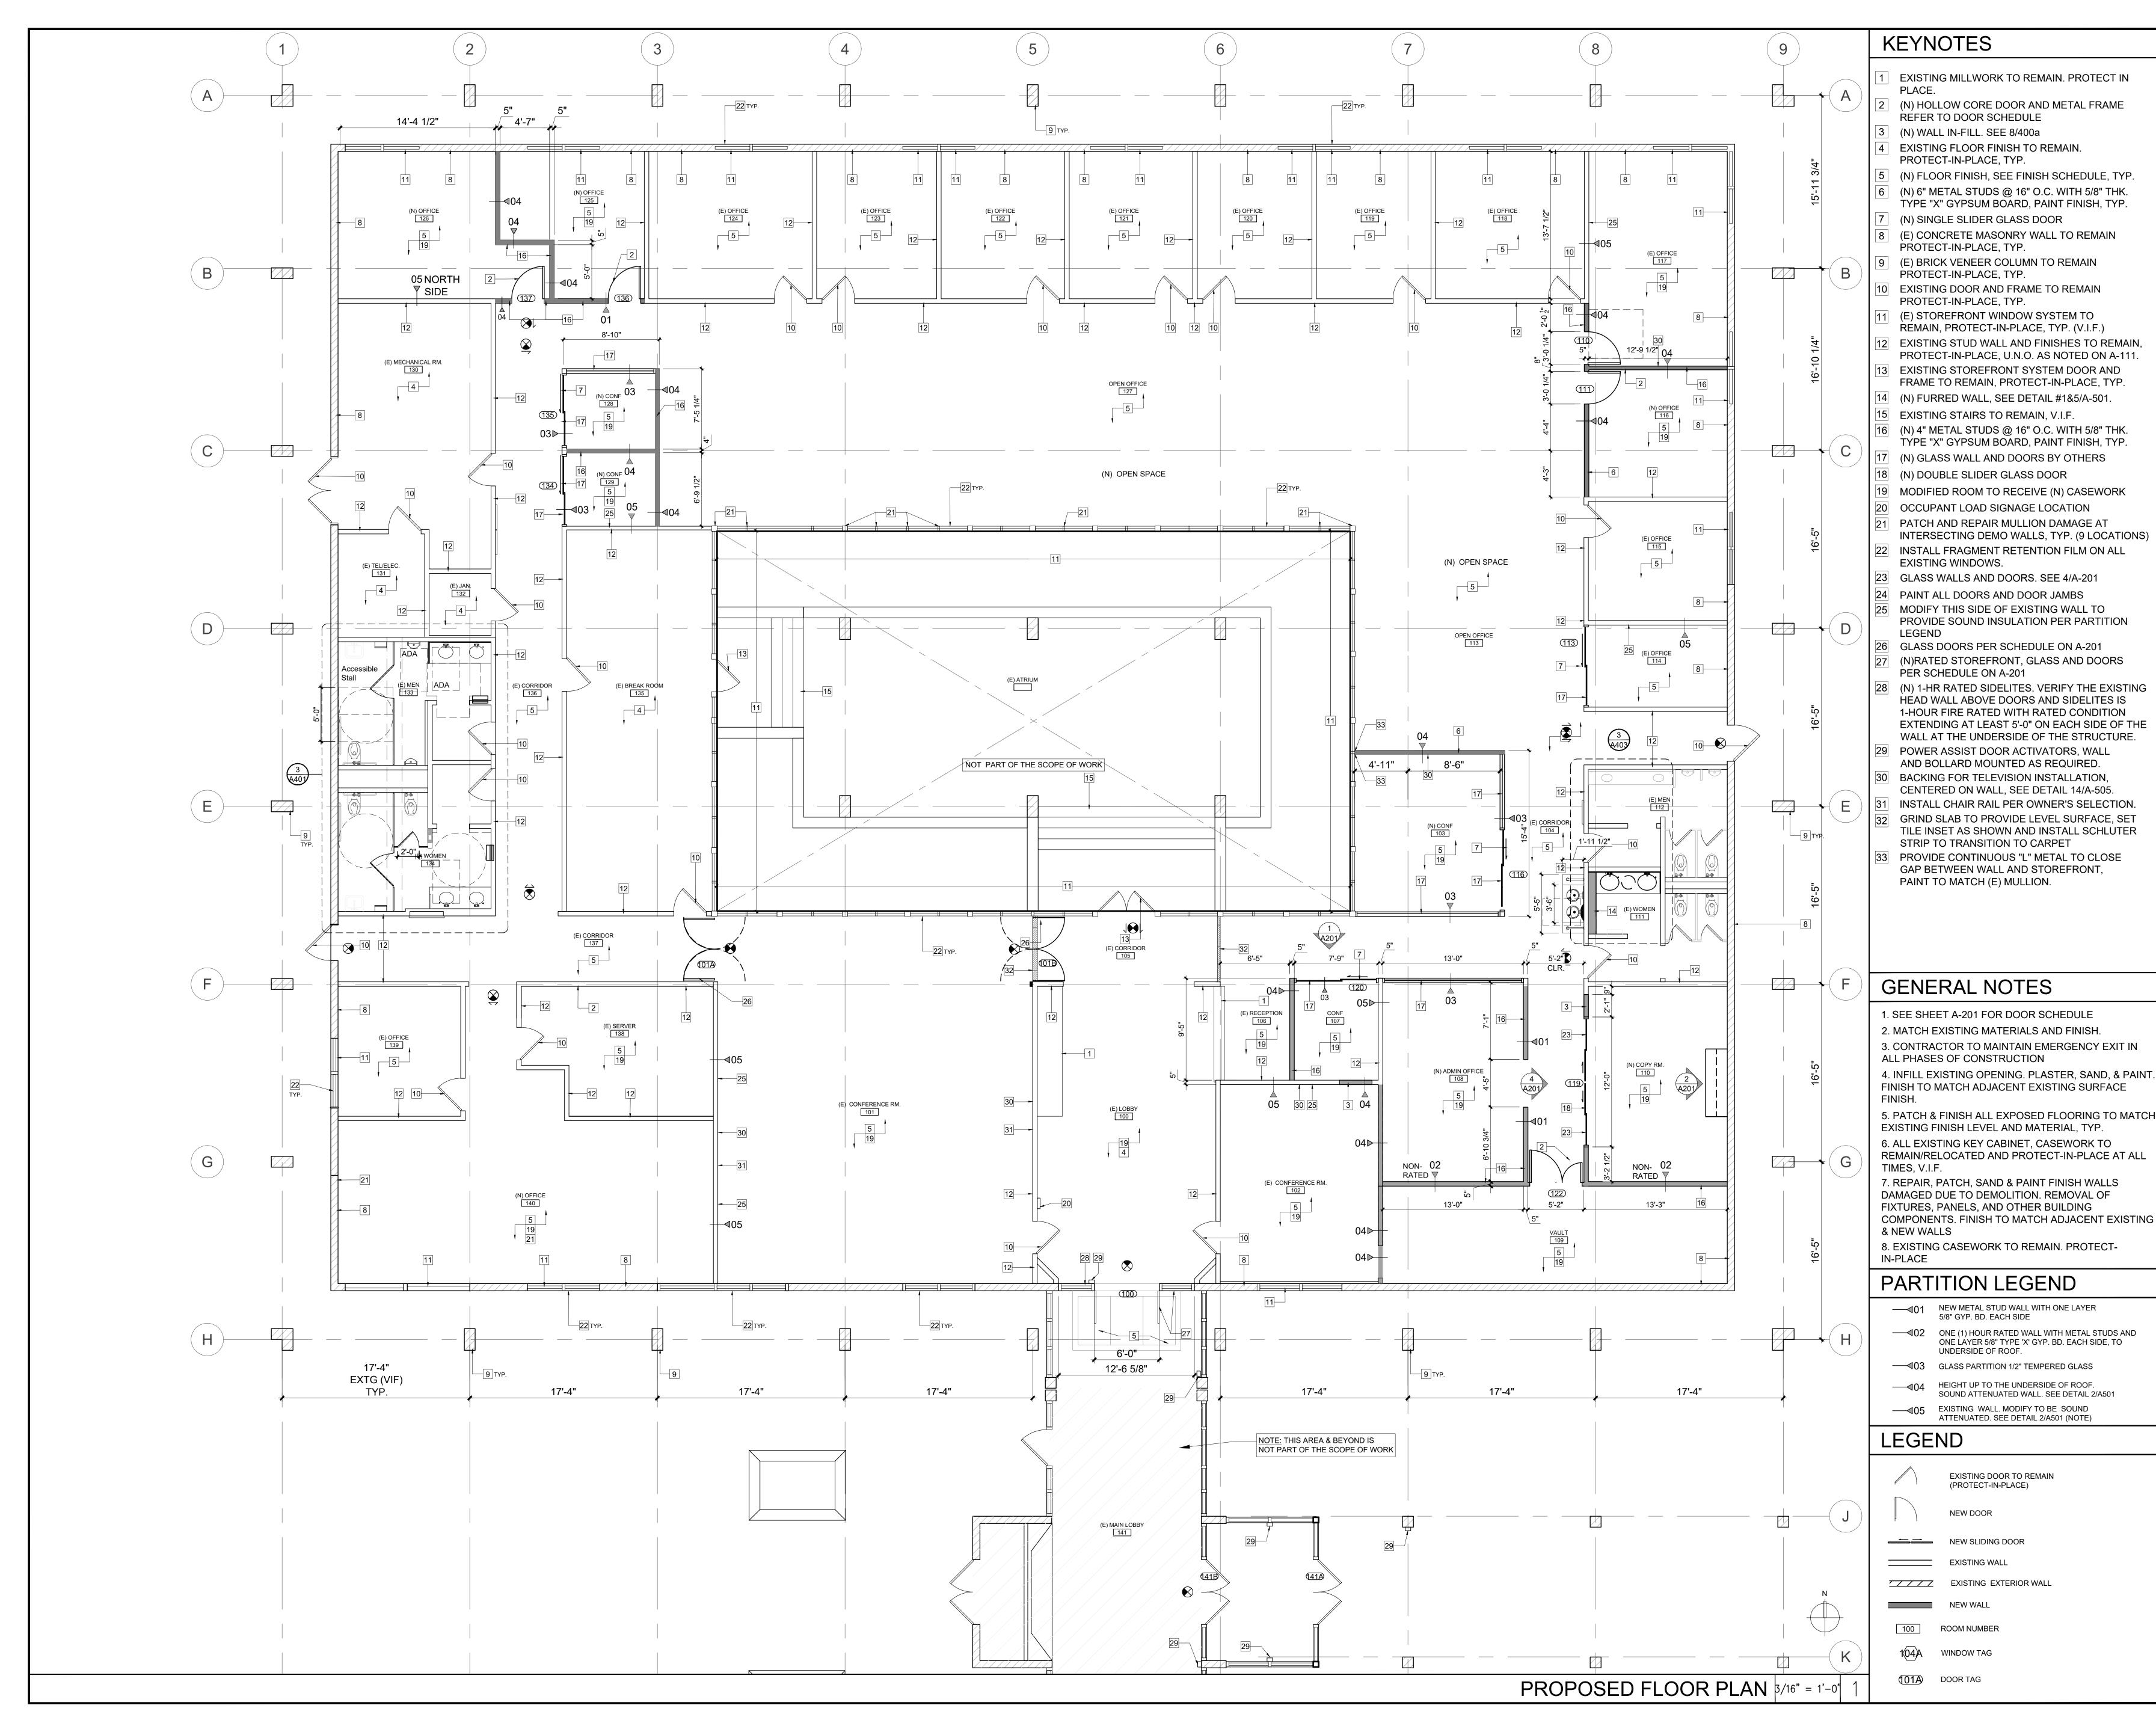


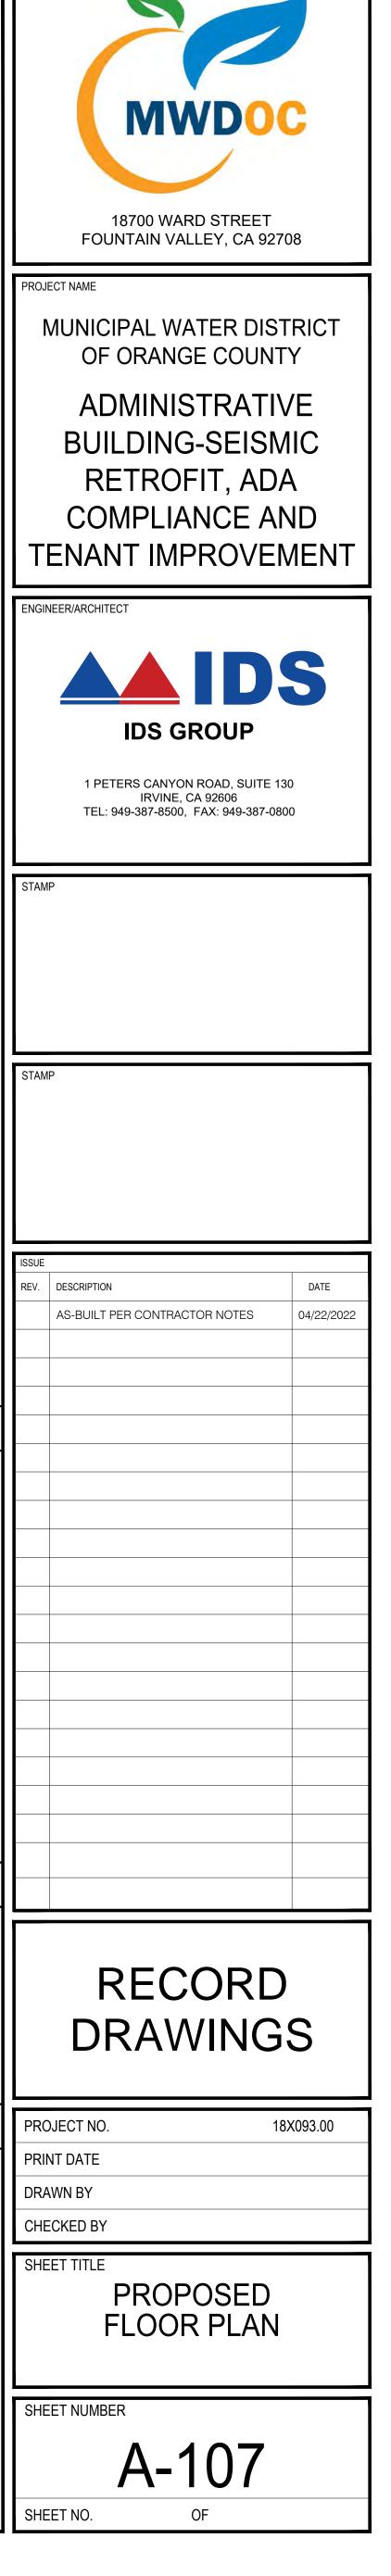


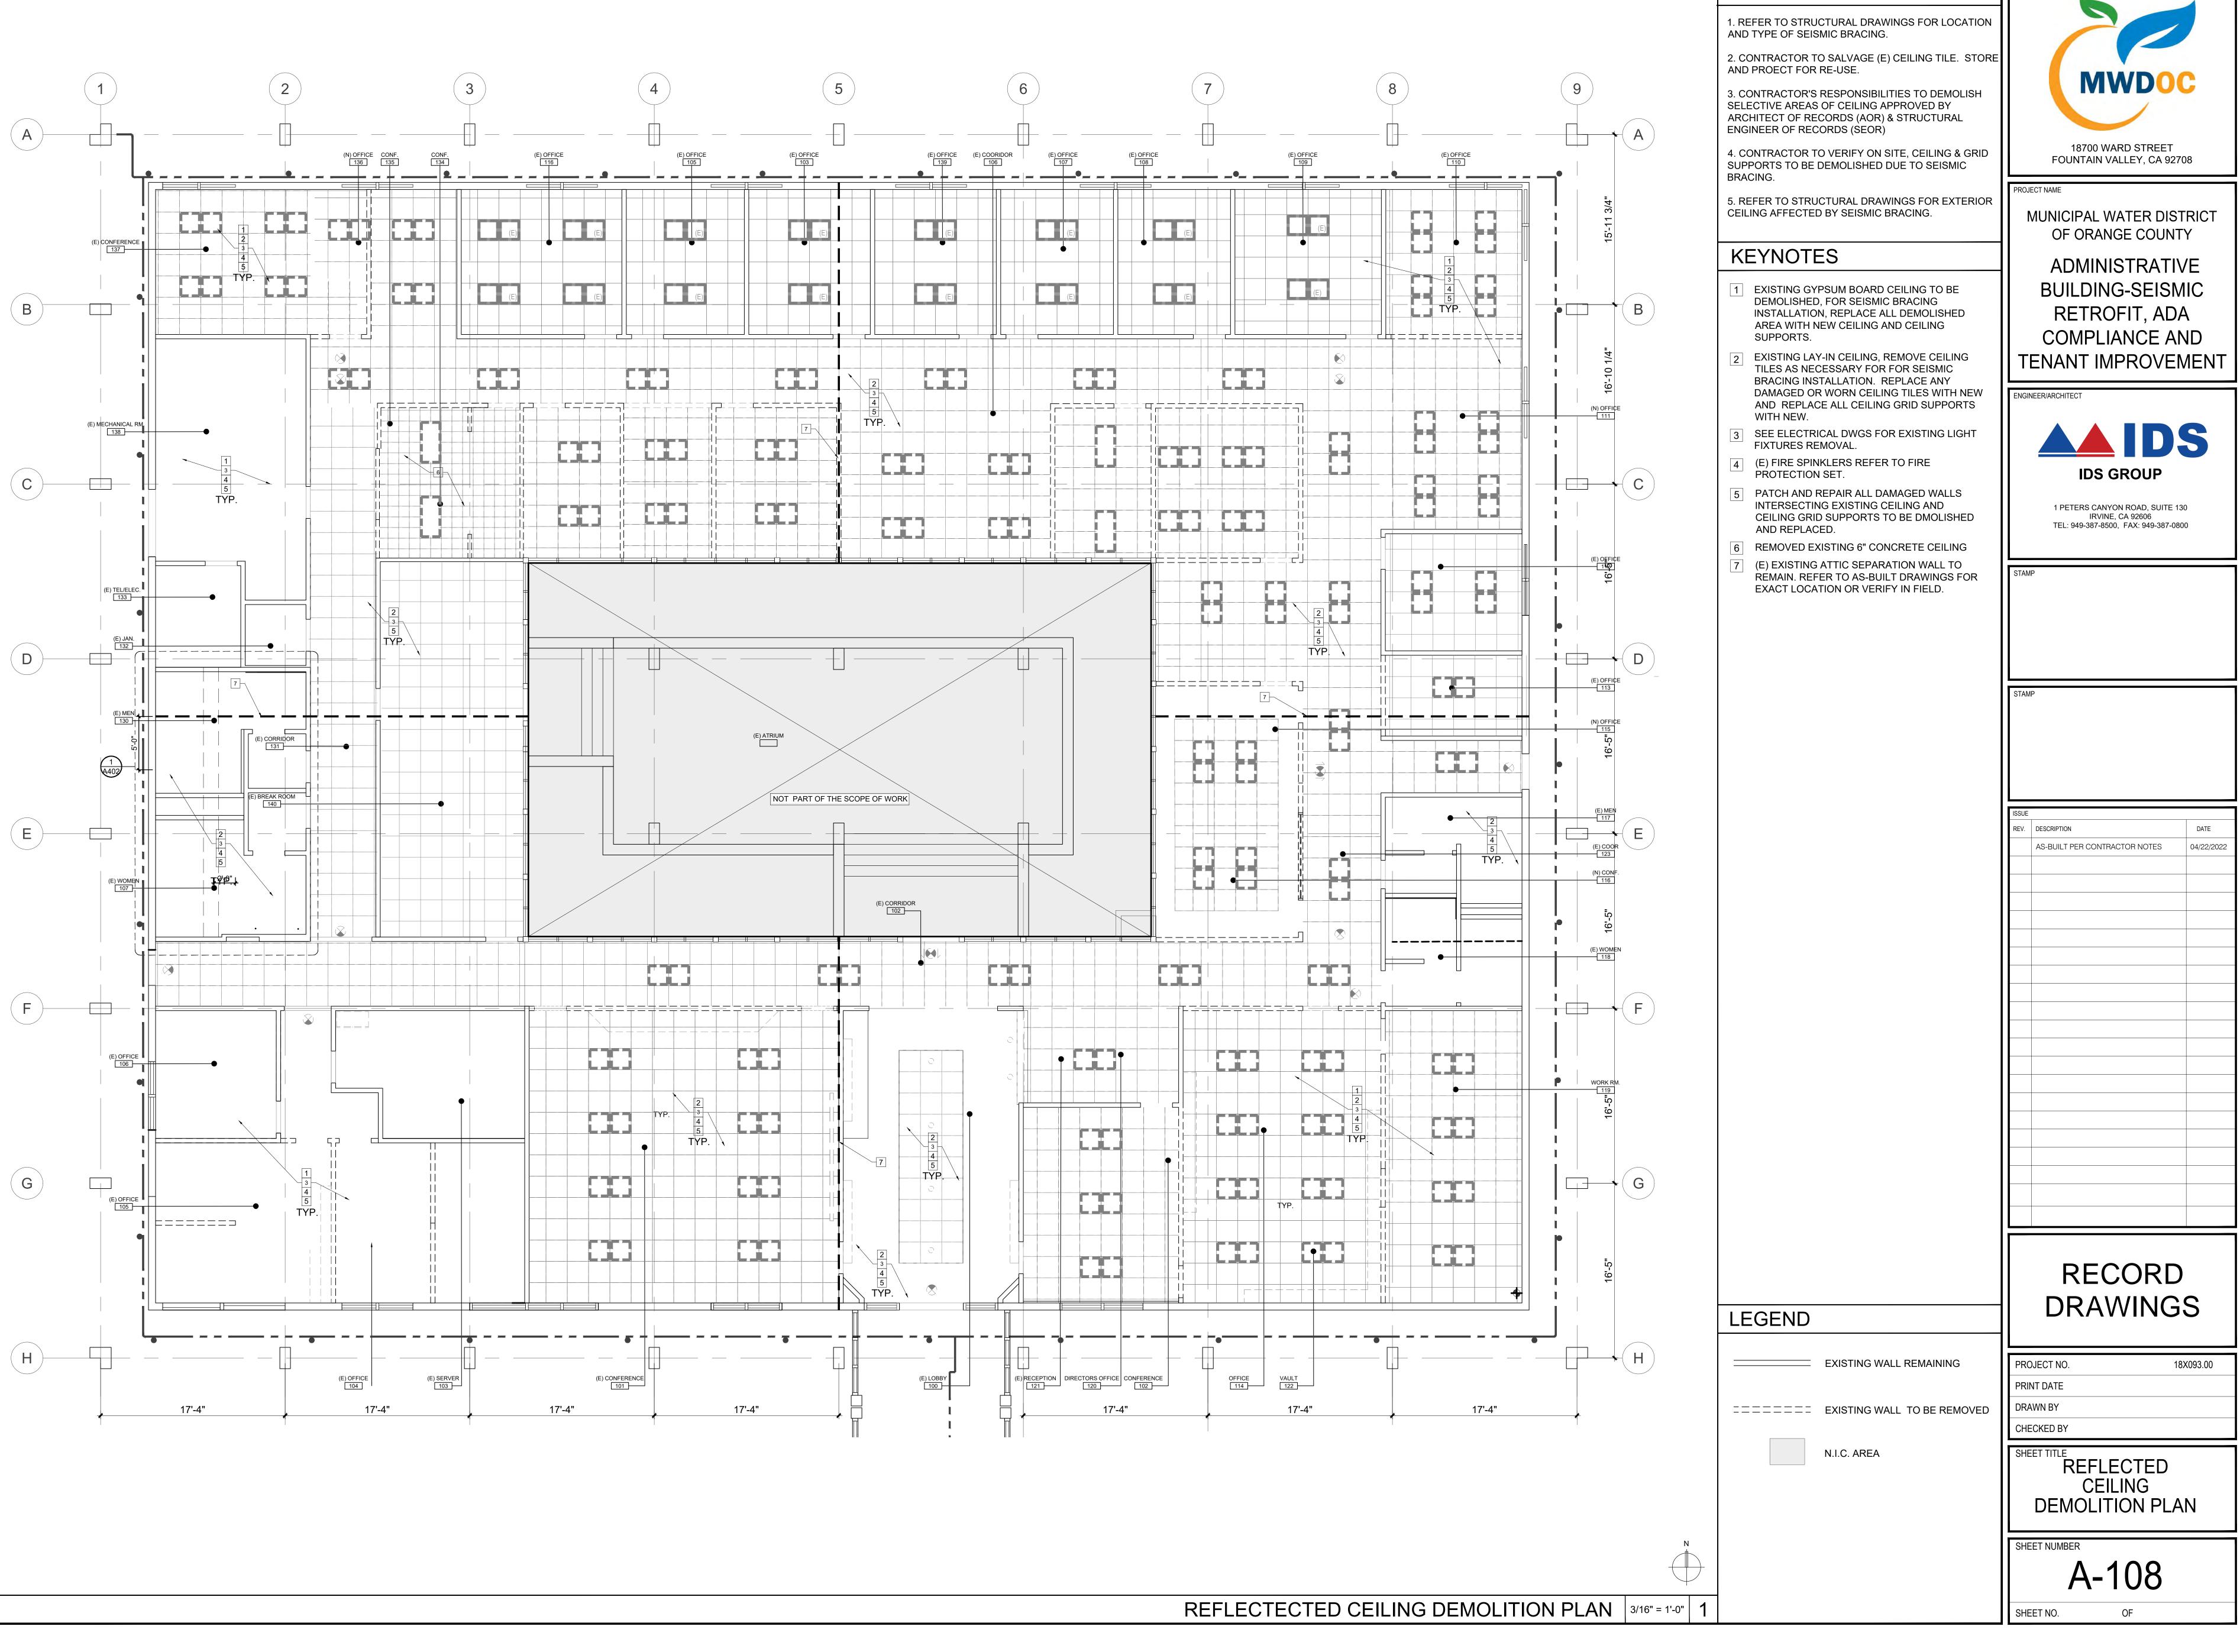



GENERAL NOTES


CLIENT

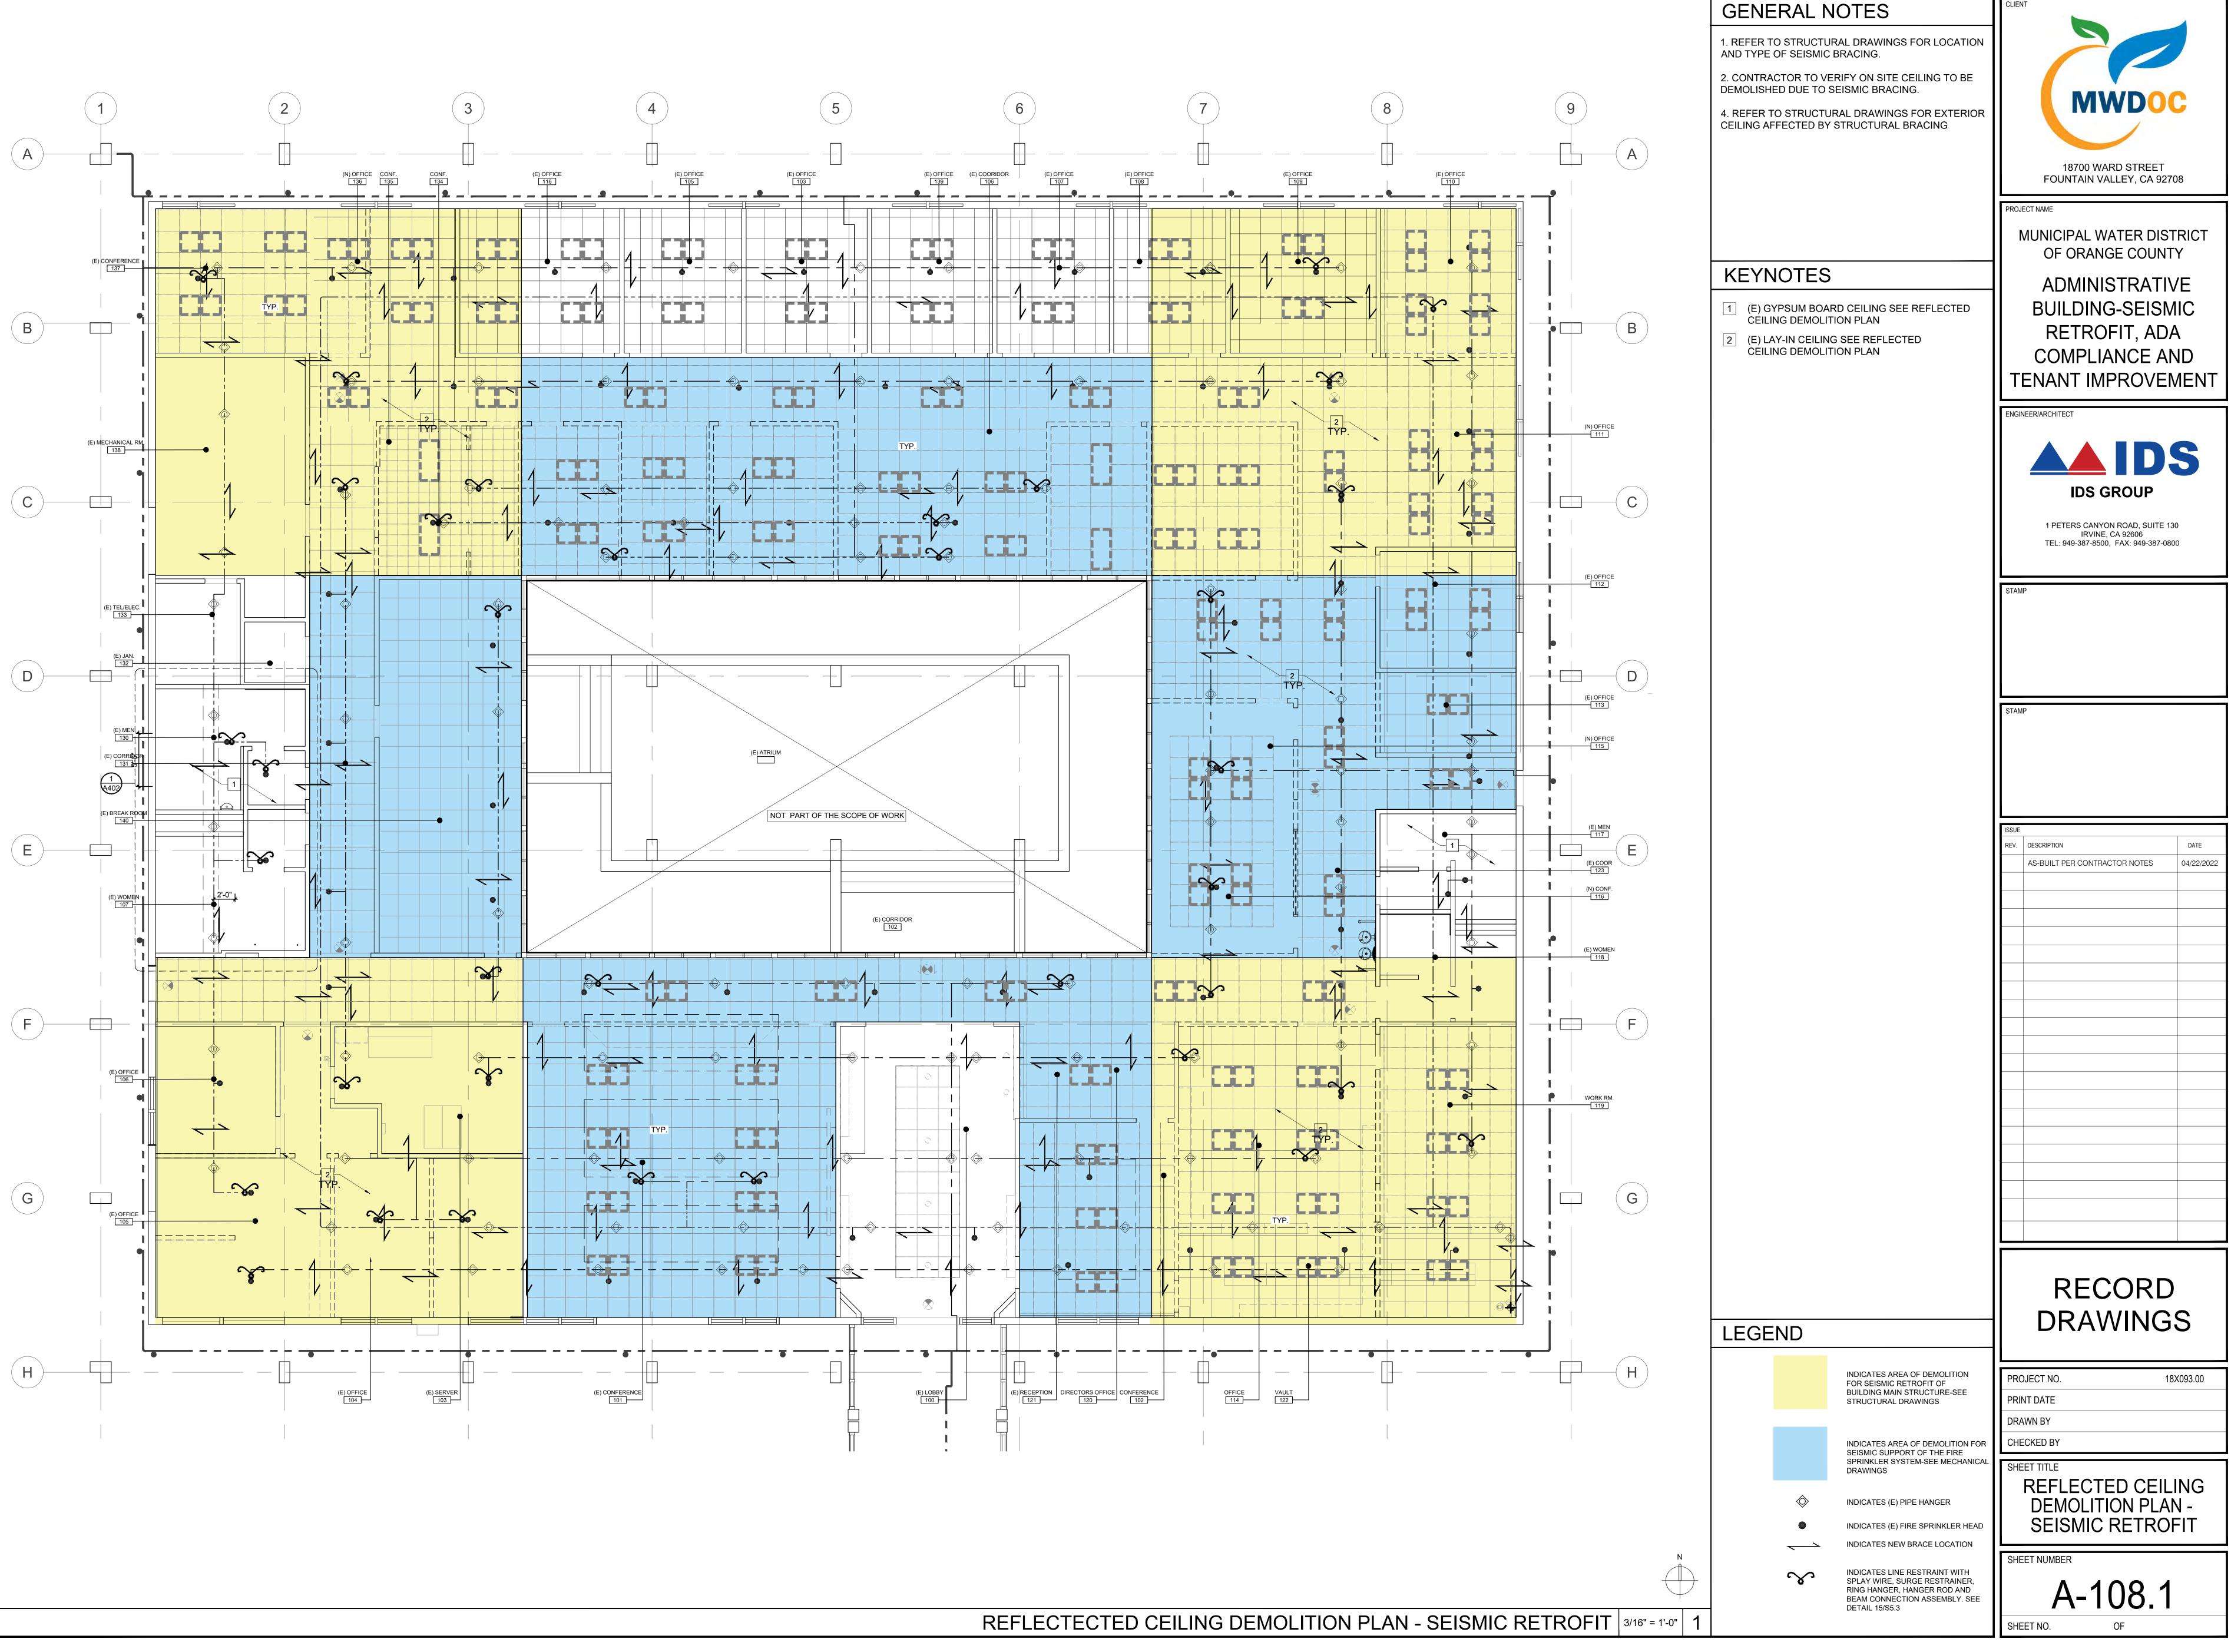

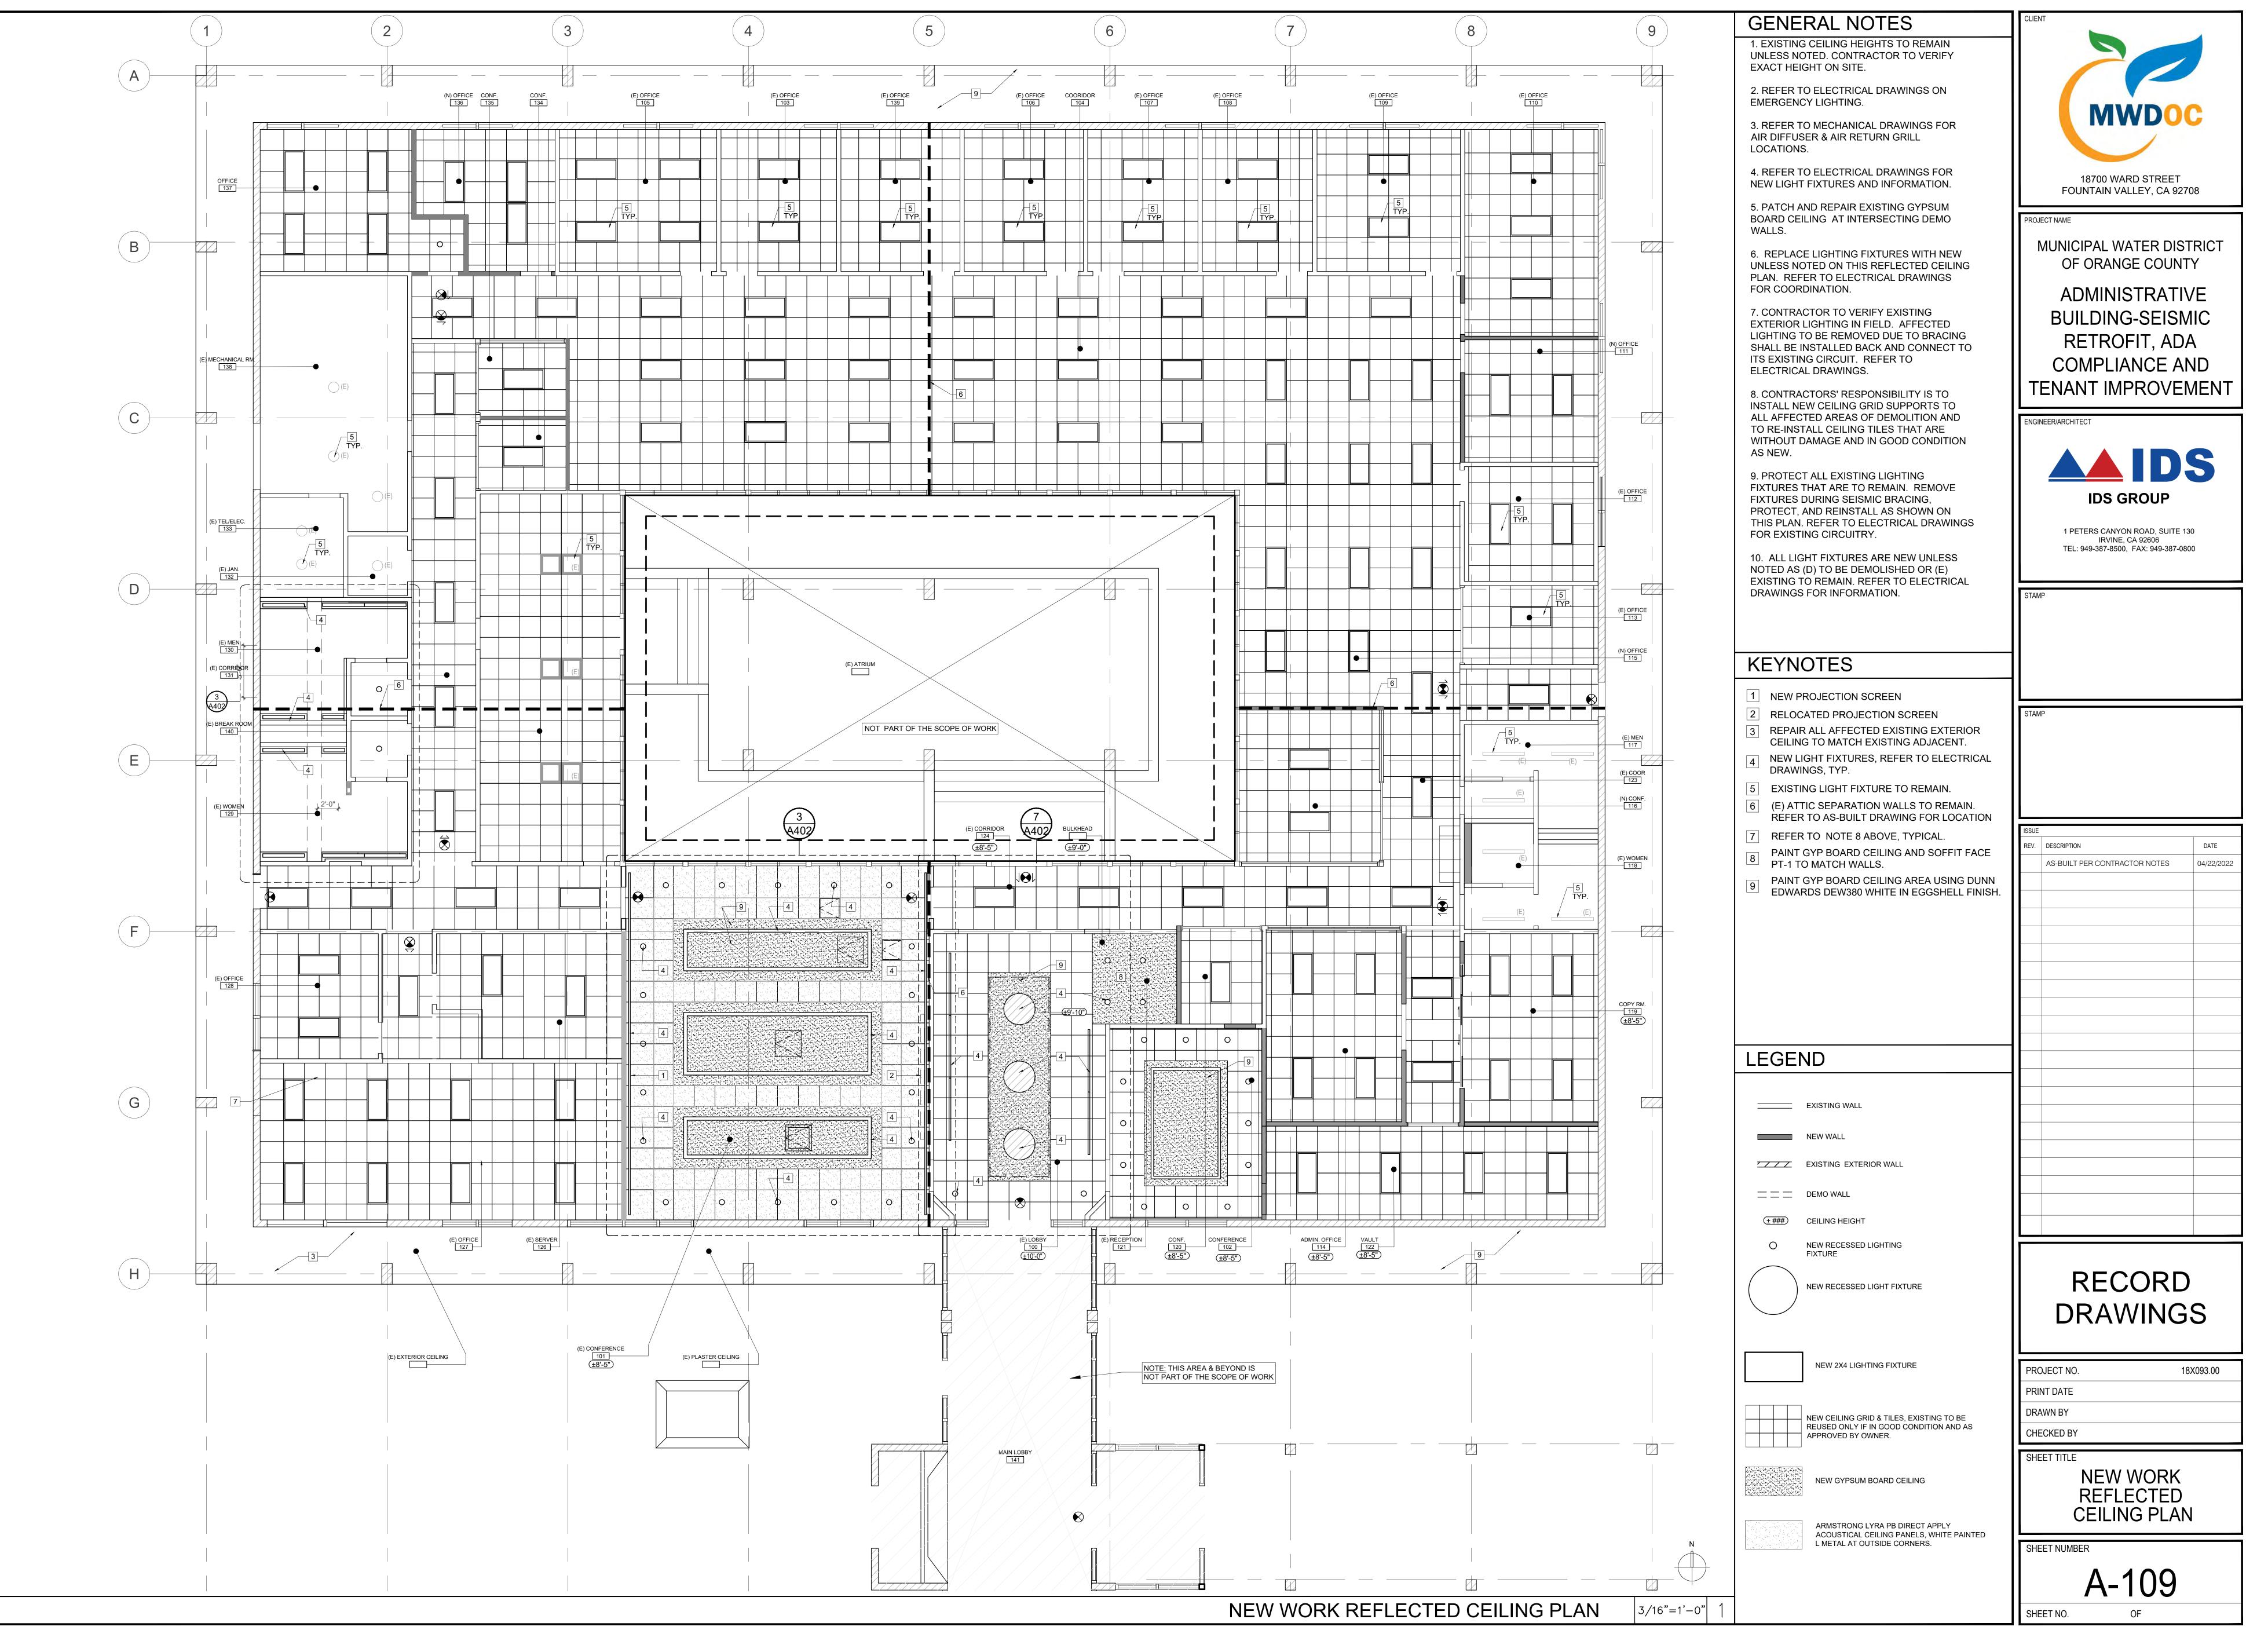


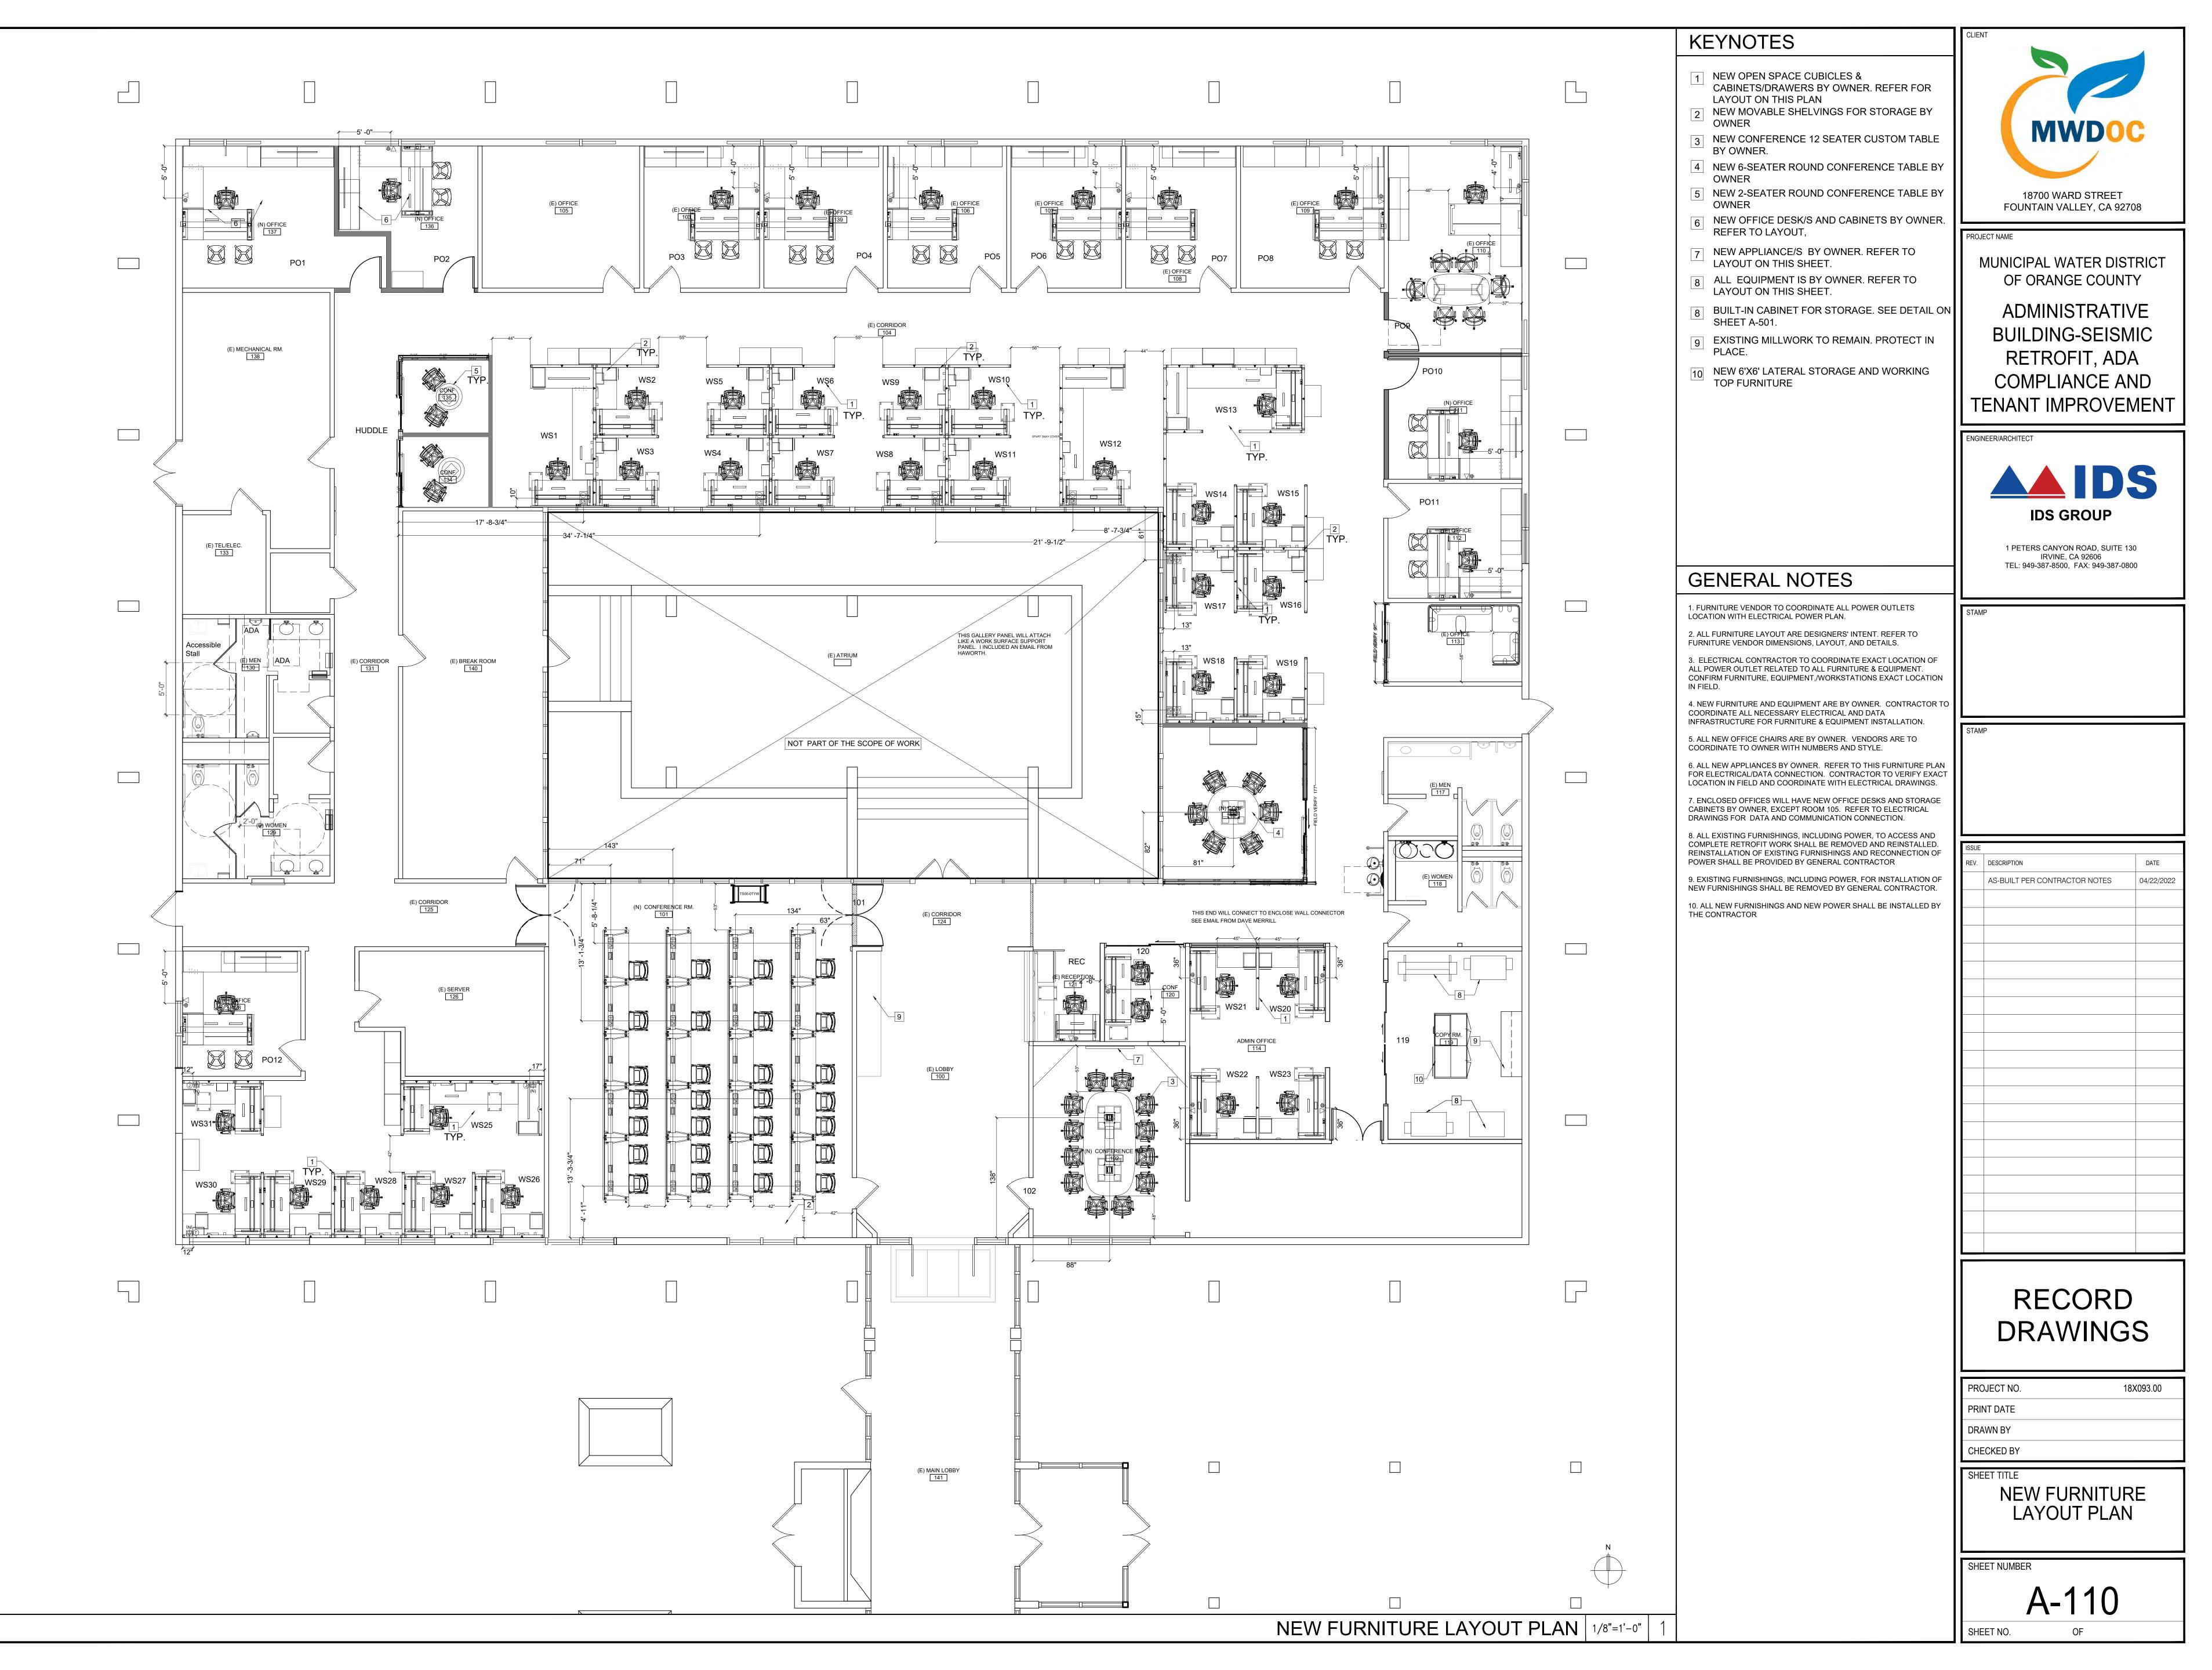


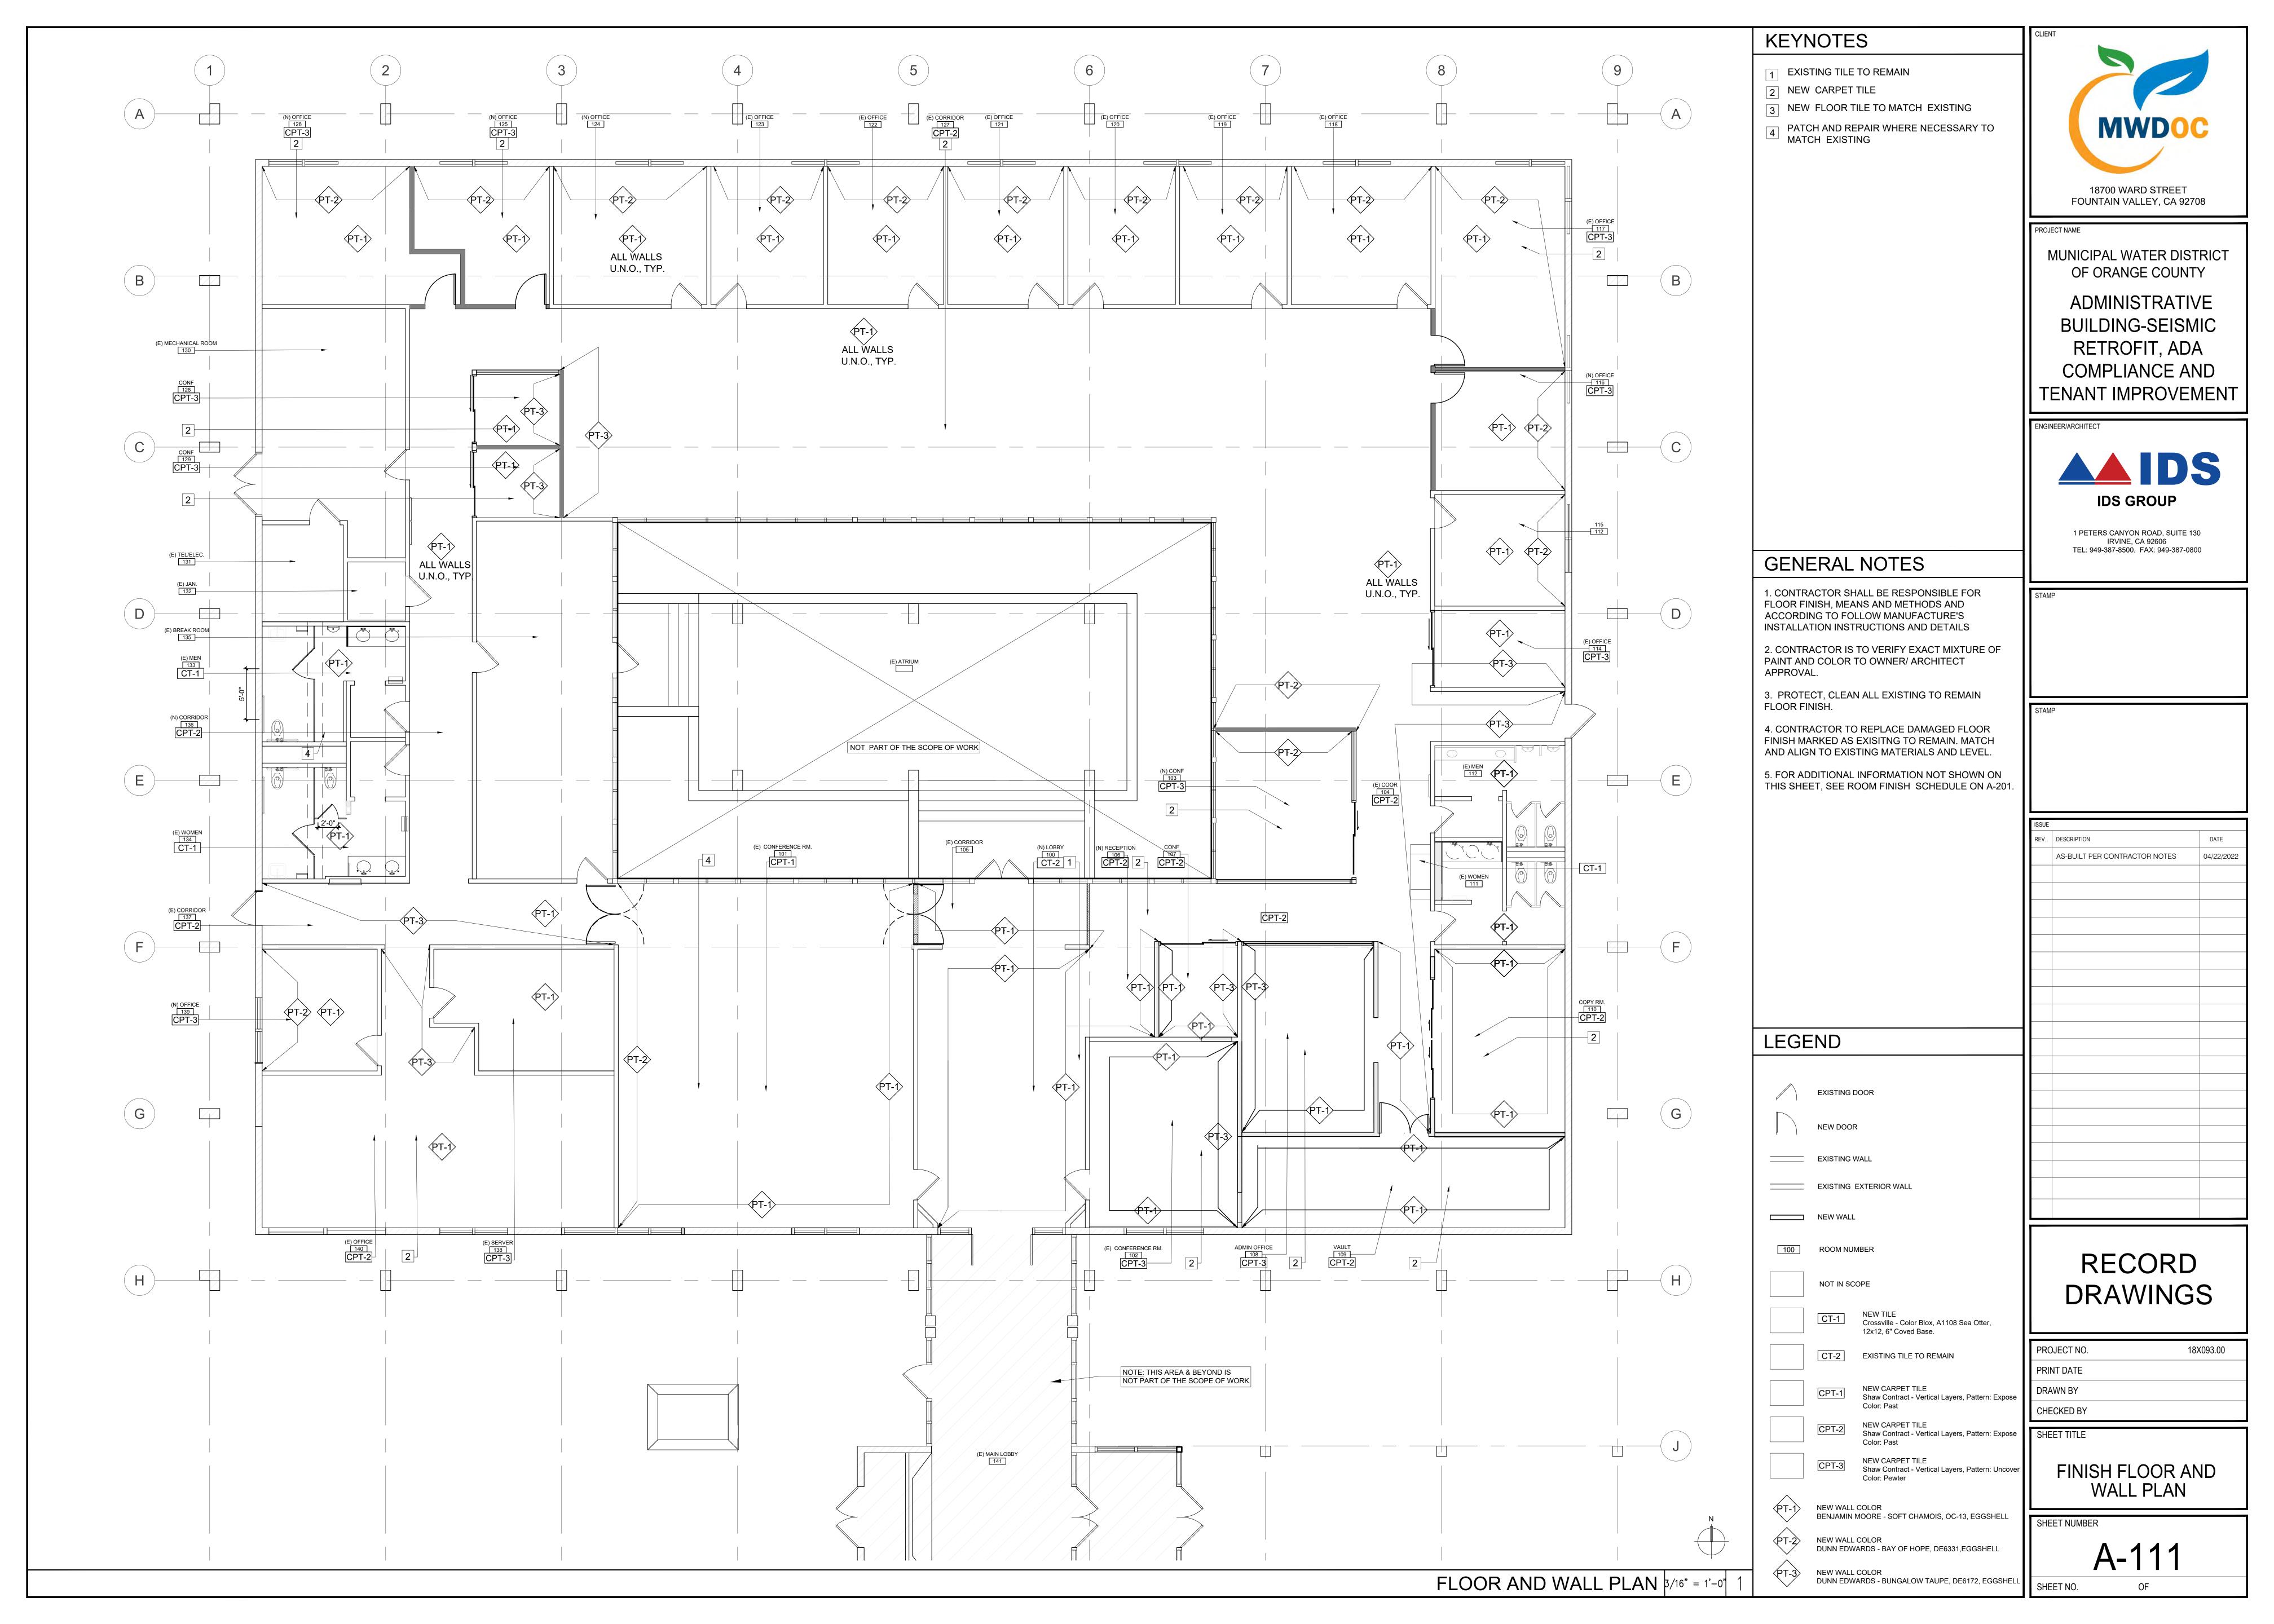


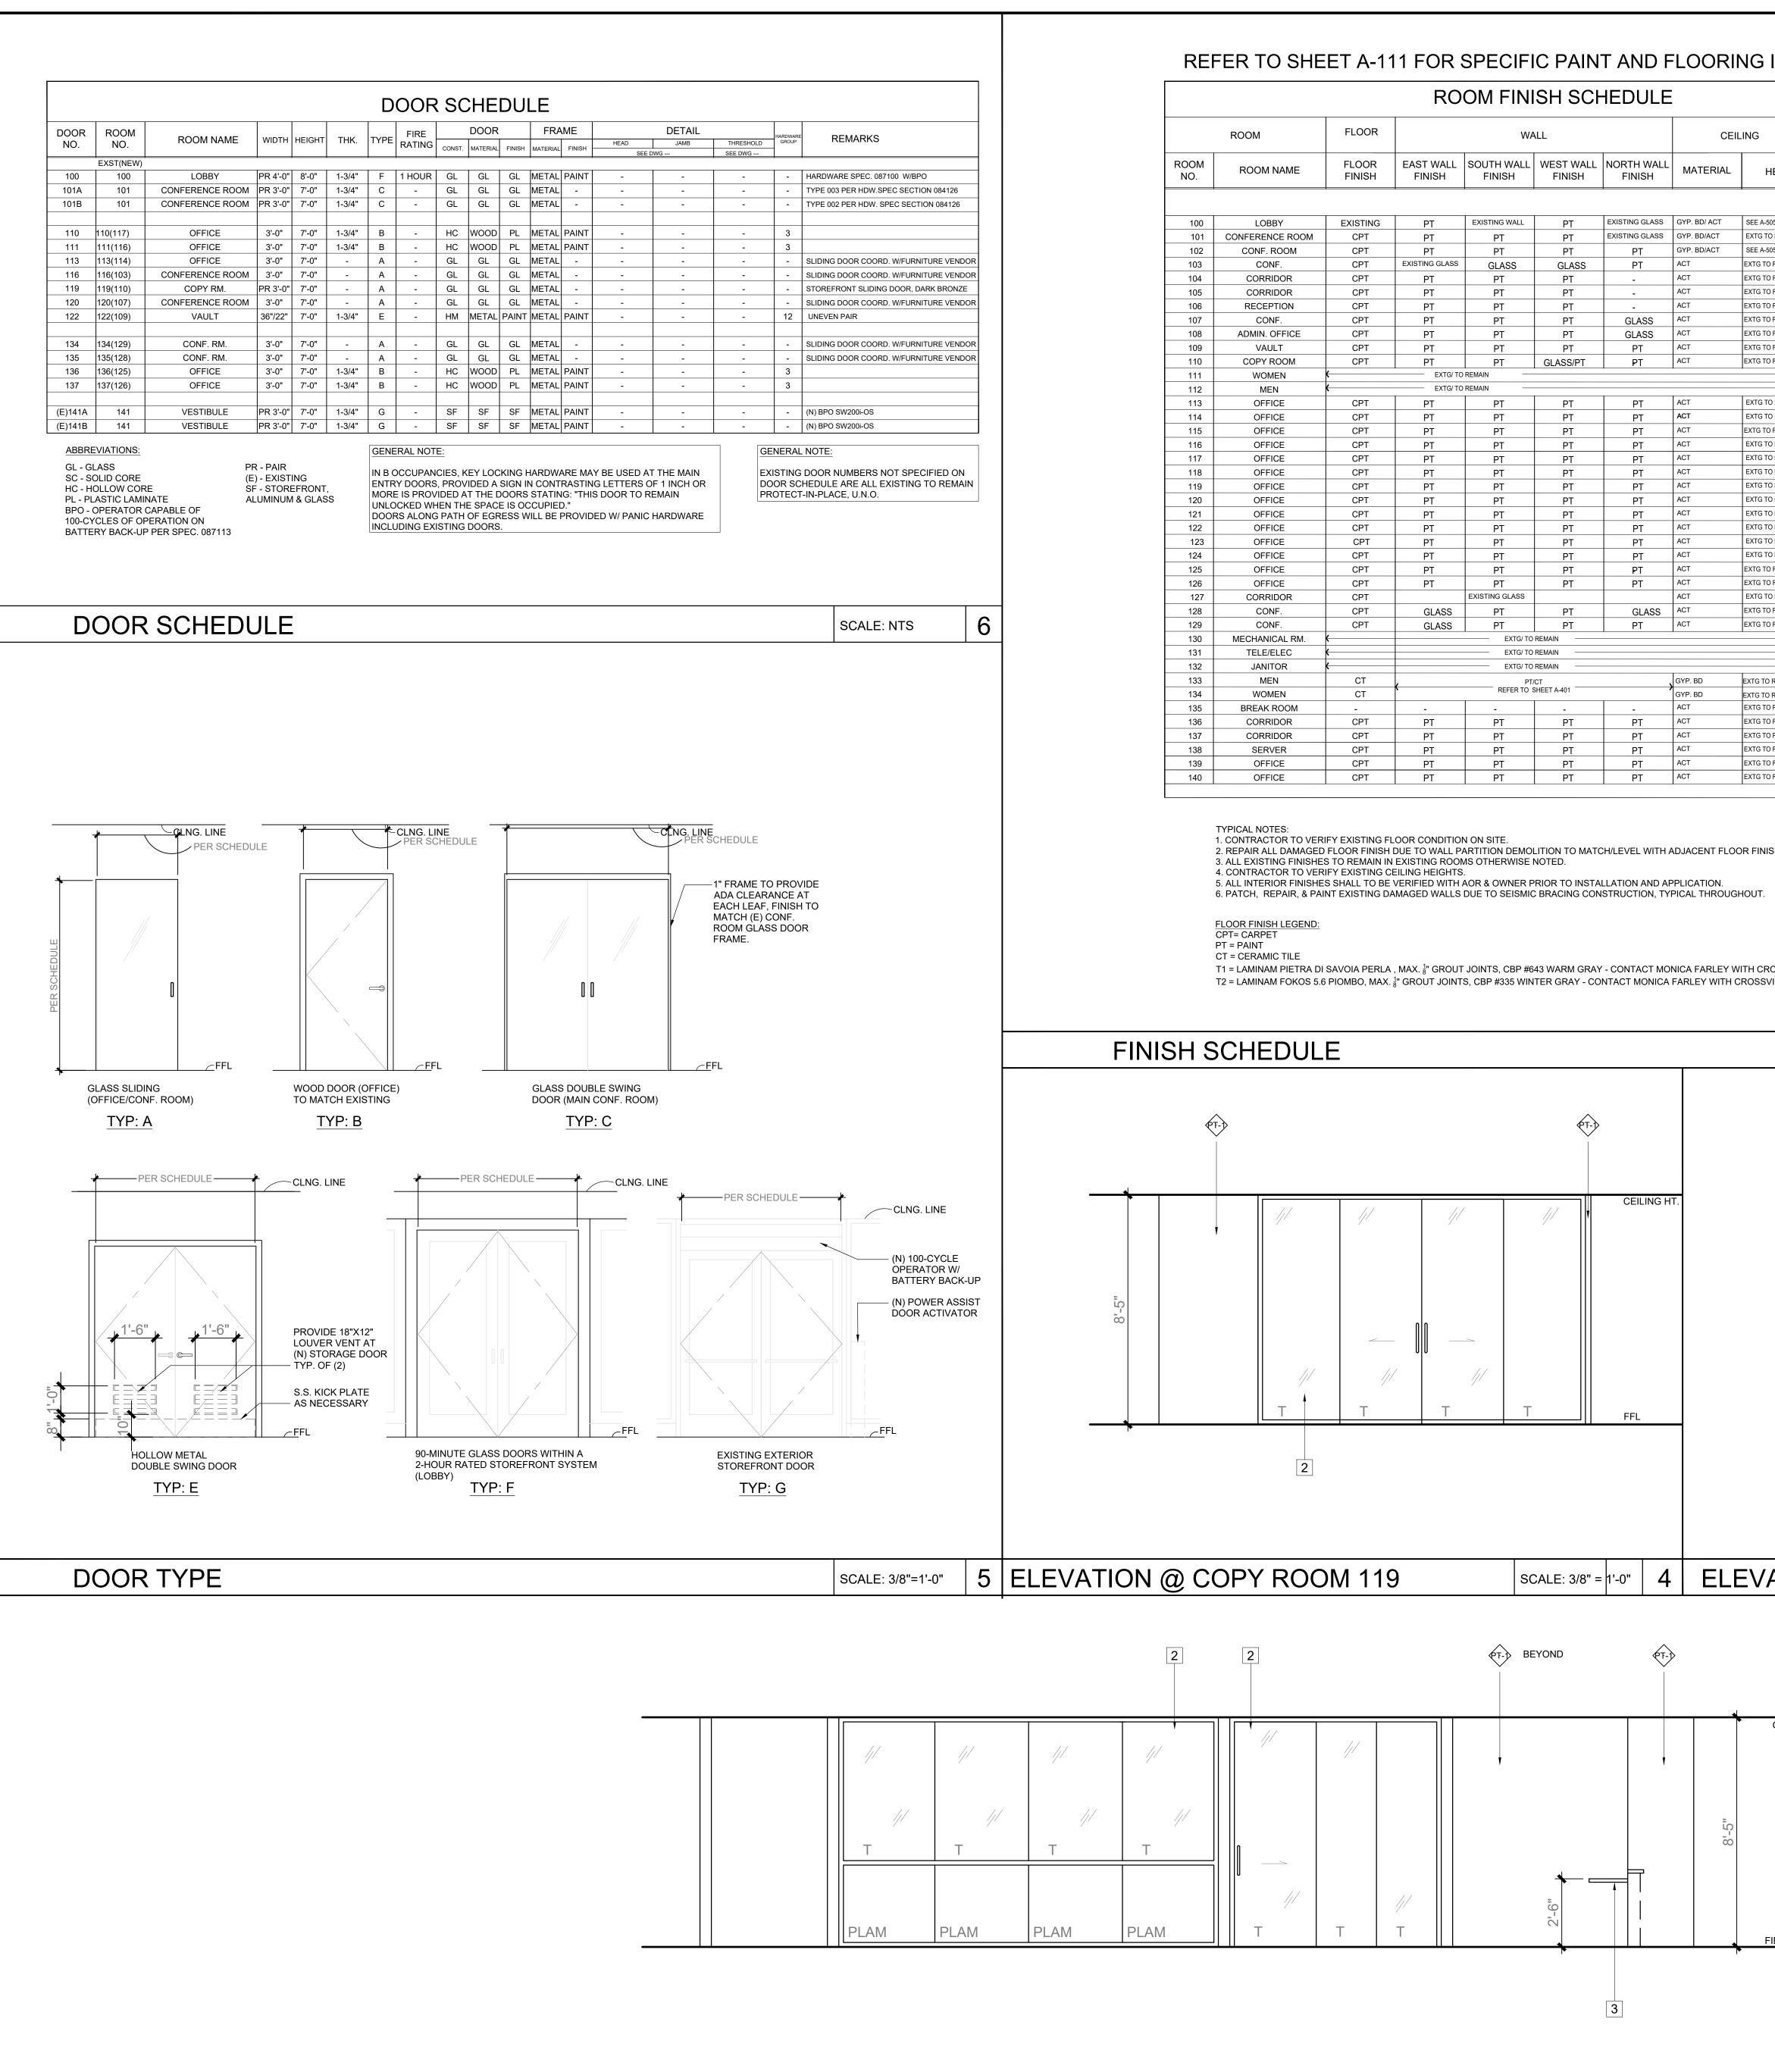



			KEYNOTES
INFO	RMATION/LOCATIONS		1 NEW MILLWORK, SEE PLAN
			2 NEW GLAZED WALLS AND SLIDING GLASS DOORS, COORDINATE W/ FURNITURE VENDOR.
	REMARKS (SEE TYPICAL NOTES BELOW)		3 EXISTING MILLWORK TO REMAIN
IEIGHT		\vdash	GENERAL NOTES
05	NEW FLOOR BASE TO MATCH EXTG BASE, CUSTOM INSERT ON COMMON SIDE OF LOBBY DOORS, T1 AND T2	\vdash	FINISH SCHEDULE:
O REMAIN 05			1. CONTRACTOR IS TO VERIFY INTERIOR CONDITION OF THE BUILDING PRIOR TO DEMOLITION AND APPLICATION
) REMAIN) REMAIN	GLASS PARTITIONS BY FURNITURE VENDOR, COORDINATE REQUIREMENTS.		OF THE INTERIOR FINISHES
) REMAIN) REMAIN	GLASS PARTITIONS BY FURNITURE VENDOR, COORDINATE REQUIREMENTS.		2. CONTRACTOR SHALL PROCEED WITH THE FINISHES UPON CONFIRMATION AND APPROVAL OF THE ARCHITECT
) REMAIN) REMAIN) REMAIN	GLASS PARTITIONS BY FURNITURE VENDOR, COORDINATE REQUIREMENTS. GLASS STOREFRONT/SLIDING DOORS DARK BRONZE FINISH.		OF RECORDS (AOR). SHOP DRAWINGS AND SUBMITTAL SHALL BE SUBMITTED AND APPROVED BY AOR PRIOR TO
	> >		APPLICATION. PROVIDE SAMPLES OF MATERIALS FOR APPROVAL. REFER TO SPECIFICATIONS OR PROJECT MANUAL FOR INFORMATION.
D REMAIN			3. ALL "EXISTING TO REMAIN" SUCH AS CEILING HEIGHTS
D REMAIN			SHALL BE VERIFIED ON SITE PRIOR TO FINAL INSTALLATION OF NEW CEILING GRID SUPPORTS AND
D REMAIN D REMAIN D REMAIN			CEILING TILES. 4. MATCH NEW AND EXISTING MATERIALS IN AREAS OF
D REMAIN			CONNECTION OR INTERSECTION WITH REGARDS TO WALLS, BASE, AND FLOORING FINISHES. CONTRACTOR IS
D REMAIN D REMAIN D REMAIN			TO SEEK APPROVAL FROM AOR.
) REMAIN D REMAIN			DOOR SCHEDULE & HARDWARE:
) REMAIN) REMAIN			1. CONTRACTOR SHALL PROVIDE ALL NECESSARY LABOR, PARTS, AND SUPPORT PRODUCTS FOR A COMPLETE DOOR AND DOOR HARWARE INSTALLATION.
REMAIN REMAIN	NOT IN SCOPE		2. CONTRACTOR SHALL VERIFY ALL OPENING DIMENSIONS BEFORE FABRICATION AND INDICATE MEASUREMENTS ON DOOR AND FRAMES SHOP DRAWINGS FOR REVIEW.
) REMAIN			3. ALL DOOR HARDWARE SHALL BE MOUNTED FROM 30"
) REMAIN) REMAIN) REMAIN			TO 44" ABOVE FLOOR.
SH.	GENERAL NOTE: WALL AND CEILING FINISH MATERIALS SHALL NOT EXCEED THE FLAME		DOOR HARDWARE SCHEDULE
	SPREAD AND SMOKE DENSITY INDEXES IN CBC 803.1.1	T١	PE QTY. DESCRIPTION CATALOG NO. FINISH MFR.
OSSVILLE			
/ILLE			
			3 HARDWARE GROUP NO. 3: 3 EA HINGE 5BB1 4.5X4.5 1 EA EA ENTRANCE/OFFICE LOCK ND50PD RHO 613
	SCALE: NTS	3	1 EA FLOOR STOP FS436 630 IVE
	CEILING HT		
		(1	2) HARDWARE GROUP NO. 12: 6 EA HINGE 5BB1 4.5X4.5 613 IVE
			1 EASTOREROOM LOCKND80PD RHO613SCH1 EAFLOOR STOPFS436630IVE
	FFL FFL		
	A501 1		Ŕ
ATIC	DN @ COPY ROOM 114 SCALE: 3/8" = 1'-0"	2	LEGEND
			(PT-1) WALL COLOR
			PL-1 PLASTIC LAMINATE COUNTERTOP
CEILING L	INE		PL-2 PLASTIC LAMINATE CABINET
			PL-3 PLASTIC LAMINATE MILLWORK
			\checkmark
			PLAM PLASTIC LAMINATE BY FURNITURE VENDOR
INISH FLO	OR LINE		
	[[
	SCALE: 3/8" = 1'-0"	1	

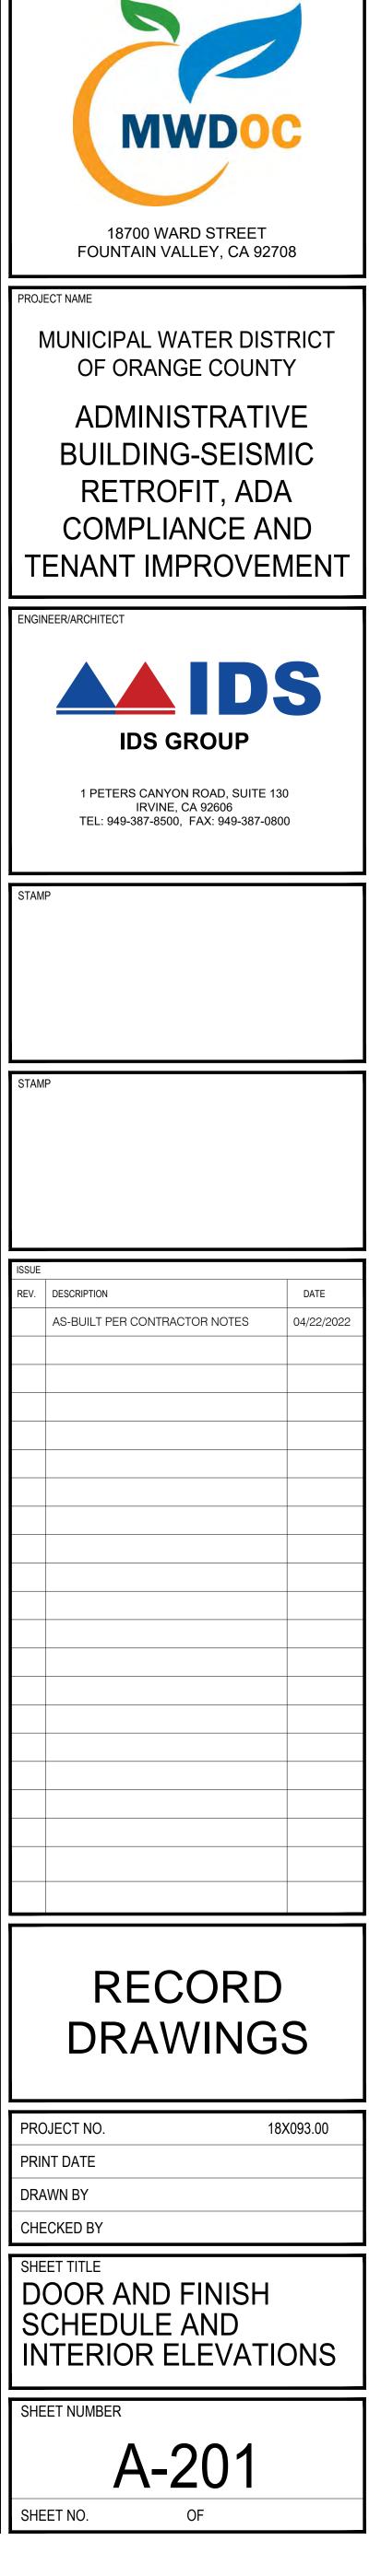


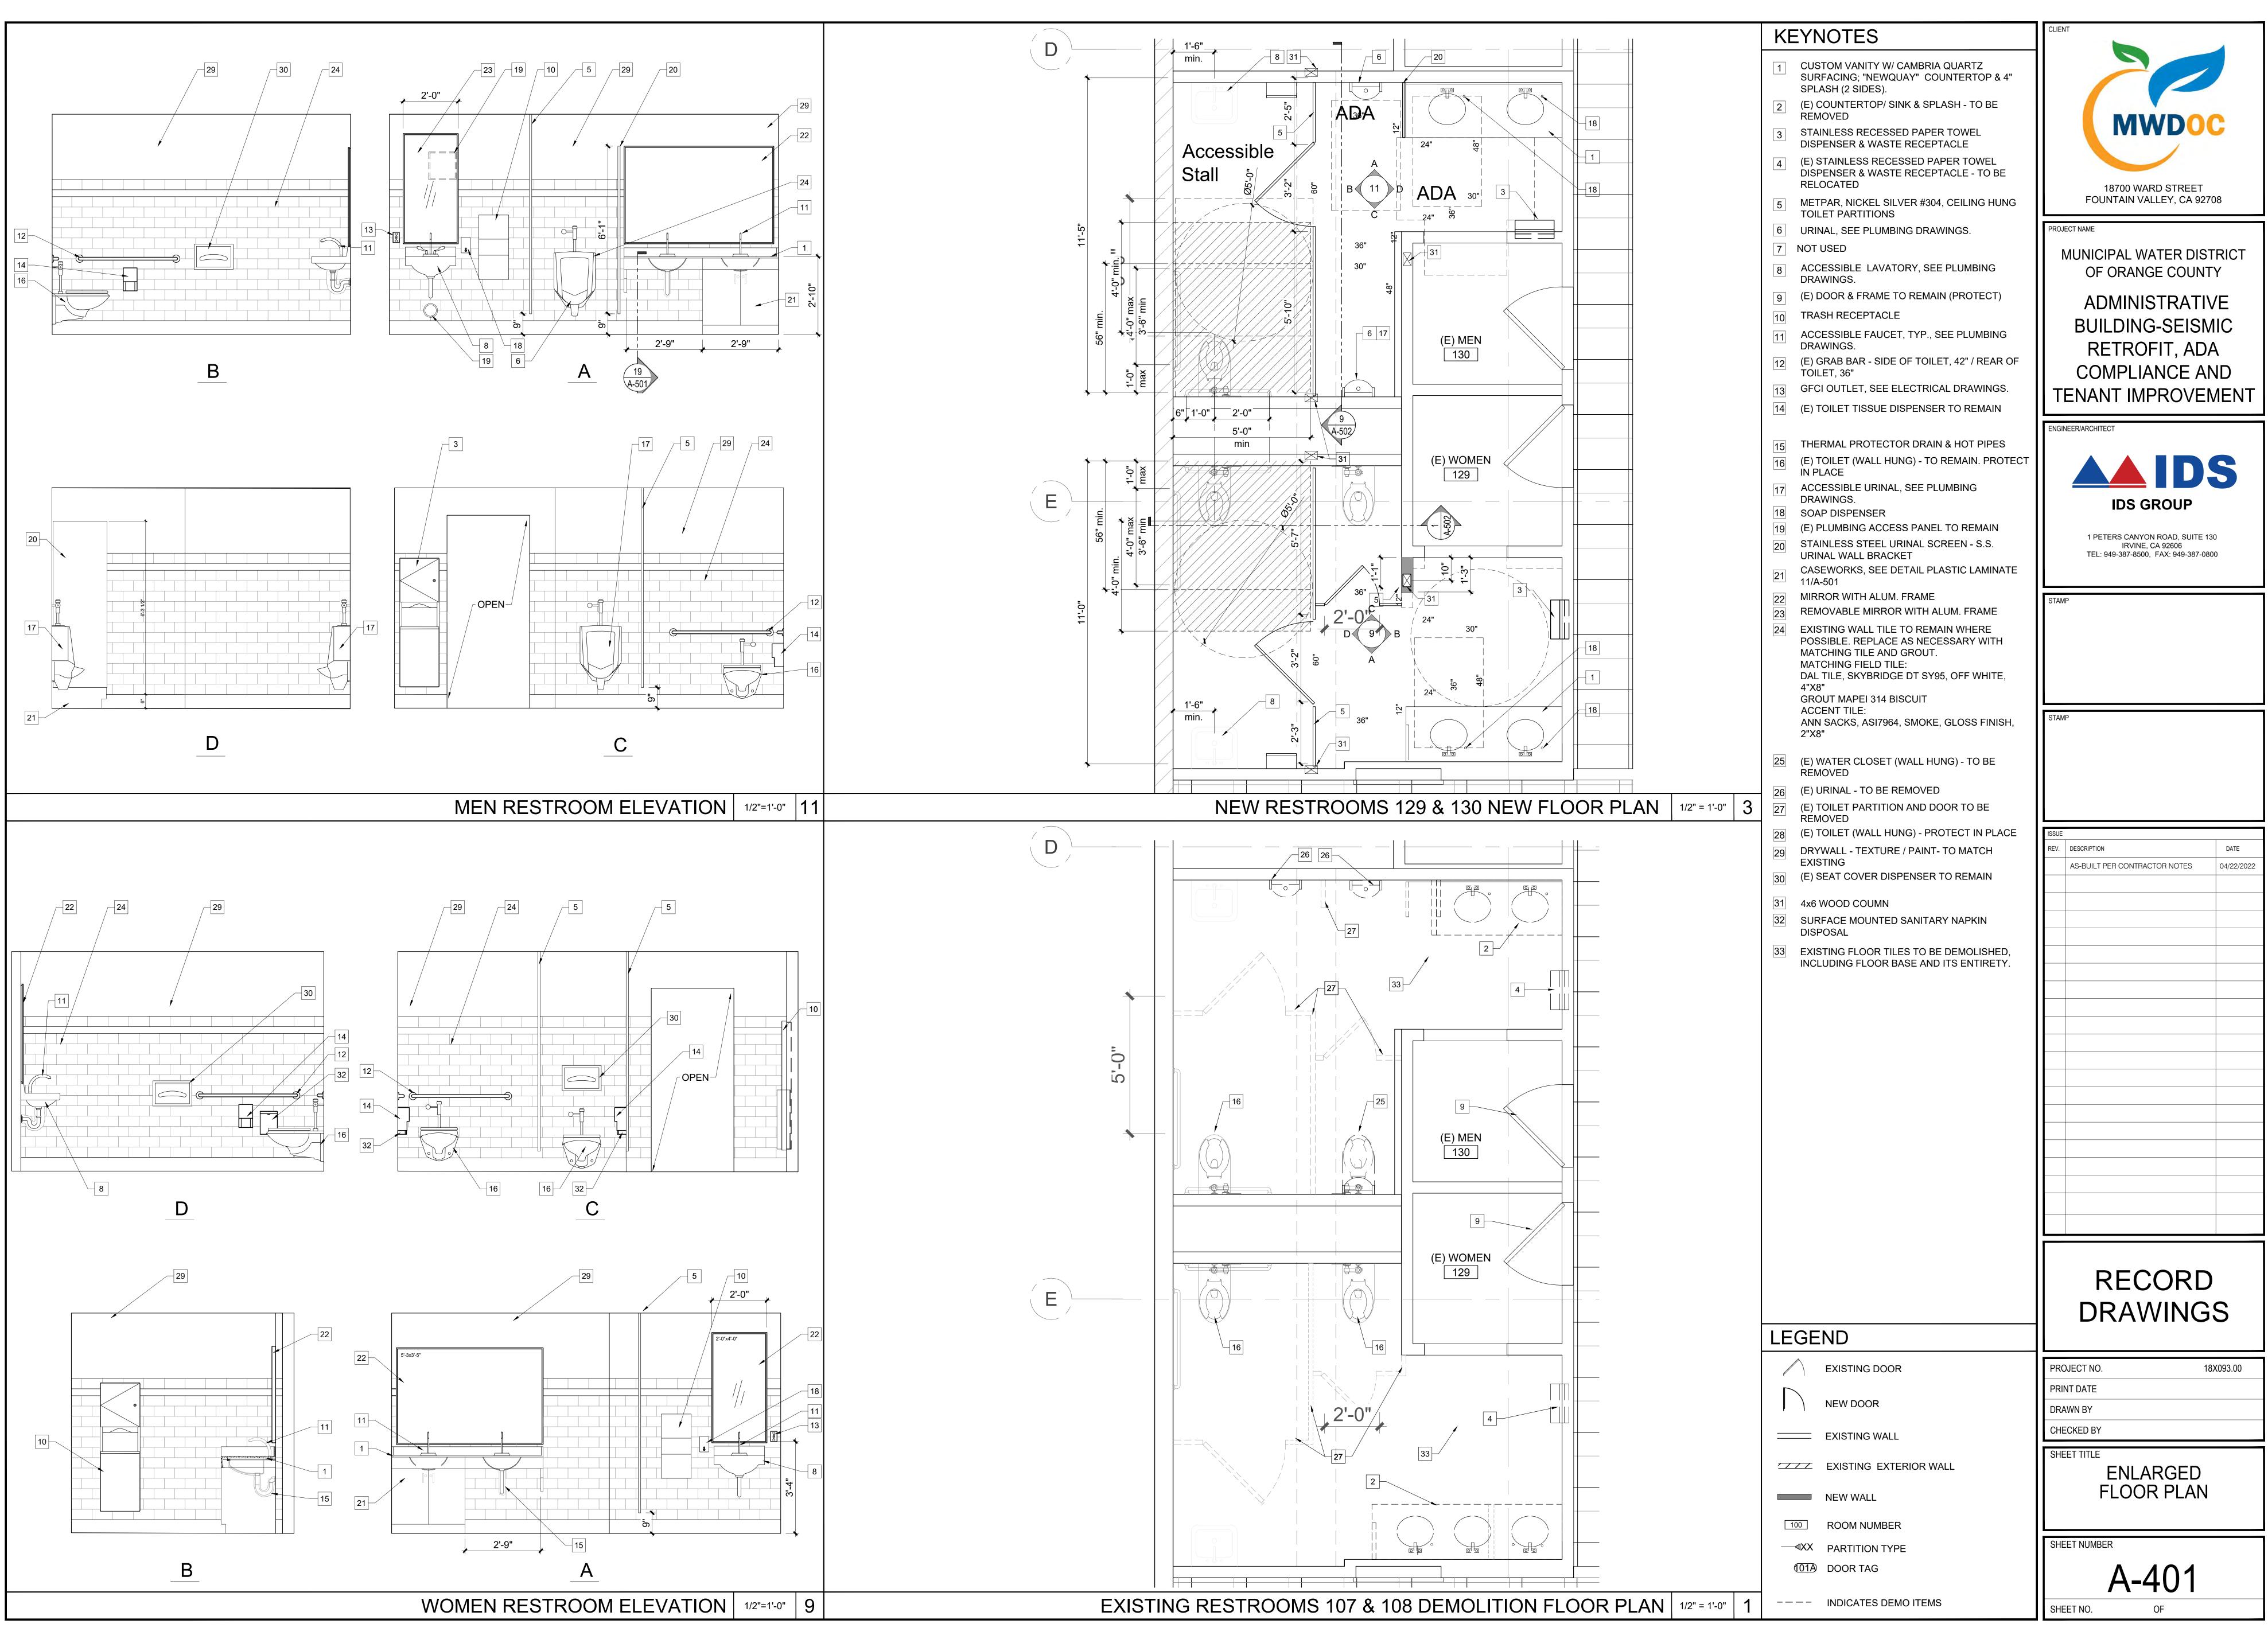


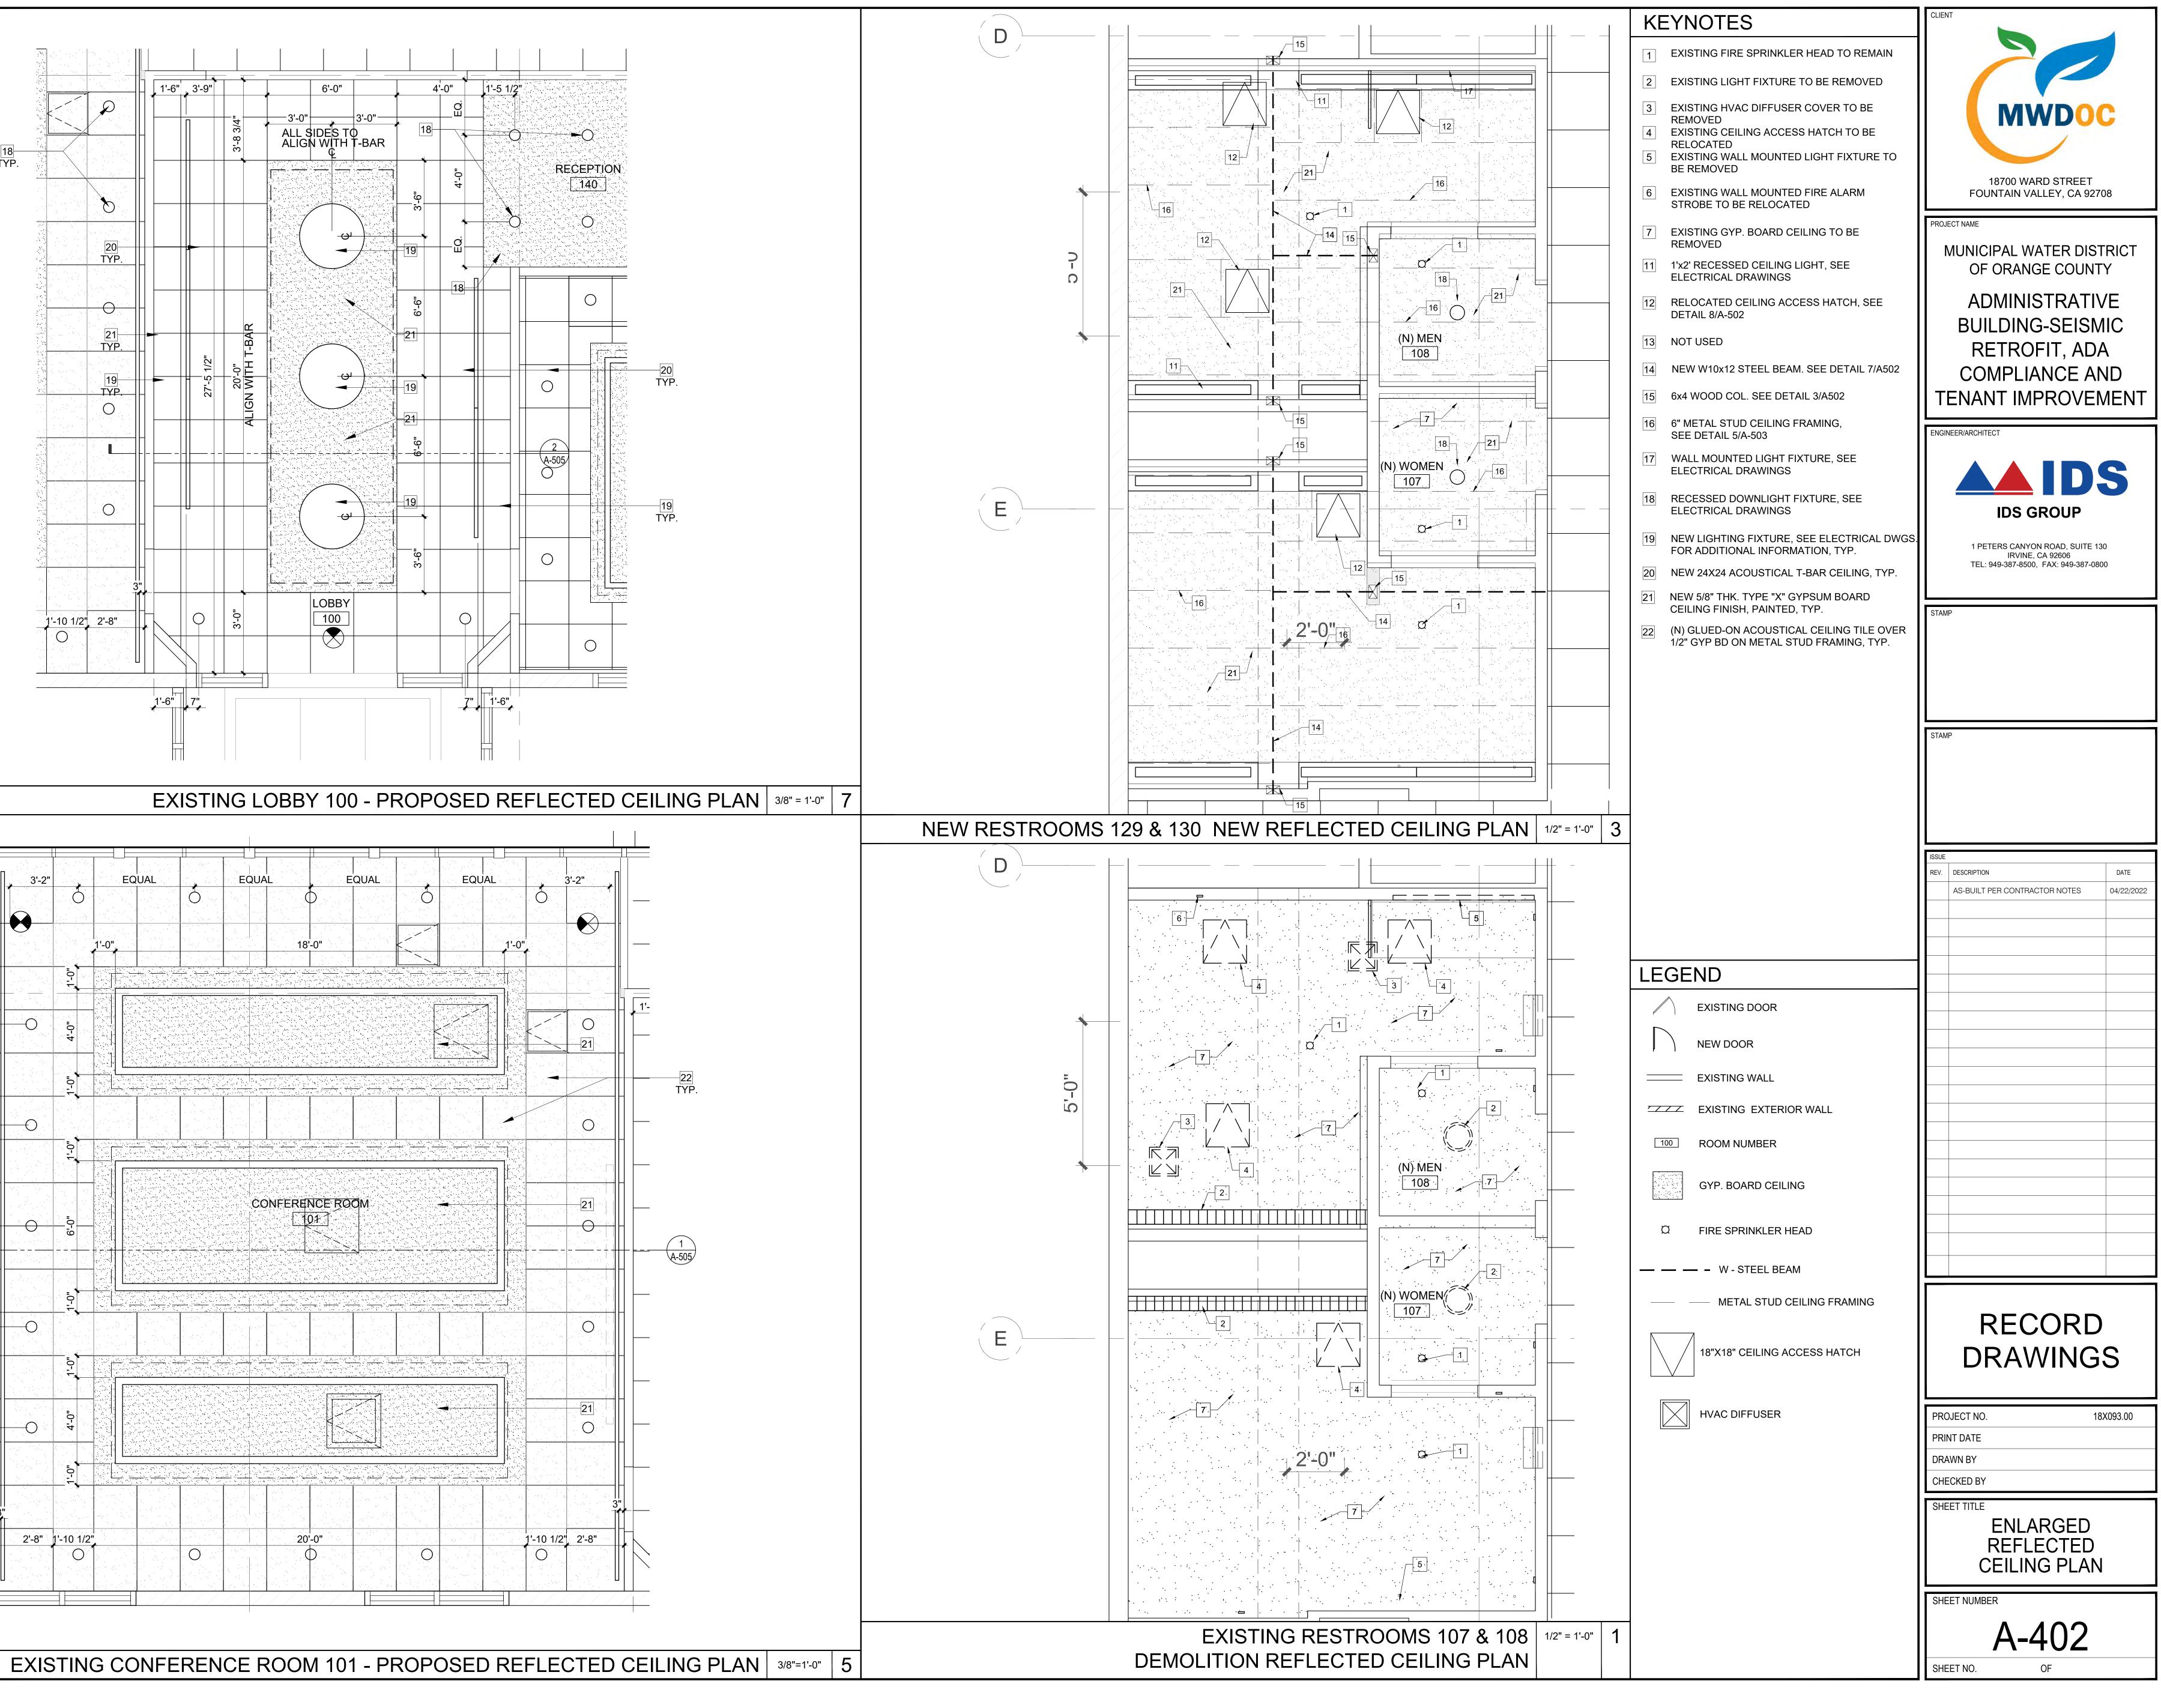


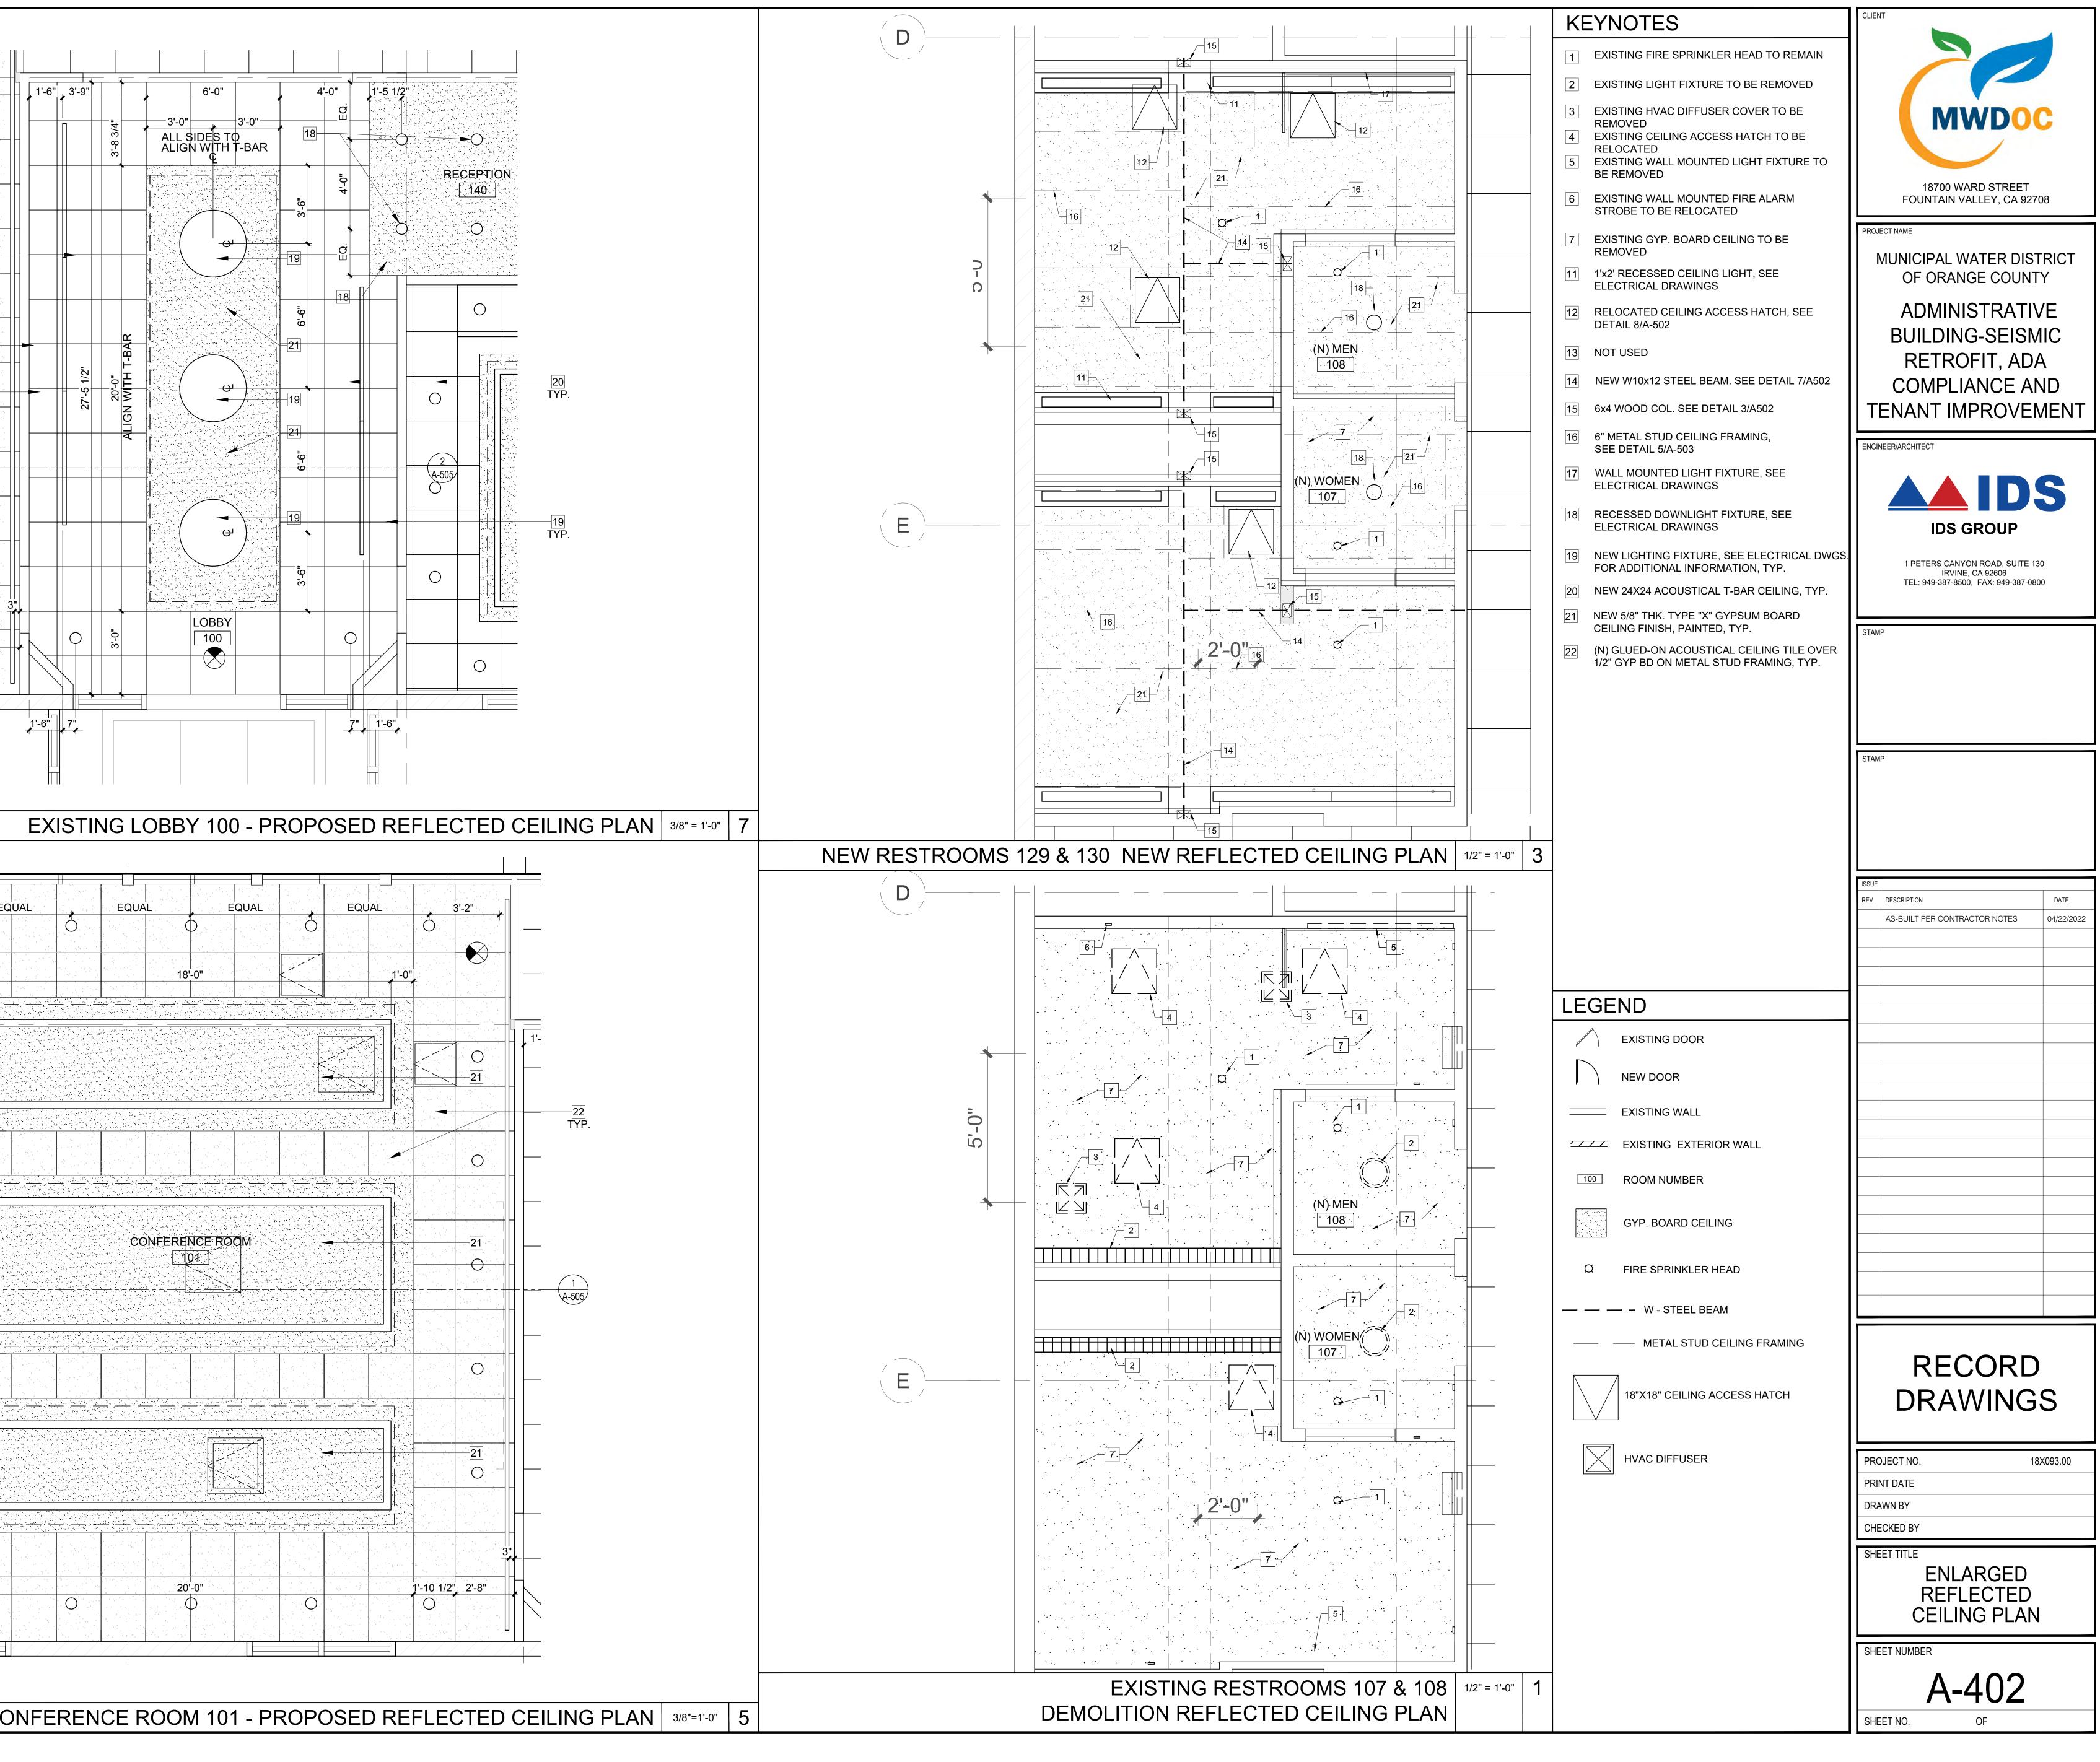


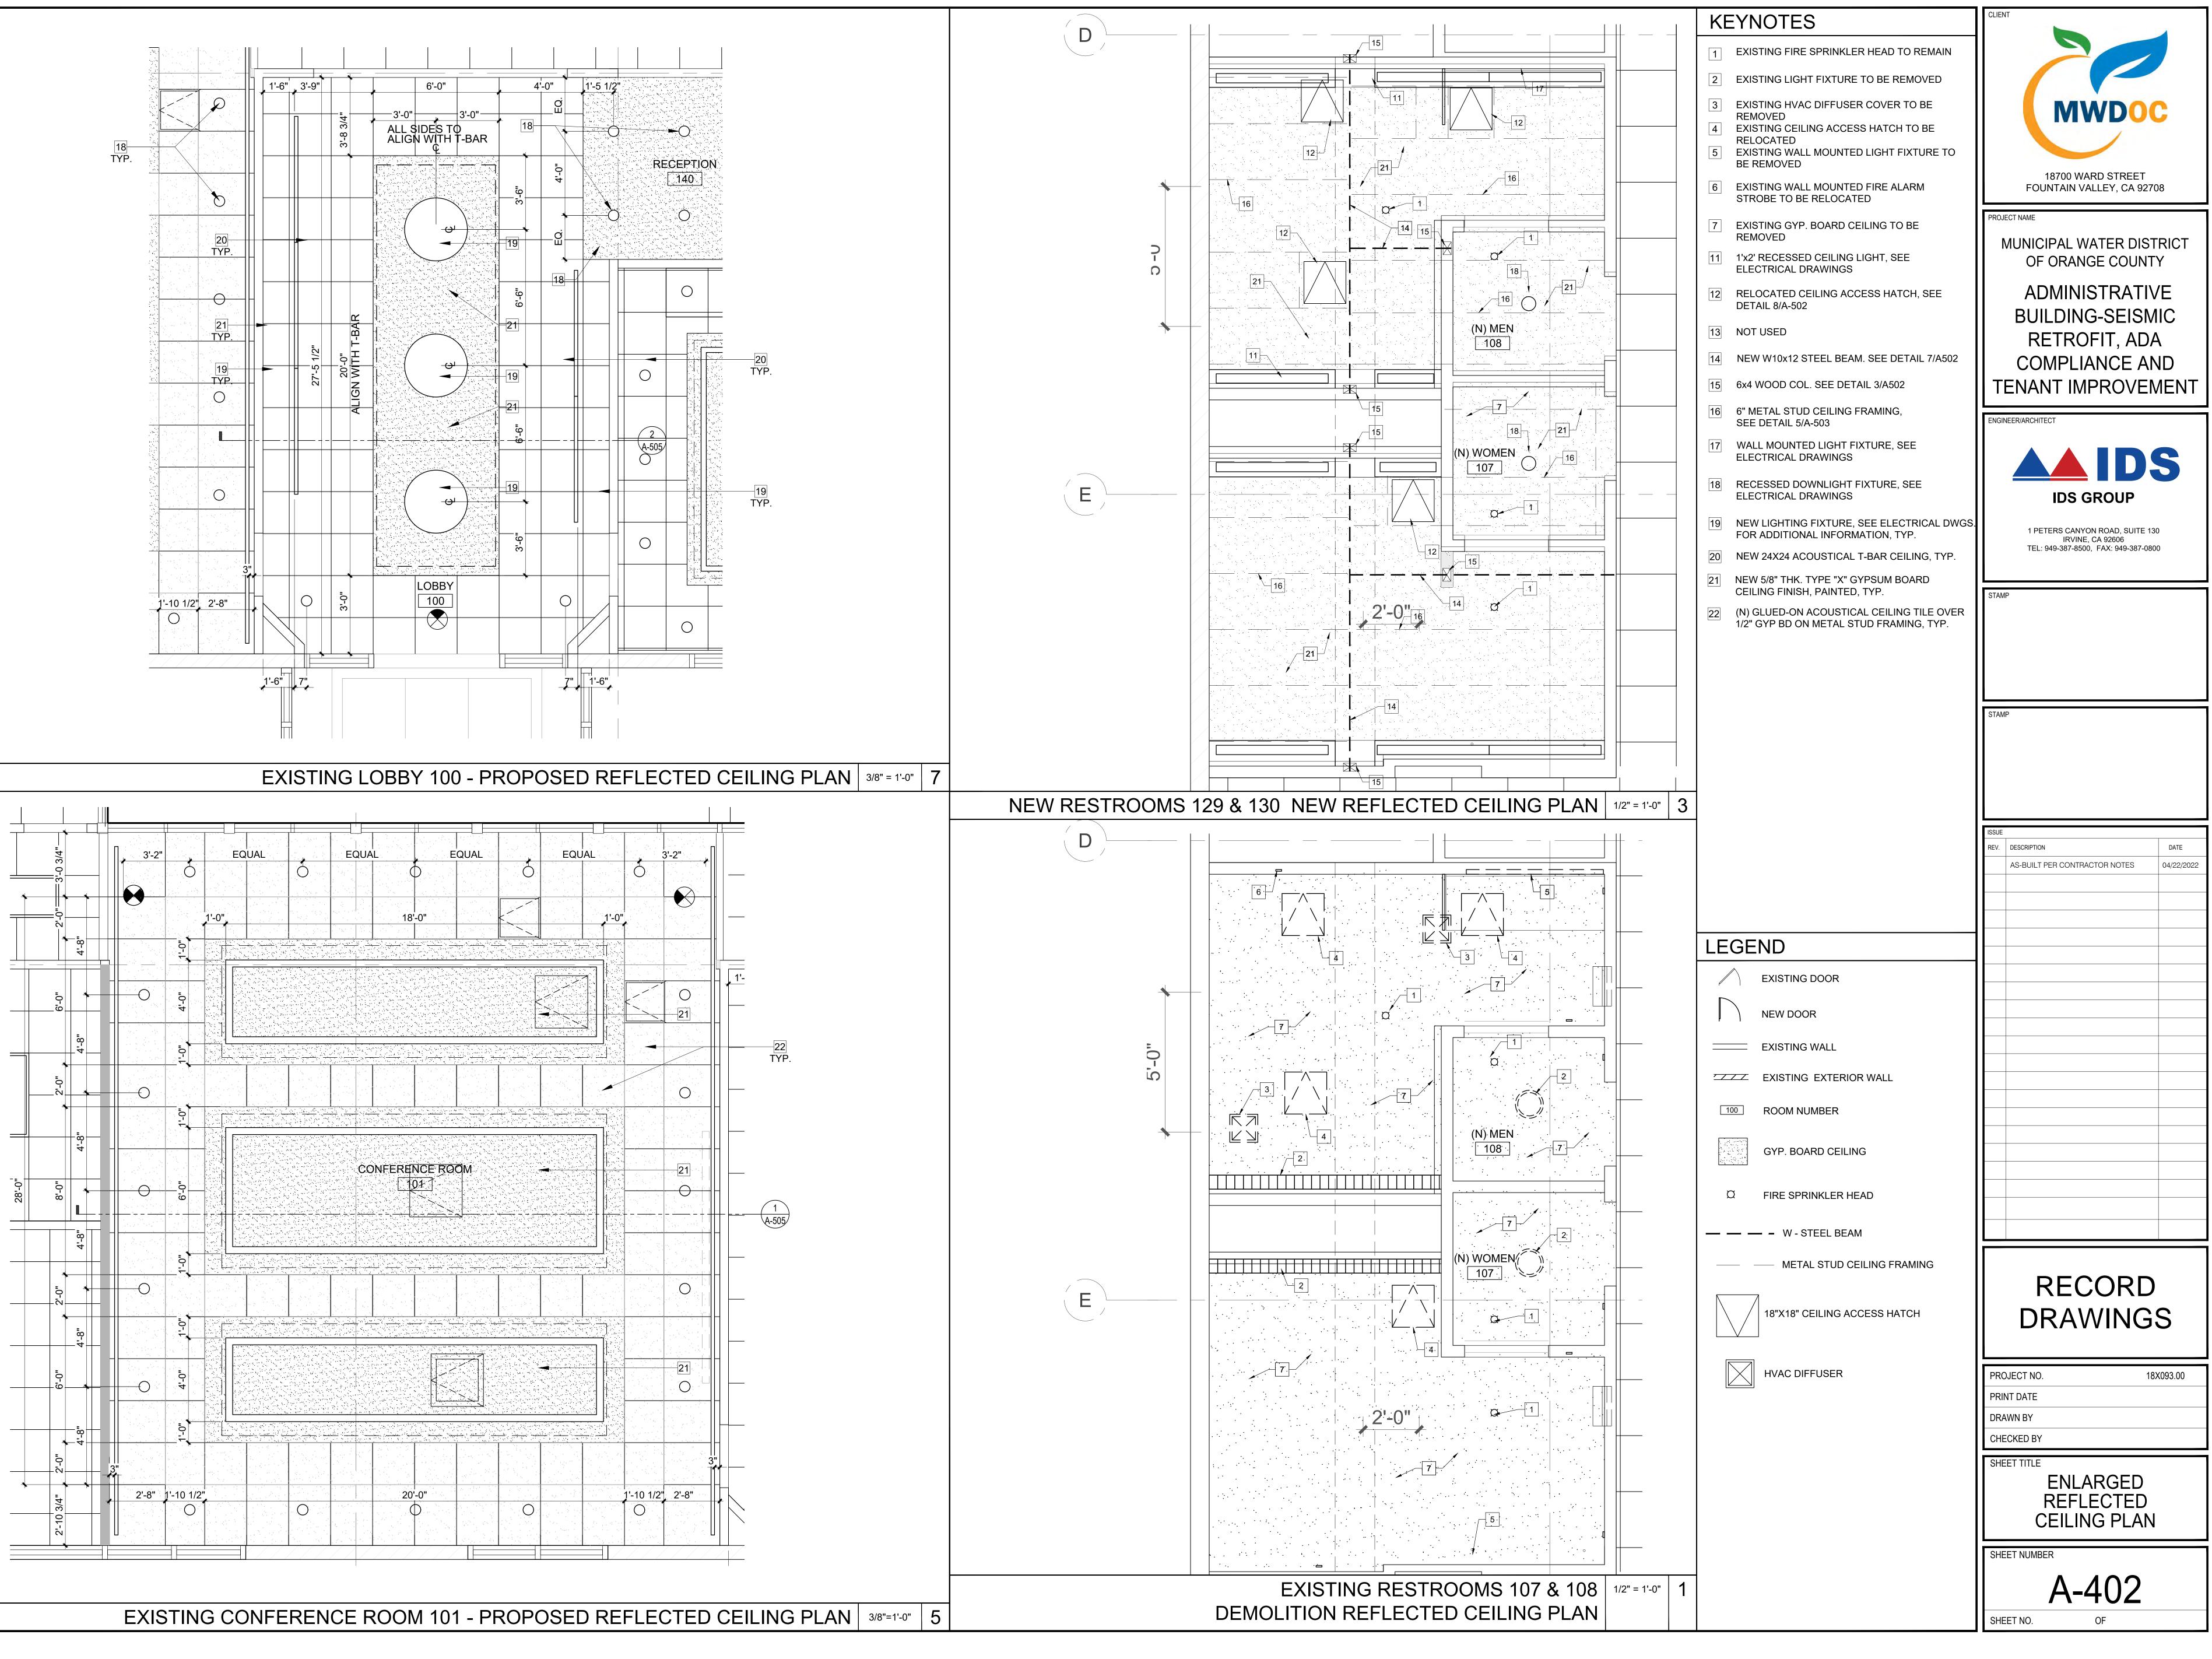


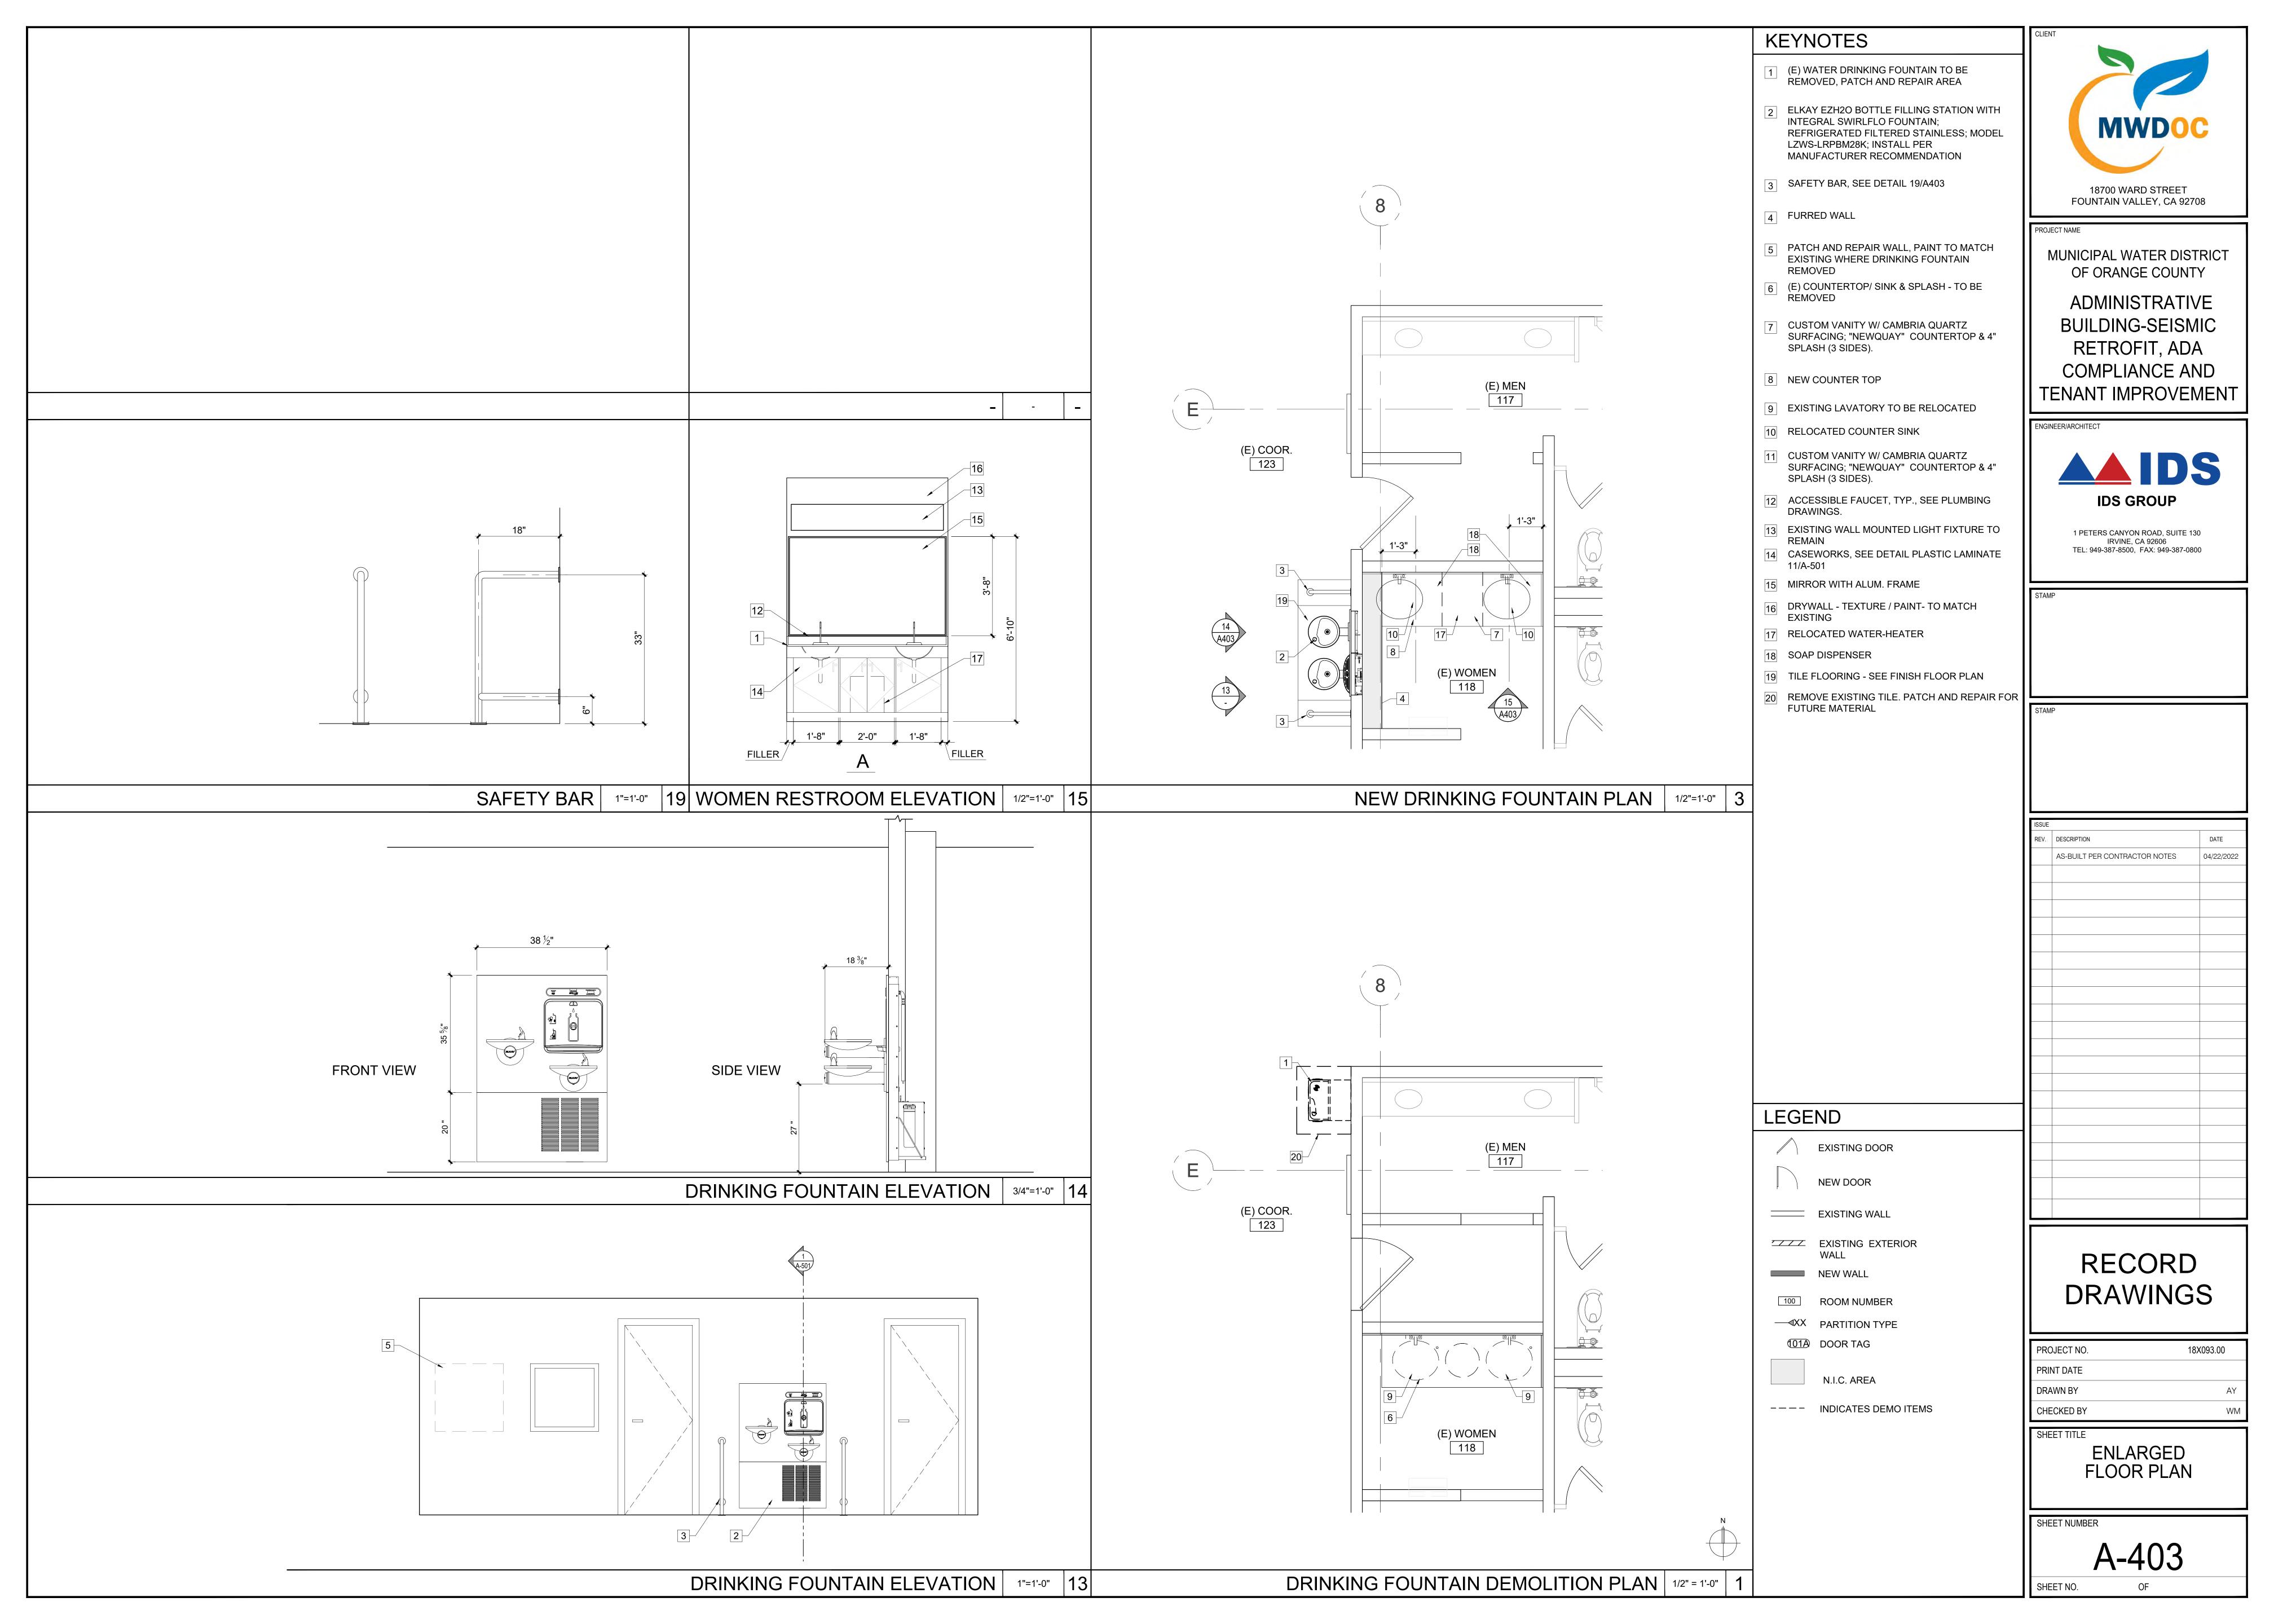


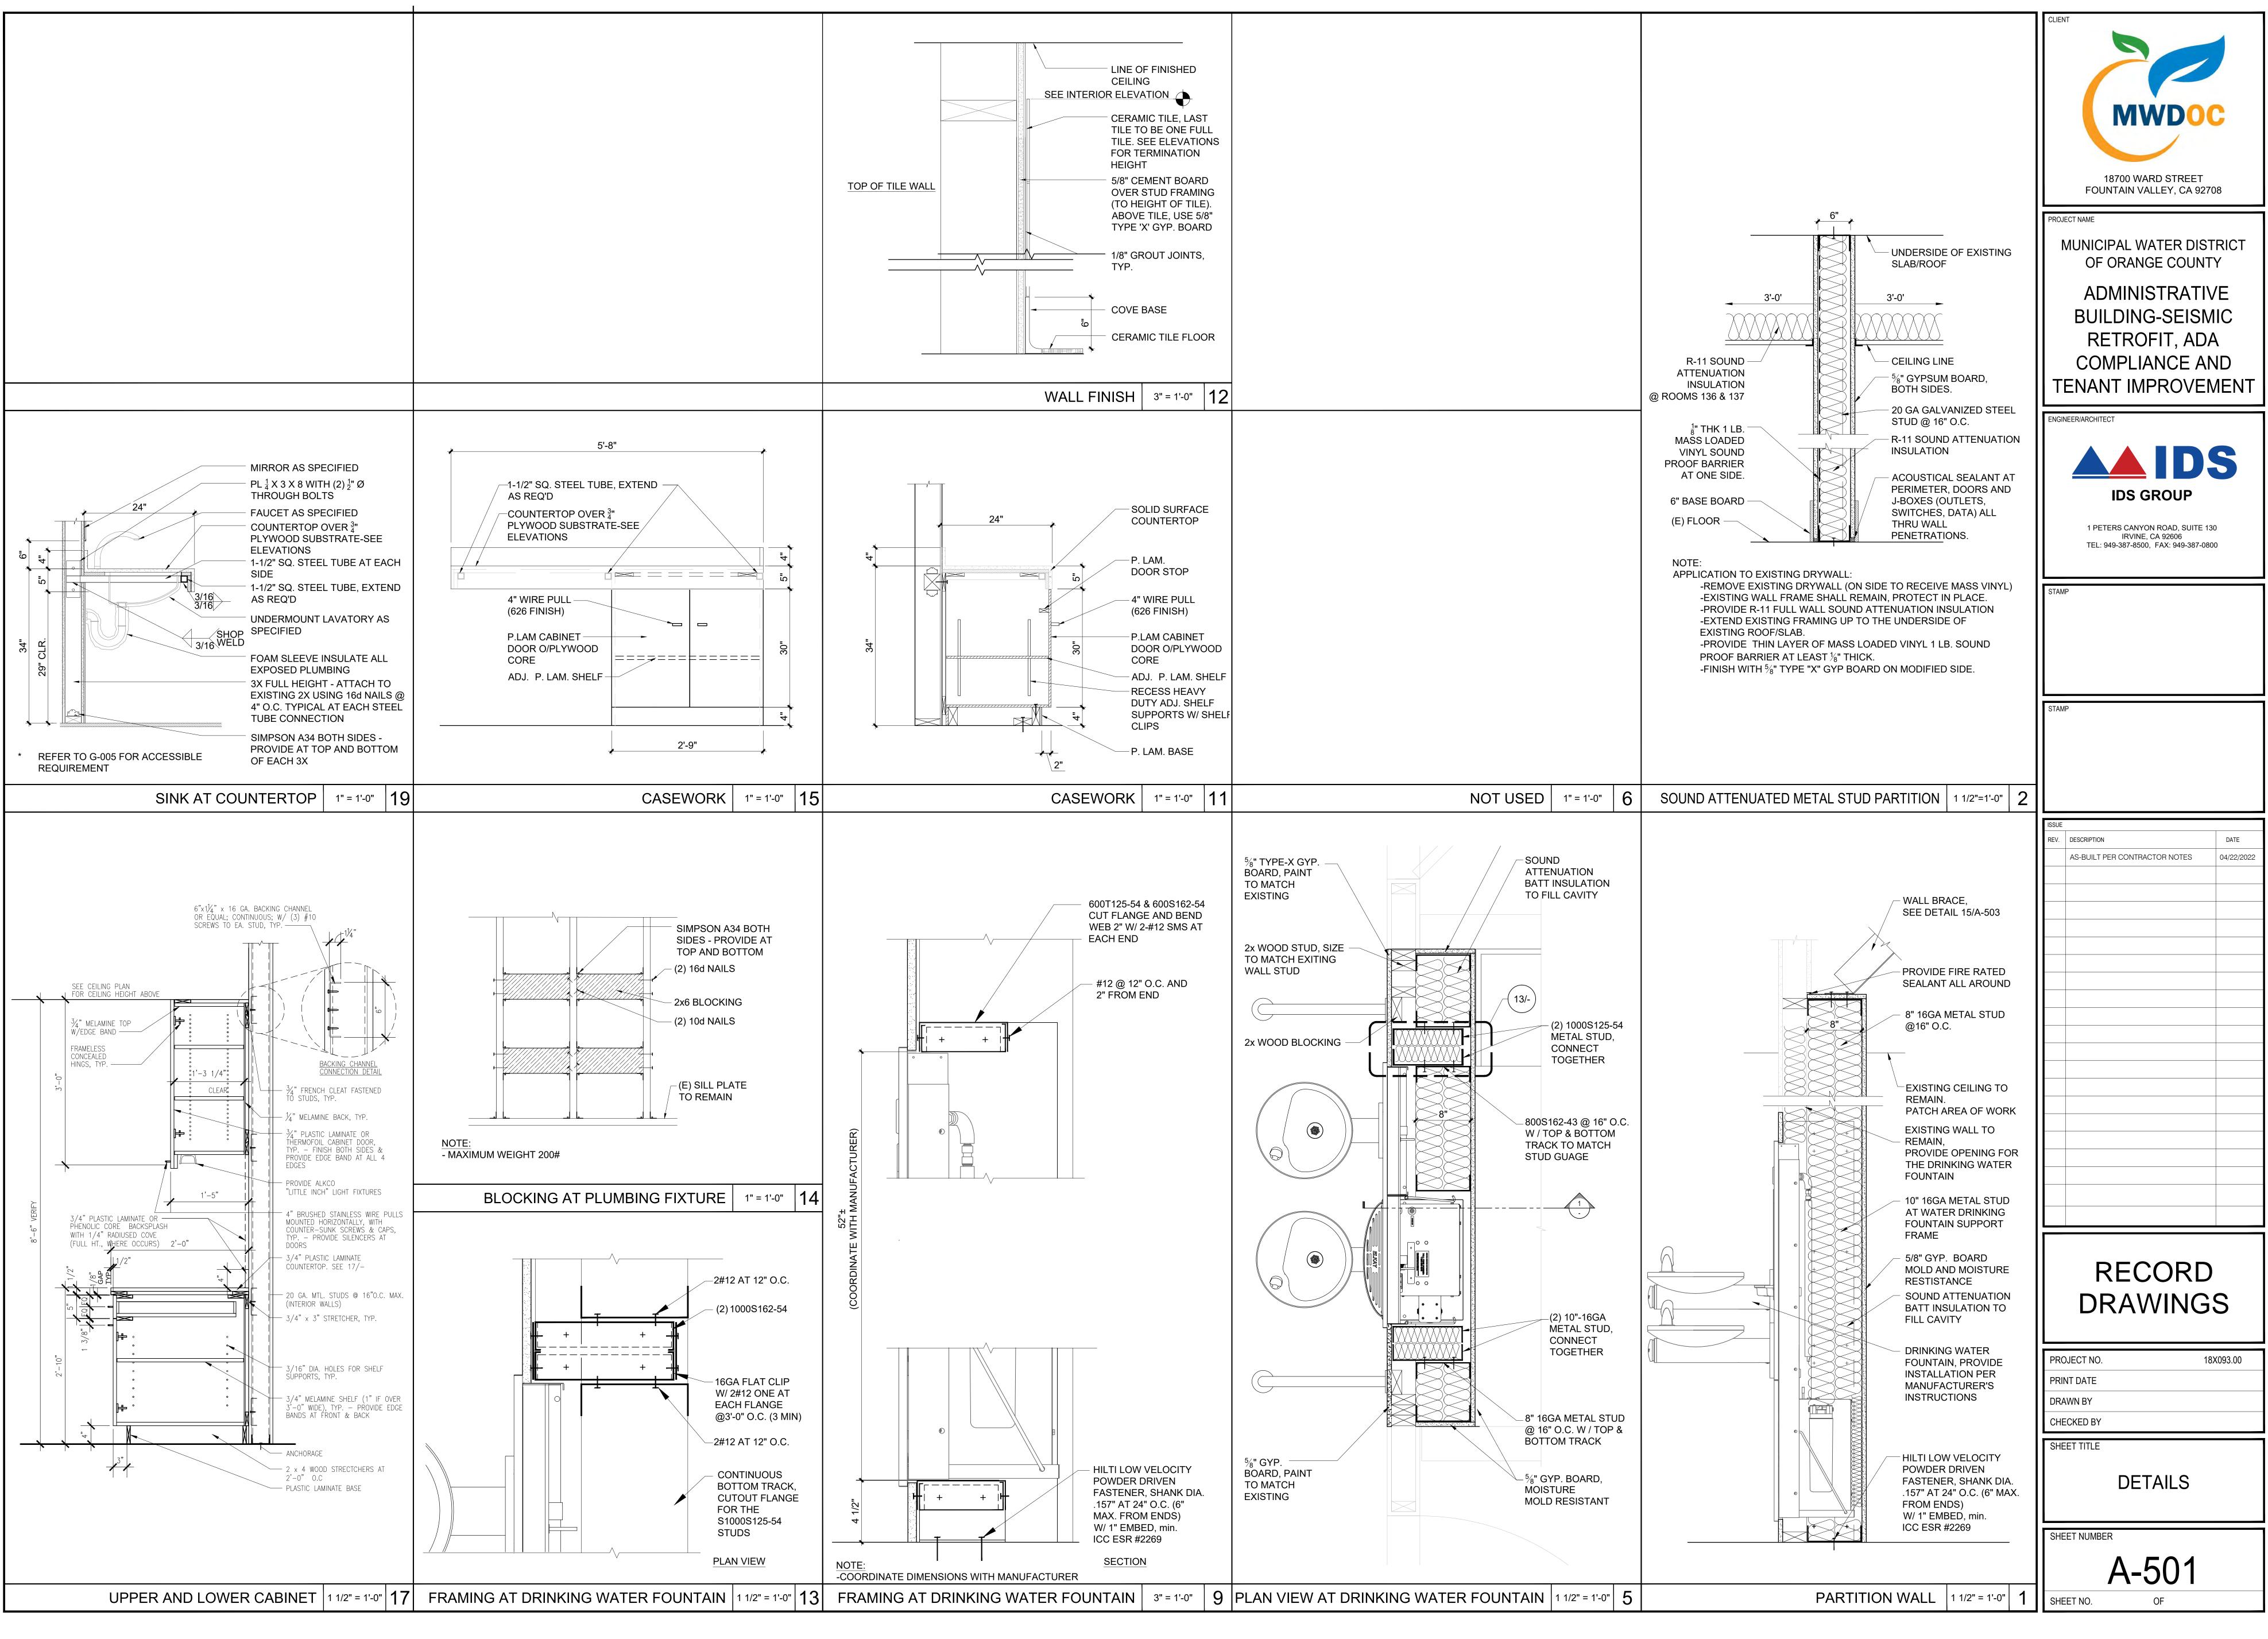

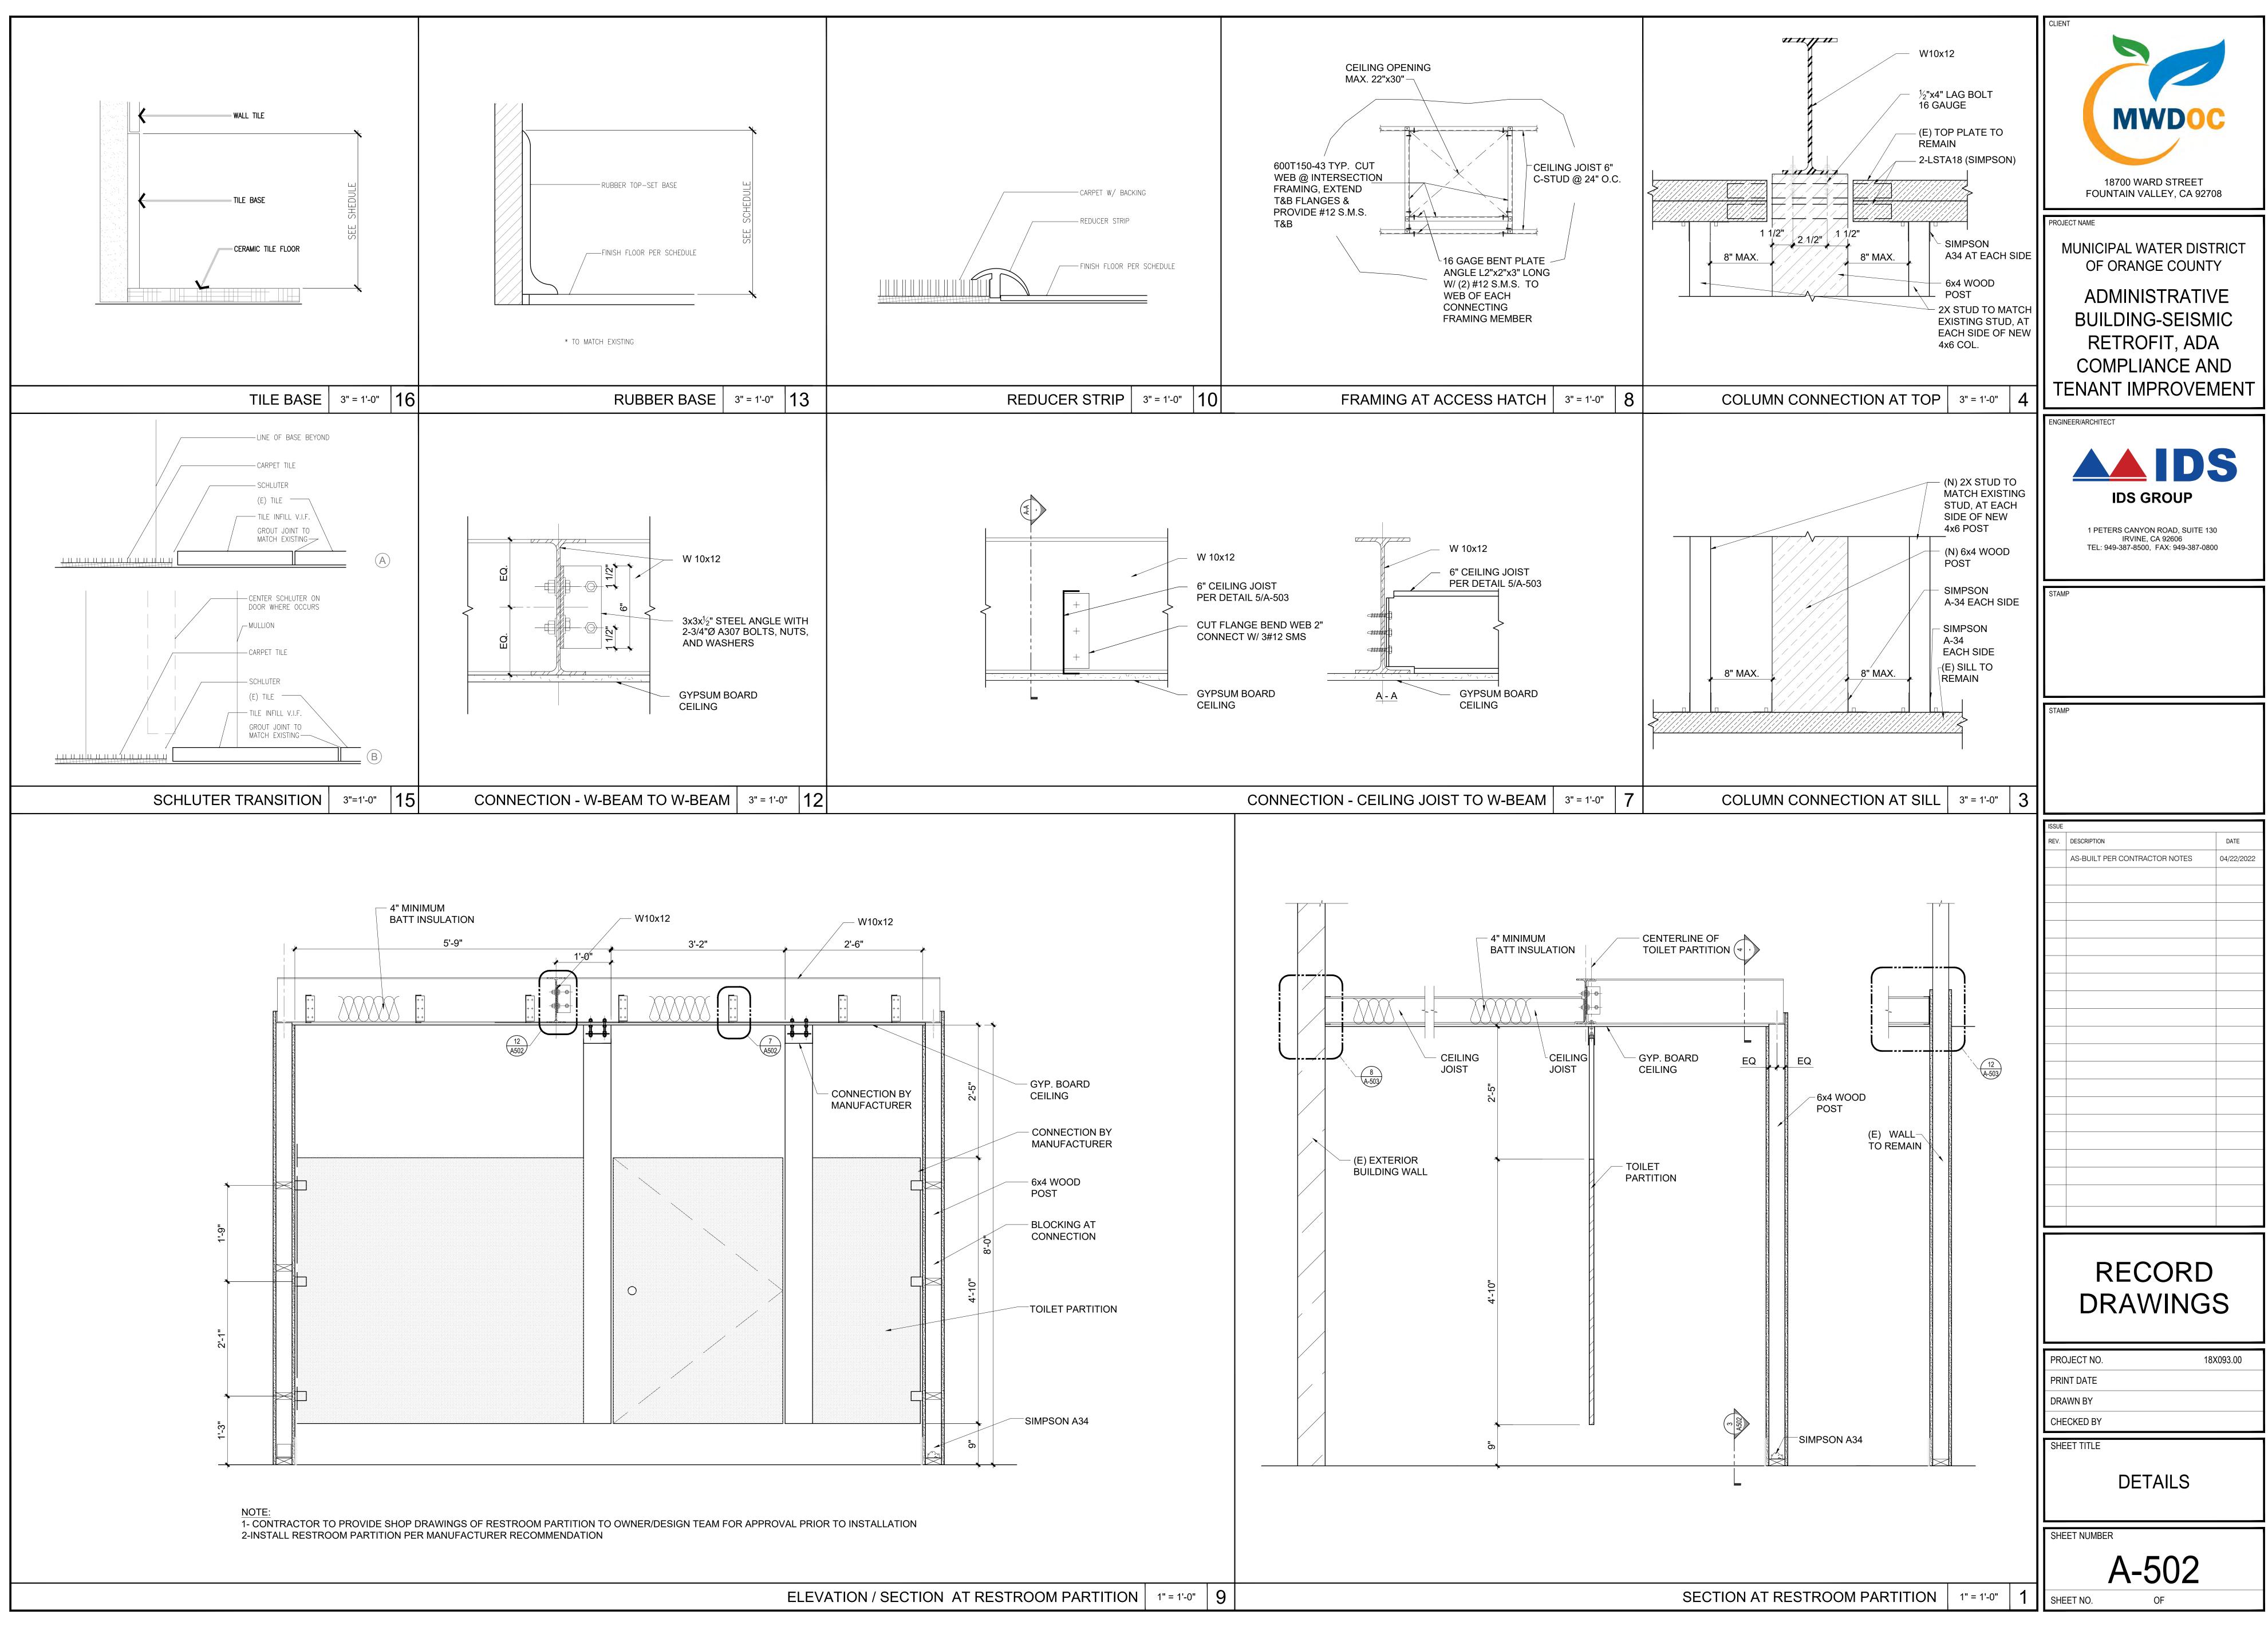

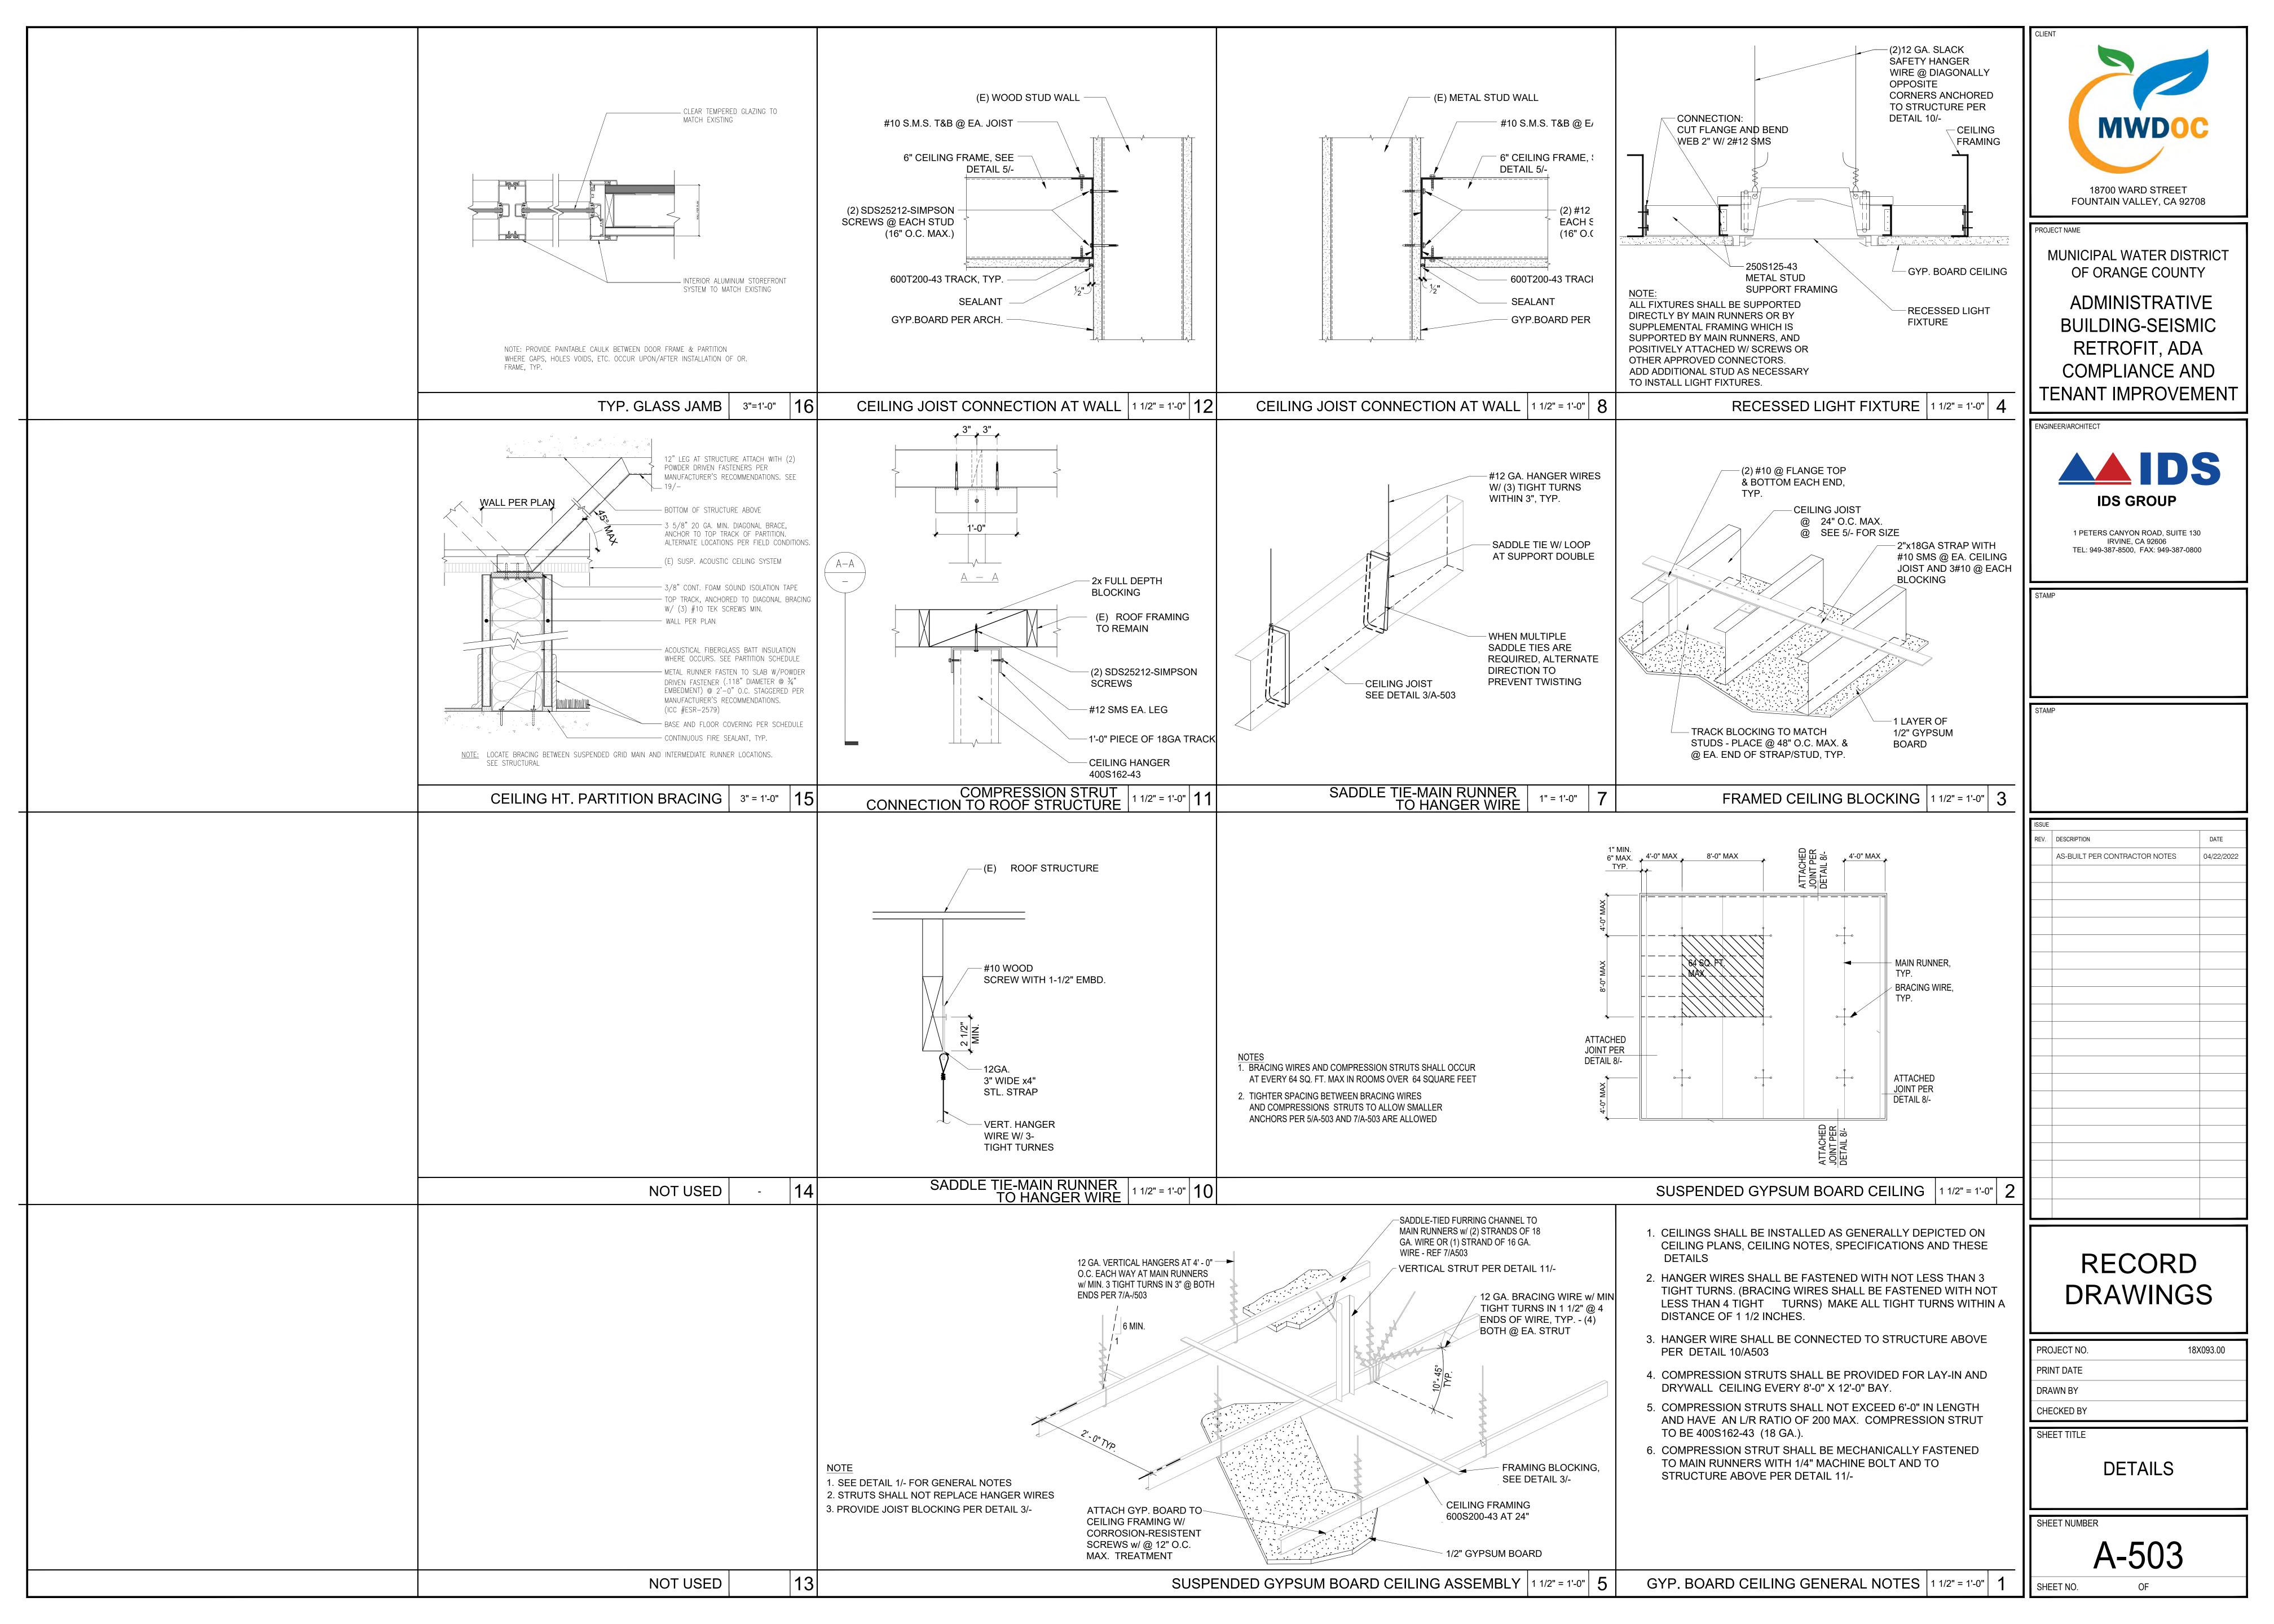

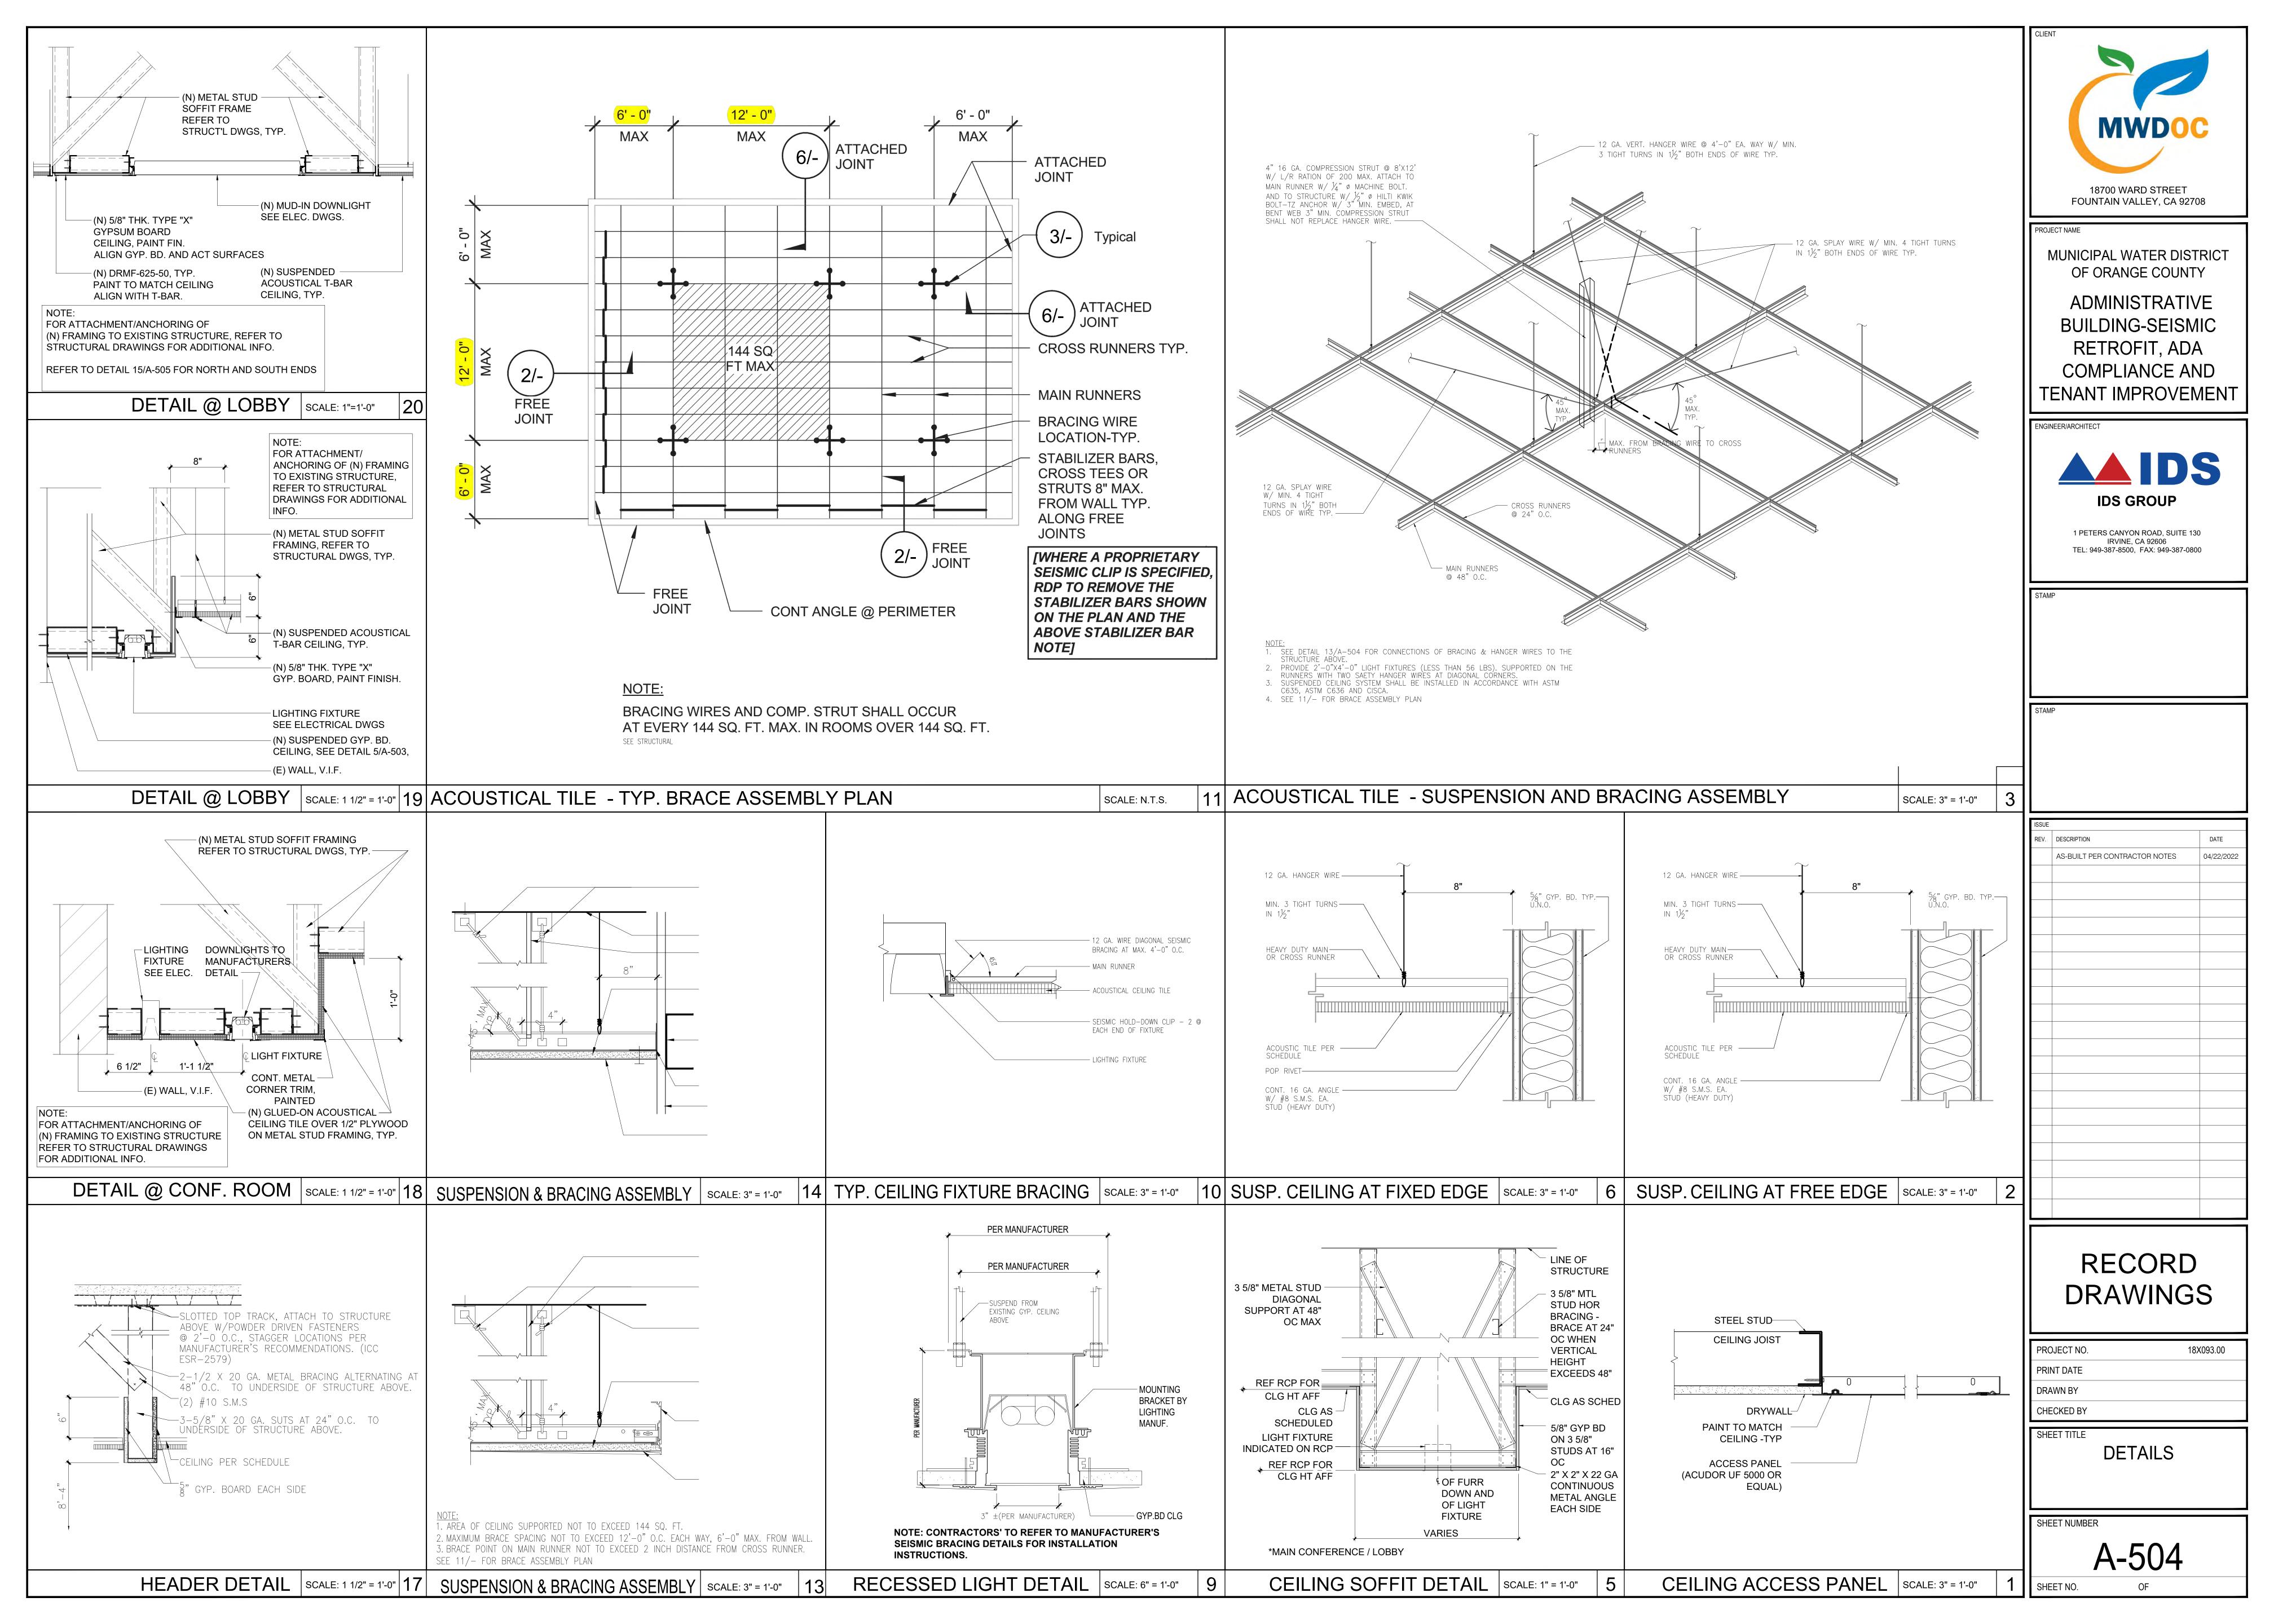


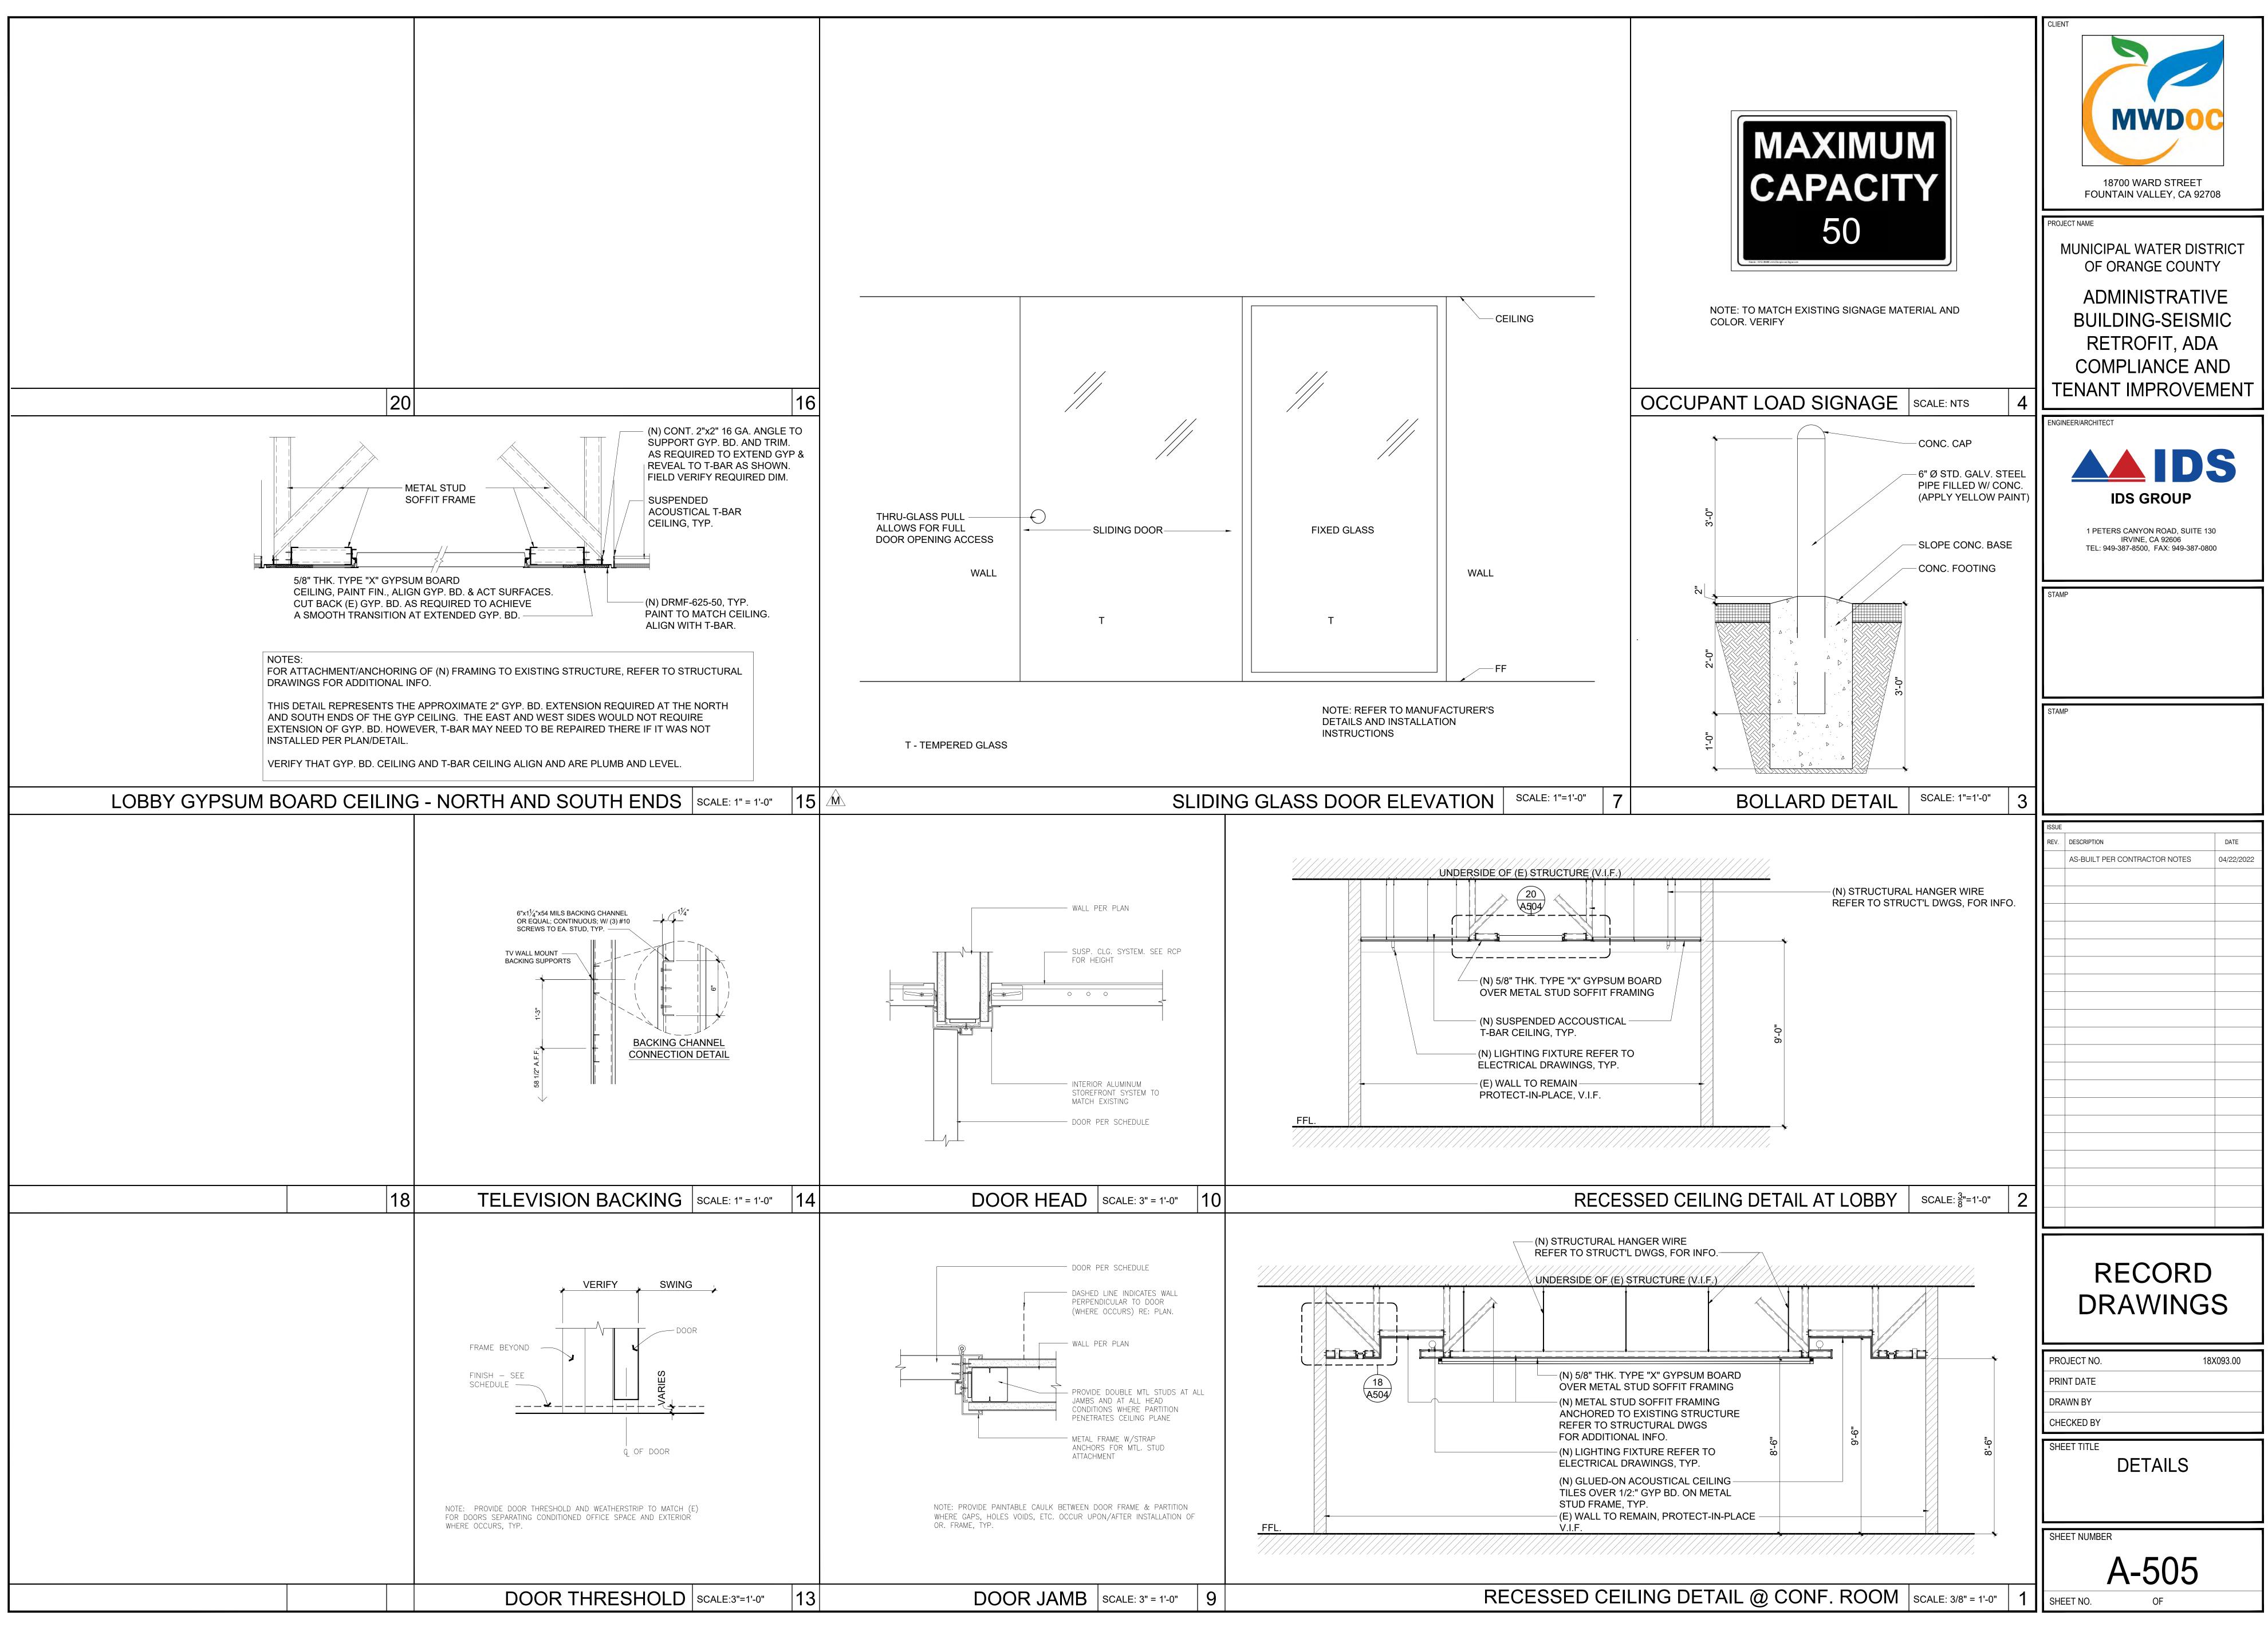

ADMINISTRATIVE BUILDING - SEISMIC RETROFIT, ADA COMPLIANCE AND TENANT IMPROVEMENT

PROJECT DESCRIPTION PROJECT DATA THIS PROJECT IS INTENDED TO SUBSTANTIALLY IMPROVE THE SEISMIC PROJECT ADDRESS: 18700 WARD STREET PERFORMANCE OF THE BUILDING THROUGH THE UPGRADE OF CONNECTIONS FOUNTAIN VALLEY, CA 92708 BETWEEN HORIZONTAL AND VERTICAL LATERAL LOAD RESISTING ELEMENTS. 156-101-06 APN: 12,280 S.F. ADDITIONALLY, THE EXISTING FIRE SPRINKLER SYSTEM WILL BE IMPROVED TO A BUILDING AREA: HIGH SEISMIC PERFORMANCE STANDARD BY ADDING DIVERSE TRANSVERSE AND STORIES: LONGITUDINAL SWAY BRACING. CONSTRUCTION TYPE: V-B, SPRINKLERED OCCUPANCY: CONTACTS APPLICABLE CODES OWNER: 2016 CALIFORNIA REFERENCED STANDARDS CODE, PART 1, TITLE 24 C.C.R. MUNICIPAL WATER DISTRICT OF ORANGE COUNTY 18700 WARD STREET 2016 CALIFORNIA BUILDING CODE (CBC), PART 2, TITLE 24 C.C.R. FOUNTAIN VALLEY, CA 92708 CONTACT: KELLY HUBBARD, EMERGENCY SERVICE MANAGER 2016 CALIFORNIA ELECTRICAL CODE (CEC), PART 3, TITLE 24 C.C.R. (2014 NEC) PHONE: 714-593-5010 2016 CALIFORNIA FIRE CODE, PART 9, TITLE 24 C.C.R. STRUCTURAL ENGINEER: 2016 CALIFORNIA EXISTING BUILDING CODE, PART 10, TITLE 24 C.C.R. IDS GROUP, INC. 1 PETERS CANYON ROAD, SUITE 130 2016 TITLE 19 C.C.R. PUBLIC SAFETY, STATE FIRE MARSHAL REGULATIONS. IRVINE, CA 92606 AMERICANS WITH DISABILITIES ACT PHONE: (949) 387-8500

VICINITY MAP

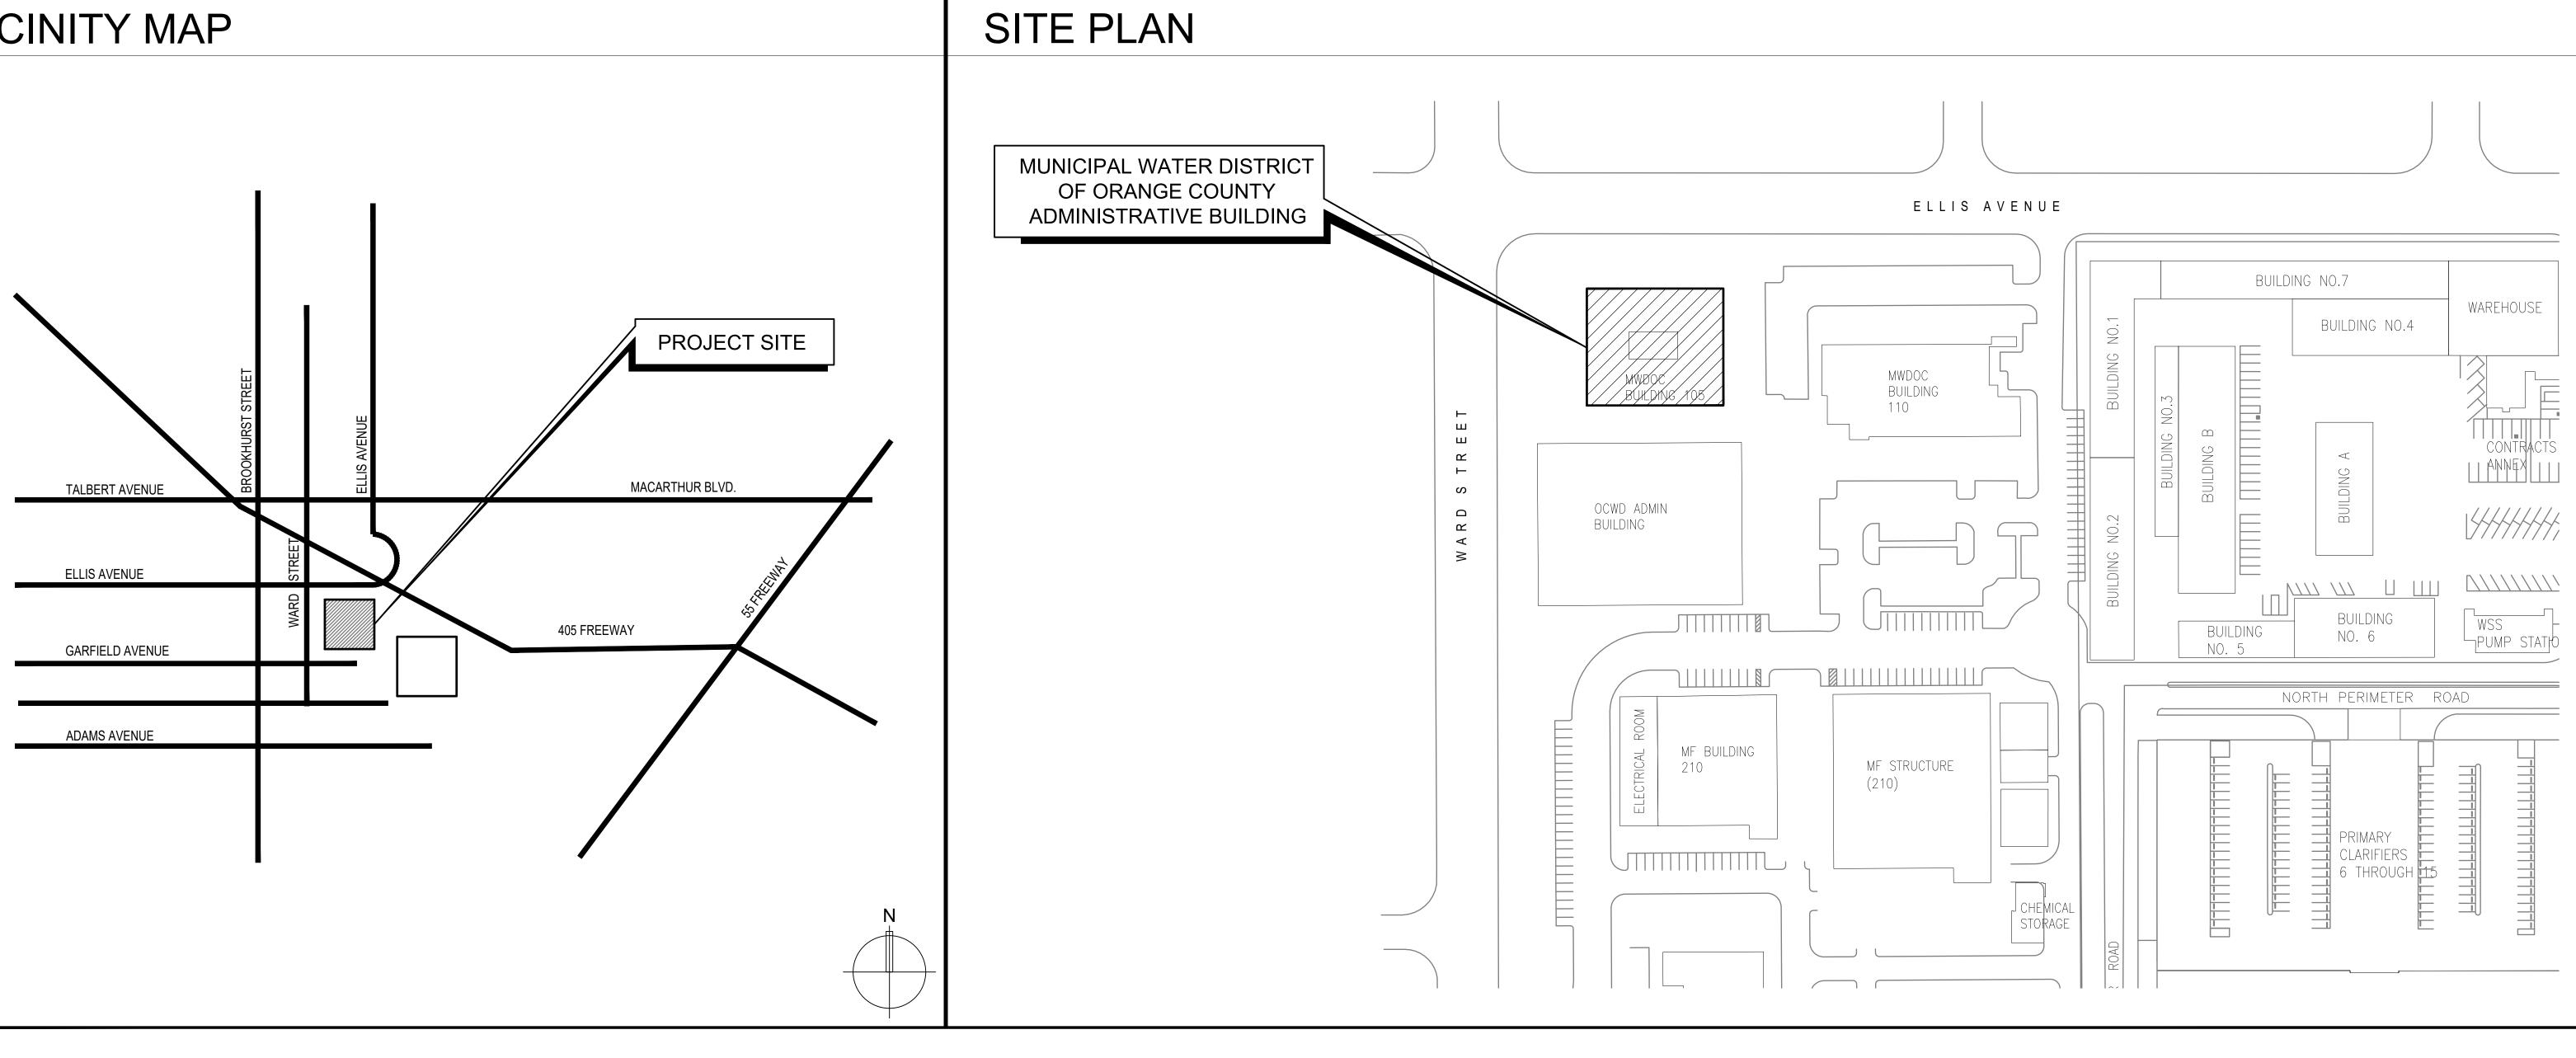

MUNICIPAL WATER DISTRICT OF ORANGE COUNTY

18700 WARD STREET FOUNTAIN VALLEY, CA 92708

THE SCOPE OF WORK FOR THIS PROJECT CONSISTS OF THE FOLLOWING ITEMS:

- 1. STRENGTHEN THE FOLLOWING SEISMIC ELEMENTS PER ENHANCED SEISMIC PERFORMANCE OF ASCE 41-13:
- OUT-OF-PLANE ROOF-TO-WALL ANCHORAGE. - ROOF DIAPHRAGM SHEAR TRANSFER TO PERIMETER WALLS.

MEETING CBC/ASCE7 AND NFPA-13 REQUIREMENTS.


- ROOF DIAPHRAGM CHORDS. - DRAGLINES/COLLECTORS AND CONNECTIONS AT COURTYARD CORNER
- COLUMNS. STRENGTHEN EXISTING FIRE SPRINKLER SYSTEM THROUGH THE ADDITION OF TRANSVERSE AND LONGITUDINAL BRACING CONSISTENT WITH SEISMIC DESIGN LOAD LEVELS AND TYPICAL DETAILING/PRACTICE FOR ESSENTIAL FACILITIES

- ADA UPGRADES TRIGGERED BY EXTENT OF SEISMIC IMPROVEMENT WORK IN ACCORDANCE WITH APPLICABLE CODES.

SHEET INDEX

		<u>GENERAL</u>
T0.0	COVER SHEET	
		<u>STRUCTURAL</u>
S1.0 S1.1	GENERAL NOTES GENERAL NOTES	

S2.2	ROOF FRAMING PLAN
S2.3	EXISTING FIRE SPRINKLER PLAN
S5.1	DETAILS AND SECTIONS
S5.2	DETAILS AND SECTIONS
S5.3	DETAILS AND SECTIONS

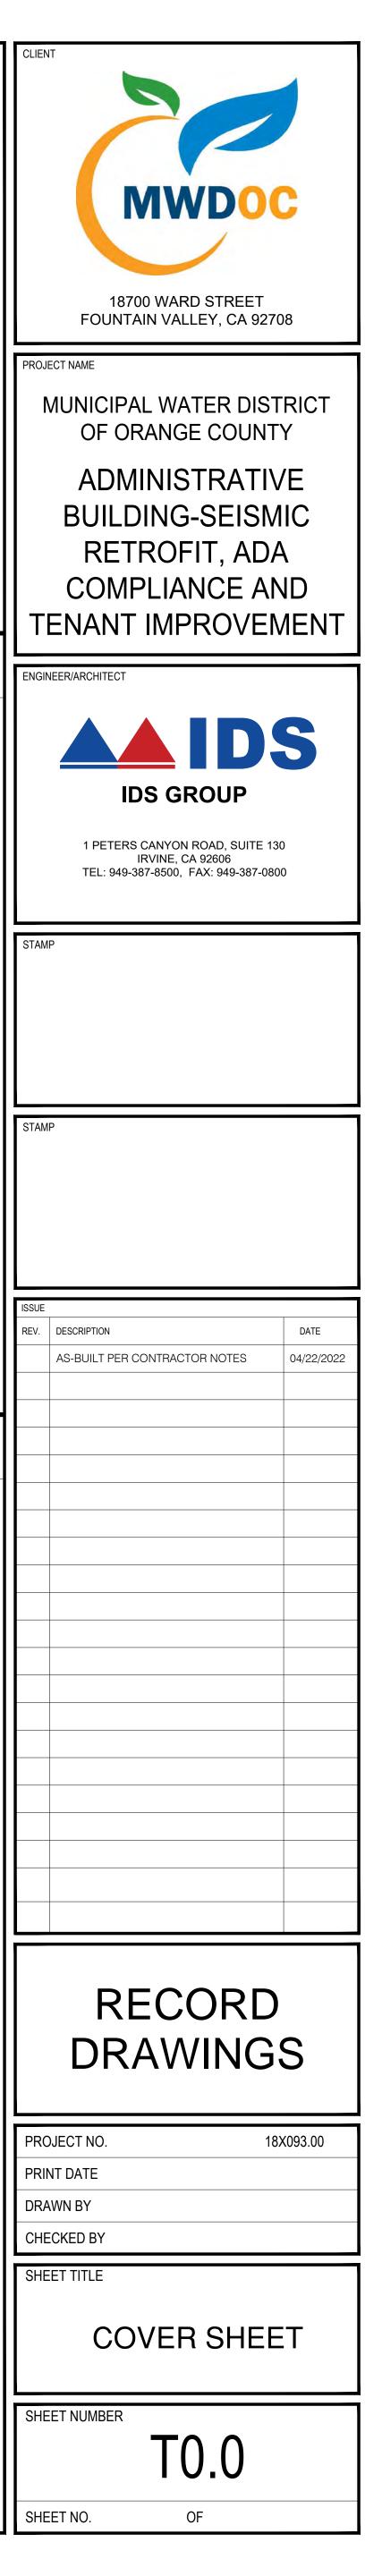

	REQUIRED VERIFICATION AND INSPECTION	UF SIEEL CC	INSTRUCTION	1
	VERIFICATION AND INSPECTION	CONTINUOUS	PERIODIC	REFERENCE STANDARD
•	MATERIAL VERIFICATION OF HIGH-STRENGTH BOLTS, NUTS AND WAS	HERS:		
	a. IDENTIFICATION MARKINGS TO CONFORM TO ASTM STANDARDS SPECIFIED IN THE APPROVED CONSTRUCTION DOCUMENTS.	_	Х	AISC 360, SECTION A3.3 AND APPLICABLE ASTM MATERIAL STANDARDS
	b. MANUFACTURER'S CERTIFICATE OF COMPLIANCE REQUIRED.	_	Х	_
2.	INSPECTION OF HIGH-STRENGTH BOLTING:			
	a. SNUG—TIGHT JOINTS.	_	Х	
	b. PRETENSIONED AND SLIP-CRITICAL JOINTS USING TURN-OF-NUT WITH MATCHMARKING, TWIST-OFF BOLT OR DIRECT TENSION INDICATOR METHODS OF INSTALLATION.	_	Х	AISC 360, SECTION M2.5
	c. PRETENSIONED AND SLIP-CRITICAL JOINTS USING TURN-OF-NUT WITHOUT MATCHMARKING OR CALIBRATED WRENCH METHODS OF INSTALLATION.	Х	_	
).	MATERIAL VERIFICATION OF STRUCTURAL STEEL AND COLD-FORMED	STEEL DECK:		
	a. FOR STRUCTURAL STEEL, IDENTIFICATION MARKINGS TO CONFORM TO AISC 360.	-	Х	AISC 360, SECTION A3.1
	b. FOR OTHER STEEL, IDENTIFICATION MARKINGS TO CONFORM TO ASTM STANDARDS SPECIFIED IN THE APPROVED CONSTRUCTION DOCUMENTS.	_	Х	APPLICABLE ASTM MATERIAL STANDARDS
	c. MANUFACTURER'S CERTIFIED TEST REPORTS.	-	Х	_
4.	MATERIAL VERIFICATION OF WELD FILLER MATERIALS:			
	a. IDENTIFICATION MARKINGS TO CONFORM TO AWS SPECIFICATION IN THE APPROVED CONSTRUCTION DOCUMENTS.	_	Х	AISC 360, SECTION A3.5 AND APPLICABLE AWS A5 DOCUMENTS
	b. MANUFACTURER'S CERTIFICATE OF COMPLIANCE REQUIRED.	_	Х	_
5.	INSPECTION OF WELDING:	I		
	a. STRUCTURAL STEEL AND COLD-FORMED STEEL DECK:			
	1) COMPLETE AND PARTIAL JOINT PENETRATION GROOVE WELDS.	Х	_	
	2) MULTIPASS FILLET WELDS.	Х	_	-
	3) SINGLE-PASS FILLET WELDS > $\frac{5}{16}$ "	Х	_	AWS D1.1
	4) PLUG AND SLOT WELDS.	Х		-
	5) SINGLE-PASS FILLET WELDS $\leq \frac{5}{16}$ "	-	Х	
	6) FLOOR AND ROOF DECK WELDS.	_	Х	AWS D1.3
	b. REINFORCING STEEL:			
	1) VERIFICATION OF WELDABILITY OF REINFORCING STEEL OTHER THAN ASTM A 706.	-	Х	_
	2) REINFORCING STEEL RESISTING FLEXURAL AND AXIAL FORCES IN INTERMEDIATE AND SPECIAL MOMENT FRAMES, AND BOUNDARY ELEMENTS OF SPECIAL STRUCTURAL WALLS OF CONCRETE AND SHEAR REINFORCEMENT.	X	_	AWS D1.4 ACI 318: SECTION 3.5.2
	3) SHEAR REINFORCEMENT.	X		
	4) OTHER REINFORCING STEEL.	-	Х	
).	INSPECTION OF STEEL FRAME JOINT DETAILS FOR COMPLIANCE:	I		
	a. DETAILS SUCH AS BRACING AND STIFFENING.	_	Х	_
	b. MEMBER LOCATIONS.	-	Х	-
	c. APPLICATION OF JOINT DETAILS AT EACH CONNECTION.	_	Х	_

REFERENCE STANDARDS FOR CONCRETE REPAIR

	ACI RAP-1	STRUCTURAL CRACK REPAIR BY EPOXY INJECTION.
	ACI RAP-2	CRACK REPAIR BY GRAVITY FEED WITH RESIN
	ACI RAP-3	SPALL REPAIR BY LOW-PRESSURE SPRAYING
CONCRETE REPAIR	ACI RAP-4	SURFACE REPAIR USING FORM-AND-POUR TECHNIQUES
	ACI RAP-5	SURFACE REPAIR USING FORM-AND-PUMP TECHNIQUES
	ACI RAP-6	VERTICAL AND OVERHEAD SPALL REPAIR BY HAND APPLICATION
	ACI RAP-7	SPALL REPAIR OF HORIZONTAL CONCRETE SURFACES

- ACI 530 AND CBC.

- JOINT.
- 8 INCHES ON CENTER.
- UNIT.

242 LB 242 LB 864 LB 864 LB 514 LB 514 LB 1252 LB 1252 LB 1004 LB 1066 LB 1448 LB 1448 LB
864 LB 4 FT-LB "864 LB 514 LB 514 LB 15 FT-LB 1252 LB 15 FT-LB 1004 LB 20 FT-LB 1448 LB 20 FT-LB
864 LB "864 LB 514 LB 546 LB 1252 LB 1252 LB 1004 LB 1066 LB 1448 LB
514 LB "546 LB 1252 LB 1252 LB 1004 LB 1066 LB 1448 LB
" 546 LB 15 FT-LB 1252 LB 15 FT-LB " 1252 LB 1004 LB 20 FT-LB 1448 LB 20 FT-LB
1252 LB 15 FT-LB " 1252 LB 1004 LB " 1066 LB 1448 LB 20 FT-LB
1252 LB " 1252 LB 1004 LB " 1066 LB 1448 LB 20 FT-LB
1004 LB "1066 LB 1448 LB 20 FT-LB
<u> </u>
1448 LB 20 FT-LB
1448 LB
" 1//8 I B
1302 LB
<u>1384 LB</u> 65 FT-LB
1998 LB 65 FT-LB
" 2070 LB
1658 LB
<u> </u>
2632 LB 120 FT-LB
" 2632 LB

POST-INSTALLED ANCHORAGE INTO MASONRY

1. POST-INSTALLED MECHANICAL ANCHORS INTO MASONRY SHALL BE SIMPSON WEDGE-ALL (ICC-ESR-1396), HILTI KWIK-BOLT 3 (ICC ESR-1385), OR EQUAL. INSTALL ANCHORS IN CONFORMANCE WITH THE ICC REPORT AND MANUFACTURER'S SPECIFICATIONS. COMPLY WITH

2. ALL HOLES SHALL BE DRILLED PER MANUFACTURER'S RECOMMENDATIONS. CORE DRILLED HOLES ARE NOT PERMITTED.

7. CONTRACTOR SHALL DETERMINE LOCATION OF EXISTING REINFORCING STEEL PRIOR TO DRILLING FOR ANCHORS, AND DRILL THE ANCHOR HOLES TO CLEAR THE REINFORCING STEEL PER THESE NOTES. NO REINFORCING STEEL SHALL BE NICKED, CUT OR DAMAGED IN ANY WAY. DAMAGED REINFORCING WILL BE REPLACED BY THE CONTRACTOR AT NO ADDITIONAL COST. IF THE LOCATION OF ANCHORS MUST BE MOVED SLIGHTLY TO ACCOMMODATE THE LOCATION OF EXISTING REINFORCING STEEL, THE CONTRACTOR SHALL PREPARED A SLIGHTLY MODIFIED DESIGN OF THE ITEM TO BE ANCHORED AND SUBMIT TO THE ENGINEER FOR APPROVAL PRIOR TO FABRICATION. THE MODIFIED DESIGN SUGGESTED BY THE CONTRACTOR SHALL INVOLVE THE ABSOLUTE MINIMUM RELOCATION OF ANCHORS TO MEET THE DETAILS AND REQUIREMENTS HEREIN, AND SHALL BE BASED ON A TEMPLATE BY THE CONTRACTOR WHICH ACCURATELY PORTRAYS THE POSITION OF THE ANCHORS.

8. MAINTAIN A MINIMUM CLEARANCE OF 1-INCH BETWEEN THE REINFORCEMENT AND THE POST-INSTALLED ANCHOR.

9. ANCHORS SHALL BE INSTALLED A MINIMUM OF 1-3/8 INCH FROM ANY VERTICAL MORTAR

10. ANCHOR LOCATIONS ARE LIMITED TO ONE PER MASONRY CELL, WITH A MINIMUM SPACING OF

11. EMBEDMENT SHALL BE MEASURED FROM THE OUTSIDE FACE OF THE CONCRETE MASONRY

12. STAINLESS STEEL ANCHORS SHALL BE PROVIDED FOR EXTERIOR EXPOSURES. 13. CONTINUOUS SPECIAL INSPECTION IS REQUIRED.

TEST LOADS, EXPANSION BOLTS INTO MASONRY

14. PER 1704A.4 TEST POST-INSTALLAED ANCHORS IN MASONRY USING THE REQUIREMENTS FOR TEST LOADS, FREQUENCY, ACCEPTANCE CRITERIA AND PROCEDURE SET FORTH IN CBC 1913A.7. TEST LOADS SHALL BE IN ACCORDANCE WITH 1913A.7.2, METHOD 2 FOR ANCHORS 11. PROVIDE BEVELED WASHERS ON SLOPING SURFACE OF CONNECTIONS FOR FULL BEARING. OTHER THAN MECHANICAL ANCHORS WHICH ARE COVERED IN THE ABOVE TABLE.

15. POST-INSTALLED ADHESIVE ANCHORS SHALL USE HILTI HIT HY 70 PER ICC ESR-2682 FOR ROD DIAMETERS LESS THAN $\frac{3}{4}$ ".

DESIGN CRITERIA

DESIGN CONFORMS TO CBC.

1.	LIVE	LOADS:	
	Α.	ROOF:	21.5 PSF

2. DEAD LOADS:

A. SELF WEIGHT B. PARTITIONS: 20 PSF

SEISMIC ANALYSIS: EQUIVALENT LATERAL FORCE PROCEDURE

SITE CLASS D SEISMIC DESIGN CATEGORY D

	1.556 g 0.579 g 1.0
Fv =	1.5
Sds =	1.037 g
Sd1 =	0.579 g

STRUCTURAL STEEL

- 1. THE CONTRACTOR SHALL SUBMIT ALL STRUCTURAL STEEL AND MISCELLANEOUS STEEL SHOP DRAWINGS TO THE ENGINEER FOR REVIEW PRIOR TO FABRICATION.
- MATERIAL TEST OR REPORTS FOR HOT-ROLLED STRUCTURAL SHAPES, PLATES, AND BARS SHALL BE MADE IN ACCORDANCE WITH ASTM A6. FOR SHEET MATERIAL, TEST SHALL BE MADE IN ACCORDANCE WITH ASTM A568. FOR TUBING AND PIPE, SUCH TEST SHALL BE MADE IN ACCORDANCE WITH REQUIREMENTS OF THE APPLICABLE ASTM STANDARDS.
- 3. HOT ROLLED SHAPES WITH FLANGES 11/3" THICK AND THICKER AND BASE PLATE 11/3" THICK AND THICKER SHALL HAVE A MINIMUM CHARPY V-NOTCH TOUGHNESS OF 20 FL-LB AT 70° F.
- 4. STEEL MATERIALS SHALL CONFORM TO THE FOLLOWING, UNLESS OTHERWISE NOTED: A. ANGLES, PLATES AND BARS: ASTM A36 (Fy=36ksi, Fu=58ksi)
- B. W AND WT: ASTM A992 (Fy=50ksi, Fu=65ksi) C. RECTANGULAR AND SQUARE HSS: ASTM A1085 (Fy=50ksi, Fu=65ksi) D. ROUND HSS: ASTM A1085 (Fy=50ksi, Fu=65ksi)
- E. PIPES: ASTM A53, GRADE B (Fy=35ksi, Fu=60ksi)
- F. BOLTS AT STEEL-TO-STEEL CONNECTIONS: ASTM A325 ST (SNUG-TIGHTENED), TYPE 1; 🔏 "Ø TYP. U.O.N.
- BOLTS AT OTHER APPLICATIONS: ASTM A307
- H. ANCHOR RODS: ASTM F1554, GRADE 36, U.N.O. THREADED RODS: ASTM A36
- NUTS: ASTM A563
- WASHERS: ASTM F436
- TWIST-OFF-TYPE TENSION-CONTROL BOLT ASSEMBLIES: ASTM F1852 COMPRESSIBLE-WASHER-TYPE DIRECT-TENSION INDICATORS: ASTM F959
- N. STEEL STUD SHEAR CONNECTORS: ASTM A29/A108, AWS D1.1
- 5. ALL WELDING OF STEEL SHALL CONFORM TO AWS D1.1 AND SHALL BE PERFORMED BY AWS CERTIFIED WELDERS USING E-70XX LOW HYDROGEN MOISTURE RESISTING ELECTRODES UNLESS OTHERWISE NOTED.
- 6. USE THE MINIMUM SIZE OF WELDS IN ACCORDANCE WITH AISC MANUAL OF STEEL CONSTRUCTION AT STEEL TO STEEL JOINTS UNLESS A LARGER WELDING SIZE IS SPECIFIED ON THE PLANS.
- 7. ALL STEEL (EXCEPT STAINLESS STEEL) SHALL BE SHOP PRIMED WITH ZINC OXIDE PRIMER UNLESS OTHERWISE NOTED.
- 8. PAINT ALL STRUCTURAL STEEL WITH WEATHER/RUST RESISTANT PAINT IN ACCORDANCE WITH THE PROJECT SPECIFICATIONS AND ARCHITECTURAL DETAILS UNLESS OTHERWISE NOTED.
- 9. DIAMETER OF BOLT HOLE SHALL BE $\frac{1}{16}$ " LARGER THAN THE BOLT'S DIAMETER UNLESS OTHERWISE NOTED.
- 10. IF DRILLING HOLES AT STEEL MEMBERS TO ACCOMMODATE THE CONCRETE OR MASONRY ANCHORS IS REQUIRED, THE DRILLING MUST BE DONE AFTER THE ANCHORS HAVE BEEN INSTALLED. THE HOLES AT STEEL MEMBERS SHALL MATCH THE LOCATION OF INSTALLED ANCHORS.
- 12. WHERE LENGTH OF WELDING IS NOT SHOWN, IT SHALL BE FULL LENGTH OF JOINT. ALL BUTT WELDS SHALL BE COMPLETE PENETRATION WELDS UNLESS OTHERWISE NOTED.
- 13. WHERE SO INDICATED ON THE DRAWINGS, STEEL EXPOSED TO VIEW IS DEFINED AS "ARCHITECTURALLY" EXPOSED STRUCTURAL STEEL" (AESS). SEE SPECIFICATIONS.
- 14. MINIMUM BOLT SPACING FROM CENTER OF STANDARD AISC HOLE AS FOLLOWS, U.N.O.: CENTER-TO-CENTER = 3 BOLT DIAMETER CENTER-TO-ROLLED EDGE = 1.5 BOLT DIAMETER CENTER-TO-SHEARED EDGE = 1.75 BOLT DIAMETER
- 15. THE NATURAL CAMBER IN BEAMS SHALL BE ORIENTED UP, UNLESS NOTED OTHERWISE. AT CANTILEVERS, THE NATURAL CAMBER SHALL BE ORIENTED SO THAT THE FREE END IS ABOVE THE CONNECTED END. THE TOP OF ALL MEMBERS SHALL BE CLEARLY IDENTIFIED. ALL BEAM CAMBERS SHOWN ON THE PLANS SHALL INCLUDE NATURAL CAMBER.
- 16. PROVIDE UPWARD CAMBER TO MEMBERS INDICATED TO HAVE CAMBER. AMOUNT MEASURED IN THE FIELD PRIOR TO ERECTION SHALL NOT DEVIATE BY MORE THAN ALLOWED BY THE AISC SPECIFICATION. DO NOT CAMBER MEMBERS OCCURRING BELOW ELEVATOR ENTRANCE DOORS.
- 17. GALVANIZE ALL STEEL EXPOSED TO WEATHER, UNLESS OTHERWISE NOTED.
- 18. UNDER NO CIRCUMSTANCES SHALL DRAWINGS BE SCALED OR REFERENCE ELECTRONIC BUILDING INFORMATION BE USED TO DETERMINE ELEVATIONS OR DIMENSIONS.
- 19. THE CONTRACTOR SHALL ESTABLISH A MASTER SET OF TOP-OF-STEEL DRAWINGS FOR ALL AREAS OF THE BUILDING OR STRUCTURE FOR APPROVAL BY THE ARCHITECT BEFORE BEGINNING FABRICATION OF STRUCTURAL STEEL. THE CONTRACTOR'S MASTER SET OF TOP-OF-STEEL DRAWINGS SHALL BE SUBMITTED AT THE BEGINNING OF THE SHOP DRAWING SUBMITTAL PROCESS. THIS SET OF DRAWINGS SHALL SHOW ALL TOP-OF-STEEL ELEVATIONS, ALL EDGE OF STEEL INFORMATION FOR FLOOR AND ROOF LEVELS, AND ALL STEEL FRAMING DIMENSIONS AT FLOOR AND WALL OPENINGS.

TOLERANCE


1. PERMITTED TOLERANCE SHALL BE ACCORDING TO THE CBC.

GENERAL

- SCOPE OF WORK: THIS PROJECT INVOLVES SEISMIC RETROFIT OF A 18,000 SF CMU WITH WOOD ROOF BUILDING. WORK INCLUDES OUT-OF-PLANE WALL ANCHORS, CONTINUOUS CROSS-TIES AND A NEW CHORD CONNECTIONS.
- 2. REFER TO PROJECT SPECIFICATIONS FOR PROJECT REQUIREMENTS.
- 3. ALL CONSTRUCTION AND WORKMANSHIP, INCLUDING MATERIALS, SHALL CONFORM TO THESE DRAWINGS AND THE CBC.
- 4. GOVERNING CODE AUTHORITY: FOUNTAIN VALLEY BUILDING AND SAFETY DIVISION.
- 5. COMPLY FULLY WITH ALL CODES HAVING JURISDICTION OVER THE WORK. IF ANY WORK SHOWN OR INDICATED ON THE DRAWINGS IS IN CONFLICT WITH ANY CODE HAVING JURISDICTION, BRING IT TO THE ATTENTION OF THE OWNER PRIOR TO THE COMMENCEMENT OF ANY WORK WHICH WOULD BE AFFECTED BY IT.
- 6. WHERE NOT INDICATED OTHERWISE, THE LATEST EDITION OF ALL CITED DOCUMENTS SHALL GOVERN.
- 7. THE TERM CBC IN THESE DRAWINGS MEANS 2016 CALIFORNIA BUILDING CODE, CALIFORNIA CODE OF REGULATIONS, TITLE 24, ALL PARTS AND VOLUMES.
- 8. ALL INFORMATION, DIMENSIONS, AND ELEVATIONS SHOWN OR NOTED TO EXISTING STRUCTURE ARE BASED ON BEST INFORMATION CURRENTLY AVAILABLE AT THE TIME OF THE PREPARATION OF THESE DRAWINGS. NO WARRANTY IS IMPLIED AS TO THE ACCURACY OF EXISTING CONDITIONS. THE CONTRACTOR SHALL REFER TO THE ORIGINAL CONSTRUCTION DOCUMENTS FOR INFORMATION REGARDING EXISTING CONSTRUCTION AND SHALL FIELD VERIFY ALL CONDITIONS. IF CONDITIONS BECOME APPARENT WHICH DIFFER FROM THE CONDITIONS SHOWN HEREIN, THEY SHALL BE BROUGHT TO THE IMMEDIATE ATTENTION OF THE OWNER. HOWEVER, ANY SIGNIFICANT CONFLICTS SHALL BE RESOLVED AS NOTED.
- 9. THE CONTRACTOR SHALL:

BEFORE PROCEEDING WITH THE WORK.

- A. BECOME FAMILIAR WITH ALL CONTRACT DOCUMENTS. B. CHECK ALL DIMENSIONS.
- C. BE RESPONSIBLE FOR COORDINATION OF ALL TRADES TO ASSURE PROPER CONSTRUCTION OF THE PROJECT. ALL DISCREPANCIES SHALL BE CALLED TO THE ATTENTION OF THE ENGINEER AND SHALL BE RESOLVED
- 10. DIMENSIONS: DIMENSIONS TAKE PRECEDENCE OVER SCALE OF DRAWING. RELY ON WRITTEN DIMENSIONS GIVEN AND FIELD VERIFICATION. IF DISCREPANCIES ARE FOUND, NOTIFY THE OWNER BEFORE THE COMMENCEMENT OR RESUMPTION OF WORK. IF NO DIMENSION ARE GIVEN, NOTIFY THE OWNER FOR CLARIFICATIONS. ALL NOTIFICATIONS SHALL BE BY "RFI".
- 11. DRAWINGS INDICATE GENERAL AND TYPICAL DETAILS OF CONSTRUCTION. NOTES AND DETAILS ON DRAWINGS TAKE PRECEDENCE OVER "GENERAL NOTES" AND TYPICAL DETAILS. WHERE CONDITIONS ARE NOT SPECIFICALLY INDICATED BUT ARE OF SIMILAR CHARACTER TO DETAILS SHOWN, SIMILAR DETAILS OF CONSTRUCTION SHALL BE USED SUBJECT TO PRIOR REVIEW BY THE ENGINEER.
- 12. CONDITIONS NOTED AS "EXISTING" OR (E) ARE TO REMAIN U.N.O. PROTECT AS REQUIRED. "EXISTING" CONSTRUCTION REMOVED BY THE CONTRACTOR FOR ANY REASON SHALL BE REPLACED TO MATCH EXISTING AT NO ADDITIONAL COST TO THE OWNER. ALL MATERIALS, FEATURES OR CONDITIONS NOT SPECIFICALLY IDENTIFIED AS "EXISTING" OR (E) ARE CONSIDERED NEW WORK AND ARE PART OF THE PROJECT SCOPE OF WORK.
- 13. ALL EXISTING CONDITIONS, WHETHER OR NOT SPECIFICALLY NOTED ON THE DRAWINGS, SHALL BE VERIFIED PRIOR TO THE COMMENCEMENT OF ANY WORK. DO NOT PROCEED WITH ANY ITEM OR WORK THAT IS REASONABLY QUESTIONABLE WITHOUT ADVISING THE OWNER. OBTAIN DIRECTION FROM THE OWNER AS TO HOW TO PROCEED. SUBMIT ALL QUESTIONS ON "RFI" FORM.
- 14. ANY DISCREPANCIES FOUND IN THE CONTRACT DOCUMENTS SHALL BE BROUGHT TO THE ATTENTION OF THE ENGINEER FOR RESOLUTION PRIOR TO COMMENCING ANY WORK.
- 15. SHOP DRAWINGS REQUIRED BY THE PROJECT SPECIFICATIONS SHALL BE SUBMITTED TO THE ENGINEER FOR REVIEW PRIOR TO FABRICATION. DRAWINGS ARE REVIEWED BY THE ENGINEER FOR GENERAL CONFORMANCE TO THE DESIGN. REGARDLESS OF THE ENGINEER'S REVIEW, THE CONTRACTOR IS FULLY AND SOLELY RESPONSIBLE FOR COMPLETE AND SATISFACTORY SUBMITTAL AND CONFORMANCE TO THE CONTRACT DOCUMENTS. SHOP DRAWINGS WILL BE REJECTED FOR INCOMPLETENESS, LACK OF CALCULATIONS (IF REQUIRED) OR CHANGES WITHOUT PRE-APPROVAL. ALL STRUCTURAL CALCULATIONS AND DRAWINGS AS PART OF THE SHOP DRAWINGS SUBMITTAL SHALL BE SIGNED AND STAMPED BY A CALIFORNIA REGISTERED STRUCTURAL ENGINEER. FOR RESUBMITTALS, ALL CHANGES FROM THE PRIOR SUBMITTAL SHALL BE TIGHTLY ENCLOSED BY A "CLOUD" SO AS TO INDICATE ONLY THOSE AREAS CHANGED. WHEN THE CLOUDED DRAWINGS ARE RESUBMITTED, ONLY THE CLOUDED AREAS WILL BE REVIEWED.
- 16. THE CONTRACTOR SHALL SUPERVISE AND DIRECT THE WORK, AND SHALL BE SOLELY RESPONSIBLE FOR ALL CONSTRUCTION MEANS, METHODS, TECHNIQUES, SEQUENCES AND PROCEDURES. THE SUPPORTING SERVICES BY THE ENGINEER, WHETHER PERFORMED PRIOR TO, DURING, OR AFTER CONSTRUCTION, ARE PERFORMED SOLELY FOR THE PURPOSE OF ASSISTING IN QUALITY CONTROL AND IN ACHIEVING CONFORMANCE WITH CONTRACT DRAWINGS AND PROJECT SPECIFICATIONS; BUT THEY DO NOT GUARANTEE THE CONTRACTOR'S PERFORMANCE AND SHALL NOT BE CONSIDERED AS SUPERVISION OF CONSTRUCTION.
- 17. THE CONTRACTOR IS FULLY AND SOLELY RESPONSIBLE FOR ALL SHORING REQUIRED IN ORDER TO SAFELY ACHIEVE THE FINAL CONSTRUCTION SHOWN ON THE DRAWINGS. THIS INCLUDES, BUT IS NOT LIMITED TO, ANY TYPES OF SHORING REQUIRED FOR SOILS EXCAVATION AND BACKFILL WORK; SUPPORT OF STRUCTURAL ELEMENTS UNTIL THEY HAVE ACHIEVED THE NECESSARY STRENGTH TO PERFORM IN THE FINAL POSITION AND MANNER SHOWN ON THE DRAWINGS; AND SUPPORT OF STRUCTURAL ELEMENTS THAT ARE MODIFIED AND THEREBY REDUCED IN STRENGTH IN ANY WAY DURING CONSTRUCTION AS REQUIRED TO ACHIEVE THE FINAL CONSTRUCTION AS SHOWN ON THE DRAWINGS. ALL SHORING CALCULATIONS AND DRAWINGS SHALL BE STAMPED BY A CALIFORNIA REGISTERED ENGINEER AND SUBMITTED FOR REVIEW PRIOR TO PERFORMING THE WORK.
- 18. THE CONTRACTOR SHALL COORDINATE ALL UTILITY LOCATIONS WITH OTHER DRAWINGS AND SHALL CONDUCT A DETAILED SURVEY OF EXISTING UTILITIES TO IDENTIFY INTERFERENCES WITH THE NEW CONSTRUCTION. PROMPTLY NOTIFY THE ENGINEER OF ANY INTERFERENCES PRIOR TO PERFORMING THE WORK.
- 19. IN THE EVENT THAT THERE ARE ANY UTILITIES AFFECTED, ANY MODIFICATIONS SHALL BE THE RESPONSIBILITY OF THE CONTRACTOR AND NOT THAT OF THE OWNER. ALL OUTLETS EITHER ELECTRICAL OR MECHANICAL, OR ANY ASSOCIATED REWORK OR MODIFICATIONS WILL BE A PART OF THE BID AND NOT TO BE CONSTRUED AS THE WORK OF THE OWNER. SUFFICIENT DUE DILIGENCE ON THE PART OF THE CONTRACTOR WILL ELIMINATE ANY POTENTIAL ISSUES AND ACCEPTANCE OF THE AGREEMENT SHALL BIND CONTRACTOR TO SAID ACCEPTANCE.
- 20. LOCATE ALL EMBEDDED ITEMS, REINFORCING STEEL AND TENDONS USING NON-DESTRUCTIVE MEANS PRIOR TO DRILLING OR CORING. DO NOT DAMAGE EMBEDDED ITEMS WITHOUT APPROVAL BY THE STRUCTURAL ENGINEER.
- 21. THE CONTRACTOR SHALL BE RESPONSIBLE FOR THE SAFETY OF WORK AREA DURING CONSTRUCTION PERIOD. THE CONTRACTOR SHALL PROTECT ADJACENT PROPERTY AND UTILITIES IN ACCORDANCE WITH ALL NATIONAL. STATE, AND LOCAL SAFETY ORDINANCES.
- 22. PROVIDE BARRICADING AND MAINTAIN ANY REQUIRED LIGHTS, WARNING, AND DIRECTIONAL SIGNS, AND OTHER PROTECTION NEAR AND ABOUT THE AREA OF THE WORK AS MAY BE REQUIRED BY THE OWNER, OR BY ANY OTHER GOVERNING AUTHORITY. PROVIDE NECESSARY MEANS TO PROTECT ANY SURROUNDING ADJACENT SITE STRUCTURES, PROPERTIES, SERVICING UTILITIES, PEDESTRIAN AND VEHICLE WAYS, AND MAINTAIN ALL SAFETY MEASURES UNTIL WORK IS COMPLETED.
- 23. SECURE THE CONSTRUCTION SITE. ANY PARTS OF WORK AREA WHICH ARE TO BE BARRICADED OR SEALED TO NON-CONSTRUCTION INDIVIDUALS MUST BE COORDINATED WITH AND APPROVED BY THE OWNER BEFORE PROCEEDING WITH THE WORK.
- 24. PROVIDE ALL MEASURES NECESSARY TO PROTECT THE STRUCTURE AND ADJACENT STRUCTURE(S), FINISHES AND UTILITIES DURING CONSTRUCTION.
- 25. PROVIDE AND ENGINEER ALL TEMPORARY STRUCTURAL AND SAFETY ELEMENTS REQUIRED TO ACCOMPLISH THE WORK.
- 26. THE CONTRACTOR SHALL EXERT EVERY EFFORT TO PREVENT DUST AND CONSTRUCTION DEBRIS FROM CONTAMINATING THE WORK AREA. THESE EFFORTS SHALL INCLUDE BUT NOT BE LIMITED TO PROVIDING A DAILY CLEANUP OF THE CONSTRUCTION AREA. THE CONTRACTOR SHALL REFER TO THE PROJECT SPECIFICATIONS FOR ADDITIONAL REQUIREMENTS.
- 27. CUTTING, BORING, SAW-CUTTING OR DRILLING THROUGH NEW STRUCTURAL MEMBERS OTHER THAN THOSE DETAILED ON STRUCTURAL DRAWINGS SHALL NOT BE DONE WITHOUT THE ENGINEER'S APPROVAL.
- 28. PERFORM ALL PATCHING AND RESTORATION AS REQUIRED BY THE WORK. THE WORK SHALL MATCH ADJACENT SURFACES UNLESS SPECIFICALLY NOTED OTHERWISE TO THE SATISFACTION OF THE OWNER.

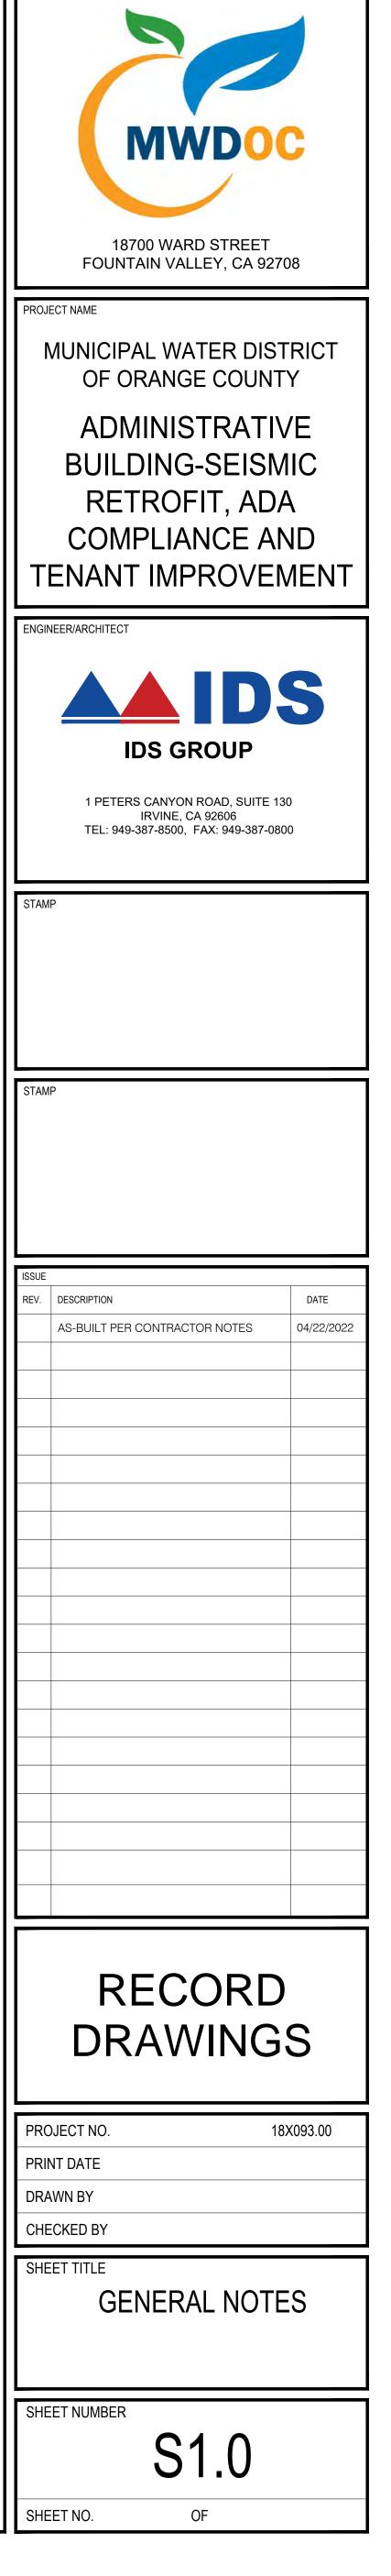

ABBREVIATIONS

ABBREVIA	TIONS		<u>SH</u>
@ &	AT AND	К К.Р.	KIPS; 1000 KING POST 1. S
A.B. ABV.	ANCHOR BOLT ABOVE	LAT.	Γ
ADD'L. (ADDL.) ADJ.		L.B. LB (#)	LATERAL (LAG BOLT] POUND]
ALT. ALUM.	ALTERNATE ALUMINUM	L.F. LLH	LINEAL FEET (FOOT) F LONG LEG HORIZONTAL
APPRX. (APPROX.) ARCH.		LLV LT. WT.	LONG LEG VERTICAL 2. S LIGHT WEIGHT
	· · · · · · · · · · · · · · · · · · ·		F
BLDG. BLKG.	BUILDING BLOCKING	MAX. M.B.	MAXIMUM F MACHINE BOLT F
BLW. BM.	BELOW BEAM	MECH. M.E.P.	MECHANICAL E MECHANICAL, ELECTRICAL E
B.N. BNDRY.	BOUNDARY NAILING BOUNDARY	MEZZ.	AND PLUMBING MEZZANINE
B.O.C. B.O.F. BOT. (B)	BOTTOM OF CONCRETE BOTTOM OF FOOTING	MFR. MIN. MISC.	MANUFACTURER MINIMUM MISCELLANEOUS
BRCG. BRDG.	BOTTOM BRACING BRIDGE (ING)	MTL.	METAL
BRG. BTWN.	BEARING BETWEEN	(N)	NEW
		NO. (#) N.S.	NUMBER NEAR SIDE
CAMB. (C) CBC	CAMBER(ED) CALIFORNIA BUILDING CODE	N.T.S.	NOT TO SCALE
CANT. C.F.	CANTILEVER(ED) CUBIC FEET (FOOT)	0/C (0.C.)	ON CENTER
C.I.P. C.I.D.H.	CAST–IN–PLÀCE CAST–IN–DRILLED HOLE	0.D. 0.H.	OUTSIDE DIAMETER OPPOSITE HAND
C.J.	CONTROL JOINT; CONSTRUCTION JOINT	OPNG. OPP.	OPENING OPPOSITE
C.L. (€) CLG.	CENTER LINE CEILING	ORTHO. O.W.J.	ORTHOGONAL OPEN WEB JOIST
CLR. COL.	CLEAR COLUMN CONCRETE	PC PCF	PILE CAP POUNDS PER CU.FT.
CONC. CONN. CONST.	CONCRETE CONNECTION CONSTRUCTION	PL. PLYWD.	PLATE PLYWOOD
CONT. C.P.	CONTINUOUS COMPLETE-PENETRATION	P.P. P.S.F.	PARTIAL—PENETRATION POUNDS PER SQUARE
CTSK. CTR.	COUNTERSINK CENTER(ED)	P.S.I.	FOOT POUNDS PER SQUARE
C.Y.	CUBIC YARD	PT	INCH PRETENSIONED
d	d PENNY NAIL	P.T.	PRESSURE TREATED
DBA DBL.	DEFORMED BAR ANCHOR DOUBLE	QTY.	QUANTITY
DEPT. D.F.	DEPARTMENT DOUGLAS FIR	RAD. (R)	RADIUS
DIA. (Ø) DIAG. DIADH	DIAMETER DIAGONAL DIADHRAGM	RBS REF.	REDUCED BEAM SECTION REFERENCE
DIAPH. DIM. DN.	DIAPHRAGM DIMENSION DOWN	REINF. REQ'D. (REQD.)	REINFORCEMENT (ING) REQUIRED
DO DWG. (DWGS.)	DITTO (REPEAT) DRAWING(S)	RF. R.O.	ROOF ROUGH OPENING
DWC. (DWCS.) DWL.	DOWEL		
EA.	EACH	S.A.D. SC	SEE ARCHITECTURAL DRAWINGS
E.F. E.J.	EACH FACE EXPANSION JOINT	SC S.C.D. SCH.	SLIP-CRITICAL SEE CIVIL DRAWINGS SCHEDULE
EL. ELEC.	ELEVATION ELECTRICAL	SEP. SHT.	SEPARATION SHEET
ELEV. EMB.	ELEVATOR EMBED(MENT) EDGE NAIL	SIM. SKW.	SIMILAR SKEW(ED)
E.N. ENG. EQ.	EDGE NAIL ENGINEER EQUAL	S.O.G. SPEC.	SLAB-ON-GRADE SPECIFICATION
EQPT. EQUIV.	EQUIPMENT EQUIVALENT	SQ. ST	SQUARE SNUG–TIGHTENED
EXP. EXIST. (E)	EXPANSION EXISTING	STD. STAGG.	STANDARD STAGGER(ED)
EXT.	EXTERIOR	STIFF. STIR.	STIFFENER STIRRUP
FDN.	FOUNDATION	STL. STRUC(T). SUSP.	STEEL STRUCTURAL SUSPENDED
FIN. FLR.	FINISH(ED) FLOOR	SUSP. SYMM.	SYMMETRICAL
F.N. F.O.C. F.O.M.	FIELD NAIL; FACE NAIL FACE OF CONCRETE FACE OF MASONRY	T&B	TOP AND BOTTOM
F.O.S. F.O.W.	FACE OF STUD FACE OF WALL	T&G TEMP.	TONGUE AND GROOVE TEMPORARY
F.P. FRP	FULL (COMPLETE) PENETRA FIBER REINFORCED POLYME	ATIONK. ERT.N.	THICK(NESS) TOE NAIL
F.S. FT. (')	FOOT (FEET)	T.O.C.	TOP OF TOP OF CONCRETE TOP OF STEEL:
FTG. F.V.	FOOTING FIELD VERIFY	T.O.S. T.O.W.	TOP OF STEEL; TOP OF SHEATHING TOP OF WALL
GA.	GAUGE	TRANS. T.S.G.	TRANSVERSE TAPERED STEEL GIRDER
GALV. GLB.	GALVANIZE(D) GLU-LAM/GLULAM	TYP.	TYPICAL
GRD. GYP.	GLUED LAMINATED BEAM GRADE		UNLESS OTHERWISE NOTED
	GYPSUM	UTIL. VERT. (V)	UTILITY VERTICAL
HD. HDR.	HOLDOWN; HAND HEADER	V.I.F.	VERIFY IN FIELD
HGR. HORIZ. (H)	HANGER HORIZONTAL	W/ (W)	WITH WIDE; WIDTH
H.S. H.S.B. HT.	HEADED STUD HIGH STRENGTH BOLT HEIGHT	ŴĎ. W.P.	WOOD WORK POINT
		WT. W.W.F.	WEIGHT WELDED WIRE FABRIC
I.D. IN. (")	INSIDE DIAMETER INCH(ES)	X-STG	EXTRA STRONG
INFO.	INFORMATION	XX-STG	DOUBLE EXTRA STRONG
JST.	JOIST		
JT.	JOINT		

SHOP DRAWINGS, SUBMITTALS AND REVIEW BY THE ENGINEER NAILING

1. SHOP DRAWINGS ARE NOT CONTRACT DOCUMENTS AND MAY NOT BE USED AS A BASIS FOR CONSTRUCTING THE WORK IN A MANNER DIFFERENT FROM WHAT IS SHOWN IN THE CONTRACT DOCUMENTS. THE PURPOSE OF THE SHOP DRAWING REVIEW BY THE ENGINEER IS TO HELP THE CONTRACTOR UNDERSTAND AND IMPLEMENT THE DESIGN SHOWN ON THE DRAWINGS AND DESCRIBED IN THE SPECIFICATIONS. IF DEVIATIONS, DISCREPANCIES OR CONFLICTS BETWEEN THE SHOP DRAWINGS AND THE CONTRACT DOCUMENTS ARE DISCOVERED EITHER PRIOR TO OR AFTER THE SHOP DRAWINGS ARE REVIEWED BY THE ENGINEER, THE CONTRACT DOCUMENTS SHALL CONTROL AND SHALL BE FOLLOWED.


2. SHOP DRAWINGS ARE REVIEWED BY THE ENGINEER SOLELY TO AID IN ASSESSING THE CONTRACTOR'S GENERAL CONFORMANCE WITH THE DESIGN REQUIREMENTS AND INTENT. THE CONTRACTOR IS SOLELY RESPONSIBLE FOR CONSTRUCTABILITY. COMPATIBILITY WITH THE RELATED COMPONENTS OR ASSEMBLIES. DIMENSIONS, QUANTITIES, WEIGHTS OR GAUGES, AND THE LIKE. THE CONTRACTOR IS NOT RELIEVED FROM COMPLIANCE WITH THE CONTRACT DOCUMENTS, OR FROM ANY CODE OR OTHER LEGAL REQUIREMENTS. THE CONTRACTOR IS SOLELY RESPONSIBLE FOR CONFIRMING AND COORDINATING ALL DIMENSIONS: FOR CONSTRUCTION MEANS & METHODS AND SAFETY PRECAUTIONS: AND FOR ANY ICAL DEVIATIONS FROM THE PLANS AND SPECIFICATIONS NOT CLEARLY IDENTIFIED BY THE ENGINEER.

1.	CONNECTION JOIST TO SILL OR GIRDER	FASTENING ^{a, m} 3 - 8d COMMON (2 ¹ / ₂ " x 0.131")
2.	BRIDGING TO JOIST	2 – 8d COMMON (2½" x 0.131")
3.	1" x 6" SUBFLOOR OR LESS TO EACH JOIST	2 - 8d COMMON (2½" x 0.131")
4.	WIDER THAN 1" x 6" SUBFLOOR TO EACH JOIST	3 - 8d COMMON (2½" x 0.131")
5.	2" SUBFLOOR TO JOIST OR GIRDER	2 – 16d COMMON (3½" x 0.162")
6.	SOLE PLATE TO JOIST OR BLOCKING	16d (3½" x 0.135") AT 16" O.C.
	SOLE PLATE TO JOIST OR BLOCKING AT PANELS BRACED WALL PANEL	3 − 16d (3½" × 0.135") AT 16" O.C.
7.	TOP PLATE TO STUD	$2 - 16d \text{ COMMON} (3\frac{1}{2}" \times 0.162")$
8.	STUD TO SOLE PLATE	4 - 8d COMMON $(2\frac{1}{2}$ " x 0.131") 2 - 16d COMMON $(3\frac{1}{2}$ " x 0.162")
9.	DOUBLE STUDS	16d (3½" x 0.135") AT 24" O.C.
10.	DOUBLE TOP PLATES DOUBLE TOP PLATES	16d (3½" x 0.135") AT 16" O.C. 8 — 16d COMMON (3½" x 0.162")
11.	BLOCKING BETWEEN JOISTS OR RAFTERS TO TOP PLATE	$3 - 8d$ COMMON ($2\frac{1}{2}$ " x 0.131")
12.	RIM JOIST TO TOP PLATE	8d (2 ¹ / ₂ " x 0.131") AT 6" O.C.
13.	TOP PLATES, LAPS AND INTERSECTIONS	2 – 16d COMMON (3½" x 0.162")
14.	CONTINUOUS HEADER, TWO PIECES	16d COMMON $(3\frac{1}{2}^{*} \times 0.162^{*})$
15.	CEILING JOISTS TO PLATE	3 - 8d COMMON (2½" x 0.131")
16.	CONTINUOUS HEADER TO STUD	4 - 8d COMMON (2½" x 0.131")
17.	CEILING JOISTS, LAPS OVER PARTITIONS (NOTE q.)	3 – 16d COMMON (3½" × 0.162") MINIMUM, TABLE 2308.10.4.1
18.	CEILING JOISTS TO PARALLEL RAFTERS (NOTE q.)	3 – 16d COMMON (3½" x 0.162") MINIMUM, TABLE 2308.10.4.1
19.	RAFTER TO PLATE (NOTE 4.)	3 - 8d COMMON (2½" x 0.131")
20.	1" DIAGONAL BRACE TO EACH STUD AND PLATE	$2 - 8d$ COMMON ($2\frac{1}{2}$ " x 0.131")
21.	1" x 8" SHEATHING TO EACH BEARING	3 - 8d COMMON (2½" x 0.131")
22.	WIDER THAN 1" x 8" SHEATHING TO EACH BEARING	3 - 8d COMMON (2 ¹ / ₂ " x 0.131")
23.	BUILT-UP CORNER STUDS	16d COMMON (3 ¹ / ₂ " × 0.162")
24.	BUILT-UP GIRDER AND BEAMS	20d COMMON (4" x 0.192") AT 32" O.C.
		2 – 20d COMMON (4" X 0.192")
25.	2" PLANKS	16d COMMON (3½" x 0.162")
26	. COLLAR TIE TO RAFTER	3 - 10d COMMON (3" x 0.148")
27.	JACK RAFTER TO HIP	$3 - 10d \text{ COMMON} (3" \times 0.148")$ 2 - 16d COMMON ($3\frac{1}{2}" \times 0.162"$)
28.	ROOF RAFTER TO 2-BY RIDGE BEAM	2 - 16d COMMON $(3\frac{1}{2}^{"} \times 0.162")$ 2 - 16d COMMON $(3\frac{1}{2}^{"} \times 0.162")$
29.	JOIST TO BAND JOIST	$3 - 16d \text{ COMMON} (3\frac{1}{2}" \times 0.162")$
	LEDGER STRIP	$3 - 16d \text{ COMMON} (3\frac{1}{2}" \times 0.162")$
31.	WOOD STRUCTURAL PANELS AND PARTICILEBOARD ^b SUBFLOOR, ROOF AND WALL SHEATHING (TO FRAMING)	$\frac{1}{2}$ " AND LESS $6d^{c,1}$ 19_{32} " TO $\frac{3}{4}$ " $8d^{d}$ OR $6d^{e}$ $\frac{7}{8}$ " TO 1" $10d^{d}$ OR $8d^{e}$ $1\frac{1}{8}$ " TO $1\frac{1}{4}$ " $10d^{d}$ OR $8d^{e}$
	SINGLE FLOOR (COMBINATION SUBFLOOR – UNDERLAYMENT TO FRAMING)	³ / ₄ " AND LESS 6d ^e ⁷ / ₈ " TO 1" 8d ^e 1 ¹ / ₈ " TO 1 ¹ / ₄ " 10 ^d OR 8d ^e
32.	PANEL SIDING (TO FRAMING)	1/2" AND LESS 6d ^f 5/8" 8d ^f
33.	FIBERBOARDING SHEATHING ⁹	$\frac{1}{2}$ " 6d COMMON NAIL (2" x 0.113") $\frac{25}{32}$ " 8d COMMON NAIL ($\frac{21}{2}$ " x 0.131")
34.	INTERIOR PANELING	1/4" 4d ^j 3/8" 6d ^k
		I

- a. COMMON OR BOX NAILS ARE PERMITTED TO BE USED EXCEPT WHERE OTHERWISE STATED. b. NAILS SPACED AT 6 INCHES ON CENTER AT EDGES, 12 INCHES AT INTERMEDIATE SUPPORTS EXCEPT 6 INCHES AT SUPPORTS WHERE SPANS ARE 48 INCHES OR MORE. FOR NAILING OF WOOD STRUCTURAL PANEL AND PARTICLE BOARD DIAPHRAGMS AND SHEAR WALLS, REFER TO SECTION 2305. NAILS FOR WALL SHEATHING ARE PERMITTED TO BE COMMON, BOX OR CASING.
- c. COMMON OR DEFORMED SHANK (6d 2" x 0.113"; 8d $2\frac{1}{2}$ " x 0.131"; 10d 3" x 0.148").
- d. COMMON (6d 2" x 0.113"; 8d $2\frac{1}{2}$ " x 0.131"; 10d 3 x 0.148"). e. DEFORMED SHANK (6d - 2" x 0.113"; 8d - $2\frac{1}{2}$ " x 0.131"; 10d - 3" x 0.148").
- f. CORROSION-RESISTANT SIDING (6d $1\frac{7}{8}$ " x 0.106"; 8d $2\frac{3}{8}$ " x 0.128") OR CASING (6d 2" x 0.099"; 8d $2\frac{1}{2}$ " x 0.113")
- q. FASTENERS SPACED 3 INCHES ON CENTER AT EXTERIOR EDGES AND 6 INCHES ON CENTER AT INTERMEDIATE SUPPORTS, WHEN USED AS STRUCTURAL SHEATHING. SPACING SHALL BE 6 INCHES ON CENTER ON THE EDGES AND 12 INCHES ON CENTER AT INTERMEDIATE SUPPORTS FOR NON-STRUCTURAL APPLICATIONS.
- h. CORROSION-RESISTANT ROOFING NAILS WITH $\frac{7}{16}$ -INCH-DIAMETER HEAD AND 1 $\frac{1}{2}$ -INCH LENGTH FOR $\frac{1}{2}$ -INCH SHEATHING AND $1\frac{3}{4}$ -INCH LENGTH FOR $2\frac{5}{32}$ -INCH SHEATHING.
- i. CORROSION-RESISTANT STAPLES WITH NOMINAL $\frac{7}{16}$ -INCH CROWN OR 1-INCH CROWN AND $\frac{11}{4}$ -INCH LENGTH FOR $\frac{1}{2}$ -INCH SHEATHING AND 1%-INCH LENGTH FOR 25 $_{32}$ -INCH SHEATHING. PANEL SUPPORTS AT 16 INCHES (20 INCHES IF STRENGTH AXIS IN THE LONG DIRECTION OF THE PANEL, UNLESS OTHERWISE MARKED).
- j. CASING (1½" x 0.080") OR FINISH (1½" X 0.072") NAILS SPACED 6 INCHES ON PANEL EDGES, 12 INCHES AT INTERMEDIATE SUPPORTS.
- k. PANEL SUPPORTS AT 24 INCHES. CASING OR FINISH NAILS SPACED 6 INCHES ON PANEL EDGES, 12 INCHES AT INTERMEDIATE SUPPORTS.
- I. FOR ROOF SHEATHING APPLICATIONS, 8d NAILS $(2\frac{1}{2}$ " x 0.113") ARE THE MINIMUM REQUIRED FOR WOOD STRUCTURAL PANELS. m. STAPLES SHALL HAVE A MINIMUM CROWN WIDTH OF $\frac{7}{16}$ INCH.
- n. FOR ROOF SHEATHING APPLICATIONS, FASTENERS SPACED 4 INCHES ON CENTER AT EDGES, 8 INCHES AT INTERMEDIATE SUPPORTS. o. FASTENERS SPACED 4 INCHES ON CENTER AT EDGES, 8 INCHES AT INTERMEDIATE SUPPORTS FOR SUB-FLOOR AND WALL SHEATHING AND 3 INCHES ON CENTER AT EDGES, 6 INCHES AT INTERMEDIATE SUPPORTS FOR ROOF SHEATHING.
- p. FASTENERS SPACED 4 INCHES ON CENTER AT EDGES, 8 INCHES AT INTERMEDIATE SUPPORTS. q. CEILING JOIST AND RAFTER CONSTRUCTION SHALL BE IN ACCORDANCE WITH CBC SECTION 2308.10.

WOOD

- LOCATION TOENAIL
- TOENAIL EACH END
- FACE NAIL
- FACE NAIL
- BLIND AND FACE NAIL
- TYPICAL FACE NAIL
- BRACED WALL
- END NAIL
- TOENAIL
- END NAIL
- FACE NAIL
- TYPICAL FACE NAIL LAP SPLICE
- TOENAIL
- TOENAIL
- FACE NAIL
- 16" O.C. ALONG EDGE
- TOENAIL
- TOENAIL
- FACE NAIL
- FACE NAIL
- TOENAIL
- FACE NAIL
- FACE NAIL
- FACE NAIL 24" O.C.
- FACE NAIL AT TOP AND BOTTOM STAGGERED ON OPPOSITE SIDES
- FACE NAIL AT ENDS AND AT EACH SPLICE
- AT EACH BEARING
- FACE NAIL
- TOENAIL
- FACE NAIL
- TOENAIL FACE NAIL
- FACE NAIL
- FACE NAIL AT EACH JOIS

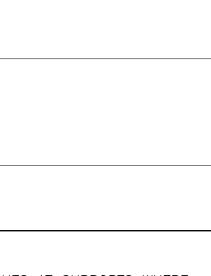

- 1. WOOD MEMBERS SHALL BE DOUGLAS FIR-LARCH PER WCLIB OR WWPA, VISUALLY GRADED DIMENSION LUMBER AND SHALL BE SURFACED DRY (19% MOISTURE CONTENT MAXIMUM). ALL LUMBER SHALL BEAR THE GRADE STAMP OF AN APPROVED TESTING AGENCY, EXCEPT EXPOSED LUMBER AT VISIBLE AREAS. STRUCTURAL FRAMING MEMBERS SHALL BE S4S AND GRADE MARKED AS No.1.
- 2. PLYWOOD SHEATHING SHALL MEET THE REQUIREMENTS OF THE LATEST EDITION OF U.S. PRODUCT STANDARDS PS 1–95. STRUCTURAL USE PANELS SHALL CONFORM TO NER–108 (APA–PRP–108). EACH PANEL SHALL BE IDENTIFIED WITH THE APPROPRIATE A.P.A. GRADE STAMP.
- ROOF SHEATHING SHALL BE FIVE PLY WITH THICKNESS AND PANEL INDEX AS INDICATED ON DRAWINGS. STAGGER SHEETS PER PLAN. ROOF NAILING SHALL BE PER SCHEDULE ON DRAWINGS. OR AS INDICATED ON NOTES. INSTALL SHEETS WITH FACE GRAIN ACROSS SUPPORTS EXCEPT WHERE NOTED OTHERWISE.
- 4. ROOF AND FLOOR SHEATHING, AND SHEAR WALL PANELS NAILING AND INSTALLATION SHALL BE INSPECTED AND APPROVED PRIOR TO COVERING.
- 5. BOLTS SHALL CONFORM TO ASTM A307. ALL BOLTS THROUGH WOOD SHALL HAVE STANDARD WASHERS. BOLT HOLES SHALL BE BORED $\frac{1}{32}$ " to $\frac{1}{16}$ " larger than the BOLT diameter unless noted otherwise. ALL BOLTS SHALL BE TIGHTENED PRIOR TO BEING COVERED. WHERE PLATE WASHERS ARE SHOWN ON THE DRAWINGS THEY SHALL BE AS FOLLOWS:

	1
	L
MINIMUM SIZE FOR SQUARE PLATE WASHERS	L

	·
BOLT SIZE	PLATE SIZE
1⁄2"	$\frac{3}{16}$ " × 2" × 2"
5⁄8 "	1/4" × $21/2$ " × $21/2$ "
³ ⁄4"	$\frac{5}{16}$ " × $2\frac{3}{4}$ " × $2\frac{3}{4}$ "
7⁄8"	⁵ / ₁₆ " × 3" × 3"
1"	³ / ₈ " × ³ / ₂ " × ³ / ₂ "


- 6. NAILS SHALL BE COMMON WIRE NAILS $(0131)^{\circ} \times 2^{1/2}$ FOR 8d; $0148^{\circ} \times 3^{\circ}$ FOR 10d; $0.148^{\circ} \times 3^{1/4}$ FOR 12d; 0.162"\$x31/3" FOR 16d) OR ACCESSORIES OF HARDWARE CONNECTORS. SEE CBC FOR MINIMUM NAILING SCHEDULE AT CONNECTIONS.
- 7. HARDWARE CONNECTORS AND ACCESSORIES SHALL BE SIMPSON STRONG-TIE CONNECTORS OR APPROVED EQUAL.
- 8. NONBEARING PARTITIONS SHALL BE MINIMUM 2x4 STUD AT MAXIMUM 16" ON CENTER WITH TOP AND SILL PLATES AS SHOWN IN THE APPLICABLE DETAILS UNLESS OTHERWISE NOTED.
- 9. PLYWOOD NAILING SHALL HAVE A MINIMUM EDGE DISTANCE OF 3/8". NAIL HEADS SHALL BE FLUSH WITH TOP SURFACE OF PLYWOOD; SINKING NAIL HEADS IS PROHIBITED.
- 10. PROVIDE PLYWOOD EDGE NAILING AROUND THE PLYWOOD OPENINGS AND ALONG THE FULL HEIGHT OF ALL WOOD POSTS AND COLUMNS.
- 11. LAG SCREWS SHALL BE SCREWED, NOT DRIVEN, INTO WOOD MEMBERS WITH PRE-DRILLED HOLES. PRE-DRILLED HOLE DIAMETER IN SOFT STRUCTURAL WOODS SHALL EQUAL SCREW SHANK DIAMETER AT THE SCREW SHANK, AND SHALL BE UNDERSIZED BY 25% OF SCREW DIAMETER AT THE SCREW THREADS. FOR EXAMPLE, FOR A 3/8" SCREW, THE PRE-DRILLED HOLE SHALL BE 3/8" OVER THE LENGTH OF THE SCREW SHANK, AND SHALL BE 9/32" OVER THE LENGTH OF THE SCREW THREADS. FOR HARD WOODS USED IN A STRUCTURAL APPLICATION, PRE-DRILLED HOLE DIAMETER AT THE SHANK SHALL MATCH THE SCREW DIAMETER, AND THE HOLE DIAMETER OVER THE LENGTH OF THE SCREW THREADS SHALL BE UNDERSIZED BY 12.5% OF THE SCREW DIAMETER.
- 12. SILL PLATES IN DIRECT CONTACT WITH CONCRETE, MASONRY, OR EARTH, SHALL BE PRESSURE TREATED WOOD OR APPROVED EQUAL. PRESSURE TREATED WOOD SHALL BE TREATED WITH ALKALINE COPPER QUAT (ACQ-C AND ACQ-D), CARBONATE AZOLE (CBA-A), OR COPPER AZOLE (CA-B).
- 13. PROVIDE DOUBLE OR 4x FLOOR JOIST UNDER PARALLEL, NON-BEARING PARTITION WALL UNLESS OTHERWISE NOTED.
- 14. PROVIDE LAMINATED DOUBLE STUDS UNDER EACH SUPPORT OF BEAMS UNLESS OTHERWISE NOTED. 15. SOLID BLOCKING SHALL BE PLACED BETWEEN JOISTS AT POINTS OF SUPPORT AND POINTS WHERE
- SHEATHING IS DISCONTINUOUS. 16. APPLY ADHESIVE TO CONTACT SURFACES BETWEEN HORIZONTAL PLYWOOD SHEATHING AND SUPPORTING
- WOOD MEMBER.
- 17. WOOD MEMBER WITH WANE SHALL NOT BE LOCATED AT PLYWOOD JOINT.
- 18. NO STRUCTURAL MEMBER SHALL BE CUT WITHOUT THE APPROVAL OF THE STRUCTURAL ENGINEER.
- 19. HARDWARE CONNECTING WOOD MEMBERS SHALL BE RECESSED WHEN REQUIRED BY ARCHITECTURAL FINISH. VERIFY WITH ARCHITECTURAL DRAWINGS.
- 20. 0.229"x2"x2" STEEL PLATE WASHERS (OR SIMPSON BP) SHALL BE USED FOR ALL SILL PLATE ANCHOR BOLTS AND HOLDOWN CONNECTOR BOLTS UNLESS OTHERWISE NOTED. SIMPSON BP SHALL BE PROTECTED WITH ZMAX (G185) COATING.
- 21. ALL BOLTS SHALL BE RE-TIGHTENED JUST PRIOR TO BEING COVERED.
- 22. BOLT HOLES AT WOOD MEMBERS SHALL NOT BE MORE THAN 1/16" LARGER THAN THE BOLT DIAMETER.
- 23. ALL HARDWARE AND FASTENERS IN CONTACT WITH TREATED WOOD SILL PLATES SHALL BE ZINC- COATED. ALL NAILS INTO TREATED SILL PLATES SHALL BE HOT-DIPPED ZINC-COATED GALVANIZED OR SIMPSON ZMAX (G185) COATED NAILS.
- 24. SOLID BLOCKING OR EQUIVALENT CROSS-BRIDGING SHALL BE INSTALLED BETWEEN ALL ROOF AND FLOOR JOISTS AT THE SPACING PER CODE.
- 25. FIRE BLOCKING SHALL BE INSTALLED BETWEEN ALL WALL STUDS IF REQUIRED BY CODE.


STRUCTURAL OBSERVATION

- 1. THE OWNER SHALL EMPLOY THE ENGINEER OF RECORD REGISTERED/LICENSED IN THE STATE OF CALIFORNIA WHO IS RESPONSIBLE FOR THE STRUCTURAL DESIGN, TO DO STRUCTURAL OBSERVATION.
- 2. THE STRUCTURAL OBSERVATION IS REQUIRED FOR THE STRUCTURAL SYSTEM IN ACCORDANCE WITH CBC SECTION 1704. STRUCTURAL OBSERVATION IS THE VISUAL OBSERVATION OF THE ELEMENTS AND CONNECTIONS OF THE STRUCTURAL SYSTEM AT SIGNIFICANT CONSTRUCTION STAGES AND THE COMPLETE STRUCTURE FOR GENERAL CONFORMANCE TO THE APPROVED PLANS AND SPECIFICATIONS. STRUCTURAL OBSERVATION DOES NOT WAIVE THE RESPONSIBILITY FOR THE INSPECTIONS REQUIRED OF THE PROJECT INSPECTOR, DEPUTY INSPECTOR, SPECIAL INSPECTOR OR CITY INSPECTOR.
- 3. STRUCTURAL OBSERVER OF RECORD : SAID HILMY, S3680
- 4. THE STRUCTURAL OBSERVER SHALL PERFORM SITE VISITS AT THOSE STEPS IN THE PROGRESS OF THE CONSTRUCTION THAT ALLOW FOR CORRECTION OF DEFICIENCIES WITHOUT SUBSTANTIAL EFFORT OR UNCOVERING OF THE WORK INVOLVED. AT A MINIMUM, THE FOLLOWING SIGNIFICANT CONSTRUCTION STAGES REQUIRE A SITE VISIT AND AN OBSERVATION REPORT FROM THE STRUCTURAL OBSERVER.

CONSTRUCTION STAGE ELEMENTS/CONNECTIONS TO BE OBSERVED; A. FOLLOWING RETROFIT/PRIOR TO COVERING WITH FINISH.

OBSERVED DEFICIENCIES: ANY OBSERVED DEFICIENCIES SHALL BE DESCRIBED ON THE FORM; THE OBSERVER SHALL ALSO INDICATE WHETHER A RE-OBSERVATION IS REQUIRED TO VERIFY CORRECTIVE ACTIONS HAVE BEEN PROPERLY TAKEN OR THAT THE CORRECTIVE ACTIONS ARE DEEMED VERIFIABLE BY THE SPECIAL INSPECTOR OR CITY INSPECTOR PRIOR TO INSPECTION APPROVAL.

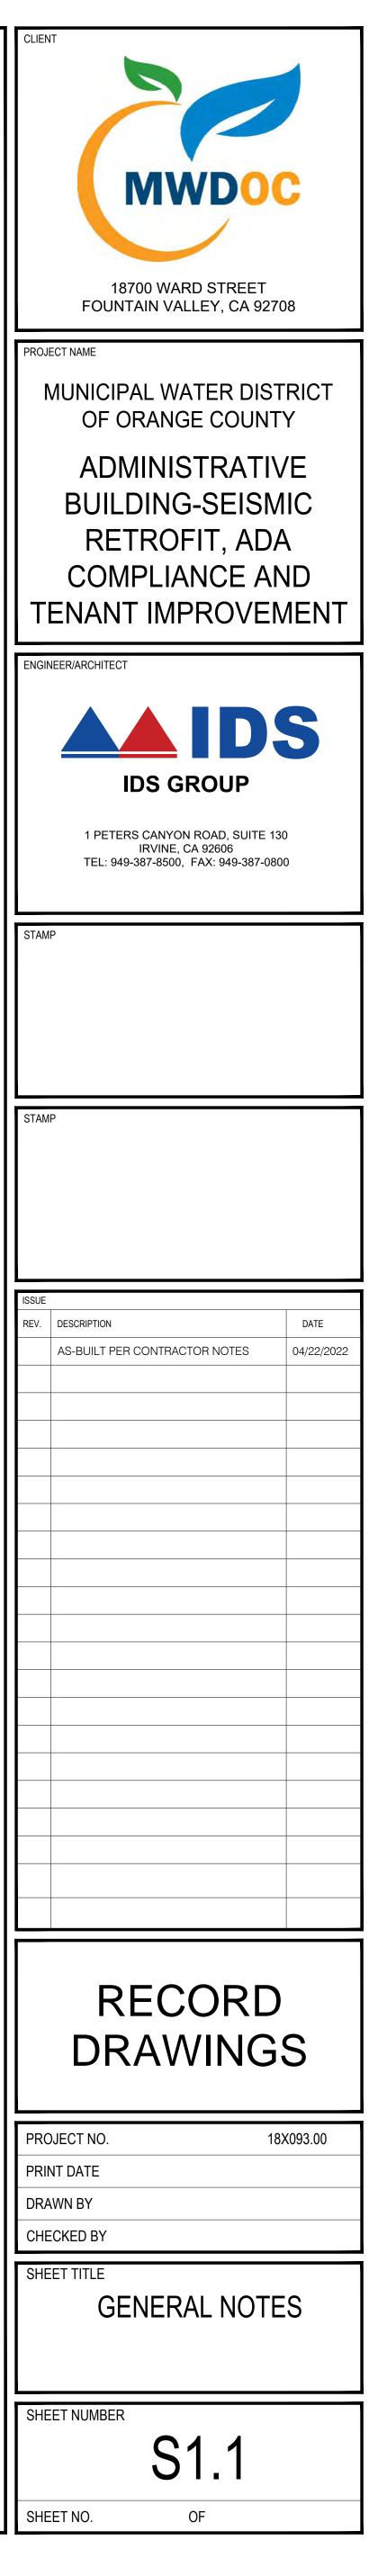

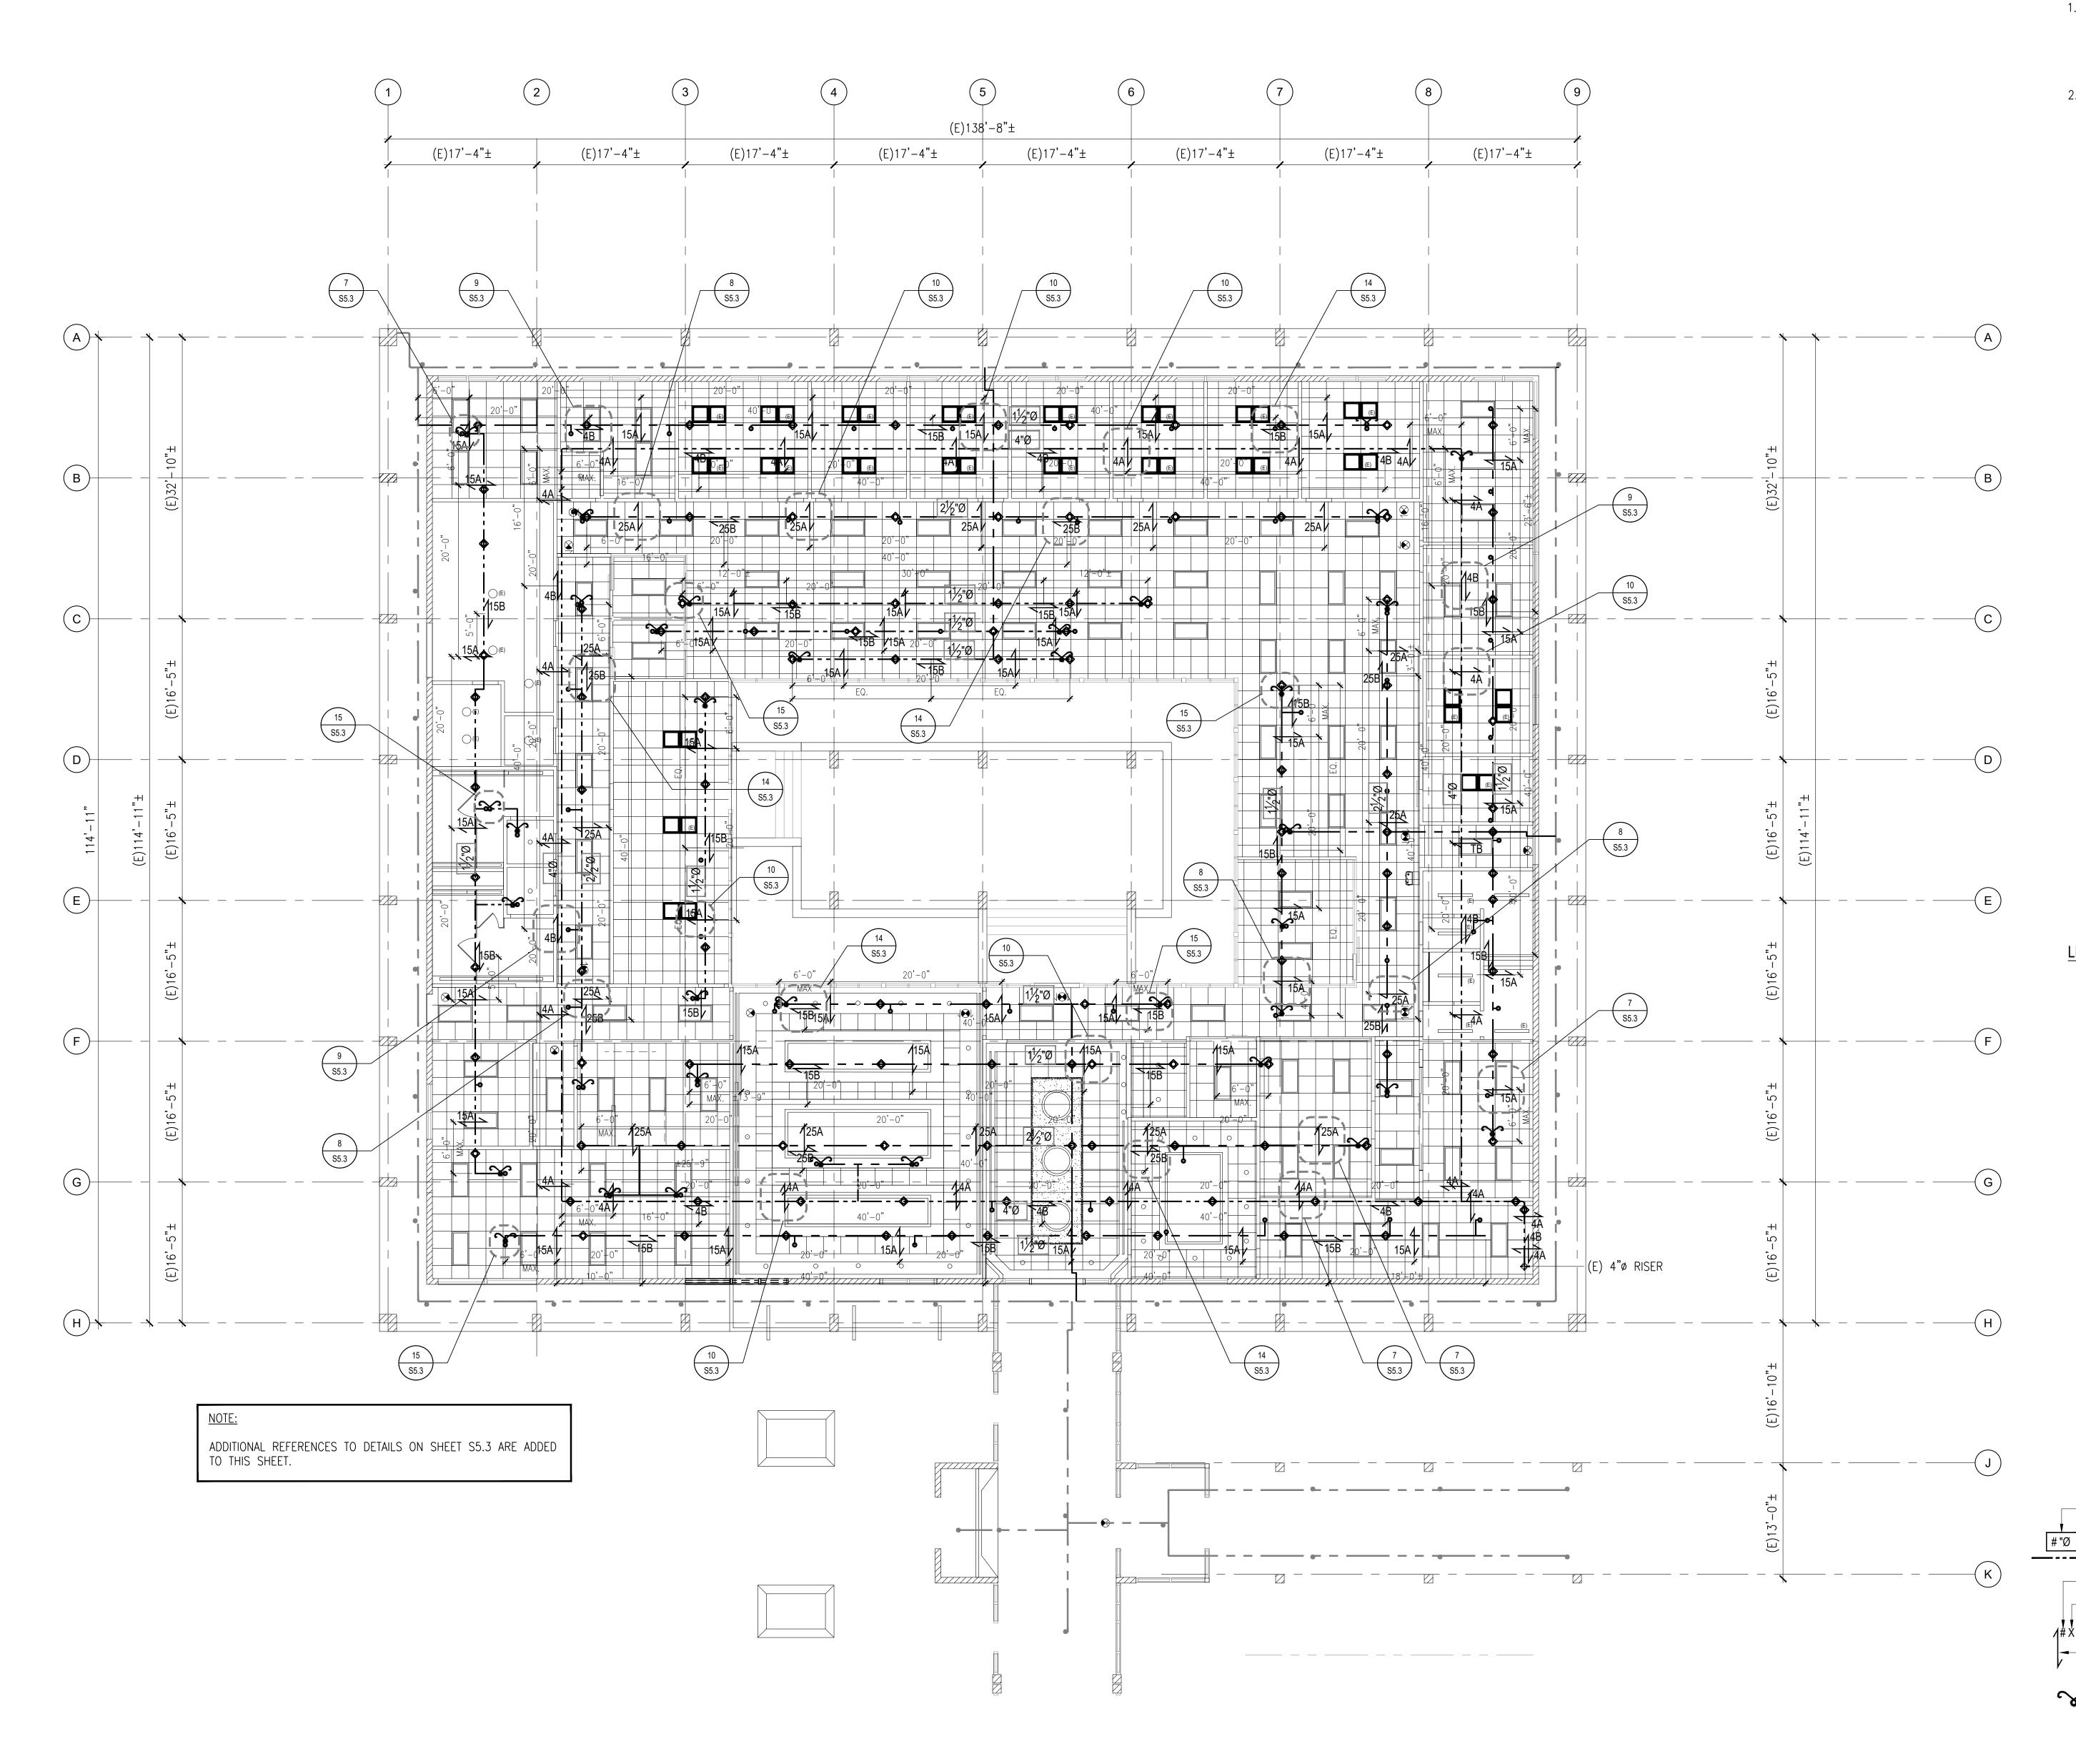

- <u>NOTES</u> 1. THESE DRAWINGS ARE SOLELY TO IMPROVE THE SEISMIC BRACING OF THE EXISTING FIRE SPRINKLER SYSTEM IN THIS STRUCTURE TO MEET CURRENT NFPA STANDARD OF HIGH SEISMIC PERFORMANCE LEVEL.
- 2. THE FIRST TRANSVERSE BRACE LOCATED AT 6'-0" FROM THE START OF THE PIPE LINE CAN BE ADJUSTED TO LINE UP WITH THE EXISTING FRAMING TO A MAXIMUM DISTANCE OF 6'-0'' FROM THE START OF THE PIPE LINE

LEGEND:

LINE	SIZE
4	4"ø
25	2½"ø
15	1½"ø

BRACE TYPE A = LATERAL B = LONGITUDINAL

LINE	MAXIMUM BRACE SPACING	MAXIMUM BRACE LOAD
4A	20'-0"	300 LBS
4B	40'-0"	569 LBS
25A	20'-0"	175 LBS
25B	40'-0"	230 LBS
15A	20'-0"	85 LBS
15B	40'-0"	145 LBS

 \bigcirc INDICATES (E) PIPE HANGER


• INDICATES (E) FIRE SPRINKLER HEAD


- INDICATES (E) FIRE SPRINKLER PIPE SIZE

#"Ø INDICATES (E) FIRE SPRINKLER PIPE - INDICATES LINE SIZE

- INDICATES BRACE TYPE


NDICATES LINE RESTRAINT WITH SPLAY WIRE, SURGE RESTRAINER, RING HANGER, HANGER ROD AND BEAM CONNECTION ASSEMBLY. SEE DETAIL 15/S5.3.

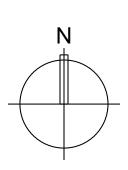


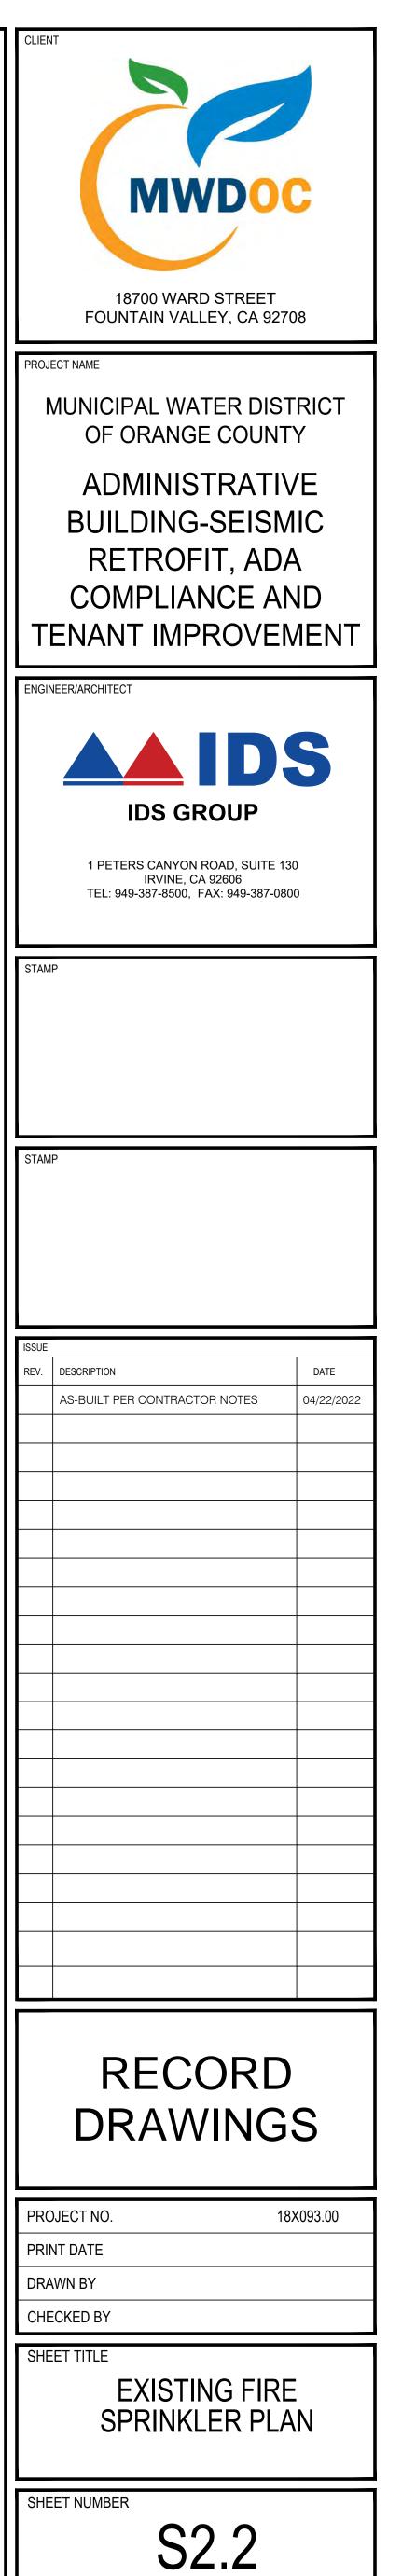



SHEET NO.


OF

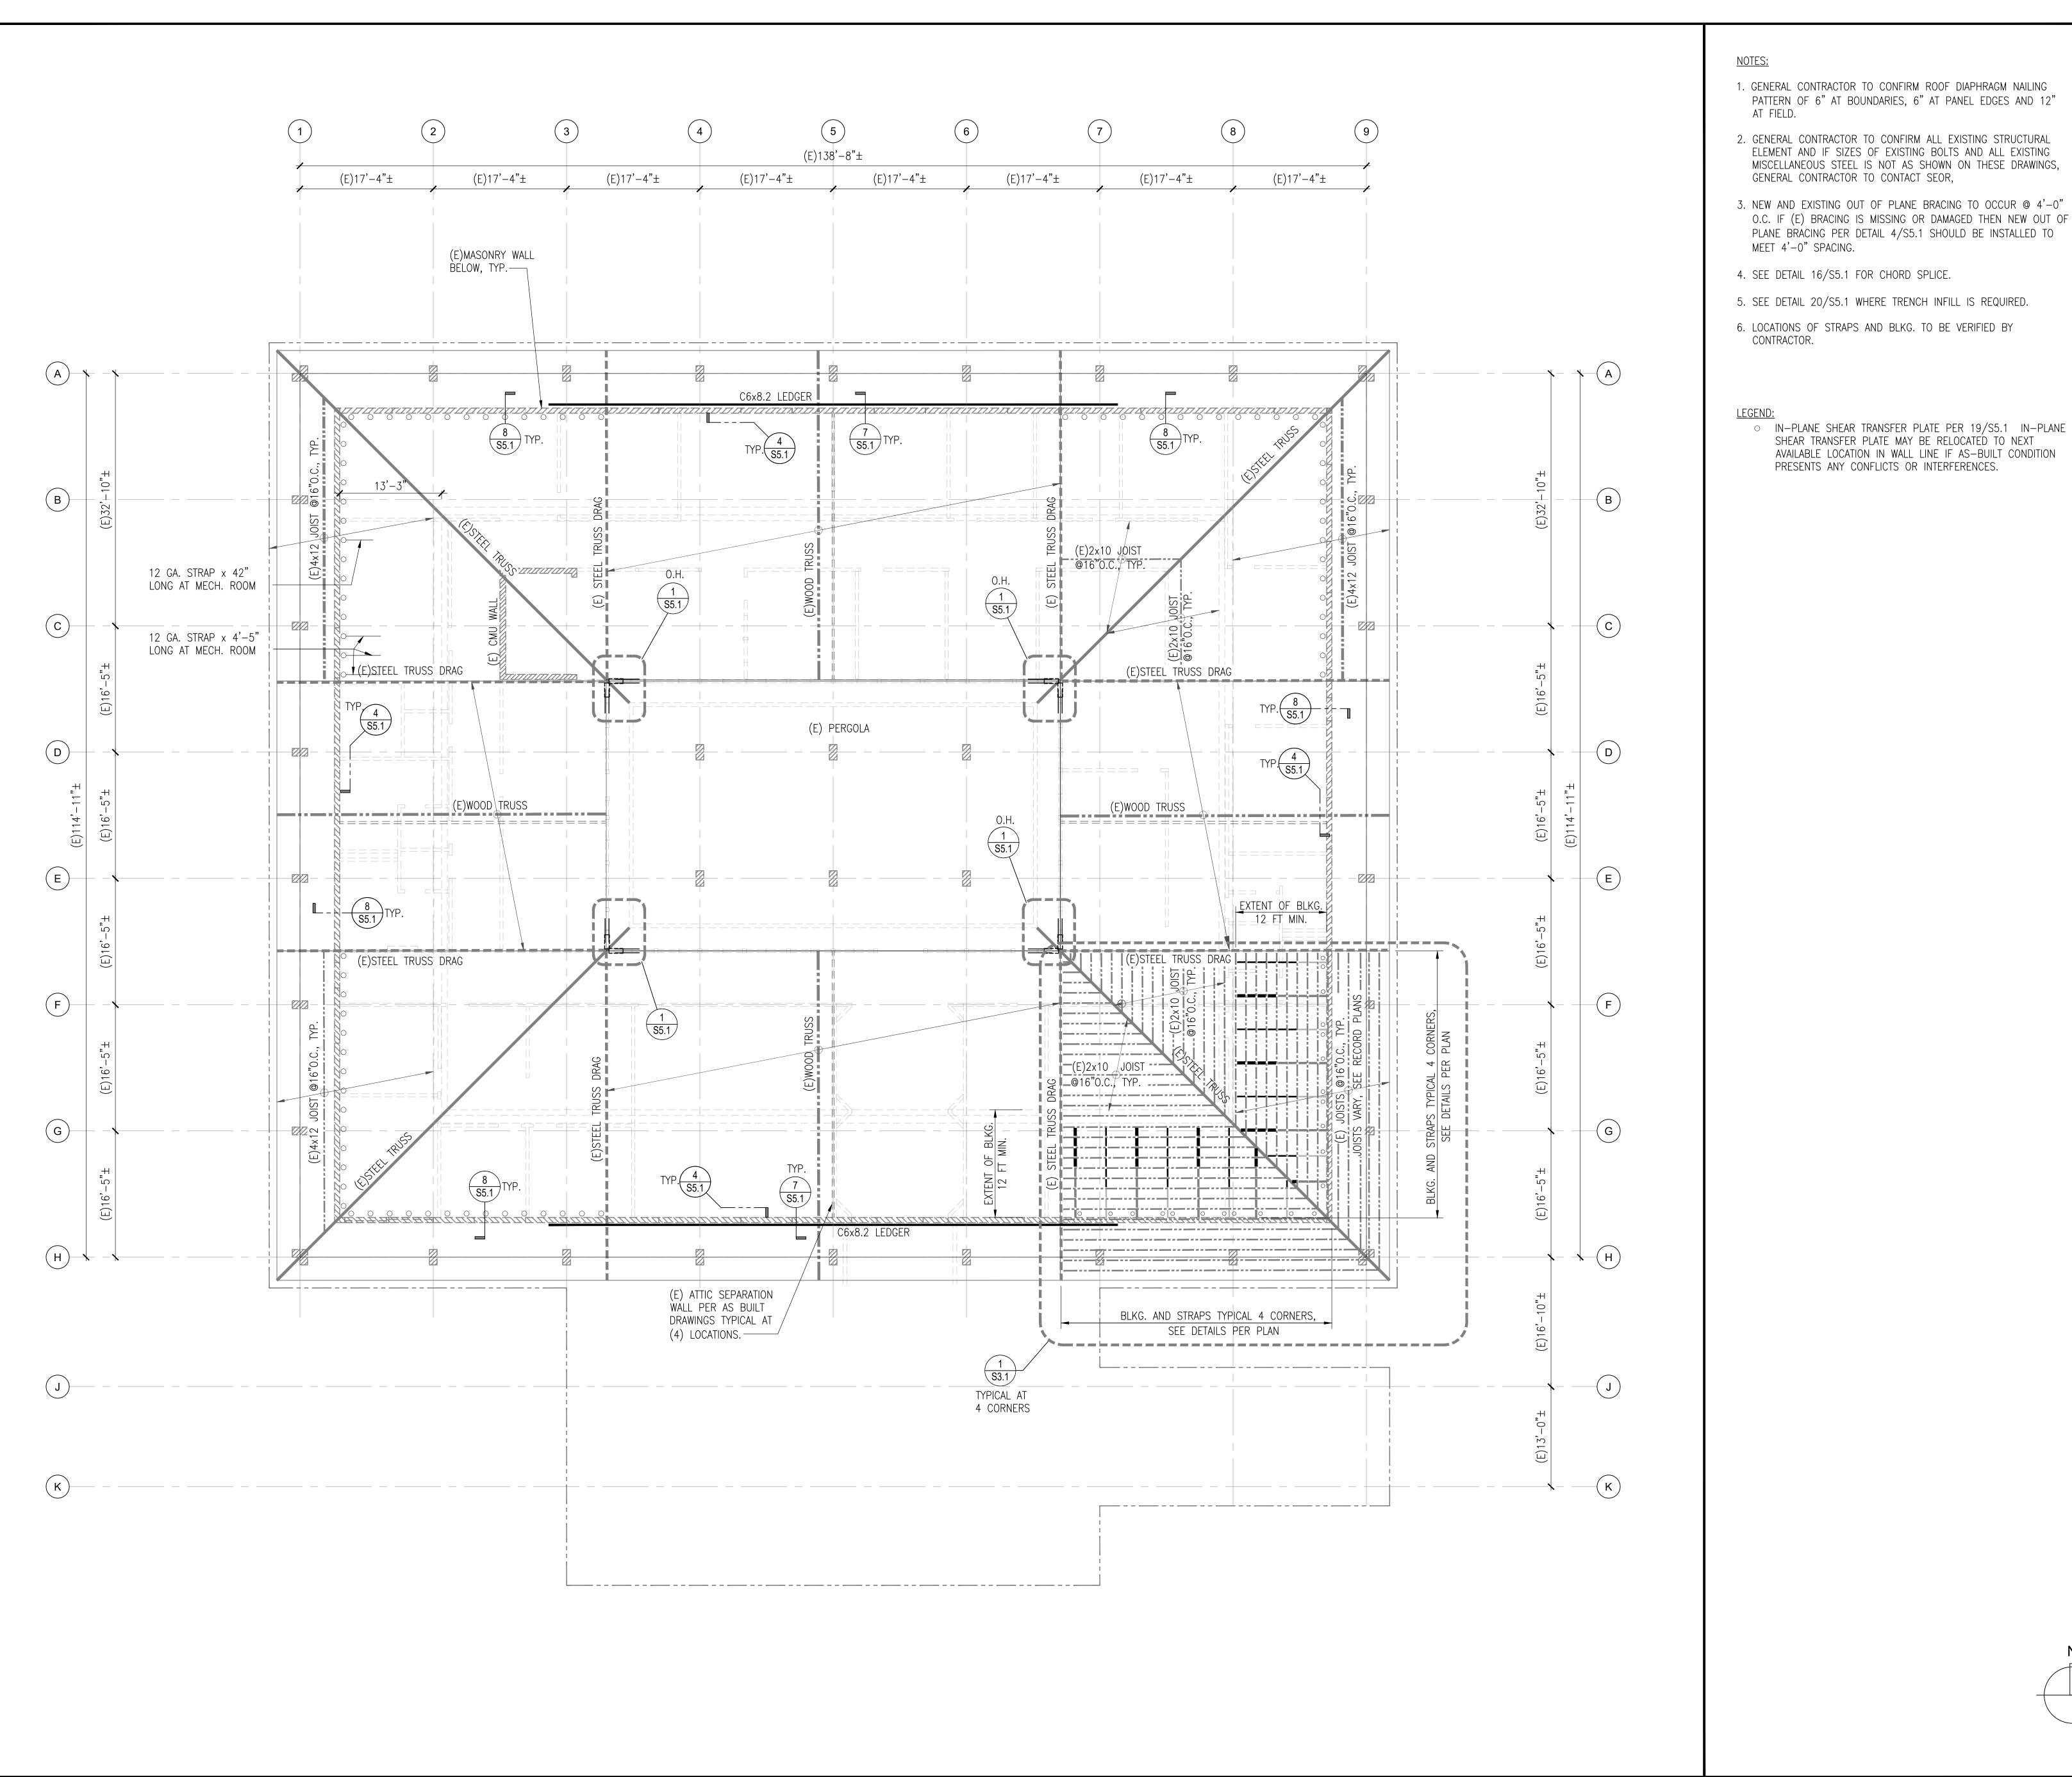

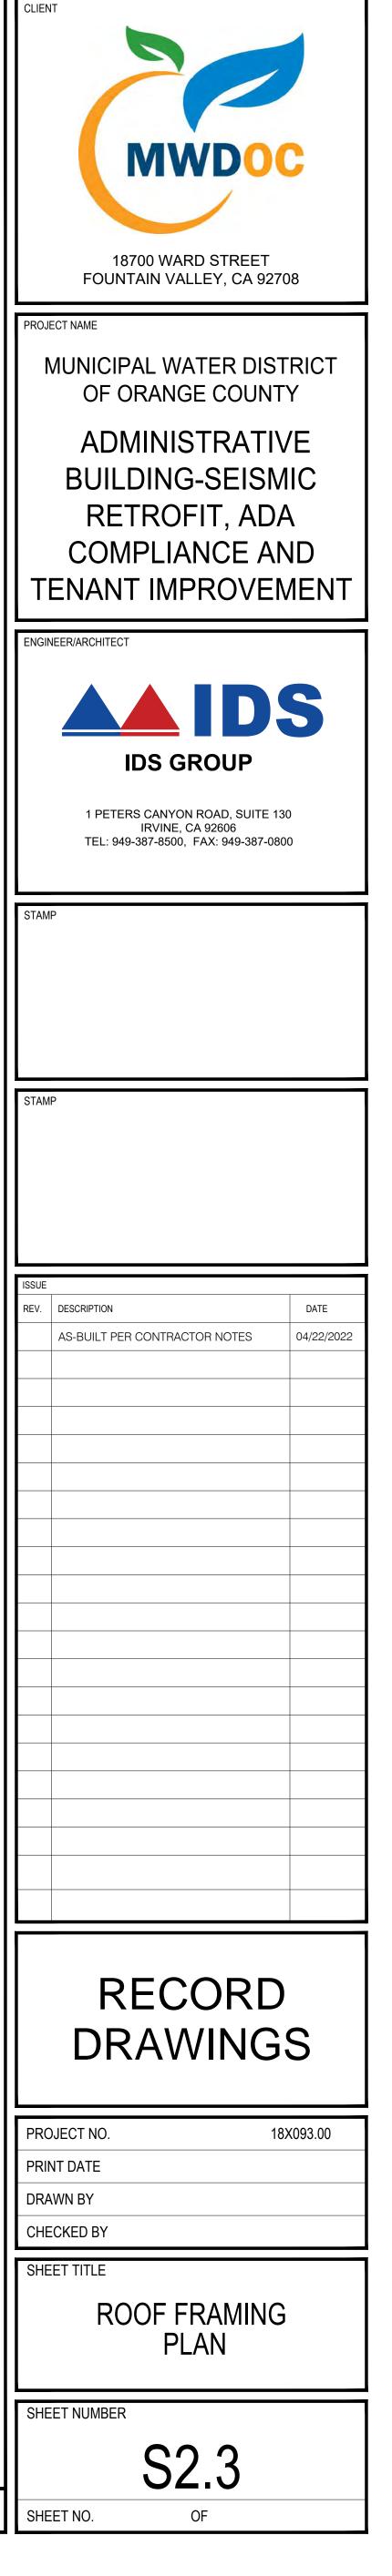

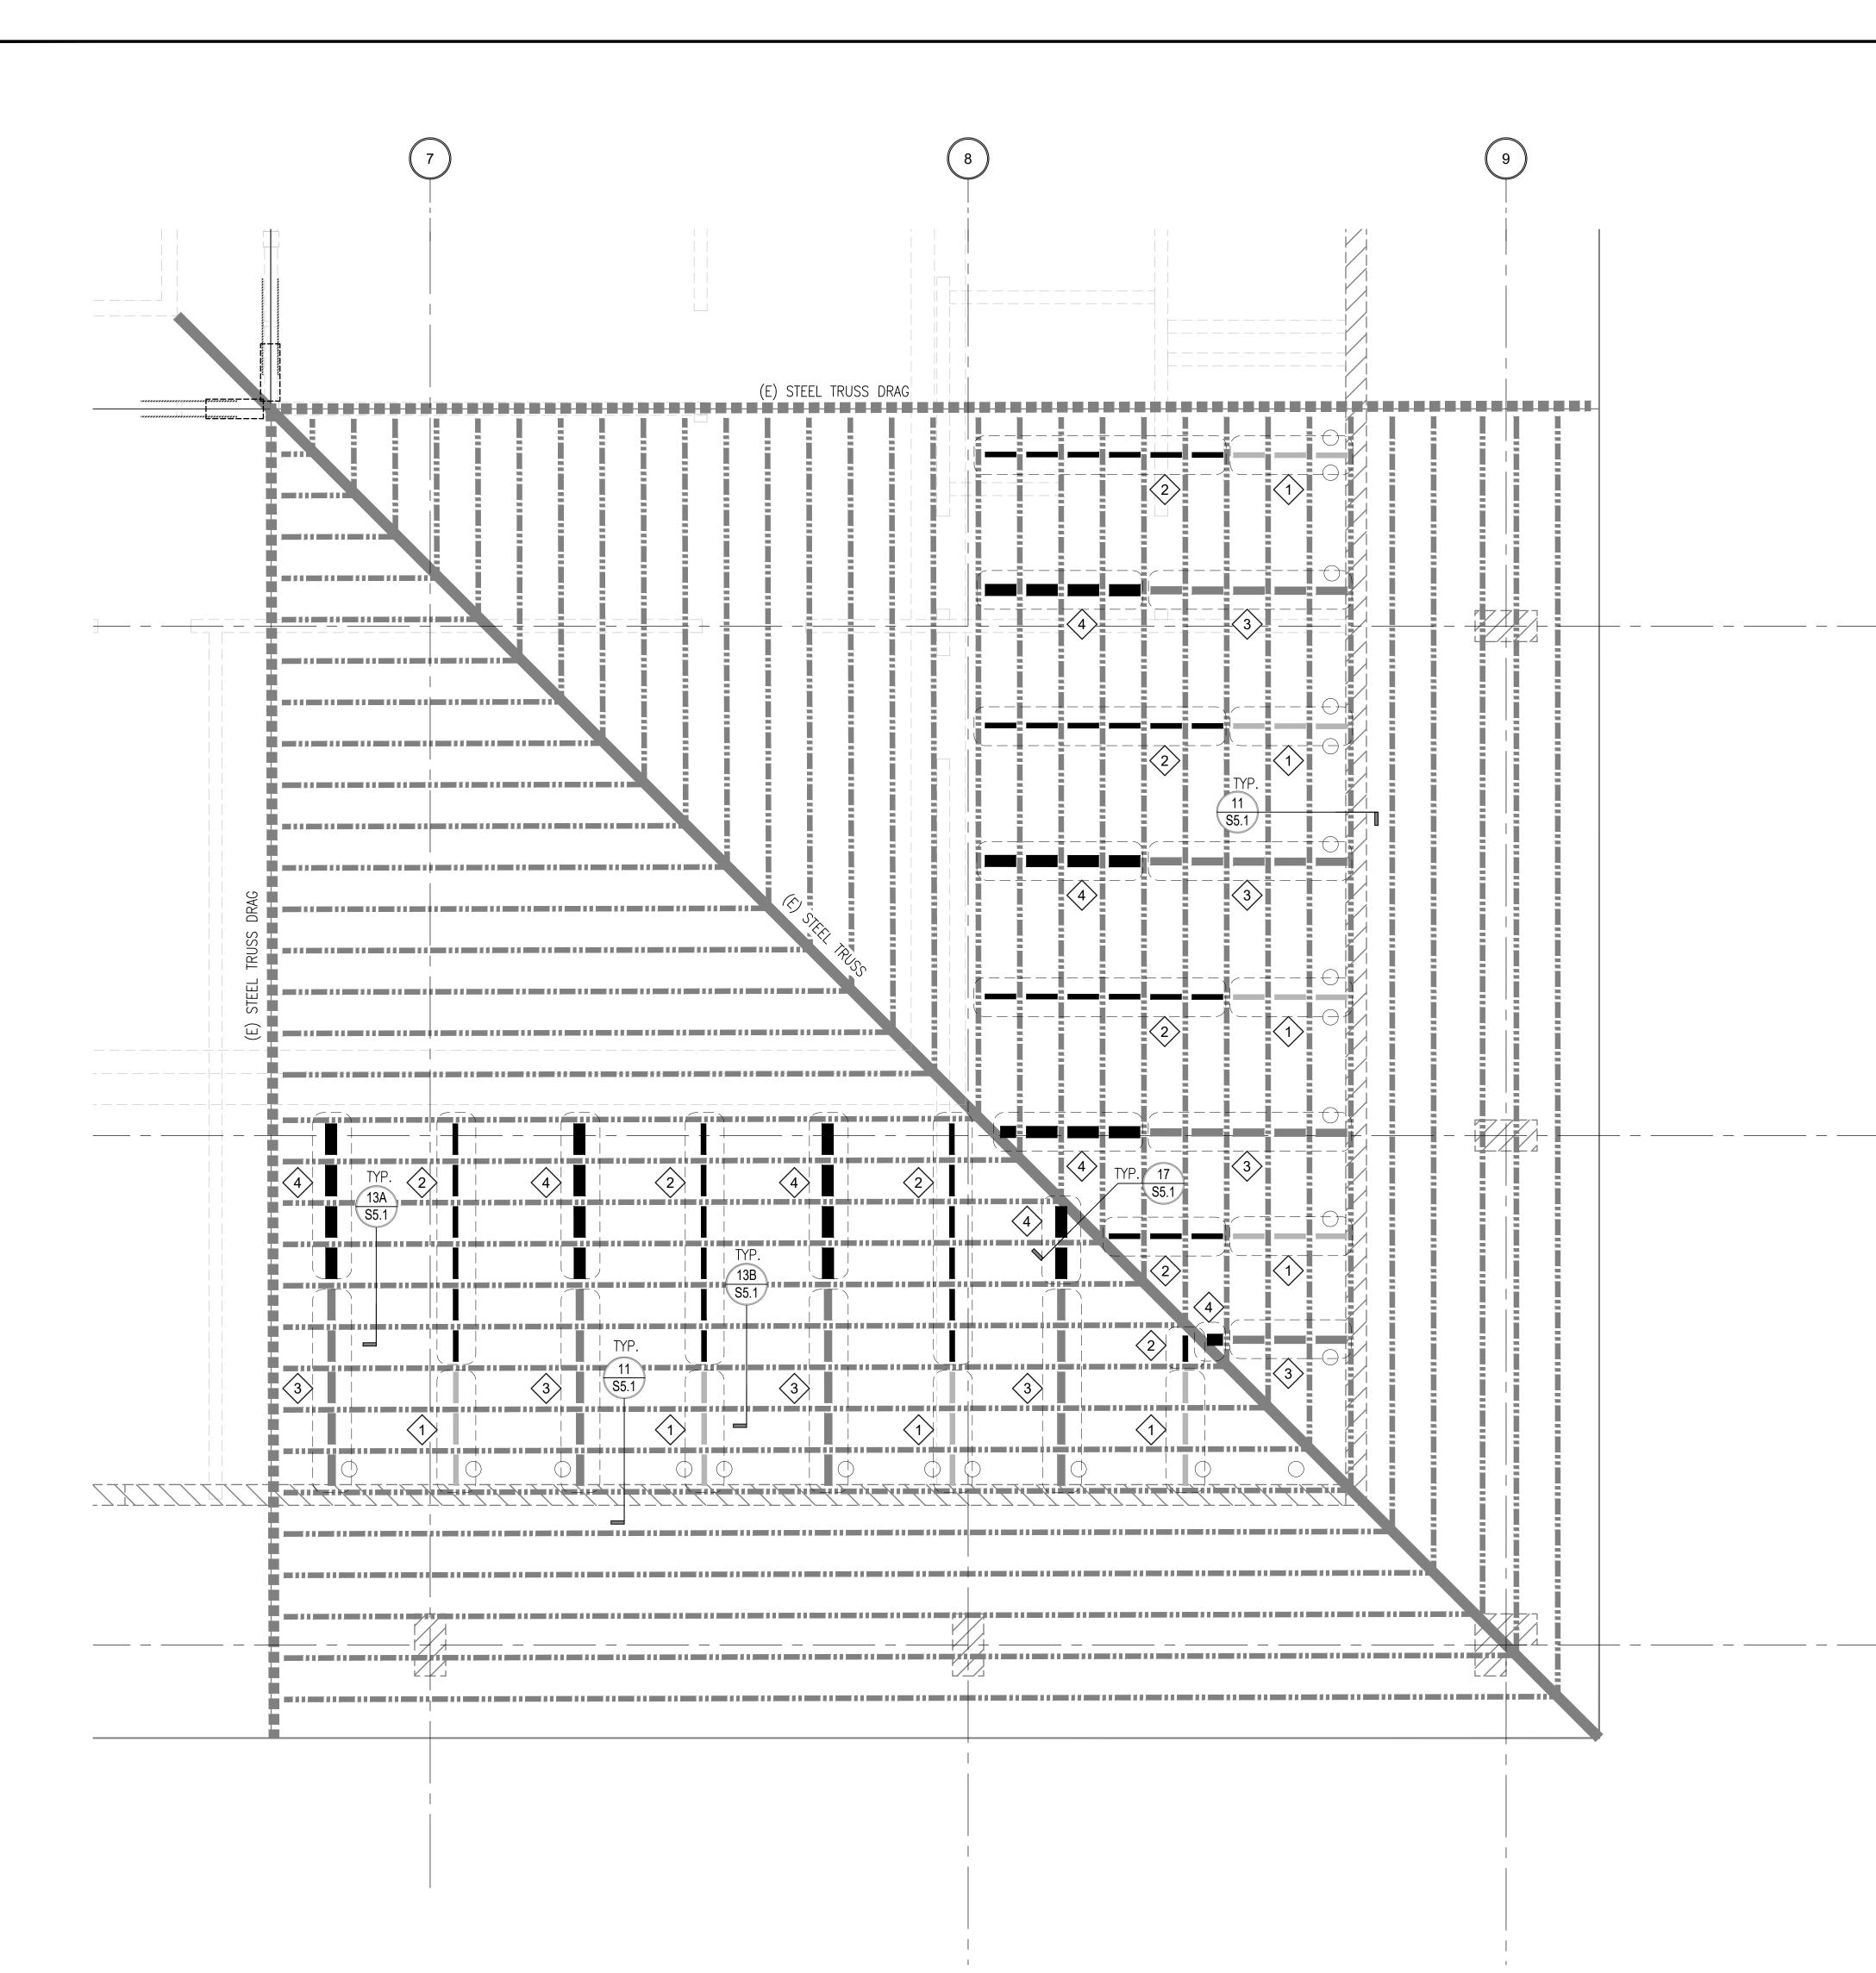


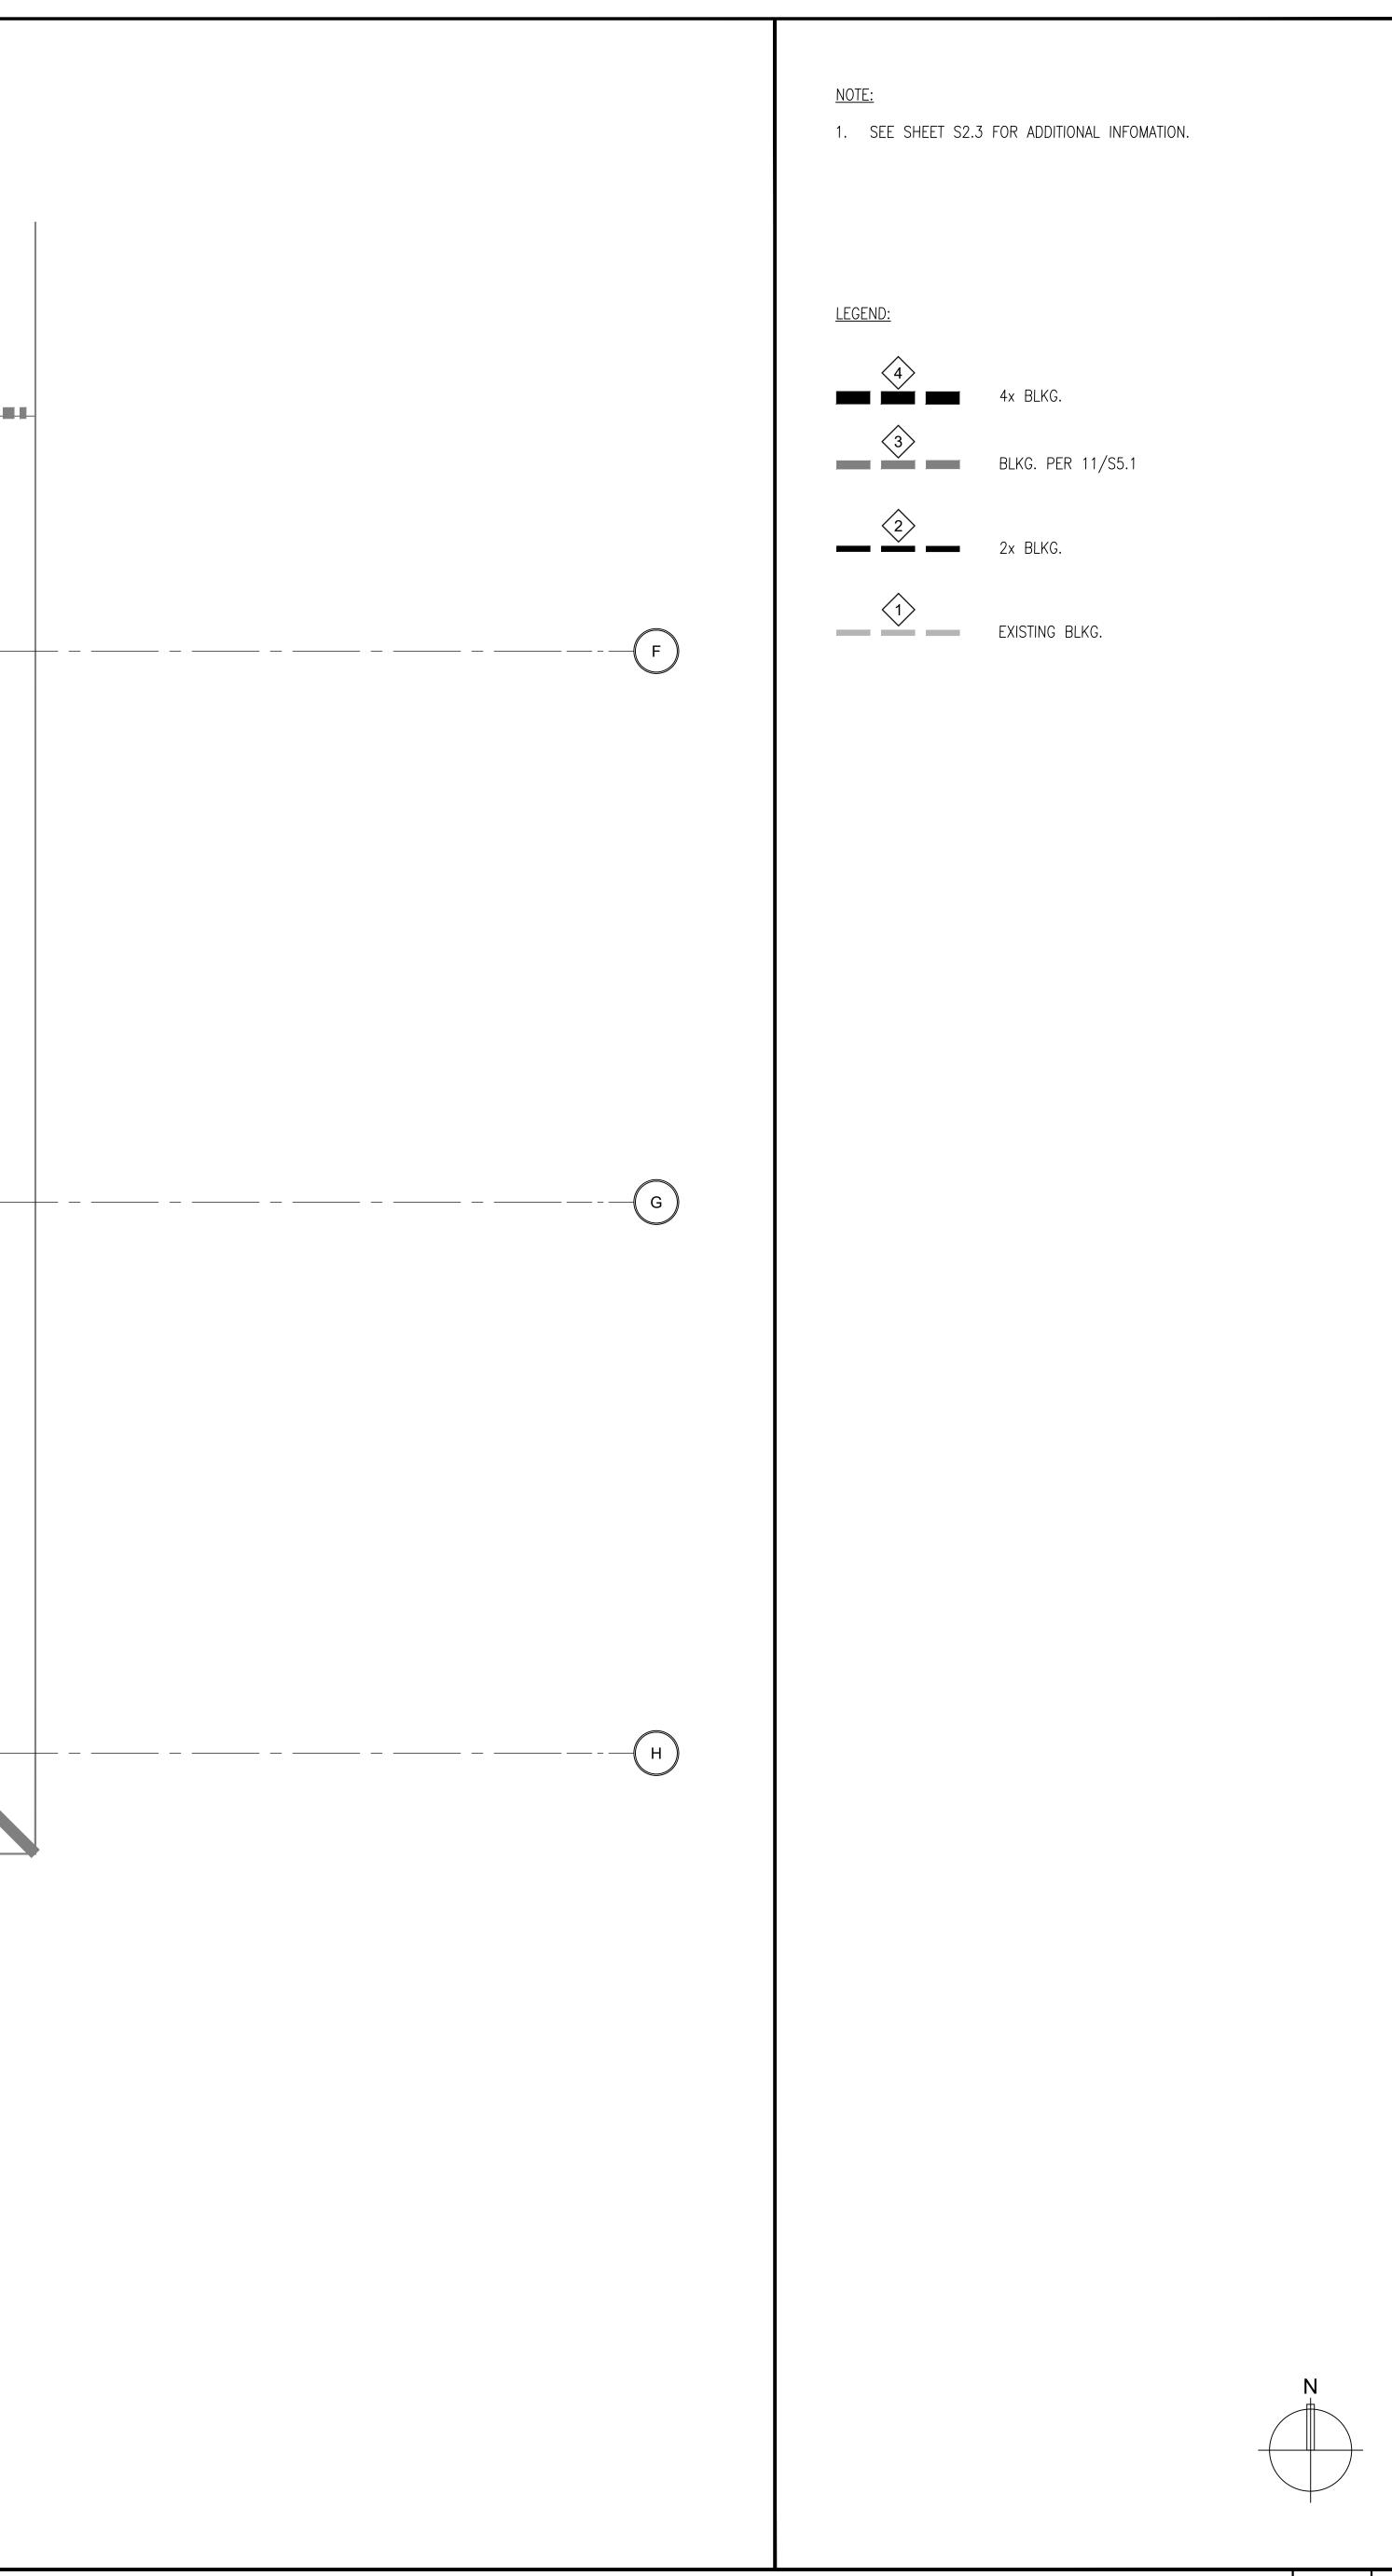


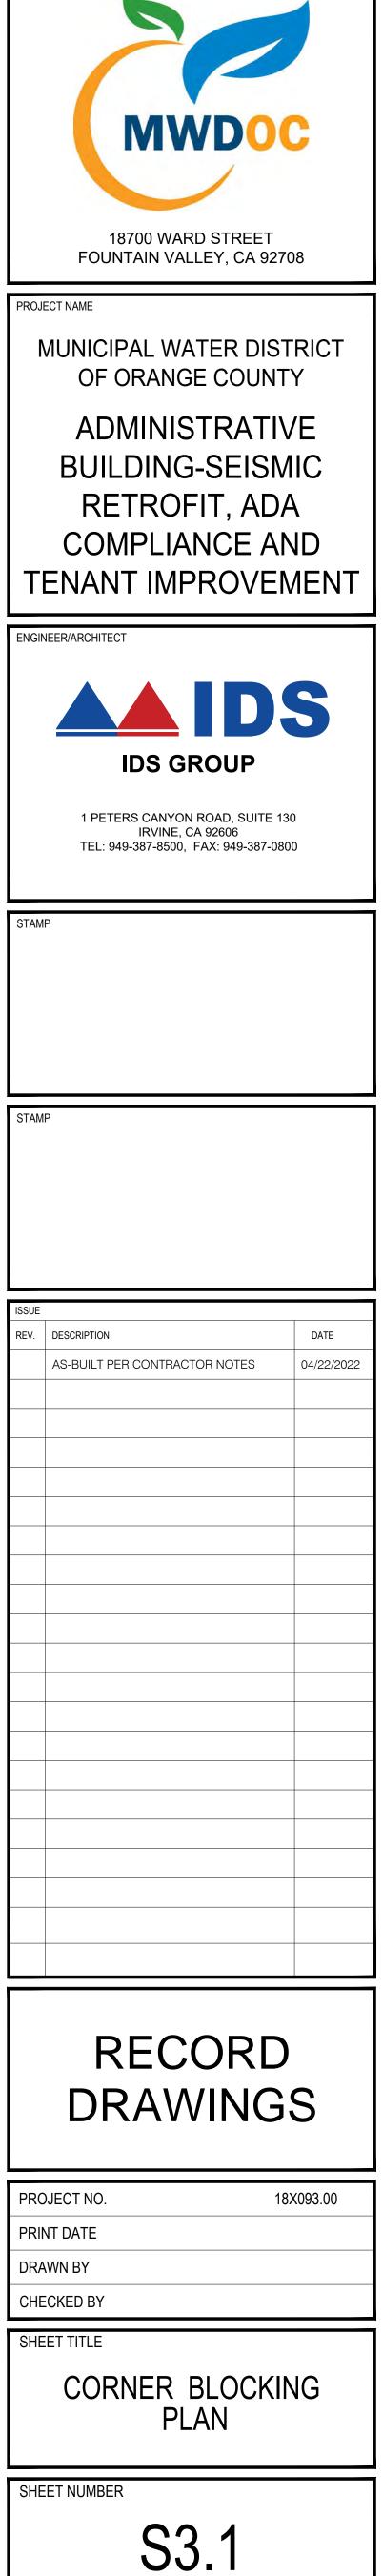


SHEET NO.


OF

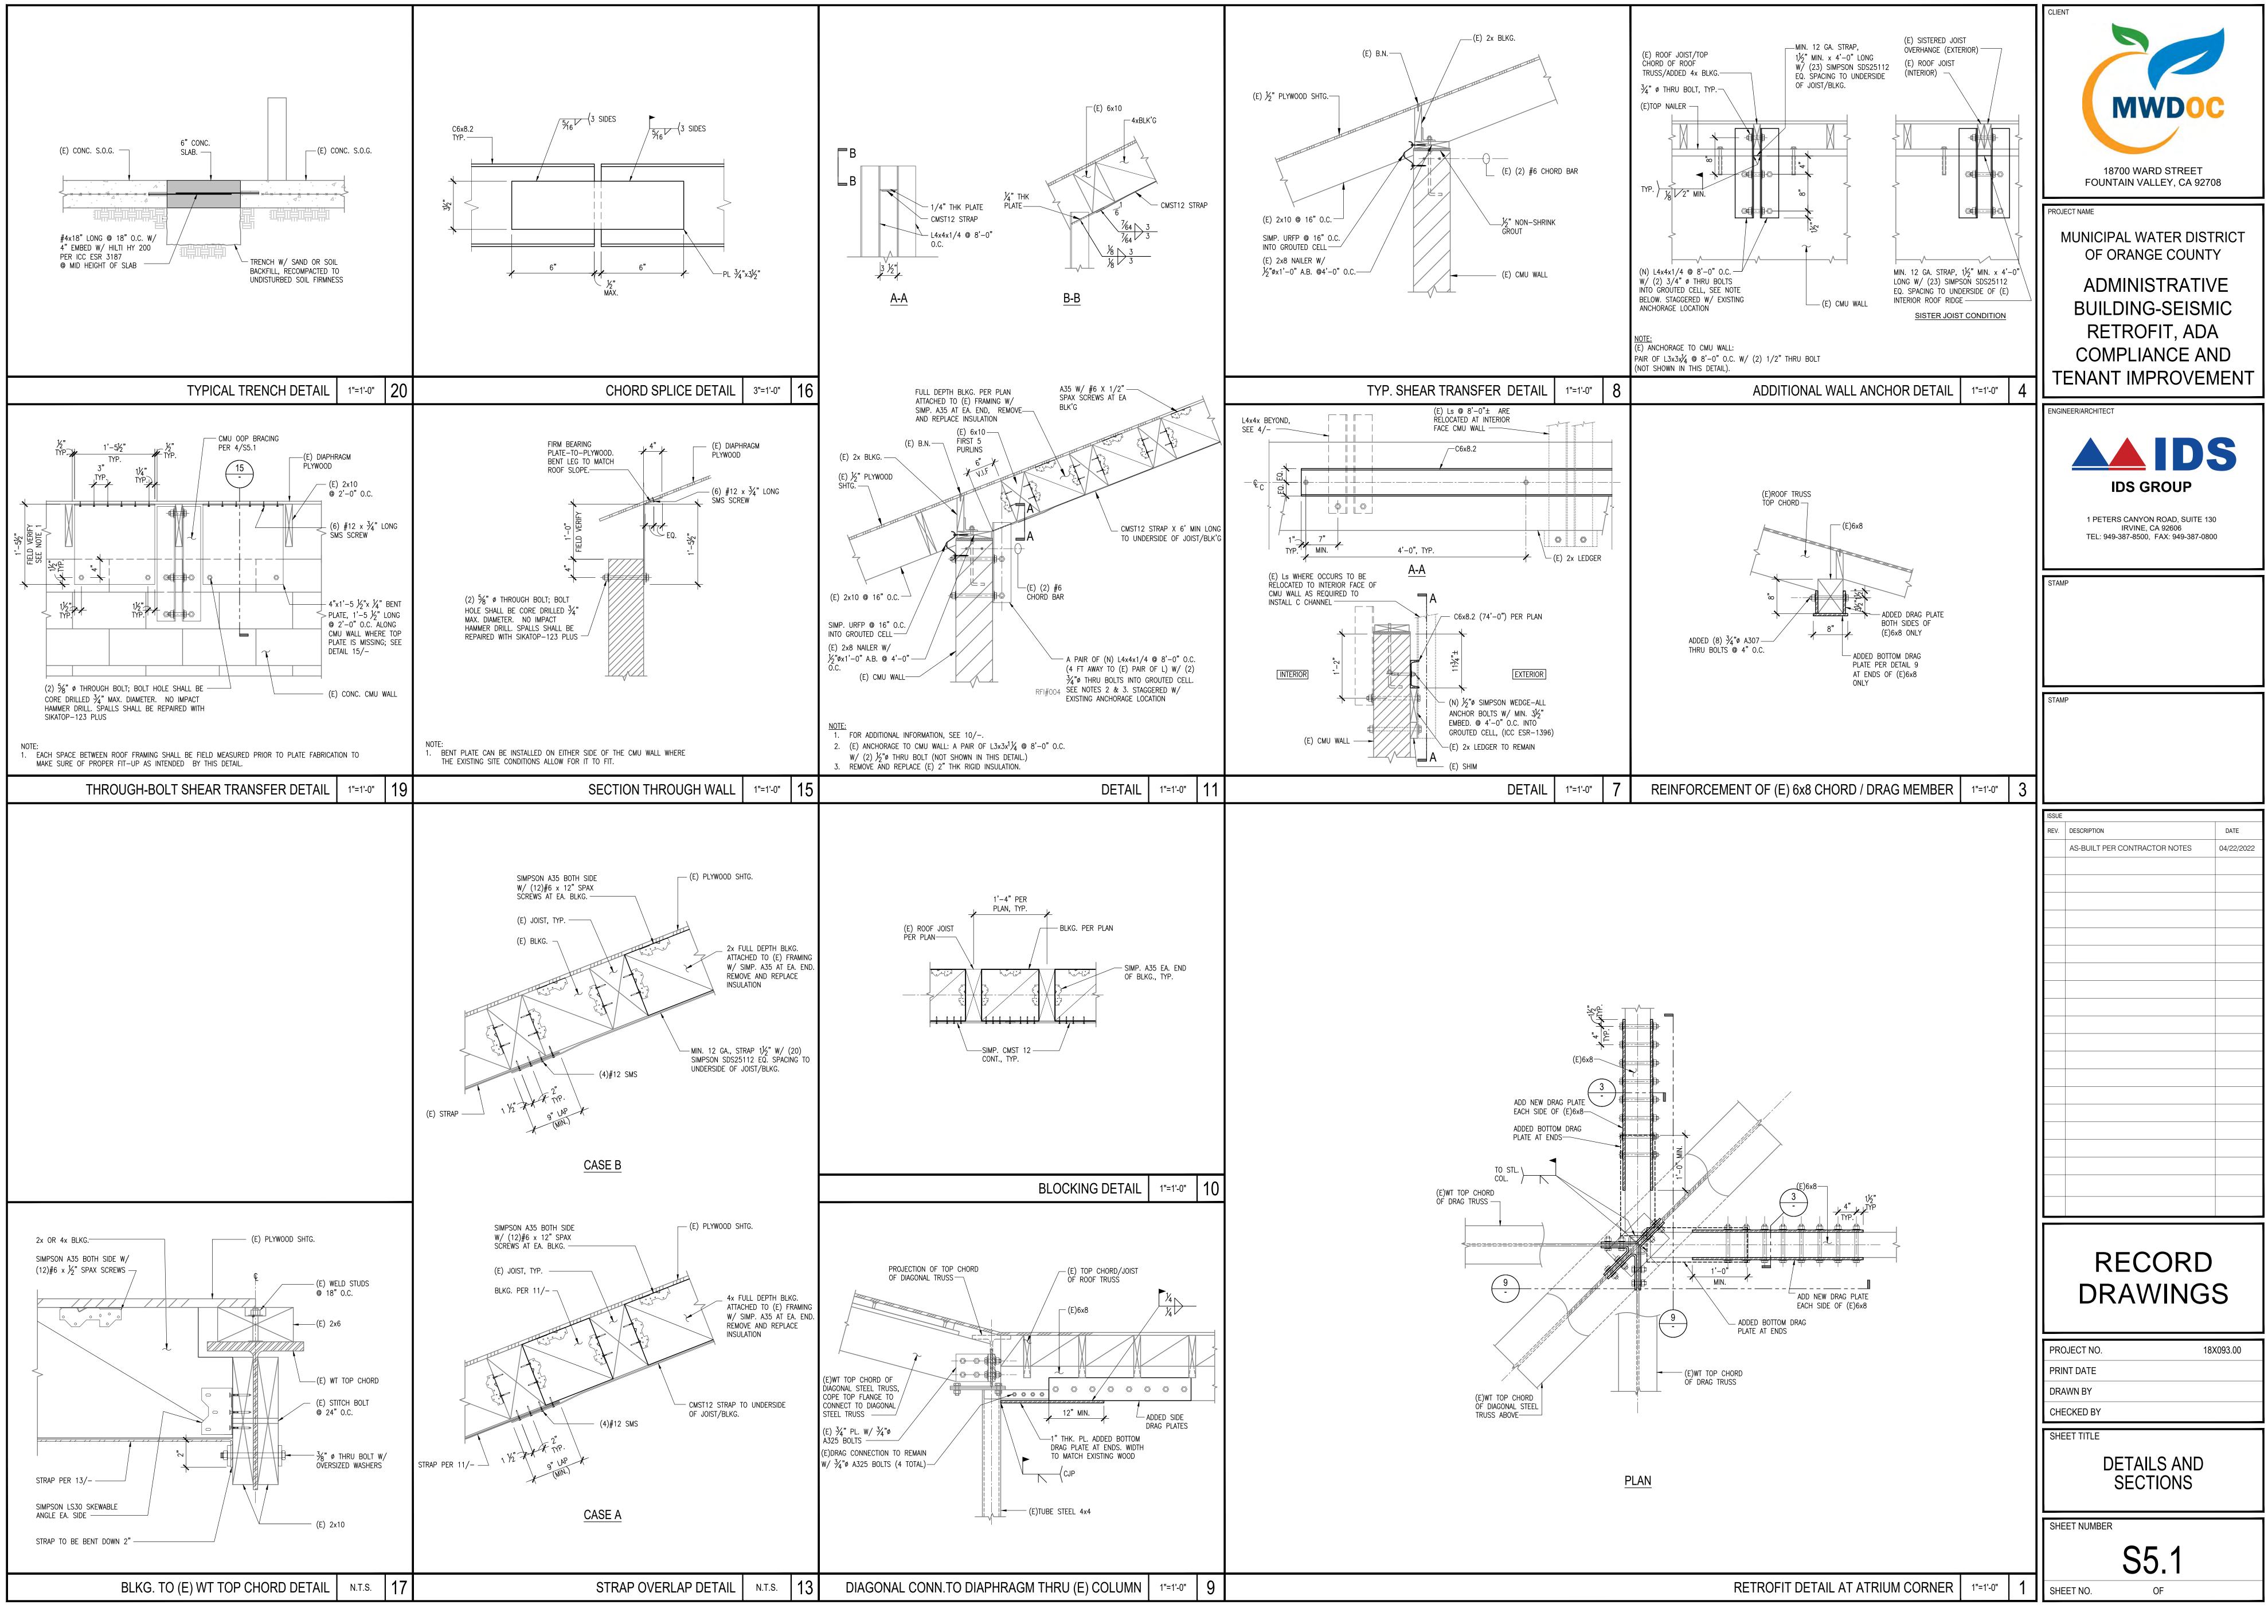

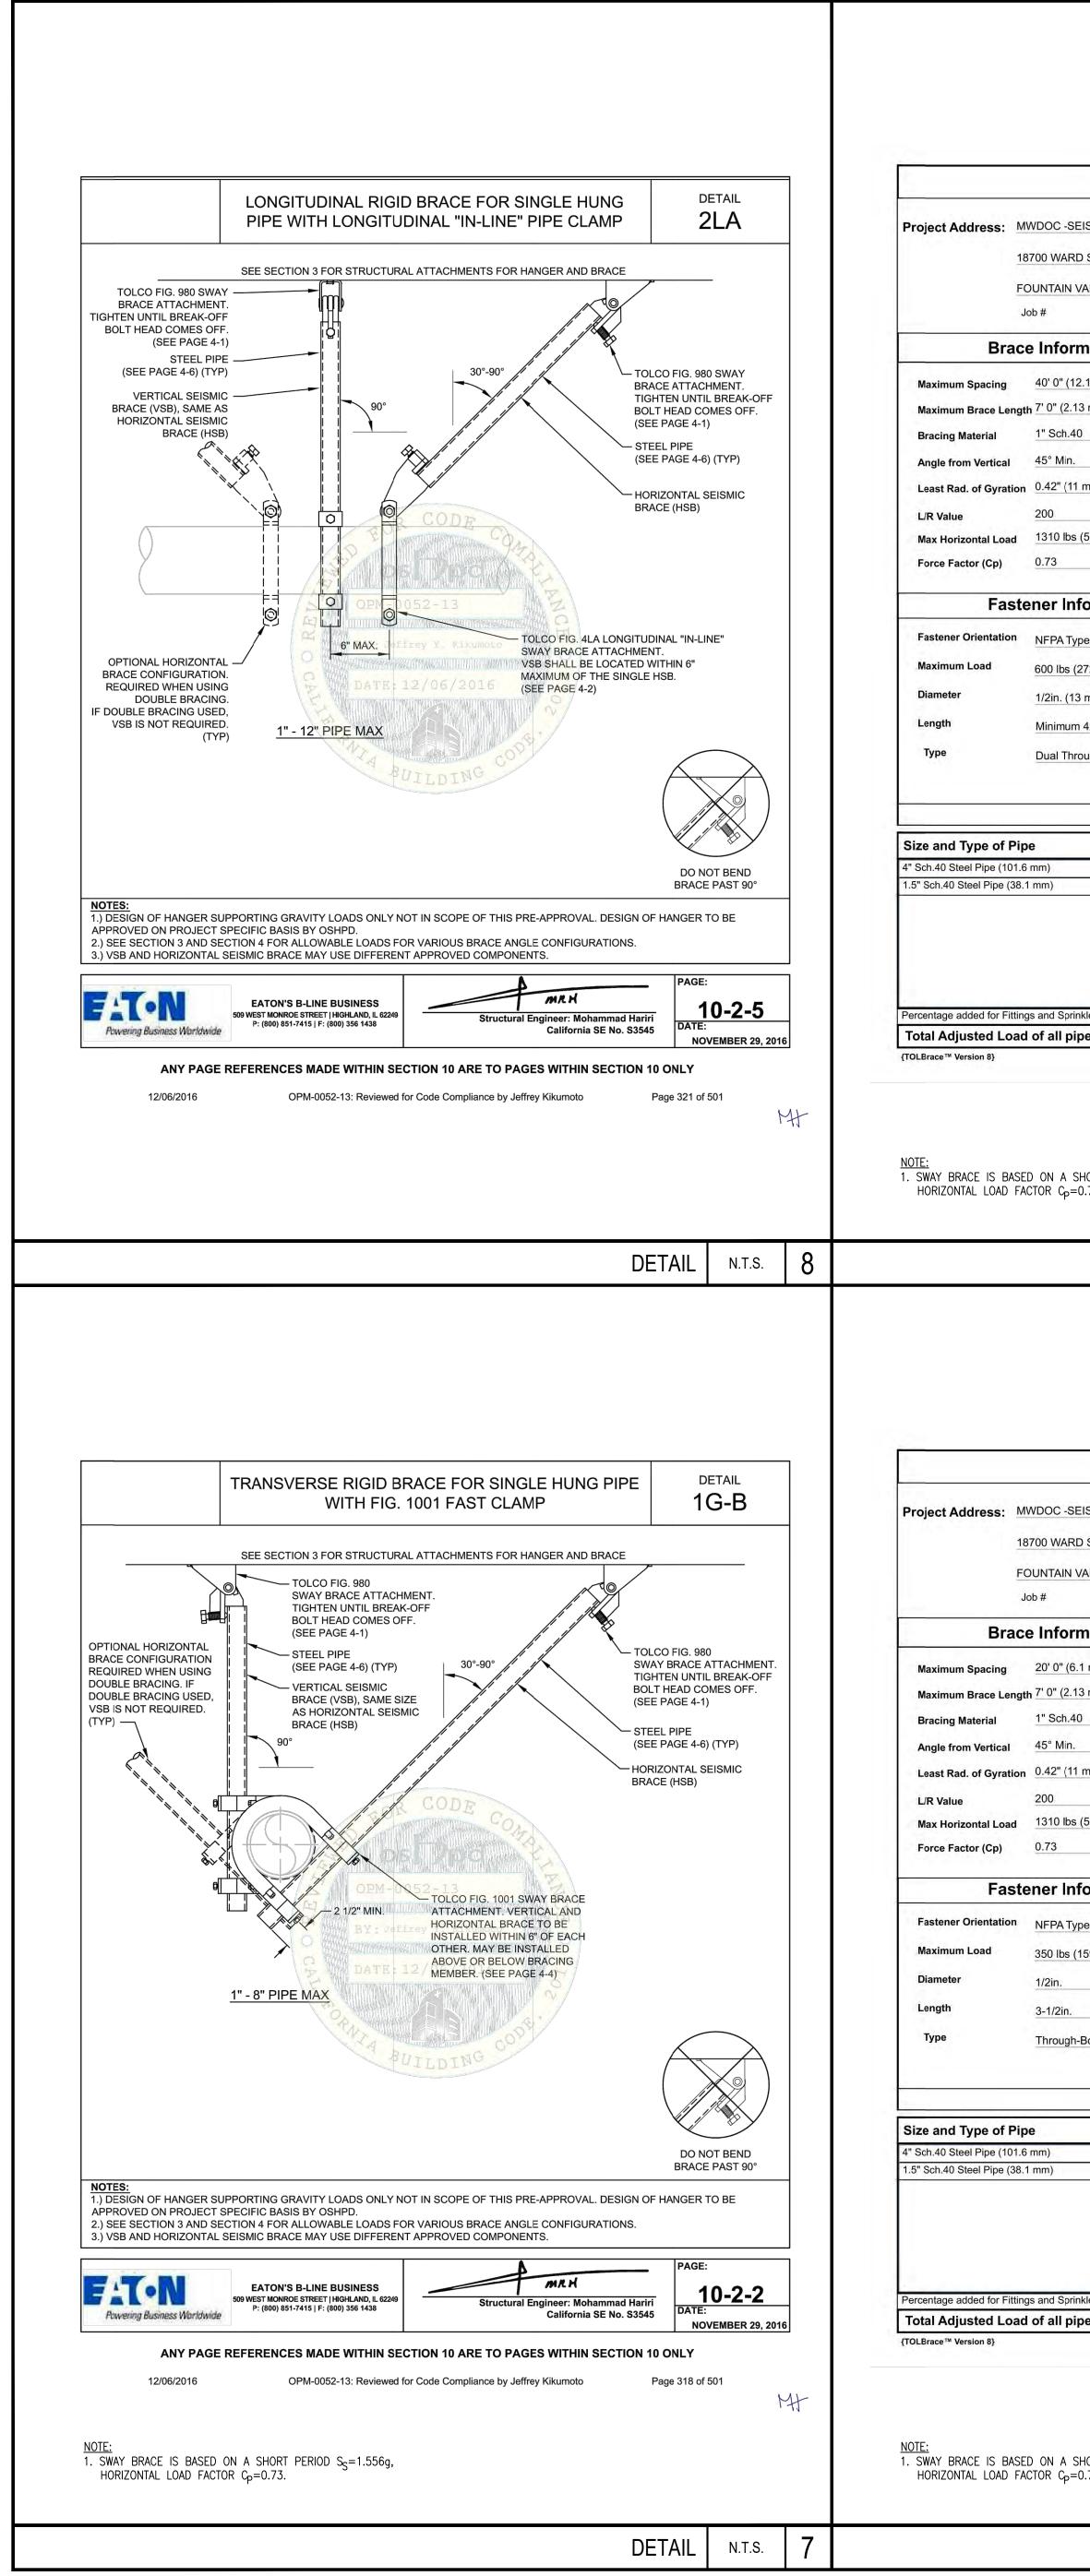

	TOLBrace	■ [™] Seismic Calculation
IDS Group 1 Peters Canyon Rd., Ste. 130 Irvine, CA 92606	Project Address: MWDOC -SEISMIC RETROFIT	IDS Group 1 Peters Canyon Rd., Ste. 130
Irvine, CA 92606 Powering Business Worldwide	18700 WARD STREET	Irvine, CA 92606
	FOUNTAIN VALLEY CA 92608	
TOL CO TM Due of Contract of the sector	Brace Information	ons based on 2016 NFPA Pamphlet #13
TOLCO [™] Brace Components TOLCO [™] Component Fig. Number Adjusted Load		TOLCO™ E TOLCO™ Component Fig.
Fig. 4LA Clamp 707 lbs (321 kg)	Maximum Spacing40' 0" (12.19 m)Maximum Brace Length7' 0" (2.13 m)	Fig. 4LA Clamp
Fig.980 Universal Swivel 1425 lbs (646 kg)	Bracing Material 1" Sch.40	Fig.980 Universal Swivel
*Calculation Based on CONCENTRIC Loading *Please Note: These calculations are for TOLCO™ components only. Use of any	Angle from Vertical 45° Min.	*Calculation Based on C *Please Note: These calculations are for
other components voids these calculations and the listing of the assembly. Assembly Detail	Least Rad. of Gyration 0.42" (11 mm)	other components voids these calcu Assen
A	L/R Value 200 Max Horizontal Load 1310 lbs (594 kg)	
B-LPNE I TOLCO PIG 1900 UNIVERSAL SWAY BRACE ATTACHMENT	Force Factor (Cp) 0.73	B-LINE T UNIV BRACE /
BRACE PIPE	Fastener Information	BRACO
B-LINE TOLCO FIG ALA TH-LINE WAY BRACE ATTACHEENT	Traffic and the store of the	B-LINE TOLCO FIG ALA IN-LINE SWAY BRACE ATTACHMENT
	Fastener Orientation NFPA Type E Maximum Load 350 lbs (159 kg)	
	Diameter 1/2in.	
(17-4*)PS) (37-12*)PS)	Length <u>3-1/2in</u> .	FIG 4LA (1 ⁺ - 4 ⁺ (PS)
	Type Through-Bolt	
Brace Identification on Plans 4B Orientation of Brace Longitudinal		Brace Identification on Plan Orientation of Brace
Total Length Total Calculated Load 40ft (12.2 m) 470 lbs (217 kg)	Size and Type of Pipe	Total Length
40ft (12.2 m) 479 lbs (217 kg) 6ft (1.8 m) 16 lbs (7 kg)	2.5" Sch.40 Steel Pipe (63.5 mm) 1.5" Sch.40 Steel Pipe (38.1 mm)	40ft (12.2 m) 14ft (4.3 m)
15% 74 lbs (33.57 kg) Influence 569 lbs (258 kg)	Percentage added for Fittings and Sprinklers Total Adjusted Load of all pipe within Zone of I	15%
ce™ is subject to terms and conditions per the end user license agreement		arace™ is subject to terms and conditions per the
e™ Seismic Calculations		
	TOLBrace	e™ Seismic Calculatio
IDS Group 1 Peters Canyon Rd., Ste. 130	TOLBrace Project Address: MWDOC -SEISMIC RETROFIT	IDS Group 1 Peters Canyon Rd., Ste. 130
IDS Group	Project Address: MWDOC -SEISMIC RETROFIT 18700 WARD STREET	IDS Group
IDS Group 1 Peters Canyon Rd., Ste. 13(Irvine, CA 92606 Powering Business Worldwide	Project Address: MWDOC -SEISMIC RETROFIT 18700 WARD STREET FOUNTAIN VALLEY CA 92608	IDS Group 1 Peters Canyon Rd., Ste. 130 Irvine, CA 92606
IDS Group 1 Peters Canyon Rd., Ste. 13(Irvine, CA 92606 Fowering Business Worldwide	Project Address: MWDOC -SEISMIC RETROFIT 18700 WARD STREET FOUNTAIN VALLEY CA 92608 Job # Calculation	IDS Group 1 Peters Canyon Rd., Ste. 13(Irvine, CA 92606
IDS Group 1 Peters Canyon Rd., Ste. 13(Irvine, CA 92606 Besed on 2016 NFPA Pamphlet #13 TOLCO™ Brace Components	Project Address: MWDOC -SEISMIC RETROFIT 18700 WARD STREET FOUNTAIN VALLEY CA 92608 Job # Calculation Brace Information	IDS Group 1 Peters Canyon Rd., Ste. 13(Irvine, CA 92606 ons based on 2016 NFPA Pamphlet #13 TOLCO TM E
IDS Group 1 Peters Canyon Rd., Ste. 13(Irvine, CA 92606 Powering Business Worldwide as based on 2016 NFPA Pamphlet #13	Project Address: MWDOC -SEISMIC RETROFIT 18700 WARD STREET FOUNTAIN VALLEY CA 92608 Job # Calculation	IDS Group 1 Peters Canyon Rd., Ste. 13(Irvine, CA 92606
IDS Group 1 Peters Canyon Rd., Ste. 13(Irvine, CA 92606 ons based on 2016 NFPA Pamphlet #13 TOLCO™ Brace Components Fig. 1001 Clamp 1425 lbs (646 kg) Fig.980 Universal Swivel 1425 lbs (646 kg)	Project Address: MWDOC -SEISMIC RETROFIT 18700 WARD STREET FOUNTAIN VALLEY CA 92608 Job # Calculation Maximum Spacing 20' 0" (6.1 m)	IDS Group 1 Peters Canyon Rd., Ste. 13(Irvine, CA 92606 ons based on 2016 NFPA Pamphlet #13 TOLCO TM E TOLCO TM Component Fig
IDS Group 1 Peters Canyon Rd., Ste. 13(Irvine, CA 92606 assed on 2016 NFPA Pamphlet #13 TOLCO™ Brace Components TOLCO™ Component Fig. Number Adjusted Load Fig. 1001 Clamp 1425 lbs (646 kg) Fig.980 Universal Swivel 1425 lbs (646 kg) Fig.980 Universal Swivel 1425 lbs (646 kg)	Project Address: MWDOC -SEISMIC RETROFIT 18700 WARD STREET FOUNTAIN VALLEY CA 92608 Job # Calculation Brace Information Maximum Spacing 20' 0" (6.1 m) Maximum Brace Length 7' 0" (2.13 m) Bracing Material 1" Sch.40 Angle from Vertical 45° Min.	IDS Group 1 Peters Canyon Rd., Ste. 13(Irvine, CA 92606 ons based on 2016 NFPA Pamphlet #13 TOLCO™ E TOLCO™ Component Fig Fig. 1001 Clamp
IDS Group 1 Peters Canyon Rd., Ste. 13(Irvine, CA 92606 based on 2016 NFPA Pamphlet #13 TOLCO™ Brace Components TOLCO™ Component Fig. Number Adjusted Load Fig. 1001 Clamp 1425 lbs (646 kg) Fig.980 Universal Swivel 1425 lbs (646 kg) Calculation Based on CONCENTRIC Loading	Project Address: MWDOC -SEISMIC RETROFIT 18700 WARD STREET 18700 WARD STREET FOUNTAIN VALLEY CA 92608 Job # Calculation Brace Information Maximum Spacing 20' 0" (6.1 m) Maximum Brace Length 7' 0" (2.13 m) Bracing Material 1" Sch.40 Angle from Vertical 45° Min. Least Rad. of Gyration 0.42" (11 mm)	IDS Group 1 Peters Canyon Rd., Ste. 13(Irvine, CA 92606 ons based on 2016 NFPA Pamphlet #13 TOLCO™ E TOLCO™ Component Fig Fig. 1001 Clamp Fig.980 Universal Swivel *Calculation Based on 0 *Please Note: These calculations are fig
DS Group Peters Canyon Rd., Ste. 130 rvine, CA 92606 Med on 2016 NFPA Pamphlet #13 TOLCO™ Brace Components TOLCO™ Component Fig. Number Adjusted Load Fig. 1001 Clamp 1425 lbs (646 kg) Fig.980 Universal Swivel 1425 lbs (646 kg) *Calculation Based on CONCENTRIC Loading *Calculation Based on CONCENTRIC Loading *Desse Note: These calculations are for TOLCO™ components only. Use of any other components voids these calculations and the listing of the assembly. Assembly Detail TOLCO FIG. 980	Project Address: MWDOC -SEISMIC RETROFIT 18700 WARD STREET FOUNTAIN VALLEY CA 92608 Job # Calculation Brace Information Maximum Spacing 20' 0" (6.1 m) Maximum Brace Length 7' 0" (2.13 m) Bracing Material 1" Sch.40 Angle from Vertical 45° Min. Least Rad. of Gyration 0.42" (11 mm) L/R Value 200	IDS Group 1 Peters Canyon Rd., Ste. 13(Irvine, CA 92606 ons based on 2016 NFPA Pamphlet #13 TOLCO™ E TOLCO™ Component Fig Fig. 1001 Clamp Fig.980 Universal Swivel *Calculation Based on 0 *Please Note: These calculations are for other components voids these calculations are for the components voids the calc
S Group Peters Canyon Rd., Ste. 13C ine, CA 92606 on 2016 NFPA Pamphlet #13 DECOTM Brace Components OLCO™ Component Fig. Number Adjusted Load ig. 1001 Clamp 1425 lbs (646 kg) ig.980 Universal Swivel 1425 lbs (646 kg) ^C Calculation Based on CONCENTRIC Loading Pease Note: These calculations are for TOLCO™ components only. Use of any other components voids these calculations and the listing of the assembly. Assembly Detail UNIVERSAL SWAY BRACE ATTACHMENT	Project Address: MWDOC -SEISMIC RETROFIT 18700 WARD STREET 18700 WARD STREET FOUNTAIN VALLEY CA 92608 Job # Calculation Brace Information Maximum Spacing 20' 0" (6.1 m) Maximum Brace Length 7' 0" (2.13 m) Bracing Material 1" Sch.40 Angle from Vertical 45° Min. Least Rad. of Gyration 0.42" (11 mm)	IDS Group 1 Peters Canyon Rd., Ste. 13(Irvine, CA 92606 ons based on 2016 NFPA Pamphlet #13 TOLCO™ E TOLCO™ Component Fig Fig. 1001 Clamp Fig.980 Universal Swivel *Calculation Based on 0 *Please Note: These calculations are for other components voids these calculations are for the components voids the calculations are for the components void
S Group Peters Canyon Rd., Ste. 130 ine, CA 92606 or 2016 NFPA Pamphlet #13 TOLCO TM Component Fig. Number Adjusted Load ig. 1001 Clamp 1425 lbs (646 kg) ig.980 Universal Swivel 1425 lbs (646 kg) Calculation Based on CONCENTRIC Loading Pease Note: These calculations are for TOLCO™ components only. Use of any other components voids these calculations and the listing of the assembly. Assembly Detail TOLCO FIG. 980 UNIVERSAL SWAY BRACE	Project Address: MWDOC -SEISMIC RETROFIT 18700 WARD STREET FOUNTAIN VALLEY CA 92608 Job # Calculation Bracce Information Maximum Spacing 20' 0" (6.1 m) Maximum Brace Length 7' 0" (2.13 m) Bracing Material 1" Sch.40 Angle from Vertical 45° Min. Least Rad. of Gyration 0.42" (11 mm) L/R Value 200 Max Horizontal Load 1310 lbs (594 kg) Force Factor (Cp) 0.73	IDS Group 1 Peters Canyon Rd., Ste. 13(Irvine, CA 92606 ons based on 2016 NFPA Pamphlet #13 TOLCO™ E TOLCO™ Component Fig Fig. 1001 Clamp Fig.980 Universal Swivel *Calculation Based on 0 *Please Note: These calculations are for other components voids these calculations are for the components voids the calc
DS Group Peters Canyon Rd., Ste. 13(rvine, CA 92606 and on 2016 NFPA Pamphlet #13 TOLCO™ Brace Components Mage Adjusted Load Fig. 1001 Clamp 1425 lbs (646 kg) Fig.980 Universal Swivel 1425 lbs (646 kg) *Calculation Based on CONCENTRIC Loading *Calculation Based on CONCENTRIC Loading *Dease Note: These calculations are for TOLCO™ components only. Use of any other components voids these calculations and the listing of the assembly. Assembly Detail TOLCO FIG. 980- UNIVERSAL SWAY BRACE ATTACHMENT	Project Address: MWDOC -SEISMIC RETROFIT 18700 WARD STREET FOUNTAIN VALLEY CA 92608 Job # Calculation Maximum Spacing 20' 0" (6.1 m) Maximum Brace Length 7' 0" (2.13 m) Bracing Material 1" Sch.40 Angle from Vertical 45° Min. Least Rad. of Gyration 0.42" (11 mm) L/R Value 200 Max Horizontal Load 1310 lbs (594 kg) Force Factor (Cp) 0.73	IDS Group 1 Peters Canyon Rd., Ste. 13(Irvine, CA 92606 ons based on 2016 NFPA Pamphlet #13 TOLCO™ E TOLCO™ Component Fig Fig. 1001 Clamp Fig.980 Universal Swivel *Calculation Based on 0 *Please Note: These calculations are for other components voids these calculations are for the components voids the calc
IDS Group 1 Peters Canyon Rd., Ste. 13(Irvine, CA 92606 ed on 2016 NFPA Pamphlet #13 EDECOTM Brace Components TOLCO™ Component Fig. Number Adjusted Load Fig. 1001 Clamp 1425 lbs (646 kg) Fig.980 Universal Swivel 1425 lbs (646 kg) *Calculation Based on CONCENTRIC Loading *Calculation Based on CONCENTRIC Loading *Calculation Based on CONCENTRIC Loading *Calculation Based on CONCENTRIC Loading *Calculation Based on CONCENTRIC Loading *Dease Note: These calculations are for TOLCO™ components only. Use of any other components voids these calculations and the listing of the assembly. DINIVERSAL SWAY BRACE ATTACHMENT	Project Address: MWDOC - SEISMIC RETROFIT 18700 WARD STREET FOUNTAIN VALLEY CA 92608 Job # Calculation Brace Information Maximum Spacing 20' 0" (6.1 m) Maximum Brace Length 7' 0" (2.13 m) Bracing Material 1" Sch.40 Angle from Vertical 45° Min. Least Rad. of Gyration 0.42" (11 mm) L/R Value 200 Max Horizontal Load 1310 lbs (594 kg) Force Factor (Cp) 0.73	IDS Group 1 Peters Canyon Rd., Ste. 13(Irvine, CA 92606 ons based on 2016 NFPA Pamphlet #13 TOLCO™ E TOLCO™ Component Fig Fig. 1001 Clamp Fig.980 Universal Swivel *Calculation Based on 0 *Please Note: These calculations are for other components voids these calculations are for the components voids the calc
IDS Group 1 Peters Canyon Rd., Ste. 13(Irvine, CA 92606 ed on 2016 NFPA Pamphlet #13 TOLCO™ Brace Components Main and Adjusted Load Fig. 1001 Clamp 1425 lbs (646 kg) Fig.980 Universal Swivel 1425 lbs (646 kg) Calculation Based on CONCENTRIC Loading *Calculation Based on CONCENTRIC Loading *Calculation Based on CONCENTRIC Loading *Calculation Based on CONCENTRIC Loading *Desembly Detail DUNIVERSAL SWAY BRACE ATTACHMENT	Project Address: MWDOC -SEISMIC RETROFIT 18700 WARD STREET FOUNTAIN VALLEY CA 92608 Job # Catculation Brace Information Maximum Spacing 20' 0" (6.1 m) Maximum Brace Length 7' 0" (2.13 m) Bracing Material 1" Sch.40 Angle from Vertical 45° Min. Least Rad. of Gyration 0.42" (11 mm) L/R Value 200 Max Horizontal Load 1310 lbs (594 kg) Force Factor (Cp) 0.73 Fastemer Orientation NFPA Type E Maximum Load 230 lbs (104 kg)	IDS Group 1 Peters Canyon Rd., Ste. 13(Irvine, CA 92606 ons based on 2016 NFPA Pamphlet #13 TOLCO TM Component Fig Fig. 1001 Clamp Fig.980 Universal Swivel *Calculation Based on 0 *Please Note: These calculations are for other components voids these calculations are for the components voids the calculations
A Group teters Canyon Rd., Ste. 13(ine, CA 92606 Protection of the second of th	Project Address: MWDOC -SEISMIC RETROFIT 18700 WARD STREET FOUNTAIN VALLEY CA 92608 Job # Catculation Brace Information Maximum Spacing 20' 0" (6.1 m) Maximum Brace Length 7' 0" (2.13 m) Bracing Material 1" Sch.40 Angle from Vertical 45° Min. Least Rad. of Gyration 0.42" (11 mm) L/R Value 200 Max Horizontal Load 1310 lbs (594 kg) Force Factor (Cp) 0.73 Fastener Orientation NFPA Type E Maximum Load 230 lbs (104 kg) Diameter 1/2in.	IDS Group 1 Peters Canyon Rd., Ste. 13(Irvine, CA 92606 ons based on 2016 NFPA Pamphlet #13 TOLCO™ E TOLCO™ Component Fig Fig. 1001 Clamp Fig.980 Universal Swivel *Calculation Based on 0 *Please Note: These calculations are for other components voids these calculations are for the components voids the calc
DS Group Peters Canyon Rd., Ste. 13(rvine, CA 92606 d on 2016 NFPA Pamphlet #13	Project Address: MWDOC -SEISMIC RETROFIT 18700 WARD STREET FOUNTAIN VALLEY CA 92608 Job # Catculation Brace Information Maximum Spacing 20' 0" (6.1 m) Maximum Brace Length 7' 0" (2.13 m) Bracing Material 1" Sch.40 Angle from Vertical 45° Min. Least Rad. of Gyration 0.42" (11 mm) L/R Value 200 Max Horizontal Load 1310 lbs (594 kg) Force Factor (Cp) 0.73 Fastemer Orientation NFPA Type E Maximum Load 230 lbs (104 kg) Diameter 1/2in. Length 1-1/2in.	IDS Group 1 Peters Canyon Rd., Ste. 13(Irvine, CA 92606 ons based on 2016 NFPA Pamphlet #13 TOLCO TM Component Fig Fig. 1001 Clamp Fig.980 Universal Swivel *Calculation Based on 0 *Please Note: These calculations are for other components voids these
S Group Peters Canyon Rd., Ste. 138 ine, CA 92606	Project Address: MWDOC -SEISMIC RETROFIT 18700 WARD STREET FOUNTAIN VALLEY CA 92608 Job # Cateulative Brace Information Maximum Spacing 20' 0" (6.1 m) Maximum Brace Length 7' 0" (2.13 m) Bracing Material 1" Sch.40 Angle from Vertical 45° Min. Least Rad. of Gyration 0.42" (11 mm) L/R Value 200 Max Horizontal Load 1310 lbs (594 kg) Force Factor (Cp) 0.73 Fastener Orientation NFPA Type E Maximum Load 230 lbs (104 kg) Diameter 1/2in. Length 1-1/2in.	IDS Group 1 Peters Canyon Rd., Ste. 13(Irvine, CA 92606 ons based on 2016 NFPA Pamphlet #13 TOLCO TM Component Fig Fig. 1001 Clamp Fig.980 Universal Swivel *Calculation Based on 0 *Please Note: These calculations are for other components voids these calculations are for Other components voids these calculations are for the components voids the c
B Group ters Canyon Rd., Ste. 137 ine, CA 32606 TO 2016 NFPA Pamphlet #13 DICO™ Brace Components DICO™ Component Fig. Number Adjusted Load g. 1001 Clamp 1425 lbs (646 kg) g.980 Universal Swivel 1425 lbs (646 kg) Calculation Based on CONCENTRIC Loading lease Note: These calculations are for TOLCO™ components only. Use of any other components voids these calculations and the listing of the assembly. STEEL PIPE TOLCO FIG. 1001 FAST CLAMP	Project Address: MWDOC -SEISMIC RETROFIT 18700 WARD STREET FOUNTAIN VALLEY CA 92608 Job # Catculation Brace Information Maximum Spacing 20' 0" (6.1 m) Maximum Brace Length 7' 0" (2.13 m) Bracing Material 1" Sch.40 Angle from Vertical 45° Min. Least Rad. of Gyration 0.42" (11 mm) L/R Value 200 Max Horizontal Load 1310 lbs (594 kg) Force Factor (Cp) 0.73 Fastemer Orientation NFPA Type E Maximum Load 230 lbs (104 kg) Diameter 1/2in. Length 1-1/2in.	IDS Group 1 Peters Canyon Rd., Ste. 13(Irvine, CA 92606 Does based on 2016 NFPA Pamphlet #13 TOLCOTM Component Fig Fig. 1001 Clamp Fig.980 Universal Swivel *Calculation Based on 0 *Please Note: These calculations are for other components voids these calculations are for TOLCO FIG. 1001 FAST CLAMP
Stroup Peters Canyon Rd., Ste. 133 ine, CA 92606 on 2016 NFPA Pamphlet #13 DECOMPONENTS OLICO TM Component Fig. Number Adjusted Load ig. 1001 Clamp 1425 lbs (646 kg) ig. 980 Universal Swivel 1425 lbs (646 kg) Calculation Based on CONCENTRIC Loading Pease Note: These calculations are for TOLCO™ components only. Use of any ather components voids these calculations are for TOLCO™ components only. Use of any ather components voids these calculations are for TOLCO™ components only. Use of any ather components voids these calculations are for TOLCO™ components only. Use of any ather components voids these calculations are for TOLCO™ components only. Use of any ather components voids these calculations are for TOLCO™ components only. Use of any ather components voids these calculations are for TOLCO™ components only. Use of any ather components voids these calculations are for TOLCO™ components only. Use of any ather components voids these calculations are for TOLCO™ components only. Use of any ather components voids these calculations are for TOLCO™ components only. Use of any ather components voids these calculations are for TOLCO™ components only. Use of any ather components only. The component of the components only. The component of the c	Project Address: MWDOC -SEISMIC RETROFIT 18700 WARD STREET FOUNTAIN VALLEY CA 92608 Job # Catculation Brace Information Maximum Spacing 20' 0" (6.1 m) Maximum Brace Length 7' 0" (2.13 m) Bracing Material 1" Sch.40 Angle from Vertical 45° Min. Least Rad. of Gyration 0.42" (11 mm) L/R Value 200 Max Horizontal Load 1310 lbs (594 kg) Force Factor (Cp) 0.73 Fastener Orientation Fastener Orientation NFPA Type E Maximum Load 230 lbs (104 kg) Diameter 1/2in. Length 1-1/2in. Type Through-Bolt	IDS Group 1 Peters Canyon Rd., Ste. 13(Irvine, CA 92606 ons based on 2016 NFPA Pamphlet #13 TOLCO TM Component Fig Fig. 1001 Clamp Fig.980 Universal Swivel *Calculation Based on 0 *Please Note: These calculations are for other components voids these calculations are for the components voids these calculations are for the components voids these calculations are for TOLCO FIG. 1001 FAST CLAMP TOLCO FIG. 1001 FAST CLAMP Total Length
DS Group Peters Canyon Rd., Ste. 130 rvine, CA 92506 d on 2016 NFPA Pamphlet #13	Project Address: MWDOC -SEISMIC RETROFIT 18700 WARD STREET FOUNTAIN VALLEY CA 92608 Job # Catculation Brace Information Maximum Spacing 20' 0" (6.1 m) Maximum Brace Length 7' 0" (2.13 m) Bracing Material 1" Sch.40 Angle from Vertical 45° Min. Least Rad. of Gyration 0.42" (11 mm) L/R Value 200 Max Horizontal Load 1310 lbs (594 kg) Force Factor (Cp) 0.73 Fastener Orientation Fastener Orientation NFPA Type E Maximum Load 230 lbs (104 kg) Diameter 1/2in. Length 1-1/2in. Type Through-Bolt	IDS Group 1 Peters Canyon Rd., Ste. 13(Irvine, CA 92606 Dons based on 2016 NFPA Pamphlet #13 TOLCO TM Component Fig Fig. 1001 Clamp Fig.980 Universal Swivel *Calculation Based on 0 *Please Note: These calculations are for other components voids these calculations are for DUNIVERSAL SA
IDS Group 1 Peters Canyon Rd., Ste. 131 Irvine, CA 92806 ns based on 2016 MFPA Pamphlet #13 TOLCO TM Component Fig. Number Adjusted Load Fig. 1001 Clamp 1425 los (646 kg) Fig.980 Universal Swivel 1425 los (646 kg) "Please Note: These calculations and the listing of the assembly. Calculation Based on CONCENTRIC Loading "Please Note: These calculations and the listing of the assembly. INIVERSAL SWAY BRACE ATTACHMENT STEEL PIPE TOLCO FIG. 1001 FAST CLAMP ATTACHMENT STEEL PIPE TOLCO FIG. 1001 FAST CLAMP Attraction on Plans 4A Crientation on Brace Lateral	Project Address: MWDOC -SEISMIC RETROFIT 18700 WARD STREET FOUNTAIN VALLEY CA 92608 Job # Catculation Brace Information Maximum Spacing 20' 0" (6.1 m) Maximum Brace Length 7' 0" (2.13 m) Bracing Material 1" Sch.40 Angle from Vertical 45° Min. Least Rad. of Gyration 0.42" (11 mm) L/R Value 200 Max Horizontal Load 1310 lbs (594 kg) Force Factor (Cp) 0.73 Fastener Information MEPA Type E Maximum Load 230 lbs (104 kg) Diameter 1/2in. Length 1-1/2in. Type Through-Bolt	IDS Group 1 Peters Canyon Rd., Ste. 13(Irvine, CA 92606 ons based on 2016 NFPA Pamphlet #13 TOLCO TM Component Fig Fig. 1001 Clamp Fig.980 Universal Swivel *Calculation Based on 0 *Please Note: These calculations are for other components voids these calculations are for ther components voids these calculations are for the components voids these calculations are for for the components voids these calculations are for the components voids the components v
IDS Group 1 Peters Canyon Rd., Ste. 137 Irvine, CA 92806 Internet CA 92806 Internet CA 92800 Internet CA 92807 Internet CA 92806 Internet CA 92807 Internet CA 92806 Internet CA 92808 Internet CA 92806 Internet CA 92808 Internet CA 92808 Internet CA 92808 Internet CA 92808 <td>Project Address: MWDOC -SEISMIC RETROFIT 18700 WARD STREET FOUNTAIN VALLEY CA 92608 Job # Catculation Brace Information Maximum Spacing 20' 0" (6.1 m) Maximum Brace Length 7' 0" (2.13 m) Bracing Material 1" Sch.40 Angle from Vertical 45° Min. Least Rad. of Gyration 0.42" (11 mm) L/R Value 200 Max Horizontal Load 1310 lbs (594 kg) Force Factor (Cp) 0.73 Fastener Information MEPA Type E Maximum Load 230 lbs (104 kg) Diameter 1/2in. Length 1-1/2in. Type Through-Bolt</td> <td>IDS Group 1 Peters Canyon Rd., Ste. 13(Irvine, CA 92606 ons based on 2016 NFPA Pamphlet #13 TOLCOTM Component Fig Fig. 1001 Clamp Fig.980 Universal Swivel *Calculation Based on 0 *Please Note: These calculations are for other components voids these calculations are for ther components voids these calculations are for the components voids these calculations are for for the components voids these calculations are for the components voids the components v</td>	Project Address: MWDOC -SEISMIC RETROFIT 18700 WARD STREET FOUNTAIN VALLEY CA 92608 Job # Catculation Brace Information Maximum Spacing 20' 0" (6.1 m) Maximum Brace Length 7' 0" (2.13 m) Bracing Material 1" Sch.40 Angle from Vertical 45° Min. Least Rad. of Gyration 0.42" (11 mm) L/R Value 200 Max Horizontal Load 1310 lbs (594 kg) Force Factor (Cp) 0.73 Fastener Information MEPA Type E Maximum Load 230 lbs (104 kg) Diameter 1/2in. Length 1-1/2in. Type Through-Bolt	IDS Group 1 Peters Canyon Rd., Ste. 13(Irvine, CA 92606 ons based on 2016 NFPA Pamphlet #13 TOLCO TM Component Fig Fig. 1001 Clamp Fig.980 Universal Swivel *Calculation Based on 0 *Please Note: These calculations are for other components voids these calculations are for ther components voids these calculations are for the components voids these calculations are for for the components voids these calculations are for the components voids the components v
IDE Group 1 Peters Canyon Rd., Ste. 131 Ivine, CA 92608 Internet Steed on 2016 NFPA Pamphlet #13 Internet Steed on CONCENTRIC Loading Internet Steed on Concentret Steed	Project Address: MWDOC -SEISMIC RETROFIT 18700 WARD STREET FOUNTAIN VALLEY CA 92608 Job # Catculation Brace Information Maximum Spacing 20' 0" (6.1 m) Maximum Brace Length 7' 0" (2.13 m) Bracing Material 1" Sch.40 Angle from Vertical 45° Min. Least Rad. of Gyration 0.42" (11 mm) L/R Value 200 Max Horizontal Load 1310 lbs (594 kg) Force Factor (Cp) 0.73 Fastener Information MEPA Type E Maximum Load 230 lbs (104 kg) Diameter 1/2in. Length 1-1/2in. Type Through-Bolt	IDS Group 1 Peters Canyon Rd., Ste. 13(Irvine, CA 92606 ons based on 2016 NFPA Pamphlet #13 TOLCO TM Component Fig Fig. 1001 Clamp Fig.980 Universal Swivel *Calculation Based on 0 *Please Note: These calculations are for other components voids these calculations are for Other components voids these calculations are for TOLCO FIG. 1001 FAST CLAMP TOLCO FIG. 1001 FAST CLAMP Brace Identification on Pla Orientation of Brace Total Length 20ft (6.1 m) 14ft (4.3 m)
IDS Group Invine, CA 92500 Image: Comparison of the property of	Project Address: MWDOC - SEISMIC RETROFIT 18700 WARD STREET FOUNTAIN VALLEY CA 92608 Job # Calculation Maximum Spacing 20' 0" (6.1 m) Maximum Brace Length 7' 0" (2.13 m) Bracing Material 1" Sch.40 Angle from Vertical 45° Min. Least Rad. of Gyration 0.42" (11 mm) L/R Value 200 Max Horizontal Load 1310 lbs (594 kg) Force Factor (Cp) 0.73 Fastemer Information Fastener Orientation NFPA Type E Maximum Load 230 lbs (104 kg) Diameter 1/2in. Length 1-1/2in. Type Through-Bolt	IDS Group 1 Peters Canyon Rd., Ste. 13(Irvine, CA 92606 ons based on 2016 NFPA Pamphlet #13 TOLCO TM Component Fig Fig. 1001 Clamp Fig.980 Universal Swivel *Calculation Based on 0 *Please Note: These calculations are for other components voids these calculations are for Other components voids these calculations are for TOLCO FIG. 1001 FAST CLAMP TOLCO FIG. 1001 FAST CLAMP Brace Identification on Pla Orientation of Brace Total Length 20ft (6.1 m) 14ft (4.3 m)
IDS Group 1 Paters Canyon Rd, Ste. 131 Ivine, CA 92608 aced on 2016 NFPA Pamphlet #13	Project Address: MWDOC - SEISMIC RETROFIT 18700 WARD STREET FOUNTAIN VALLEY CA 92608 Job # Calculation Maximum Spacing 20' 0" (6.1 m) Maximum Brace Length 7' 0" (2.13 m) Bracing Material 1" Sch.40 Angle from Vertical 45° Min. Least Rad. of Gyration 0.42" (11 mm) L/R Value 200 Max Horizontal Load 1310 lbs (594 kg) Force Factor (Cp) 0.73 Fastemer Information Fastener Orientation NFPA Type E Maximum Load 230 lbs (104 kg) Diameter 1/2in. Length 1-1/2in. Type Through-Bolt	IDS Group 1 Peters Canyon Rd., Ste. 13(Irvine, CA 92606 ons based on 2016 NFPA Pamphlet #13 TOLCO TM Component Fig Fig. 1001 Clamp Fig.980 Universal Swivel Calculation Based on 0 *Please Note: These calculations are for other components voids these calculations are for other components voids these calculations are for the components voids the components voids the c
A Group beters Canyon Rd., Ste. 130 ine, CA 92606 an 2016 NFPA Pamphlet #13 TOLCO [™] Oragonent Fig. Number Adjusted Load g. 1011 Clamp Also Iso (646 kg) g. 980 Universal Swivel 1425 lbs (646 kg) ¹ Calculation Based on CONCENTRIC Load Oragonents only. Use of any other components voids these calculations and the listing of the assembly. Tolcoo FIG. 1001 FAST CLAMP Total Length Total Calculated Load 2016 (5.1 m) 239 lbs (106 kg) 38f (2.4 m) 21 lbs (106 kg)	Project Address: MWDOC -SEISMIC RETROFIT 18700 WARD STREET FOUNTAIN VALLEY CA 92608 Job # Catcutation Maximum Spacing 20'0" (6.1 m) Maximum Brace Length 7'0" (2.13 m) Bracing Material 1" Sch.40 Angle from Vertical 45° Min. Least Rad. of Gyration 0.42" (11 mm) LR Value 200 Max Horizontal Load 1310 lbs (594 kg) Force Factor (Cp) 0.73 Fastemer Information Fastener Orientation NFPA Type E Maximum Load 230 lbs (104 kg) Diameter 1/2in. Length 1-1/2in. Type Through-Bolt Size and Type of Pipe 2.5" Sch.40 Steel Pipe (63.5 mm) 1.5" Sch.40 Steel Pipe (38.1 mm) 1.6" Sch.40 Steel Pipe (38.1 mm) Use of TOLI (TOLBrace** Version 8) Use of TOLI NOTE: 1. SWAY BRACE IS BASED ON A SHORT PERIOD Se=1.5	IDS Group 1 Peters Canyon Rd., Ste. 13(Irvine, CA 92606 ons based on 2016 NFPA Pamphlet #13 TOLCO™ Component Fig Fig. 1001 Clamp Fig.980 Universal Swivel °Calculation Based on 0 *Please Note: These calculations are for other components voids these calculations are for ther components voids these calculations are for the components voids the components voids the components voids the components voids the components
A group eters Canyon Rd., Ste. 132 me. CA 92606	Project Address: MWDOC -SEISMIC RETROFIT 18700 WARD STREET FOUNTAIN VALLEY CA 92608 Job # Calculation Maximum Spacing 20 0° (6.1 m) Maximum Brace Length 7' 0° (2.13 m) Bracing Material 1° Sch.40 Angle from Vertical 45° Min. Least Rad. of Gyration 0.42° (11 mm) Lik Value 200 Max Horizontal Load 1310 lbs (594 kg) Force Factor (Cp) 0.73 Fastemer Information Fastemer Information MEPA Type E Maximum Load 230 lbs (104 kg) Diameter 1/2in. Length 1-1/2in. Type Through-Bolt Size and Type of Pipe 2.5° Sch.40 Steel Pipe (38.1 mm) 1.5° Sch.40 Steel Pipe (38.1 mm) 1.5° Sch.40 Steel Pipe (38.1 mm) Use of TOLE Maxing added for Fittings and Sprinklers Total Adjusted Load of all pipe within Zone of Maxing By Use of TOLE	IDS Group 1 Peters Canyon Rd., Ste. 13(Irvine, CA 92606 ons based on 2016 NFPA Pamphlet #13 TOLCO™ Component Fig Fig. 1001 Clamp Fig.980 Universal Swivel °Calculation Based on 0 *Please Note: These calculations are for other components voids these calculations are for ther components voids these calculations are for the components voids the components voids the components voids the components voids the components

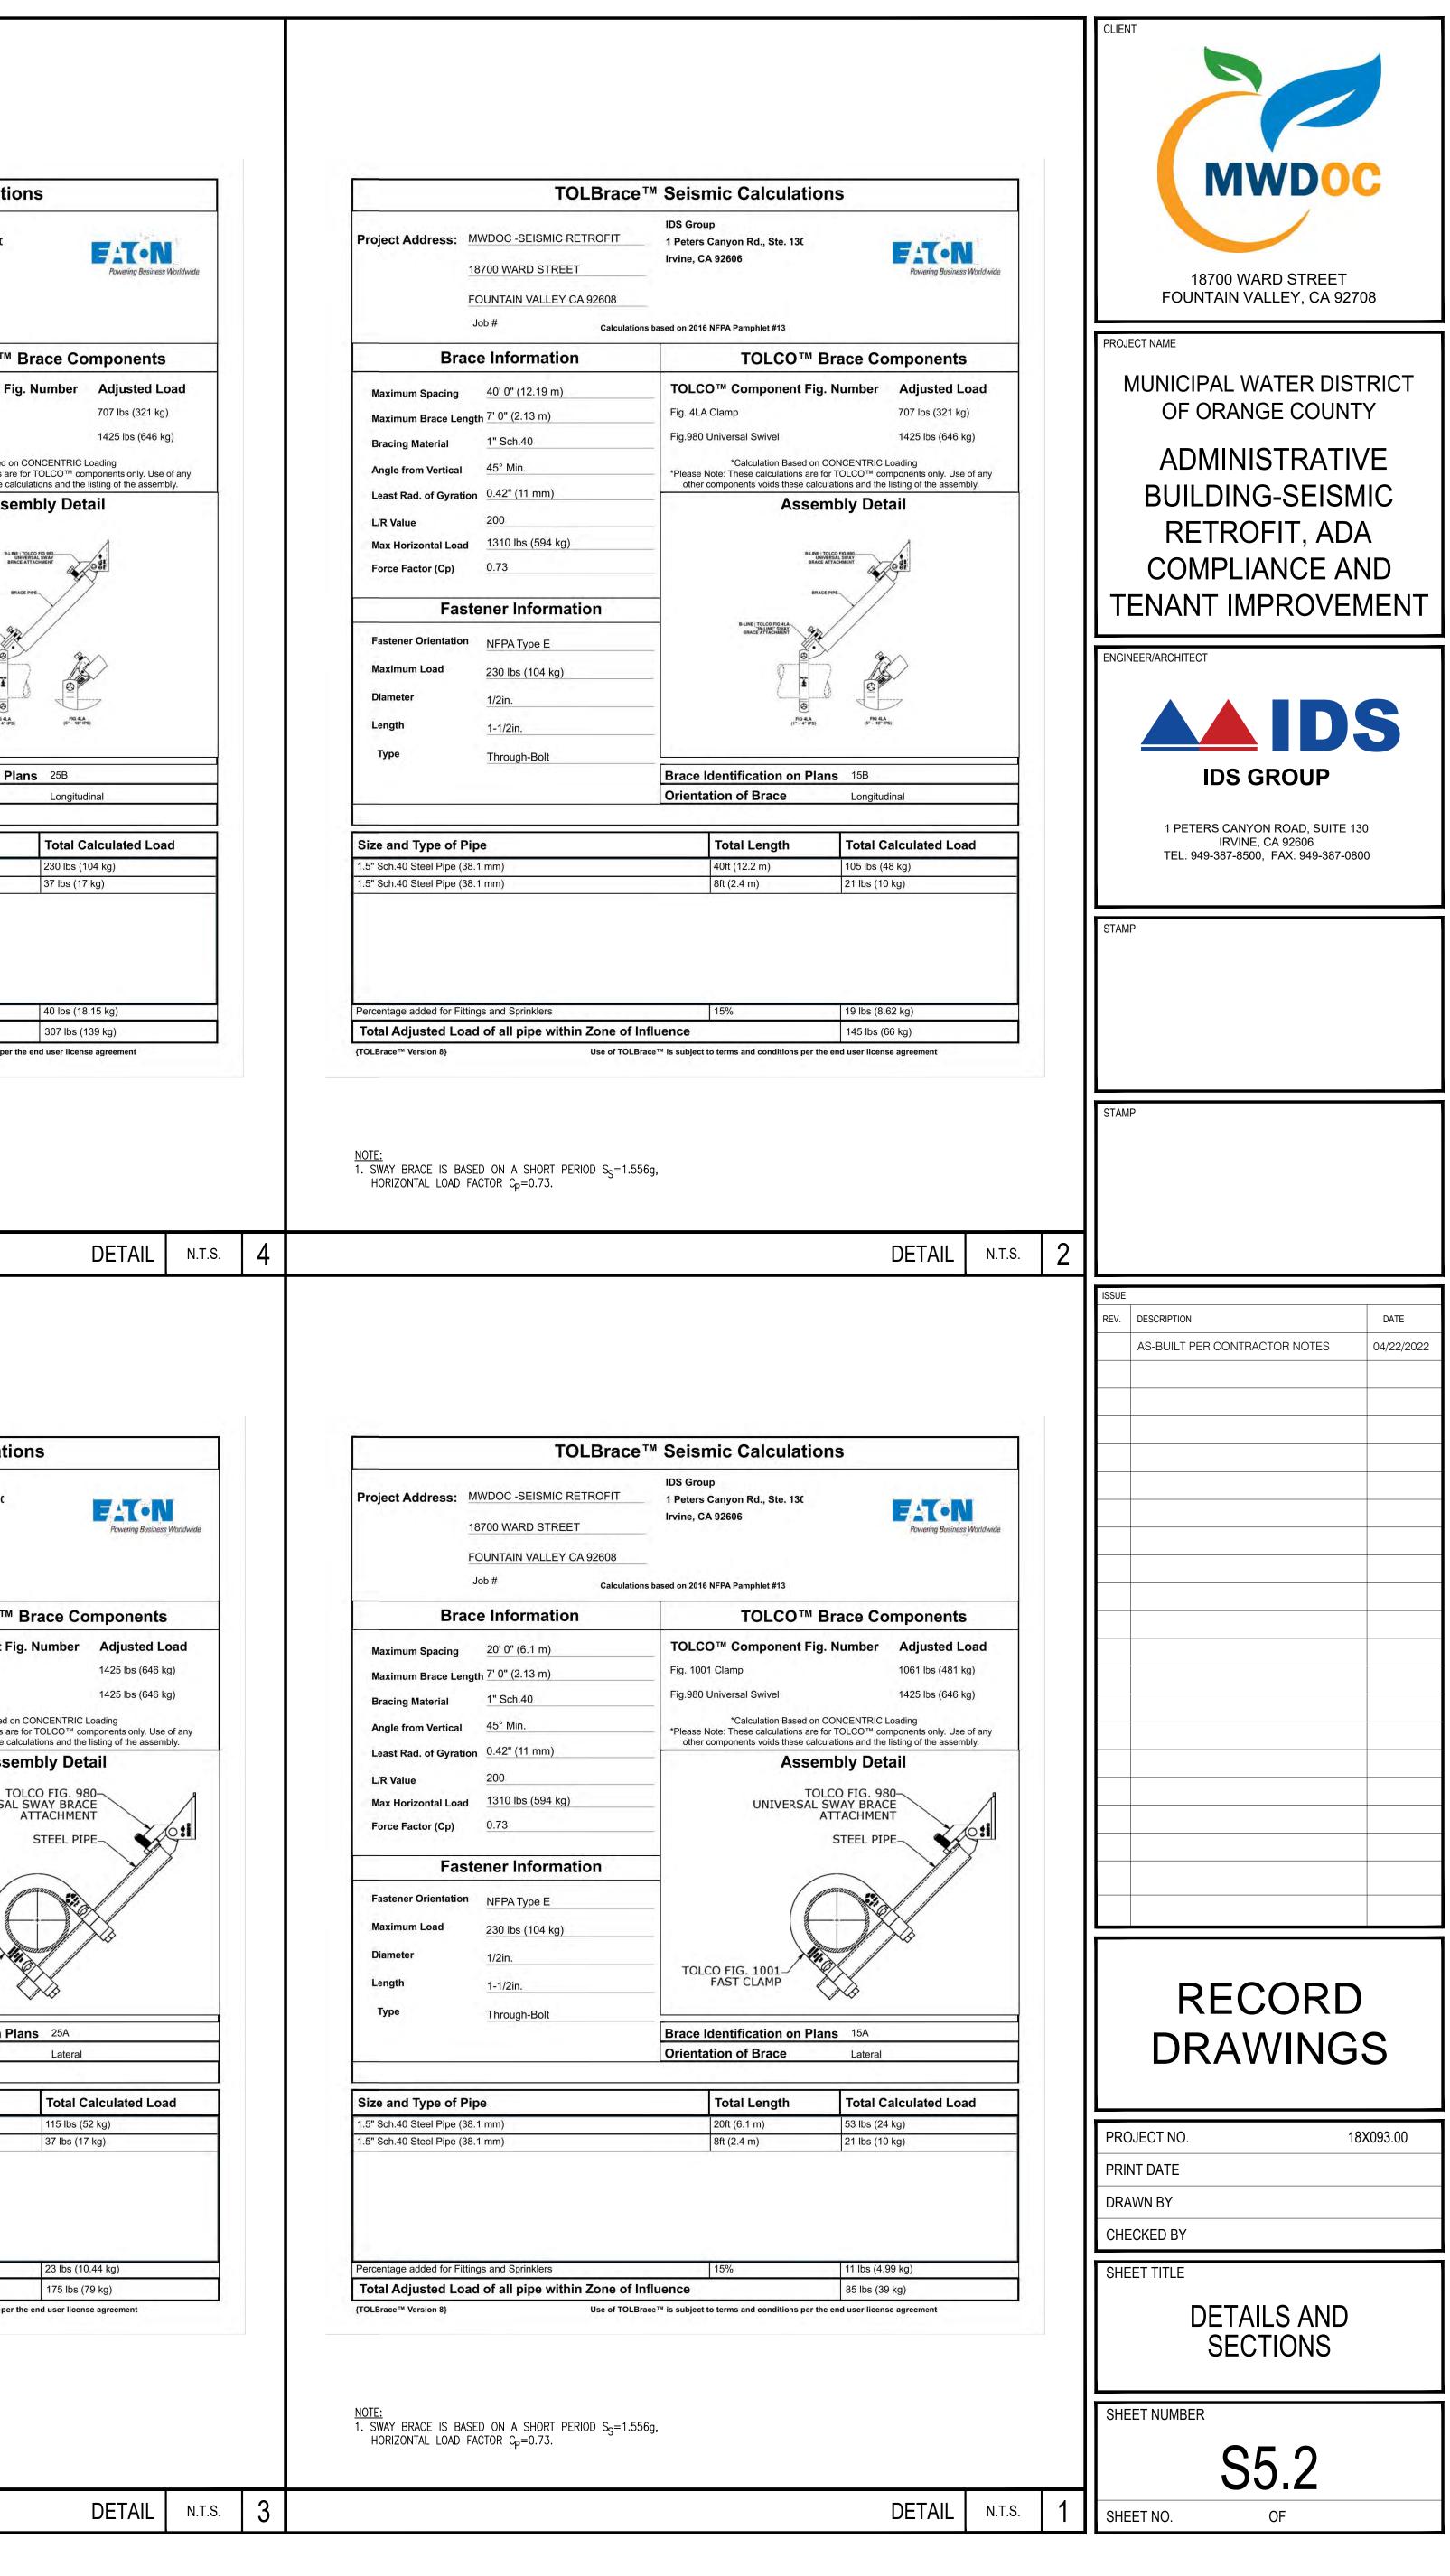

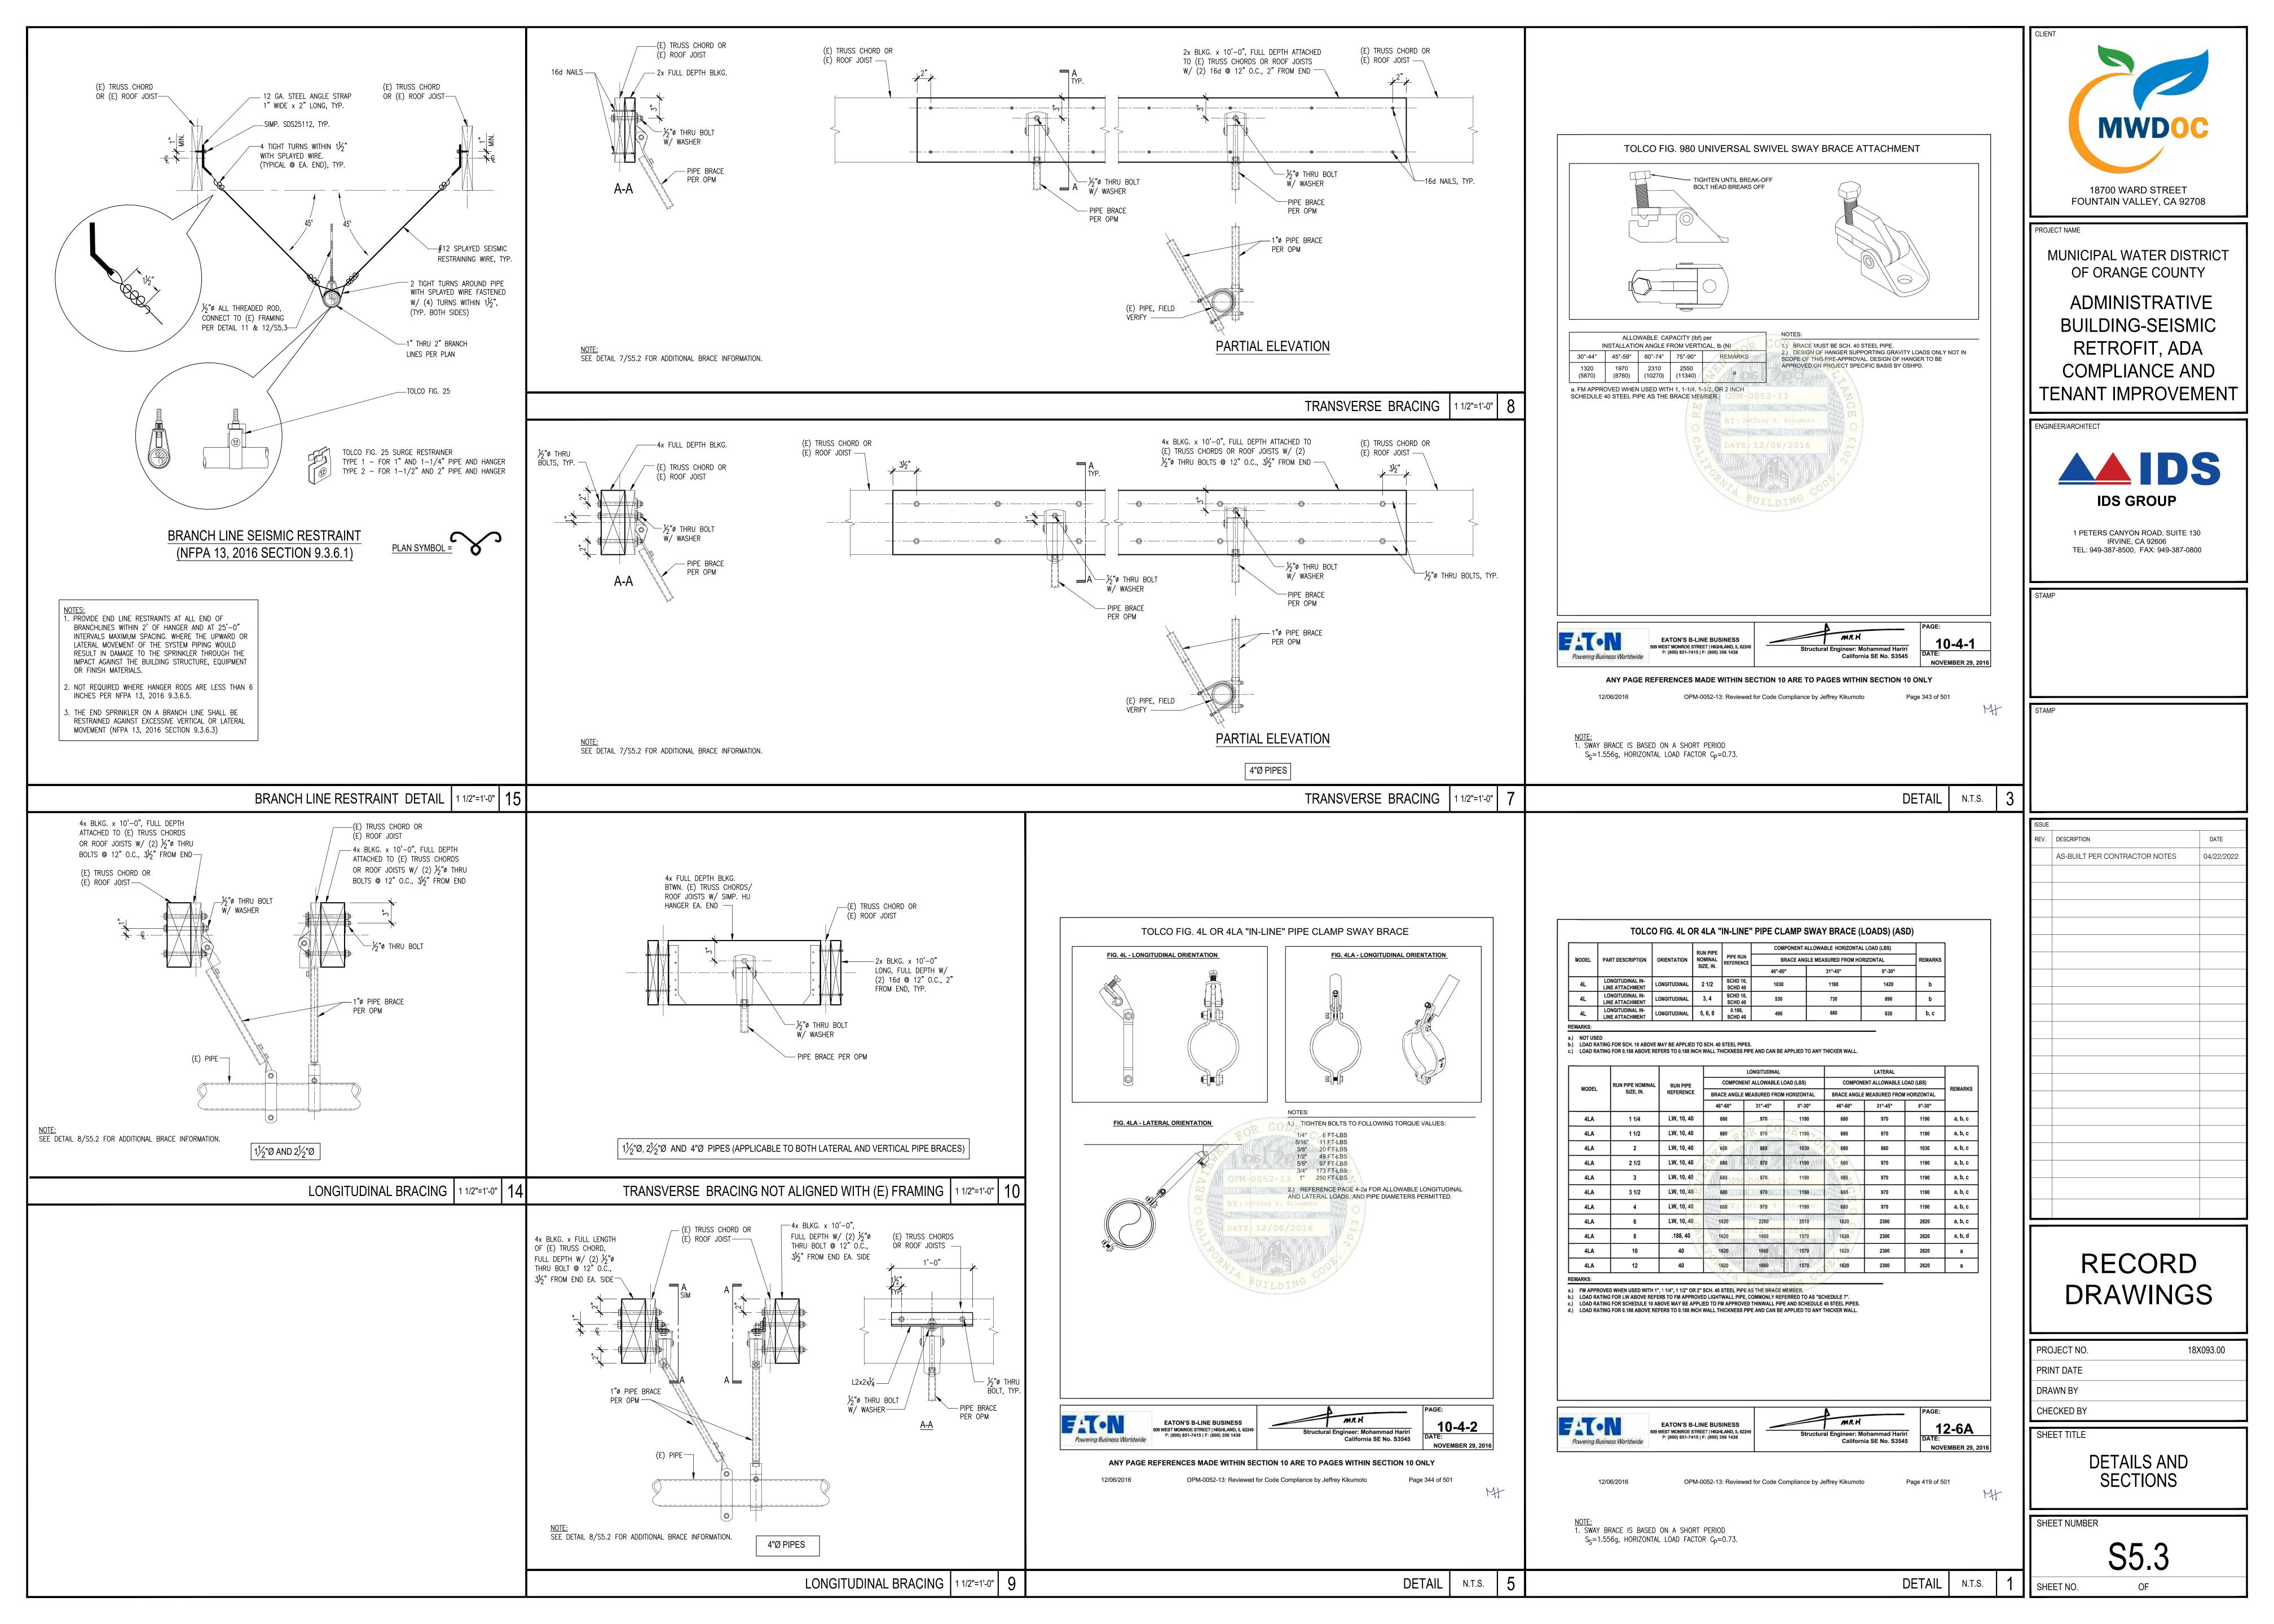

SPECIFICATIONS	ABBREVIAT	IONS
PART I - GENERAL	ABBR. / SYMBOL	DESCRIPTION
SCOPE: A. PROVIDE LABOR, MATERIAL, EQUIPMENT AND INCIDENTALS NECESSARY OR REQUIRED FOR THE COMPLETION,	AD	ACCESS DOOR
TESTING, INSPECTION AND ADJUSTING, TO PROVIDE OPERABLE MECHANICAL SYSTEMS COMPLETE IN ALL RESPECTS. B. INVESTIGATION OF CONDITIONS: EXAMINE THE CONTRACT DRAWINGS AND ALL AVAILABLE INFORMATION CONCERNING EXISTING INSTALLATION,	AFF	ABOVE FINISHED FLOOR
STRUCTURE, AND LOCAL CONDITIONS. VISIT THE SITE TO UNDERSTAND THE NATURE AND SCOPE OF ALL WORK TO BE PERFORMED. THE SUBMISSION OF A BID WILL BE TAKEN AS EVIDENCE THAT SUCH AN EXAMINATION HAS BEEN MADE	AI	ANALOG INPUT
AND ALL CONDITIONS HAVE BEEN CONSIDERED. C. DRAWINGS AND SPECIFICATIONS: EXAMINE AND BECOME FAMILIAR WITH ALL PROJECT DRAWINGS AND SPECIFICATIONS; AND COORDINATE THE	AO	ANALOG OUTPUT
MECHANICAL WORK ACCORDINGLY. MAKE REASONABLE MODIFICATIONS IN THE LAYOUT AND INSTALLATION AS NEEDED TO PREVENT CONFLICT WITH WORK OF OTHER TRADES AND FOR PROPER EXECUTION OF THE WORK,	AP	ACCESS PANEL
WITHOUT ADDITIONAL COST. D. INSTALLATION:	ARCH	ARCHITECTURAL
THE ENTIRE MECHANICAL INSTALLATION SHALL BE MADE IN A NEAT, WORKMANSHIP-LIKE, FINISHED AND SAFE MANNER. CONCEAL ALL PIPING IN FINISHED AREAS, UNLESS OTHERWISE NOTED. ALL MATERIALS AND INSTALLATIONS SHALL CONFORM TO THE LATEST PUBLISHED ASHRAE, SMACNA, NFPA, NEMA, AND NEC CODES. THE ENTIRE INSTALLATION	BAS	BUILDING AUTOMATION SYSTE
SHALL BE SUBJECT TO THE ARCHITECT'S APPROVAL. E. CODES, PERMITS AND FEES:	BDD	BACK DRAFT DAMPER
THE DRAWINGS AND SPECIFICATIONS TAKE PRECEDENCE WHEN THEY ARE MORE STRINGENT THAN CODES, ORDINANCES, STANDARDS AND STATUTES. CODES, ORDINANCES, STANDARDS AND STATUTES TAKE PRECEDENCE WHERE THEY ARE MORE STRINGENT THAN THE DRAWINGS AND SPECIFICATIONS. SECURE AND PAY FOR PERMITS,	BHP	BRAKE HORSEPOWER
TESTS, CERTIFICATES OF INSPECTION, AND ALL OTHER COSTS INCIDENTAL TO THE WORK. F. GUARANTEES:	BTUH	BTU PER HOUR
ALL WORK SHALL BE GUARANTEED TO BE FREE FROM DEFECTS IN MATERIAL AND WORKMANSHIP FOR A PERIOD OF ONE YEAR FROM DATE OF FINAL ACCEPTANCE OF THE WORK. REPLACE OR REPAIR DEFECTIVE MATERIALS OR REPAIR	СС	COOLING COIL
DEFECTIVE WORK AT NO ADDITIONAL COST. G. THIS CONTRACTOR SHALL SUBMIT FOR APPROVAL EIGHT (8) SETS OF SHOP DRAWINGS ON THE FOLLOWING: VAV UNITS, DIFFUSERS, REGISTERS AND GRILLES, INSULATION (DUCT AND PIPE), FLEXIBLE DUCT, AND THERMOSTATS. AND	CD	CEILING DIFFUSER
ANY OTHER ITEMS REQUESTED BY THE ARCHITECT.	CFM	CUBIC FEET PER MINUTE
PART II - PRODUCTS A. AIR DISTRIBUTION MATERIALS AND EQUIPMENT	CWS/R	COOLING WATER SUPPLY AND RETURN
 AIR DISTRIBUTION MATERIALS AND EQUIPMENT 1. ALL EQUIPMENT SHALL BE LABELED OR LISTED BY A RECOGNIZED APPROVAL AGENCY. 2. LOW PRESSURE DUCT WORK: SHALL BE G90 COATED GALVANIZED STEEL. DUCT CONSTRUCTION SHALL BE IN 	CTWS/R	COOLING TOWER WATER SUPPLY AND RETURN
ACCORDANCE WITH SMACNA CONSTRUCTION STANDARDS FOR LOW VELOCITY DUCT. TAPS SHALL BE THE 45° BRANCH ENTRY TYPE (NO SPIN-INS) WITH NORMAL BALANCE DAMPERS, WHERE SHOWN ON THE DRAWINGS.	CG	CEILING GRILLE
DUCT SHALL BE CLASS 1. 3. ALL EXHAUST DUCTWORK EXTENDING INTO OR THROUGH THE RETURN AIR PLENUM SHALL BE SEALED AIR TIGHT AT ALL JOINTS AND CONNECTIONS USING A LISTED LOW TO MEDIUM PRESSURE DUCT SEALANT. SEALANT SHALL BE	CNTRL	CONTROL
 INSTALLED PER MANUFACTURER'S RECOMMENDATIONS 4. EQUIPMENT CONCEALED ABOVE CEILINGS SHALL BE MARKED WITH COLORED ADHESIVE DOTS APPLIED TO THE 	CONN	CONNECTION
CEILING GRID USING DEFINING COLORS AS NOTED BELOW: a. SHUT OFF VALVES RED b. HUMDELEDO	CONT	CONTINUATION
b. HUMIDIFIERS GREEN c. AIR TERMINAL DEVICES BLUE d. SMOKE DETECTORS YELLOW	CR	CEILING REGISTER
 MANUAL VOLUME DAMPERS IN THE CEILING SPACE SHALL BE IDENTIFIED WITH A RED SURVEY RIBBON ATTACHED TO THE HANDLE. 	CSF	COMBINATION FIRE/SMOKE DAMPER
 DUCT INSULATION: ALL SUPPLY AND RETURN DUCTWORK SHALL BE INSULATED AS FOLLOWS: R-8 MIN. DUCT INSULATION (PROVIDE 2", 1-1/2 #) ON SUPPLY AND EXHAUST DUCTS. ALL JOINTS SEALED TO MEET UL 181A OR 181B TAPES AND MASTICS. INSTALLATION PER MANUFACTURER'S INSTRUCTIONS. 	DDC	
 FLEXIBLE DUCT: SHALL BE THERMAFLEX II TYPE MK-E OR EQUIVALENT, FOR LOW PRESSURE, FACTORY FABRICATED MATERIAL, WITH SPIRAL WIRE SUPPORT, MYLAR SHEATH, 1-1/2" THICK, 3/4 LB DENSITY BLANKET INSULATION AND 	DI	DIGITAL INPUT
VINYL JACKET. DUCT TO BE U.L. 181 LISTED, CLASS 1, AND IN COMPLIANCE WITH NFPA 90-A. INSTALL W/ MINIMUM NO. OF BENDS W/ A MIN. RADIUS OF 1-1/2 TIMES THE DUCT DIAMETER MEASURED FROM THE	DO	DISTRABULED DIGITAL CON
CENTERLINE, EXTEND STRAIGHT WHERE POSSIBLE AND LIMIT LENGTHS TO 5'-0" MAX. 8. GRILLES REGISTERS AND DIFFUSERS: PER BUILDING STANDARD OR AS SCHEDULED. ACCEPTABLE ALTERNATE MANUFACTURERS ARE KRUEGAR, CARNES, METAL-AIRE, AND PRICE.	Ø	(DIA) DIAMETER
PART III - EXECUTION	D	CONDENSATE DRAIN, DRAI
A. PROVIDE ALL LABOR, MATERIALS, EQUIPMENT AND SERVICES TO INSTALL A COMPLETE, OPERATING AND APPROVED	dP	PRESSURE DROP
MECHANICAL SYSTEM INCLUDING BUT NOT LIMITED TO THE FOLLOWING:	EA	EXHAUST AIR
OPENINGS, CLEARANCES, SPACE, ACCESS TO EQUIPMENT, ETC. 2. BALANCING AND ADJUSTING: SYSTEM START-UP, BALANCING TESTING AND ADJUSTING OF THE AFFECTED	EAD	EXHAUST AIR DAMPER
PORTIONS OF THE MECHANICAL SYSTEM SHALL BE THE RESPONSIBILITY OF AN INDEPENDENT THIRD PARTY APPROVED TESTING AND BALANCING CONTRACTOR. TESTING AND BALANCING CONTRACTOR SHALL BE AN AABC OR NEBB MEMBER. A COMPLETE BALANCING TEST REPORT SHALL BE SUBMITTED TO THE BUILDING	EAT	ENTERING AIR TEMPERATU
OWNER/ENGINEER. THE AIR SYSTEMS SHALL BE BALANCED TO WITHIN PLUS OR MINUS 2% OF THE QUANTITIES LISTED, AT 2" W.C., AND SHALL HAVE DUCT LEAKAGE NO GREATER THAN 1%. THE COST OF THE INDEPENDENT	EWT	ENTERING WATER TEMPERAT
TESTING AND BALANCING CONTRACTOR SHALL BE INCLUDED IN THE MECHANICAL CONTRACTOR BID. 3. CONTRACTOR SHALL BLOCK OFF ALL EXISTING SYSTEM DUCTWORK TO PREVENT CONSTRUCTION DUST AND	EDB	ENTERING DB TEMPERATU
DEBRIS FROM BEING RE-CIRCULATED IN THE EXISTING SYSTEM AND PREVENT DAMAGE TO THE AIR HANDLERS. CONTRACTOR MUST EITHER COMPLETELY BLOCK OFF DUCTWORK UNTIL FINAL CONNECTIONS ARE COMPLETED OR USE THROW AWAY CONSTRUCTION FILTERS ON THE DUCTWORK. CONTRACTOR SHALL ONLY USE THE BUILDING	EWB	ENTERING WB TEMPERATU
SYSTEM AT SUCH TIME THAT DUST AND DEBRIS ARE NOT PRESENT AND FOR THE PURPOSE OF TESTING AND BALANCING THE NEW TENANT SYSTEM. AFTER SYSTEM IS TESTED AND BALANCED CONTRACTOR SHALL PROVIDE	EMS	ENERGY MANAGEMENT SYSTE
AND INSTALL NEW CLEAN FILTERS IN THE AFFECTED ROOFTOP UNITS. 4. ACCURATE "AS-BUILT" DRAWINGS SHALL BE MAINTAINED DURING THE CONSTRUCTION 5. VERIEV WILLO IS DESPONDED FOR DEPARTS AND ASSOCIATED (TYPICAL FOR MED TRADES)	EF	EXHAUST FAN
 VERIFY WHO IS RESPONSIBLE FOR PERMITS AND ASSOCIATED (TYPICAL FOR MEP TRADES) CONTRACTOR SHALL MAINTAIN XXX(QUANTITY) OF PRINTS OF DRAWINGS AT WORK SITE. ROUTE PIPE AND DUCT SYSTEMS PARALLEL AND PERPENDICULAR TO THE BUILDING LINES. MOUNT AS CLOSE AS 		
POSSIBLE TO UNDERSIDE OF THE BUILDING STRUCTURE. 8. IF A CONFLICT OCCURS BETWEEN THE CONTRACT DRAWINGS AND THE SPECIFICATIONS, INDICATE THAT THE		
 SPECIFICATIONS OR MORE STRINGENT CONDITION SHALL GOVERN, UNLESS INSTRUCTED OTHERWISE. 9. CONTRACTOR SHALL BE RESPONSIBLE FOR THE REPAIR AND PATCHING OF DAMAGED ARCHITECTURAL COMPONENTS TO REMAIN DURING THE REMOVAL OF DESIGNATED SYSTEMS. 		
 PROVIDE OWNER WITH FIVE (5) COPIES OF THE MAINTENANCE AND OPERATION MANUALS, AND MANUFACTURES/SUPPLIERS ONE YEAR PARTS AND LABOR WARRANTY FOR ALL INSTALLED EQUIPMENT. 		

RIPTION	ABBR. / SYMBOL	DESCRIPTION	ABBR. / SYMBOL	DESCRIPTION
DOOR	EXH.	EXHAUST	OSA	OUTSIDE AIR
NISHED FLOOR	FM	FLOW METER	PD	PRESSURE DROP
NPUT	ENT	ENTERING	POC	POINT OF CONNECTION
DUTPUT	ESP	EXTERNAL STATIC PRESSURE	POD	POINT OF DEMOLITION
PANEL	°F	DEGREES FAHRENHEIT	RA	RETURN AIR
CTURAL	FC	FLEXIBLE CONNECTION	RAD	RETURN AIR DAMPER
AUTOMATION SYSTEM	FD	FIRE DAMPER	RAT	RETURN AIR TEMP.
AFT DAMPER	FLA	FULL LOAD AMPS	RG	RETURN GRILLE
DRSEPOWER	FPM	FEET PER MINUTE	RH	RELATIVE HUMIDITY
HOUR	GPM	GALLONS PER MINUTE	RPM	REVOLUTIONS PER MINUTE
COIL	Н	HEIGHT	SA	SUPPLY AIR
DIFFUSER	HP	HORSEPOWER	SAT	SUPPLY AIR TEMPERATURE
ET PER MINUTE	HWS/R	HEATING HOT WATER SUPPLY AND RETURN	SD	SMOKE DETECTOR
WATER SUPPLY JRN	HZ	HERTZ	SF	SUPPLY FAN
TOWER WATER	IN	INCHES	SG	SUPPLY GRILLE
ND RETURN GRILLE	KW	KILOWATT	SP	STATIC PRESSURE
	(L)	LINED DUCTWORK	SPEC	SPECIFICATION
TION	LB	POUND, WEIGHT	SQ FT	SQUARE FOOT
ATION	LAT	LEAVING AIR TEMPERATURE	S/S	START/ STOP
REGISTER	LWT	LEAVING WATER TEMPERATURE	ST	SOUND TRAP
TION FIRE/SMOKE	LVG	LEAVING	SZVAV	SINGLE ZONE VARIABLE AIR
	LWB	LEAVING WB TEMPERATURE	TS	VOLUME TEMPERATURE SENSOR
NPUT	MAX	MAXIMUM	TT	TEMPERATURE TRANSMITTER
	MCC	MOTOR CONTROL CENTER	TSP	TOTAL STATIC PRESSURE
AMETER	MIN	MINIMUM	TDH	TOTAL DYNAMIC HEAD
SATE DRAIN, DRAIN	NAI	NETWORK ANALOG INPUT	T OR TEMP	TEMPERATURE
E DROP	NAO	NETWORK ANALOG OUTPUT	ТҮР	TYPICAL
AIR	NDI	NETWORK DIGITAL INPUT	VD	VOLUME DAMPER
AIR DAMPER	NDO	NETWORK DIGITAL OUTPUT	VD	VOLUME DAMPER
G AIR TEMPERATURE	NC	NORMALLY CLOSED	VAV	VARIABLE AIR VOLUME
WATER TEMPERATURE	NO	NORMALLY OPEN	WB	WET BULB
G DB TEMPERATURE	SS	STAINLESS STEEL		
G WB TEMPERATURE	NO.	NUMBER		
ANAGEMENT SYSTEM	OAD	OUTSIDE AIR DAMPER		
	OPER WT	OPERATING WEIGHT		
FAN	OPNG	OPENING		

MECHANICAL	LEGEND		
ABBR. / SYMBOL	DESCRIPTION	ABBR. / SYMBOL	DESCRIPTION
	SQUARE OR RECTANGULAR DUCT	XX XX	EQUIPMENT DESIGNATION & NUMBER
٤	ROUND DUCT	1	NOTE DESIGNATION
	FIRE DAMPER	P.O.C.	POINT OF CONNECTION
	COMBINATION FIRE/SMOKE DAMPER	P.O.D.	POINT OF DISCONNECT
	DUCT WITH MANUAL VOLUME DAMPER	_y/c	UNDERCUT DOOR
UD VD	VOLUME DAMPER		DOOR LOUVER
	DUCT WITH ACOUSTICAL LINER-SIZES	CHWS	CHILLED WATER SUPPLY
• (L-X) •	GIVEN ARE SHEET METAL OUTSIDE DIMENSIONS. (X) IS LINER THICKNESS IN INCHES. IF X IS NOT SHOWN, REFER TO	CHWR	CHILLED WATER RETURN
	NOTES.	——HWS ——	HOT WATER SUPPLY
	INCLINE RISE OR DROP IN DIRECTION OF AIR FLOW	——HWR ——	HOT WATER RETURN
	FLEXIBLE DUCT - DOUBLE LINE	T	ROOM THERMOSTAT
(-cs	FLEXIBLE DUCT - SINGLE LINE	SD	SMOKE DETECTOR
	DIRECTION OF FLOW	Н	ROOM HUMIDISTAT
	TRANSITION	OS	OCCUPANCY SENSOR
	VAV (VAV-NO.)	LS	LIGHTING CONTROL SWITCH
	SIDEWALL REGISTER	LC	LIGHTING CONTROLLER
	SUPPLY, RETURN, EXHAUST UP	TC	TIME DELAY
	SUPPLY, RETURN, EXHAUST DOWN	DS	DAYLIGHT SENSOR
	CEILING REGISTER	DM	DIMMER
	EXHAUST REGISTER	LR	LIGHTING CONTROL RELAY
	CEILING DIFFUSER	(CO)	CARBON MONOXIDE SENSOR
	ROUND DUCT UP AND DOWN	603	CARBON DIOXIDE SENSOR
\square	CEILING ACCESS PANEL	TS	TEMPERATURE SENSOR
	DUCT WITH TURNING VANES	PS x	POWER SUPPLY. "X" IS VOLTAGE
	ΓΙΟΝΙς		

INSTRUCTIONS

- BEFORE SUBMITTING BIDS MECHANICAL AND ELECTRICAL CONTRACTORS SHALL COMPARE THE CONSTRUCTION DOCUMENTS SET WITH EXISTING AS BUILT PLANS TO VERIFY EXACT SCOPE OF WORK AND BILL OF MATERIALS. NO ADDED CHANGE ORDERS WILL BE GRANTED TO CONTRACTOR FOR MISSING ANY PART OF THE SCOPE OF WORK
- PRESENTED ON THE CONSTRUCTION DOCUMENTS SET. MECHANICAL CONTRACTOR SHALL TEST THE WHOLE NEW HVAC SYSTEM AND PROVIDE ONE YEAR LABOR AND MATERIAL GUARANTEE FOR ONE YEAR AS A SEPARATE BID TO OWNER FOR APPROVAL. REFLECTED CEILING PLAN IS 8'-5" FEET HIGH. CONTRACTOR SHALL COORDINATE INSTALLATIONS WITH ALL OTHER TRADES.
- IANICAL CONTRACTOR SHALL WARRANTY THE HEATING, VENTILATION AND AIR-CONDITIONING SYSTEM FOR ONE (1) THE WARRANTY SHALL BE IMPLEMENTED UPON CONSTRUCTION COMPLETION AND SHALL INCLUDE LABOR AND RIALS. NO ADDITIONAL COST WILL BE GRANTED TO CONTRACTOR RELATED TO BREAKDOWN OF THE HVAC SYSTEM EPLACING NON-OPERATIONAL MATERIAL/PARTS DURING THE WARRANTY PERIOD.

PIPE MAT	FERIAL SCHEDULE		
SERVICES	APPLICATION	MATERIAL	REMARKS
HEATING HOT WATER. EXTERIOR	=<2" DIAMETER	RIGID COPPER (TYPE L)	JOINING METHOD OPTIONS INCLUDE BRAZING OR MECHANICAL JOINTS 1.5" THICK FIBERGLASSS INSULATION FOR PIPES 1-1/4" DIAMETER OR LESS 2" THICK FIBERGLASS INSULATION FOR PIPES 1-1/2" OR GREATER. COVER INSULATION WITH CORRUGATED ALUMINUM JACKET
CHILLED WATER EXTERIOR	=<2" DIAMETER AND COIL CONNECTIONS THAT ARE >2"	RIGID COPPER (TYPE L)	JOINING METHOD OPTIONS INCLUDE BRAZING OR MECHANICAL JOINT. 1.5" THICK FIBERGLASSS INSULATION COVER INSULATION WITH CORRUGATED ALUMINUM JACKET
CHILLED WATER EXTERIOR	>2" DIAMETER	STEEL STND WEIGHT	JOINING METHOD OPTIONS INCLUDE WELDING, FLANGED OR MECHANICAL COUPLINGS. ASJ JACKETED 1.5" THICK FIBERGLASS INSULATION. COVER INSULATION WITH CORRUGATED ALUMINUM JACKET
CHILLED WATER INTERIOR	>2" DIAMETER	STEEL STND WEIGHT	JOINING METHOD OPTIONS INCLUDE WELDING, FLANGED OR MECHANICAL COUPLINGS. ASJ JACKETED 1.5" THICK FIBERGLASSS INSULATION
NOTE: HYDRON	IC PIPING INSTALLATION SHALL COMPLY WITH	CHAPTER 12 PART I OF THE C	CMC.
DUCT MA	TERIAL SCHEDULE		
SERVICES	APPLICATION	MATERIAL	REMARKS
SUPPLY	INDOOR MEDIUM PRESSURE MAIN	GALVANIZED STEEL G90	2" THICK FIBERGLASS DUCT LINER SYSTEM FOR ACOUSTICAL AND THERMAL CONTROL. R8 REFER TO NOTE 7.
RETURN	INDOOR MAIN	GALVANIZED STEEL G90	2" THICK FIBERGLASS LINER FOR ACOUSTICAL AND THERMAL CONTROL.R8
SUPPLY	EXTERIOR MAIN	GALVANIZED STEEL G90	CONSTRUCT TO 10" W.G. PRESSURE CLASS. TOP RIDGED AT CENTER LINE AND SLOPED TO DRAIN. >120" TO BE MINIMUM 16 GAUGE WITH INTERIOR TIE ROD BRACING NOT TO EXCEED 48" O.C. EXTERNAL ANGLE BRACING AT TIE ROD ATTACHMENTS. 2" THICK FIBERGLASS LINER FOR ACOUSTICAL AND THERMAL CONTROL.R8
SUPPLY	RISER CONNECTIONS TO AHU	GALVANIZED STEEL G90	1" THICK FIBERGLASS DUCT LINER SYSTEM FOR CONDENSATION CONTROL. R4.6. REFER TO NOTE 7.
 DUCT INSU A. DUCTS AIR DISTRIBE SEALED A. SUPPL BE SEALED A. SUPPL B. SUPPL C. EXHAU D. RETUFE E. CURB ACCESS D SUPPLY AI OF METAL DUCT SYS'SYSTEM SI T. DUCT LINE A. JM LIN B. REFLE SMOKE C. PINS: V D. TAPE SI E. EXPOSE 	DAND INSULATED PER CHAPTER 6 OF THE CMC Y DUCTS AND PLENUMS FROM AIR HANDLER F Y DUCTS AND PLENUMS DOWNSTREAM OF VA IST DUCTS AND PLENUMS WITHIN THE BUILDIN IN AIR DUCTS AND PLENUMS WITHIN THE BUILDIN IN AIR DUCTS AND PLENUMS WITHIN THE BUILDIN PLENUMS FOR RETURN - SEAL CLASS "A" OORS INTO DUCTS SHALL BE DUCTMATE "SAN R, RETURN AIR, AND OUTSIDE AIR FOR HEATIN AS SET FORTH IN THE ANSI/SMACNA HVAC DU TEMS USED WITH BLOWER TYPE EQUIPMENT IN HALL BE SIZED IN ACCORDANCE WITH STANDA IR SYSTEM: ACOUSTIC "RC" GLUED AND PINNED TO SHEET CTIX "R 4.2" DUCT INSULATION GLUED TO LINA E/FLAME INDEX	STANDARDS SECTION 120.4 NUM SHALL HAVE INSULATION IDING BUT NOT LIMITED TO BU 2: FAN DISCHARGE TO VAV TERM V TERMINALS - SEAL CLASS" B IG ENVELOP - SEAL CLASS "A" DING ENVELOPE SEAL CLASS DWICH" STYLE INSULATED AN IG, COOLING OR EVAPORATVE CT CONSTRUCTION STANDARI WHICH ARE PORTIONS OF HEA RDS LISTED IN CHAPTER 17 C METAL. COUSTIC AND PINNED TO SHE VATED ADHESIVE WASHERS. F IC ADHESIVE FOIL BACKED TA PROTECTED BY SHEET METAL	 I VALUE OF R4.6 UILDING CAVITIES, MECHANICAL CLOSETS, AIR HANDLER BOXES AND SUPPORT PLATFORMS SHALL IINAL - SEAL CLASS "A" FOR 4" W.G. I'F FOR 1" W.G. FOR 2" W.G. S "B" FOR 2" W.G. D GASKETED WTH HAND KNOBS. MINIMUM 24"X18". E COOLING SYSTEMS SHALL BE CONDUCTED THROUGH DUCT SYSTEMS CONSTRUCTED DS-METAL AND FLEXIBLE, OR ANOTHER APPROVED DUCT CONSTRUCTION STANDARD TING, COOLING, ABSORPTION, EVAPORATIVE COOLING OR OUTDOOR AIR VENTILATION OF 2016 CALIFORNIA MECHANICAL CODE. EET METAL. INSULATION VALUE IS ZERO. PROVIDESCLEANABLE FINISH SURFACE OVER LINER.50/25 PIN LENGTH FOR TOTAL THICKNESS OF LINER AND FINISH APPE.
A. CLEAN	SOPPLY AND REFORN DUCT VERTICAL RISER L I SOUND TRAPS AND DUCT. REPAIR DAMAGED PSULATE DUCT LINER WITH SPRAY COATING O	SECTIONS OF DUCT LIBER.	

CC	ODES AND STANDARDS	

- 2016 CALIFORNIA BUILDING STANDARDS ADMINISTRATIVE CODE, TITLE 24 C.C.R. 2016 CALIFORNIA BUILDING CODE (CBC), TITLE 24 C.C.R.
- 2016 CALIFORNIA ELECTRICAL CODE (CEC), TITLE 24 C.C.R. 2016 CALIFORNIA MECHANICAL CODE (CMC), TITLE 24 C.C.R.
- 2016 CALIFORNIA PLUMBING CODE (CPC), TITLE 24 C.C.R. 2016 CALIFORNIA GREEN BUILDING CODE (CGBC)
- 2016 CALIFORNIA ENERGY CODE 2016 NATIONAL FIRE PROTECTION ASSOCIATION (NFPA)
- ANY OTHER LOCAL AND STATE LAWS AND REGULATIONS

SEISMIC NOTES

- ALL ANCHORAGE AND/OR SEISMIC RESTRAINTS SHALL BE DESIGNED BY A REGISTERED PROFESSIONAL STRUCTURAL ENGINEER LICENSED IN THE STATE OF CALIFORNIA.
- THE ANCHORAGE AND/OR SEISMIC RESTRAINT OF PERMANENT EQUIPMENT AND ASSOCIATED SYSTEMS LISTED BELOW SHALL BE DESIGNED TO RESIST THE TOTAL DESIGN SEISMIC FORCES PRESCRIBED IN SECTION 1632.2A OF THE 2016 CALIFORNIA BUILDING CODE.
- SEISMIC RESTRAINTS ARE REQUIRED FOR THE FOLLOWING INSTALLATIONS:
- A) ALL FLOOR OR ROOF MOUNTED EQUIPMENT WEIGHING 400 LBS. OR GREATER.
- B) ALL SUSPENDED OR WALL MOUNTED EQUIPMENT WEIGHING 20 LBS. OR GREATER. C) ALL VIBRATION ISOLATION EQUIPMENT WEIGHING 20 LBS. OR GREATER.
- D) ALL PIPING 1-1/4 INCHES NOMINAL DIAMETER AND LARGER LOCATED IN BOILER, MECHANICAL EQUIPMENT AND REFRIGERATION MECHANICAL ROOMS.
- E) ALL PIPING 2-1/2 INCHES NOMINAL DIAMETER AND LARGER.
- F) ALL DUCTWORK 6 SQUARE FEET AND LARGER IN CROSS SECTIONAL AREA. G) ALL ROUND DUCTWORK 28" IN DIAMETER AND GREATER.
- H) PIPES AND DUCTS SUPPORTED BY A TRAPEZE WHERE NONE OF THOSE ELEMENTS WOULD INDIVIDUALLY REQUIRE BRACING NEED NOT BE BRACED IF CONNECTIONS TO THE PIPE/DUCT OR DIRECTIONAL CHANGES DO NOT RESTRICT MOVEMENT OF THE TRAPEZE. IF THIS FLEXIBILITY IS NOT PROVIDED, BRACING IS REQUIRED WHEN THE COMBINED OPERATING WEIGHT OF ALL ELEMENTS SUPPORTED BY THE TRAPEZE IS 10 LBS/FT OR GREATER. SEE STRUCTURAL SHEETS S5.2 AND S5.3 FOR SEISMIC BRACING DETAILS.

GREEN BUILDING STANDARD NOTES

- MINIMUM OF 50% OF NON HAZARDOUS CONSTRUCTION WASTE IS SHALL BE RECYCLE. CGC 5.713.8.1. TESTING AND ADJUSTING OF NEW SYSTEMS SHALL COMPLY AS OUTLINED IN CGC SECTION 5.713.10.4.2. OPERATIONS AND MAINTENANCE SCHEDULE (O&M) AS LISTED IN CGC SECTION 5.713.10.4.5 SHALL BE DELIVERED TO THE BUILDING OWNER OR REPRESENTATIVE AND THE FACILITIES OPERATOR.
- DURING CONSTRUCTION, ENDS OF DUCT OPENING ARE SHALL BE SEALED, AND MECHANICAL EQUIPMENT IS SHALL BE COVERED. CGC 5.714.4.3. VOC'S MUST COMPLY WITH THE LIMITATIONS LISTED IN SECTION 5.504.4 AND TABLES 4.504.1, 5.504.4.1, 5.504.4.2, 5.504.4.3 AND 5.504.4.5 FOR: ADHESIVES, SEALANTS, PAINTS, AND COATINGS, CARPET AND
- COMPOSITION WOOD PRODUCTS. CGC 5.714.4.4. PRIOR TO FINAL APPROVAL OF THE BUILDING THE LICENSED CONTRACTOR, ARCHITECT OR ENGINEER IN RESPONSIBLE CHARGE OF THE OVERALL CONSTRUCTION SHALL COMPLETE AND SIGN THE CITY APPROVED GREEN BUILDING STANDARDS CERTIFICATION FORM OR OTHER DOCUMENTATION REQUIRED BY THE CITY AND GIVEN TO THE BUILDING DEPARTMENT OFFICIAL PRIOR TO BUILDING FINAL APPROVAL TO BE FILED WITH


TITLE 24 NOTES

THE APPROVED PLANS.

- ADDITIONAL VAV BOXES ARE BEING ADDED FOR THIS PROJECT.
- 2. NO ADDITIONAL COOLING/HEATING LOADS ARE BEING ADDED TO THE BUILDING HVAC SYSTEMS.
- 3. NO CHANGES ARE BEING MADE TO THE BUILDING ENVELOPE.
- 4. NEW DUCTWORK TO COMPLY WITH SECTION 149(b) 1D. STANDARDS.
- 5. NEW TITLE 24 CALCULATION IS NOT REQUIRED BECAUSE OF THE ABOVE NOTES.

MECHANICAL SHEET INDEX

S.No.	SHEET NUMBER	SHEET TITLE
1	M-001	MECHANICAL GENERAL NOTES, LEGEND, ABBREVIATIONS AND SHEET INDEX
2	M-002	MECHANICAL SCHEDULES
3	M-201	DEMOLITION FLOOR PLAN
4	M-202	NEW FLOOR PLAN
5	M-401	DETAILS
6	M-801	TITLE 24
7	M-802	TITLE 24

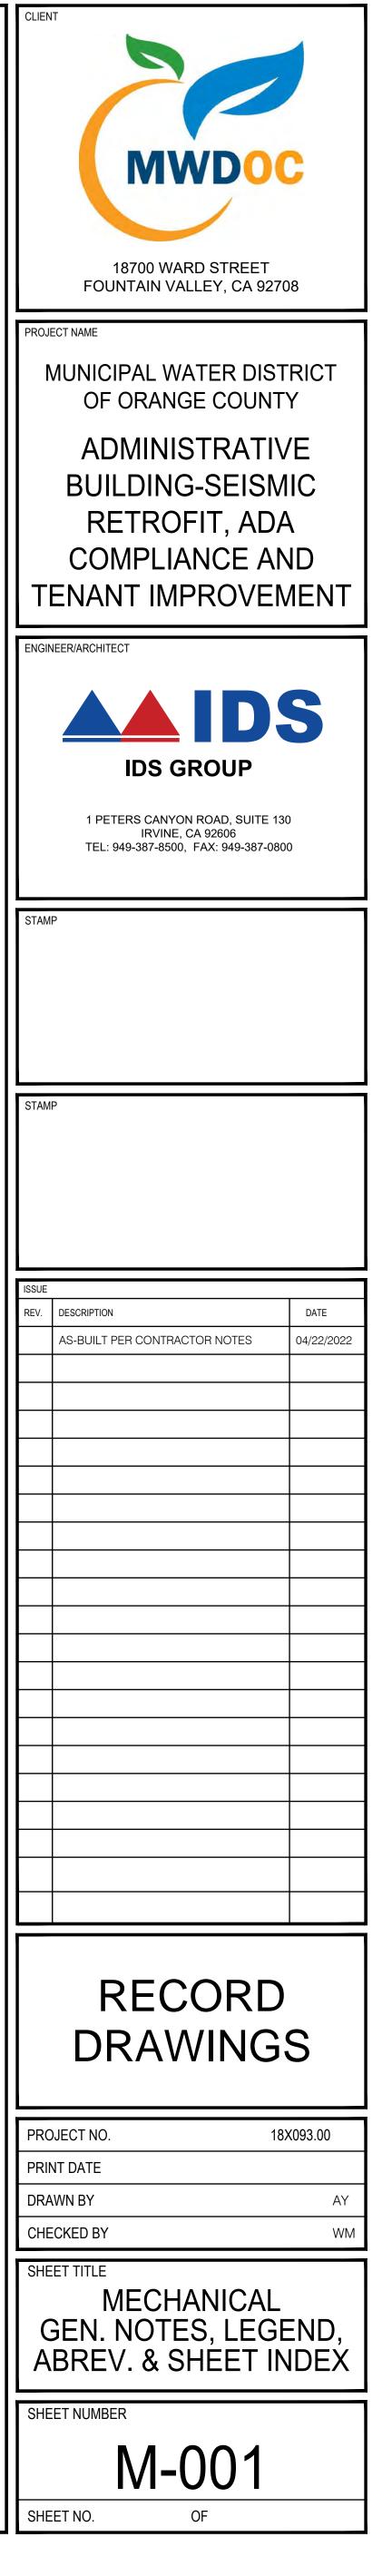

								SUPPLY	FAN			PERFORMAN	NCE (NOTE 1)		A	IR SIDE (N	OTE 1)		WA	TER (NOT	ΓE 1)			FILTE	R	El	ECTRICAL	PHY	SICAL		
ГAG	STATUS	MAKE	MODEL	TYPE	LOCATION	SERVICE				MO	TOR			ENTERING	LEAVING		TYPE	E													DEMADKS
IAG	STATUS	WARE	MODEL	ITPE	LUCATION	SERVICE	CFM OSA	TSG "WG DRIV	E RPM C	TY BHP EA	HP EA RPM	SENSIBLE MBH	TOTAL MBH	TDB TWB	TDB TWB	AREA	FPM I	ROWS FINS	GPM	EWT	LWT	dP FT	QTY L	W D	PRESS DROP IN WG	V	PH MCA	L	W	H (LBS)	REMARKS
AH 2	EXISTING	DIAKIN	CAH039GDAM	CUSTOM STACKED, BELT, CHW		SW & SE OFFICES - OCWD	10,800 2,220	2.75 BEL	850	1 3.3	10 850	297.6	341.6	82.3 66.3	55.8 55.4	500	480	6 12	68.3	45.0	55.0	12	6 20	25 2	0.28	460	3 -	-	-		


			SI	ZE		MAKE	MODEL	TYF	Έ			PEI	RFORMANC	Ξ					
		INLET		OUTL	.ET					COOLING			MIN	PRESSURE		РНҮ	SICAL		
TAG	STATUS	DIA (W)	W	Н	ROWS					AIRFLOW	AIRFLOW	AIRFLOW	AIRFLOW	S.P.	L	W	Н	WEIGHT	COMMENTS
VAV 23	EXISTING	10	14	12.5	2	TITUS	DESV	PRES		910	995	1400	145	0.58	48	14	12.5	100	1
VAV 24	EXISTING	9	14	12.5	2	TITUS	DESV			855	925	1050	120	0.54	48	14	12.5	100	1
VAV 25	EXISTING	7	12	10	2	TITUS	DESV			520	630	650	70	0.23	48	12	10	100	
VAV 26	EXISTING	16	24	16	2	TITUS	DESV			2730	1755	4000	385	0.43	51	24	16	200	
VAV 27	EXISTING	12	16	15	2	TITUS	DESV			1110	910	2000	190	0.45	48	16	15	100	
VAV 28	EXISTING	12	16	15	2	TITUS	DESV			765	600	2000	190	0.54	48	16	15	100	
VAV 29	EXISTING	9	14	12.5	2	TITUS	DESV			630	600	1050	120	0.49	48	14	12.5	100	
VAV 30	EXISTING	9	14	12.5	2	TITUS	DESV			570	410	1050	120	0.54	48	14	12.5	100	
VAV 31	EXISTING	10	14	12.5	2	TITUS	DESV			1145	1000	1400	145	0.49	48	14	12.5	100	
VAV 32	EXISTING	9	14	12.5	2	TITUS	DESV			600	350	1050	120	0.54	48	14	12.5	100	1
VAV 33	EXISTING	14	20	17.5	2	TITUS	DESV			2185	1785	3000	300	0.59	51	20	17.5	100	1
VAV 34	EXISTING	10	14	12.5	2	TITUS	DESV			1200	485	1400	145	0.44	48	14	12.5	100	1
VAV 40	EXISTING	6	6	8	2	TITUS	DESV			610	320	500	45	0.50	48	6	8	100	1
VAV 41	EXISTING	8	12	10	2	TITUS	DESV			430	485	900	90	0.50	48	12	10	100	1
VAV 42	EXISTING	6	6	8	2	TITUS	DESV		1	260	280	500	45	0.50	48	6	8	100	1


NOTES:


1) EXISTING VAV BOX TO REMAIN AND USE.


DIFFU	JSER, REGISTER AND	O GRILL SCHEDU	_E						
UNIT NO.	MANUFACTURER & MODEL NO.	DESCRIPTION	FACE TYPE	FACE SIZE	COLOR	MATERIAL	OBD	REMARKS	
CD-1	TITUS MCD BORDER 3, OR EQUAL	MODULAR CORE	LAY IN	24"X24"	8	STEEL	NO	1234567	
CD-2	TITUS PAS BORDER 1, OR EQUAL	MODULAR CORE	SURFACE	16"X16"	8	STEEL	NO	1234567	
R-1	TITUS PAR, OR EQUAL	SQUARE CEILING RETURN	LAY-IN, PERFORATED	24"X24"	8	STEEL	NO	1234567	
R-2	TITUS PAR, OR EQUAL	SQUARE CEILING RETURN	SURFACE, PERFORATED	16"X16"	8	STEEL	NO	1234567	
	ORDINATE WITH ARCHITECTURAL BORDER TYPES.	REFLECTED CEILING PLAN	IS (5)		ET M-401/2 T TION DETAI		OR TYPICA	AL CEILING DIFFUSER	8 COORDINATE THE COLOR WITH THE ARCHITECT.
2 MAXI	IMUM TOTAL PRESSURE DROP S	HALL BE 0.1" WG.	6	NECK SIZ	E AND CFM	SHOWN ON F	PLANS.		
	IMUM NC LEVEL SHALL BE 25.		T)	TRANSITI	ON AS REQ		ND NECK AF	ARE TO ROUND REA SHALL EQUAL OR	

(4) ALL VISIBLE SURFACES AND DUCTWORK BEHIND FACE SHALL BE PAINTED BLACK.

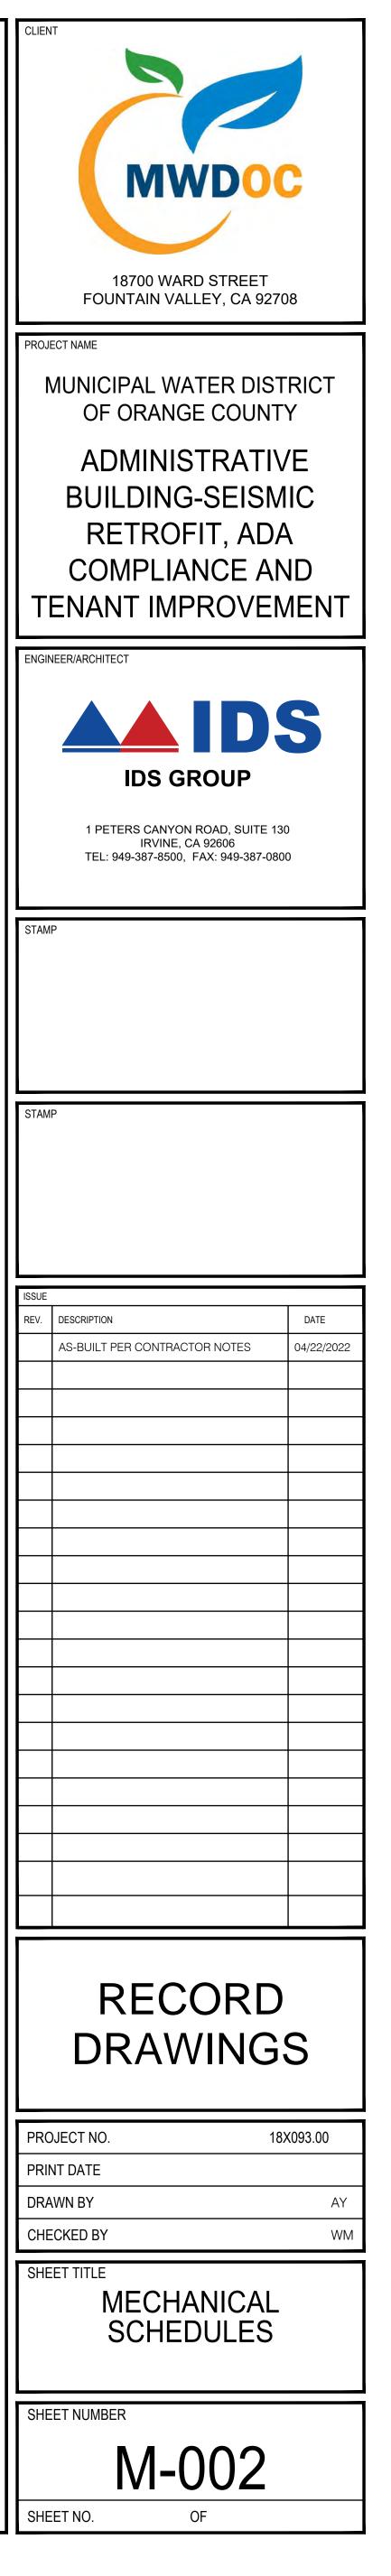


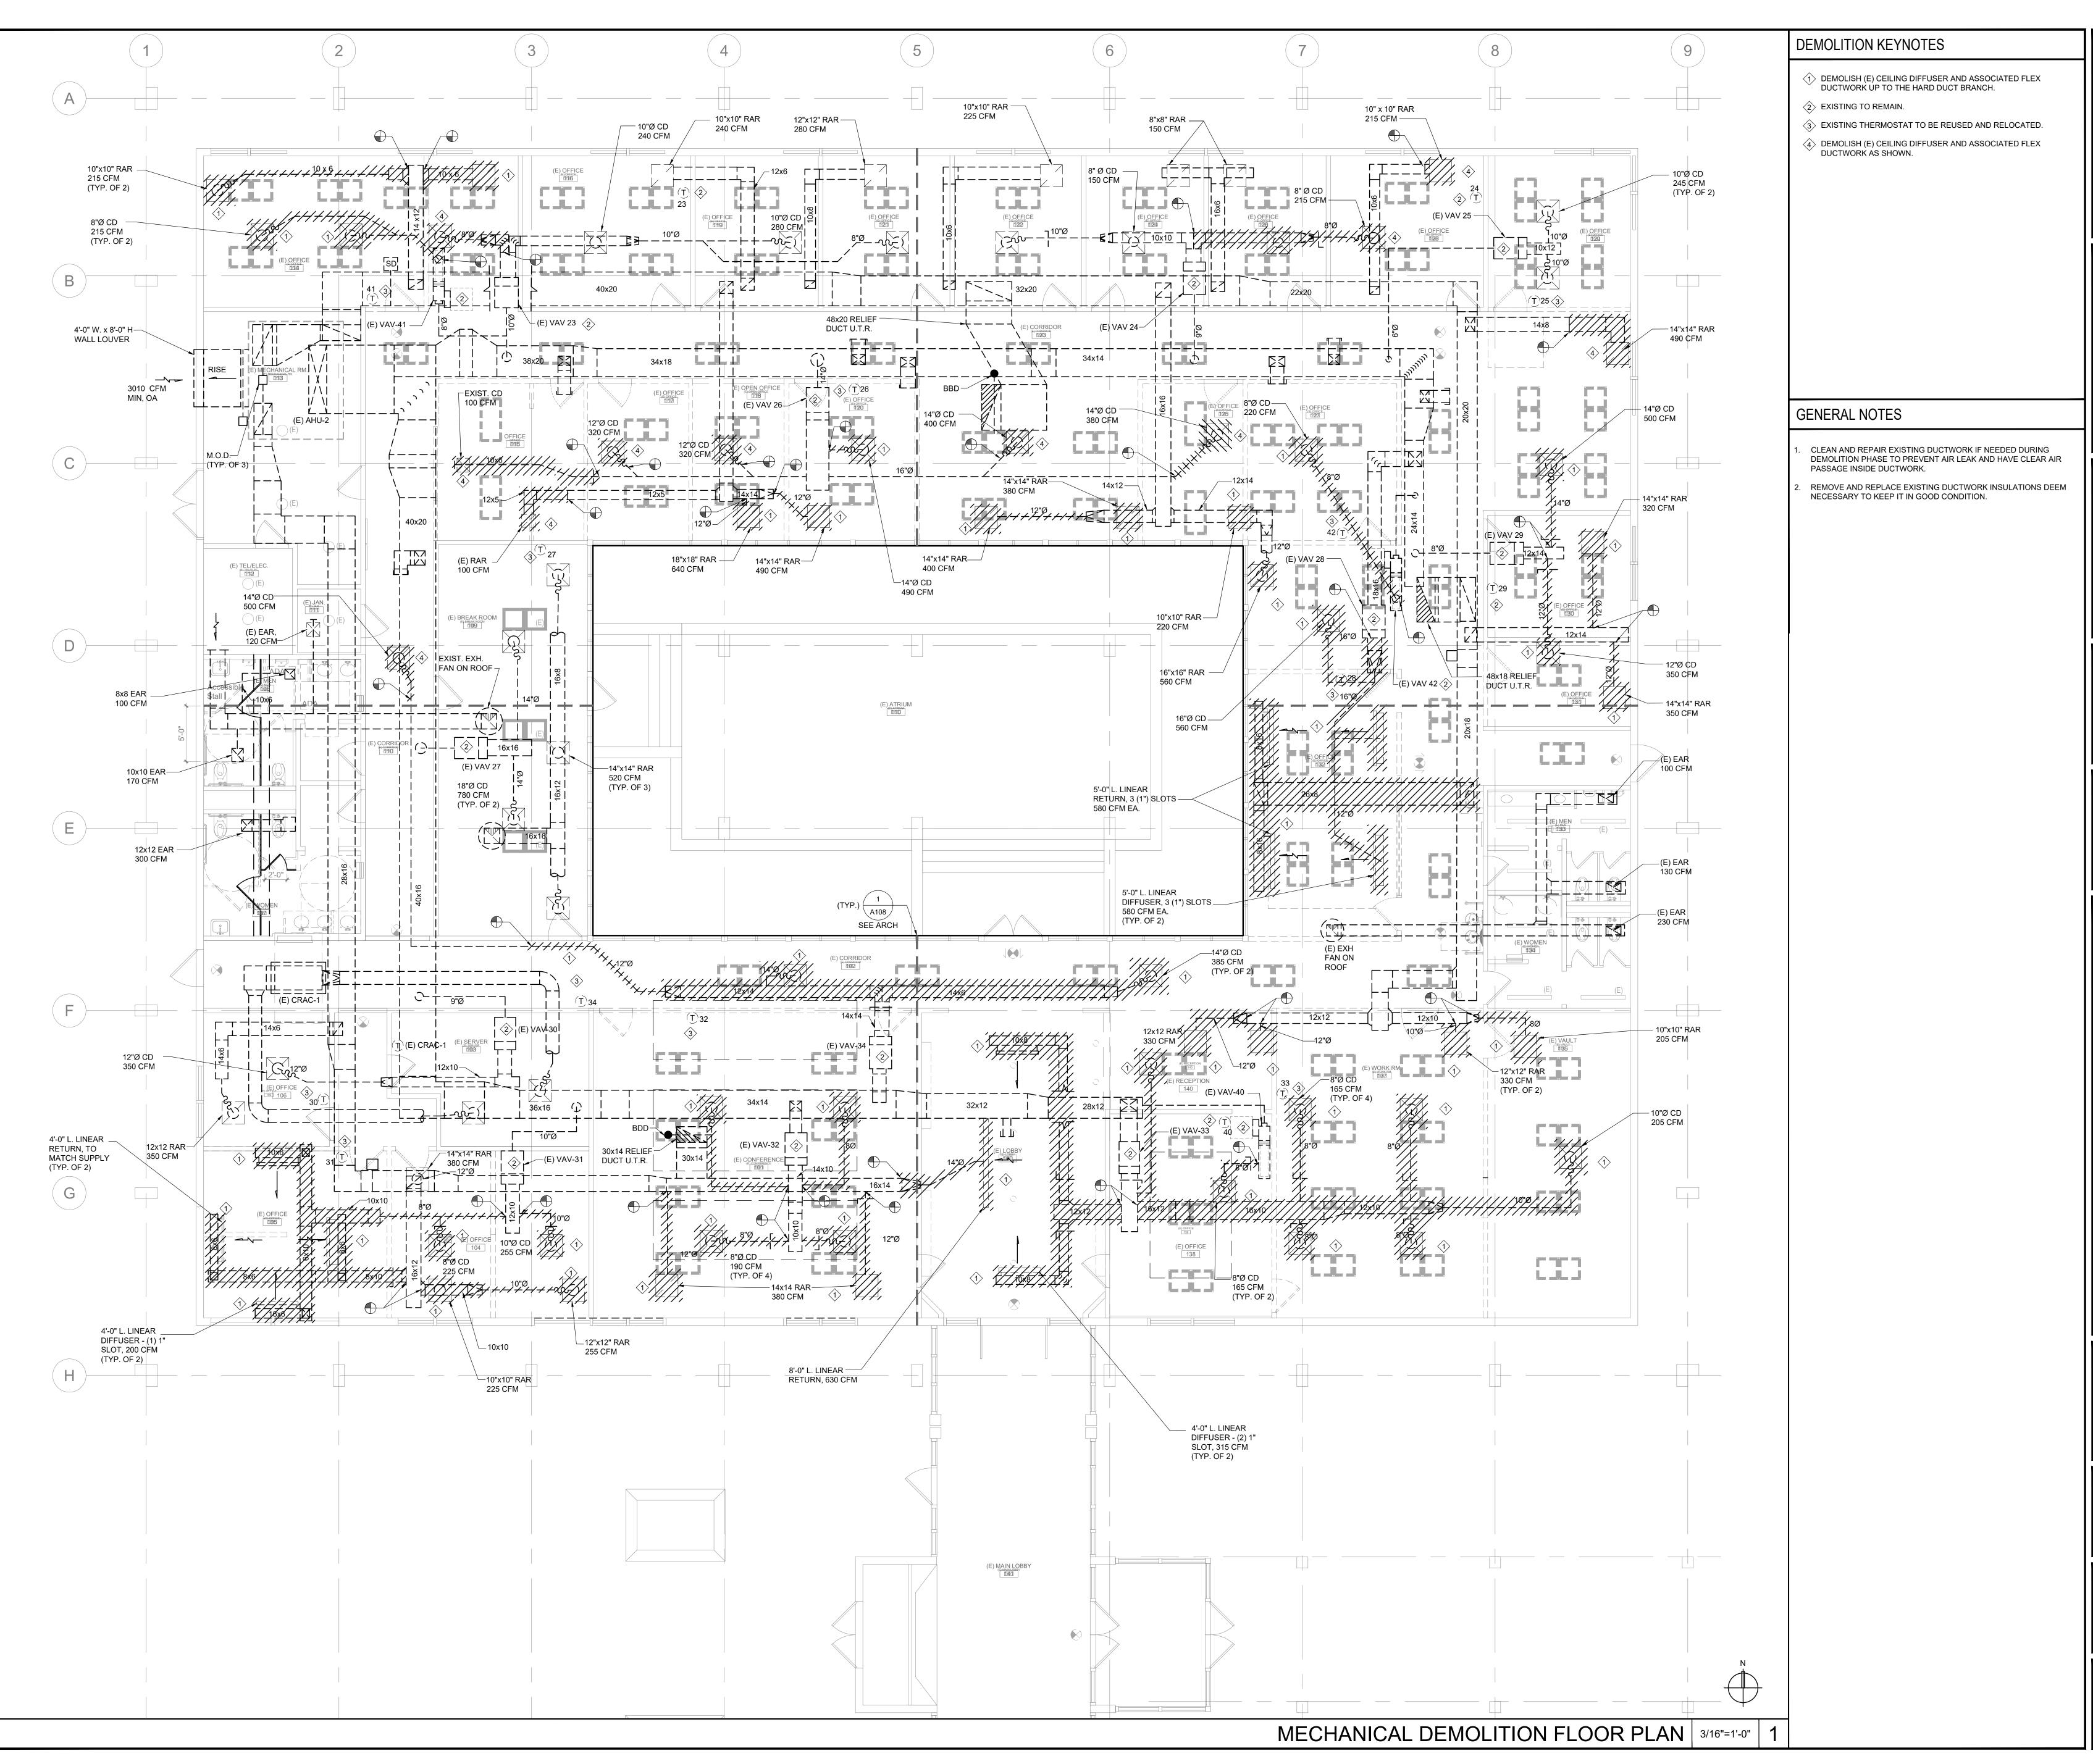


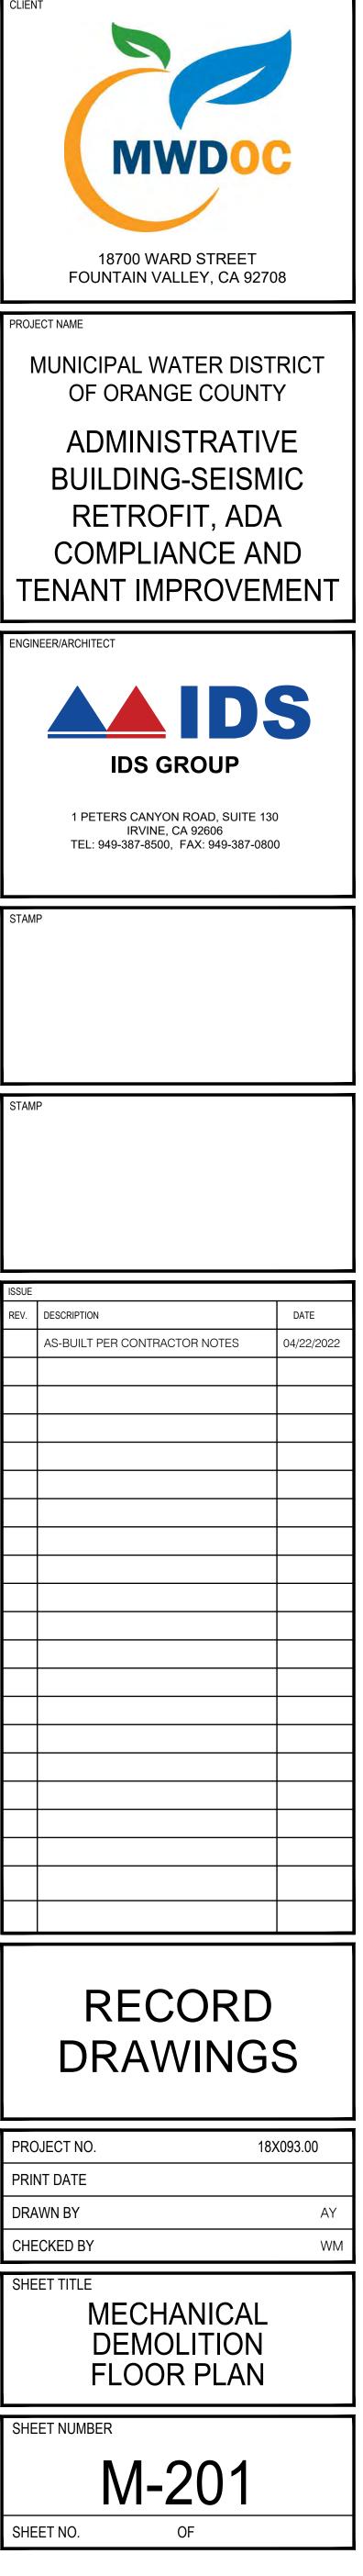


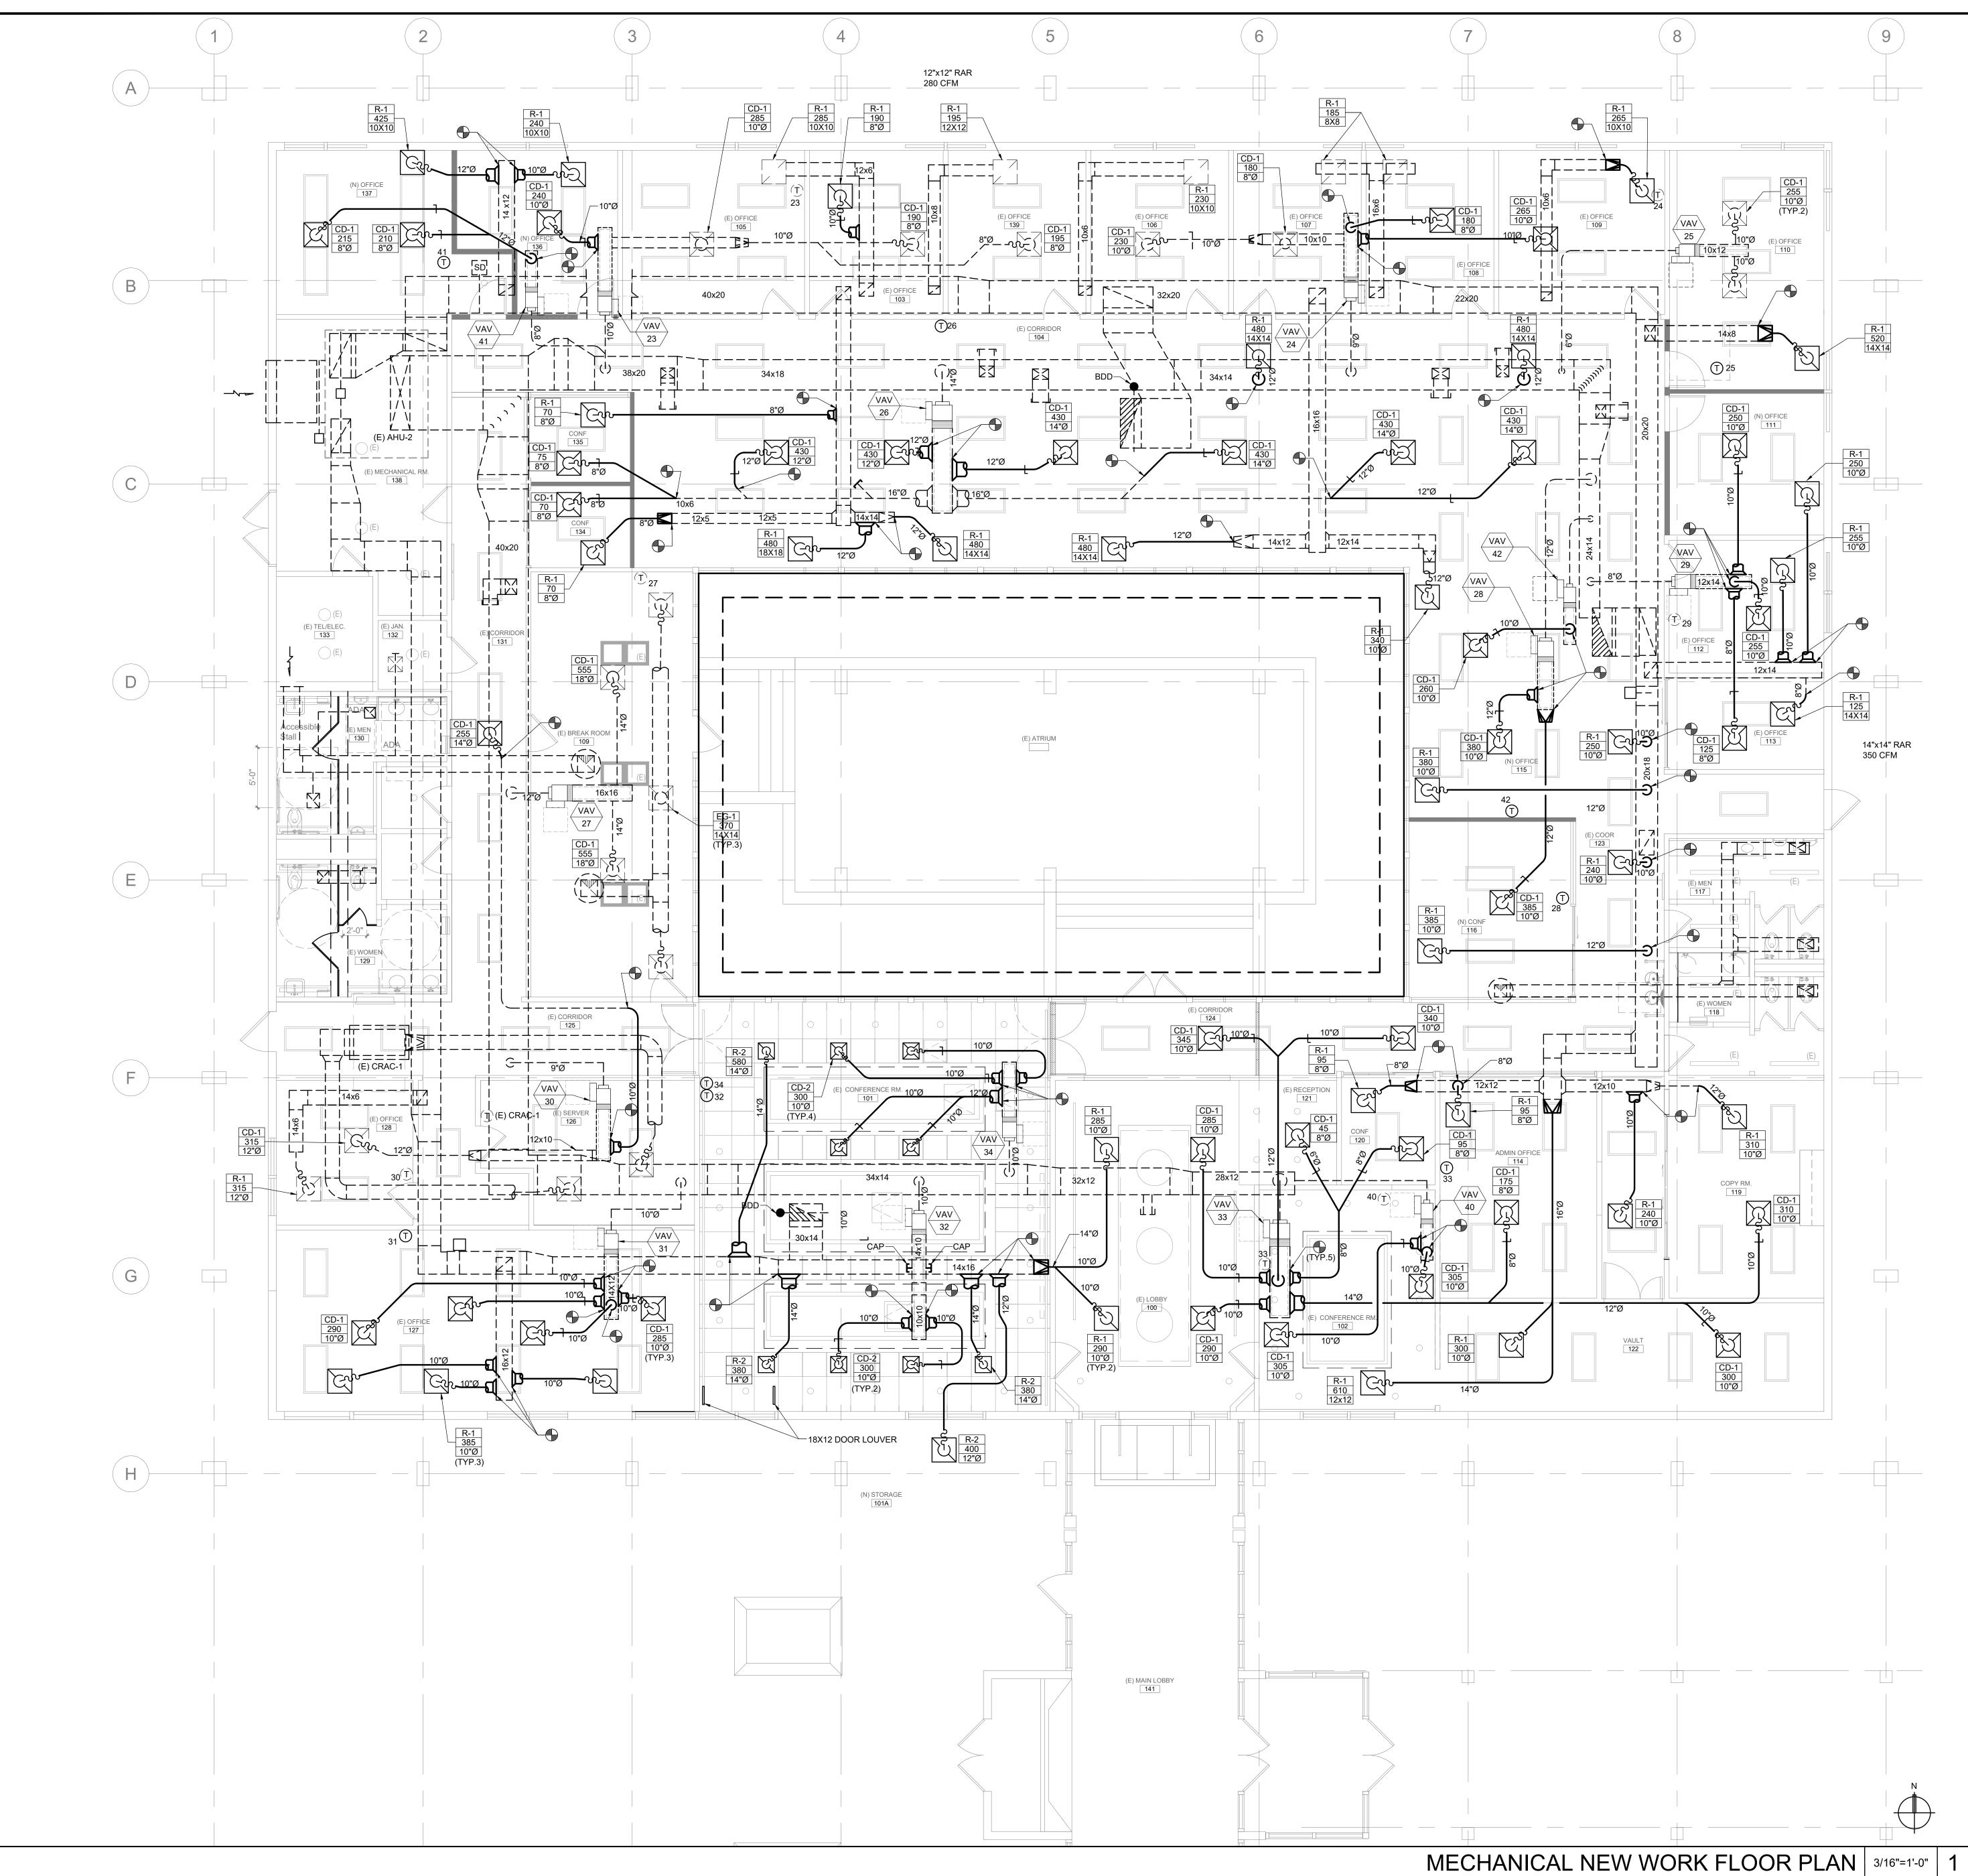


 MATERIAL INSTALLED IN THE PLENUMS SPACE ABOVE CELLING TILES SHALL COMPLY WITH CMC SECTION 80.2. FLAME SPREAD INDEX SHALL EN MOT MORE THEN 36. AND THE SMOKE BEVELOPMENT RATING SHALL FREI INSIDE DIMENSIONS. DUCTYORK AND PIPINS SHALL BE SUPPORTED AND BRACED IN ACCORDANCE WITH THE 2018 CBC/CMC AND THE LATEST EDITION OF SMARAY CUDELINES FOR SMALL BE SUPPORTED AND BRACED IN ACCORDANCY CONTROL FOR CONTROL FREITRATIS OF MECHANICAL 9YSTEDS AND FUNDISING PRINC'. EXHAUST DUCTS UNDER POSITIVE PRESSURE AND VENTING SYSTEMS SHALL NOT EXTEND INTO OR PASS THEOUGH DUCTS OR PLENUMS (CMC 602.1) ALL MATERIAL EXPOSED WITHIN THE PLENUM SPACE SHALL COMPLY WITH CMC SECTION 80. MATERIALS SHALL HAVE A MOLD. HUMDITY, AN EROSION RESISTANT FACE THAT MEETS THE REQUIREMENTS OF ILL 181 FLAT AND EXPLOSITIVE THE PLENUM SPACE SHALL COMPLY WITH CMC SECTION 80. MATERIALS SHALL HAVE A MOLD. HUMDITY, AN EROSION RESISTANT FACE THAT MEETS THE REQUIREMENTS OF ILL 181 FLAT AND SPACE TEMPERATURE THERMOSTAL @ 48"MAX. A.F.F. VERIFY EXACT LOCATION WITH ARCHTECT. MOUNT SPACE TEMPERATURE THERMOSTAL @ 48"MAX. A.F.F. VERIFY EXACT LOCATION WITH ARCHTECT. MOUNT SPACE TEMPERATURE THERMOSTAL BESITIALY DIAGRAMMATIC AND ANY OFFSETS DUE TO EXISTING CONDITIONS SHALL BE THE RESPONSIBILITY OF THE CONTRACTOR. CONTRACTOR SHALL DOR THE WARD STREE SENTIALLY DIAGRAMMATIC AND ANY OFFSETS DUE TO EXISTING CONDITIONS SHALL BE THE RESPONSIBILITY OF THE CONTRACTOR. CONTRACTOR SHALL BE INSTALLED IN THE MARATING AND STREED IN A COMPLETE WORKABLE INSTALLATION. CONTRACTOR SHALL BE INSTALLED IN ACCORDANCE WITH MISTING DOR ACCOMPLETE WORKABLE INSTALLATION. CONTRACTOR SHALL BE ONSTRUCTURAL ENGINEER PRIOT TO COMMENCEMENT OF WORK. ALL COUPERNT SHALL BE CONTRUCTED. NOT RESISTING TO STREED IN ACCORDANCE WITH OHET, OF CALL FERDING TO RESISTING THE STREED IN ACCORDING THE MARATING STREED STREED THOR OWRERS USED STALL BE ANTILED AND AND SPRETTED TO COMMEND		COORDINATE DIFFUSER/RETURN LOCATION WITH LIGHTING LAYOUT. SEE
 C. DUCTWORK DIMENSIONS SHOWN ON DRAWINGS BHALL BE ACTUAL FREI INDEE DIMENSIONS. D. DUCTWORK ADD PINIG CHAIL BE SUPPORTED AND BRACED IN ACCORDANCE WITH THE 2016 CBC/MCA AND THE LATEST EDITION OF SWACNA "OUBLINES FOR SERVIC RESTRAINTS OF MECHANICAL SYSTEMS AND PLUMBING PIPING". E. XHAUST DUCTS UNDER POSITIVE PRESSURE AND VENTING SYSTEMS SHALL NOT EXTEND INTO OR PASS THROUGH DUCTS OR PLENUMS (OW 602.1) ALL MATERIAL EXPOSED WITHIN THE PLENUM SPACE SHALL COMPLY WITH CWC SECTOR 065. MATERIALS SHALL HAVE A MOLD, HUMDITY, AN EROSION RESISTANT FACE THAT MEETS THE REQUIREMENTS OF UL. 181 MOUNT SPACE TEMPERATURE THERMOSTAT @ 48"MAX. AF.F. VERIFY EXACT LOCATION WITH ARCHITECT. J. MOUNT SPACE TEMPERATURE THERMOSTAT @ 48"MAX. AF.F. VERIFY EXACT LOCATION WITH ARCHITECT. THE HYAC CONTRACTOR. WANNINGS ARE DESENTIALLY DIARGAMMATIC AND ANY OFFSETS DUE TO EXISTING CONDITIONS SHALL BE THE RESPONSIBILITY OF THE CONTRACTOR. COORDINATE ENTIRE INSTALLATION OF THE HYAC SYSTEM WITH THE WORK OF ALL OTHER TRADES PRION TO ANY FARECATION OF MEDUIED FOR A COMPLETE WORKABLE INSTALLATION. CONTRACTOR SHALL COORDINATE WITHING, FUSED DISCONNECT SWITCHES AND CONDUIT REQUIREMENTS WITH ELECTRICAL CONTRACTOR SHALL COORDINATE WINN, G.FUSED DISCONNECT SWITCHES AND CONDUIT REQUIREMENTS WITH ELECTRICAL CONTRACTOR SHALL BE INSTALLED IN ACCORDANCE WITH MANUFACTOR. L. LUDUPMENT SHALL BE INSTALLED IN ACCORDANCE WITH MANUFACTOR. L. ALL EQUIPMENT SHALL BE INSTALLED IN ACCORDANCE WITH MANUFACTURERS RECOMMENDITIONS. PROVIDE ALL FITTINGS, TRANSITIONS DAMERES, VALUES AND OTHER DEVICES REQUIRED FOR TO COMMENCEMENT OF WORK. L. LL CULTURERS RECOMPADITONS. TROUCH ALL BELTINGS, TRANSITIONS DAMERES, VALUES AND OTHER DEVICED REQUIRED FOR TH OVERNERS WITH HING ACUTURED AND ACCORDANCE WITH MANUFACTURERS RECOMPOSITIONS. TOWORD ALL BETTINGS, TRANSITIONS DAMERES, VALUES AND OTHER DEVICED RECOMPORT OF URERS STALL BE ONSTRUCTED, SEALED ST		SHALL COMPLY WITH CMC SECTION 602.2. FLAME SPREAD INDEX SHALL BE NOT MORE THEN 25 AND THE SMOKE DEVELOPMENT RATING SHALL B
 DUCUNORK AND PIPING SHALL BE SUPPORTED AND BRACED IN ACCORDANCE WITH THE 2016 CBC/CMC AND THE LATEST EDITION OF SMACAN "SUPELINES TO RESIMUR CREMENTS OF MECHANICAL SYSTEMS AND PLUMBING PIPING". EXHAUST DUCTS LUNDER DESIMUR CREMENTS OF MECHANICAL SYSTEMS AND PLUMBING PIPING". ALL MATERIAL EXPOSED WITHIN THE PLENUM SPACE SHALL COMPLY WITH CMC SECTION 805. MATERIALS SHALL HAVE A MOLD, FUMIDITY, AN EROSION RESISTANT FACE THAT MEETS THE REQUIREMENTS OF UL 181 CONDUCTS. SUPPERSISTANT FACE THAT MEETS THE REQUIREMENTS OF UL 181 THE HAX CONTRACTOR SHALL WIST THE ADD STEP PRIOR TO SUBMITTING HISHER RID IN ORDER TO VERIEY ALL EXISTING FIELD CONDITIONS. THE HAX DEAVINGS AND ESSENTIALLY DIAGRAMMATIC AND ANY OFFSETS DUE TO EXISTING CONDITIONS SHALL BE THE RESPONSIBILITY OF THE CONTRACTOR. COORDINATE ENTIRE INSTALLATION OF THE HAXC SYSTEM WITH THE WORK OF ALL OTHER TRADES PRIOR TO ANY FABRICATION OR INSTALLATION. PROVIDE ALL FITTINGS OFFSETS AND TRANSITIONS AS REQUIRED FOR A COMPLETE WORKABLE INSTALLATION. CONTRACTOR SHALL COORTNATE WITH, SPACE THAN BERSTON SUBMITTING FISHALL ADD CONTRACTOR. CONTRACTOR SHALL COORTNATE WITH MELECTRICAL CONTRACTOR. CONTRACTOR SHALL COORTNATE WITH ALL ENTINGS TRANSITION FOUNDER ALL FITTINGS OFFSETS AND THANNITONS AS REQUIRED FOR A COMPLETE WORKABLE INSTALLATION. MALL EQUIRMENT SHALL BE INSTALLED IN ACCORDANCE WITH MANUFACTOR. LAL LOUIDMENT SHALL BE INSTALLED IN ACCORDANCE WITH MANUFACTOR. MALL EQUIRMENT SHALL BE AFFIRED TO ALL MECHANICAL EQUIRED TO MERS SHALL BE INSTALLED IN ACCORDANCE WITH MANUFACTOR. MALL EQUIRMENT SHALL BE AFFIRED TO ALL MECHANICAL EQUIRED TARD AMAINTENANCE MANUAL SHALL BE PROVIDED FOR THE VERTIFIED AND AMAINTENANCE MANUAL SHALL BE PROVIDED FOR THE ALL DUCTIONS ANAL BE CONSTRUCTED, SEA		DUCTWORK DIMENSIONS SHOWN ON DRAWINGS SHALL BE ACTUAL FREE
 E. EXHAUST DUCTS UNDER POSITIVE PRESSURE AND VENTING SYSTEMS SHALL NOT EXTEND INTO OR PASS THROUGH DUCTS OR PLENUMS (CMC 602.1) ALL MATERIAL EXPOSED WITHIN THE PLENUM SPACE SHALL COMPLY WITH CMC BECITION DB. MATERIALS SHALL HAVE A MOLD, HUMIDITY, AN EROSION RESISTANT FACE THAT MEETS THE REQUIREMENTS OF UL 181 MOUNT SPACE TEMPERATURE THERMOSTAT (@ 46°MAX. A.F.F. VERIFY EXACT LOCATION WITH ARCHITEGT. H. THE HAVAC CONTRACTOR SHALL WIST THE JOB SITE PRIOR TO SUBMITTING HISHER BID IN ORDER TO VERIFY ALL EXISTING FIELD CONDITIONS. THE HAVAC DRAWINGS ARE ESSENTIALLY DIAGRAMMATIC AND ANY OFFSETS DUE TO EXISTING CONDITIONS SHALL BE THE RESPONSIBILITY OF THE CONTRACTOR. COORDINATE ENTIRE INSTALLATION OF THE HAVAC SYSTEM WITH THE WORK OF ALL OTHER TRADES REION TO ANY FABRICATION OR INSTALLATION. PROVIDE ALL FITTINGS. OFFSETS AND TRANSITIONS AS REQUIRED FOR A COMPLETE WORKABLE INSTALLATION. CONTRACTOR. CONTRACTOR. CONTRACTOR. THE EXACT LOCATION OF ALL MECHANICAL EQUIPMENT SHALL BE VERIFIED WITH THE ARCHITECT AND STRUCTURAL ENGINEER PRIOR TO COMMENDEMENT FOWORK. ALL EQUIPMENT SHALL BE INSTALLATION. SA MULFACTURERS RECOMMENDATIONS, PROVIDE ALL FITTINGS. MITCHES AND CONDULT REQUIRED PRIOR TO COMMENDEMENT FOWORK. ALL EQUIPMENT SHALL BE INSTALLATION. MANUFACTURER SECONMENDATIONS, PROVIDE ALL FITTINGS. MITCHES RECOMMENDATIONS, PROCEDURES DETAILED, INTELESTRUCT, ALL DUCT WORK HALL BE CONSTRUCTED SANDARDS PER TITLE-24 SECTIONS (CSA14 (A)(B)). ALL HAVE EDUENT SHALL BE CONSTRUCTED SANDARDS PER TITLE-24 SECTIONS (CSA14 (A)(B)). ALL HAVE COUPMENT SHALL BE CONSTRUCTED SANDARDS PER		DUCTWORK AND PIPING SHALL BE SUPPORTED AND BRACED IN ACCORDANCE WITH THE 2016 CBC/CMC AND THE LATEST EDITION OF SMACNA "GUIDELINES FOR SEISMIC RESTRAINTS OF MECHANICAL
 ALL MATERIAL EXPOSED WITHIN THE PLENUM SPACE SHALL COMPLY WITH CMC SECTION 605. MATERIALS SHALL HAVE A MOLD, HUMIDITY, AN EROSION RESISTANT FACE THAT MEETS THE REQUIREMENTS OF UL 191 MOUNT SPACE TEMPERATURE THERMOSTAT @ 48°MAX. A.F.F. VERIFY EXACT LOCATION WITH ARCHITECT. THE HAYC CONTRACTOR SHALL VISIT THE LOD SITE PRIOR TO DOBINITIONS THE HAX DENDRING SARE DESENTIALLY DIAGRAMMATIC AND ANY OFFSETS DUE TO EXISTING CONDITIONS SHALL BE THE RESPONSIBILITY OF THE CONTRACTOR. COORDINATE ENTRE INSTALLATION OF THE HVAC SYSTEM WITH THE WORK OF ALL OTHER TRADES PRIOR TO ANY FABRICATION OR INSTALLATION. PROVIDE ALL FITTINGS, OFFSETS AND TRANSITIONS AS REQUIRED FOR A COMPLETE WORKABLE INSTALLATION. CONTRACTOR SHALL COORDINATE WIRING, FUSED DISCONNECT SWITCHES AND CONDUCT REQUIREMENTS WITH ELECTRICAL CONTRACTOR SHALL COORDINATE WIRING, FUSED DISCONNECT SWITCHES AND CONDUCT REQUIREMENTS WITH ELECTRICAL CONTRACTOR. CONTRACTOR SHALL COORDINATE WIRING, FUSED DISCONNECT SWITCHES AND CONDUCT REQUIREMENTS WITH ELECTRICAL CONTRACTOR. CONTRACTOR SHALL CONDUCT REQUIREMENTS HALL BE VERIFIED WITH THE ARCHITECT AND STRUCTURAL ENGINEET PRIOR TO COMMENCEMENT OF WORK. ALL LOURMENT SHALL BE INSTALLED IN ACCORDANCE WITH MANUFACTURERS RECOMMENDATIONS. PROVIDE ALL FITTINGS. TRANSITIONS DAMPERS, VALVES AND OTHER DEVICES REQUIRED FOR A COMPLETE WORKABLE INSTALLED IN ACCORDANCE WITH MANUFACTURERS RECOMMENDATIONS. PROVIDE ALL FITTINGS. NALL HAVE COUMPENT SHALL BE CRETTED BY THE CALIFORNIA ENERG' COMMISSION TO COMPLY WITH EFFICIENCY STANDARDS PRETTILE 24 SECTIONS (23314 (A)(B)). ALL DUCTORK SHALL BE CONSTRUCTED. SEALED ERECTED AND OWNERS USE. ALL LOUTORK SHALL BE CONSTRUCTED. SALLED ERECTED AND OWNERS USE. ALL LOUTORK SHALL BE CONSTRUCTED. SOLATED OR THAN OWNERS USE. ALL LOUTORK SHALL BE THALL DUCT WISH ALB ENDLATED ON UNEOS CONTRACTORS. ALL DUCTORK SHALL BE THALL DUCT	E.	EXHAUST DUCTS UNDER POSITIVE PRESSURE AND VENTING SYSTEMS SHALL NOT EXTEND INTO OR PASS THROUGH DUCTS OR PLENUMS (CMC
 EXACT LOCATION WITH ARCHITECT. H. THE HVAC CONTRACTOR SHALL VISIT THE JOB SITE PRIOR TO SUBMITTION HISHER BID IN ORDER TO VERIFY ALL EXISTING FIELD CONDITIONS. THE HVAC DRAWINGS ARE ESSENTIALLY DIAGRAMMATIC AND ANY OFFSETS DUE TO EXISTING CONDITIONS SHALL BE THE RESPONSIBILITY OF THE CONTRACTOR. COORDINATE ENTIRE INSTALLATION OF THE HVAC SYSTEM WITH THE WORK OFFSETS DUE TO EXISTING CONDITIONS SHALL BE THE RESPONSIBILITY OF THE CONTRACTOR. CONTRACTOR SHALL COORDINATE WIRRIG, FUSED DISCONNECT SWITCHES AND CONDUIT REQUIREMENTS WITH ELECTRICAL CONTRACTOR. CONTRACTOR SHALL COORDINATE WIRRIG, FUSED DISCONNECT SWITCHES AND CONDUIT REQUIREMENTS WITH ELECTRICAL CONTRACTOR. THE EXACT LOCATION OF ALL MECHANICAL EQUIPMENT SHALL BE VERIFIED WITH THE ARCHITECT XND STRUCTURAL ENGINEER PRIOR TO COMMENCEMENT OF WORK. LALL EQUIPMENT SHALL BE INSTALLATION. MAINTENANCE LABEL SHALL BE INSTALLATION. MAINTENANCE LABEL SHALL BE AFFIXED TO ALL MECHANICAL EQUIPMENT AND A MAINTENANCE MANUAL SHALL BE PROVIDED FOR H OWNERS USE. N. ALL HVAC EQUIPMENT SHALL BE CERTIFIED BY THE CALIFORNIA ENERGY COMMISSION TO COMPLY WITH EFFICIENCY STANDARDS PER TITLE-24 SECTIONS LOAD EWITH (HET FLOED SCALED, ERECTED AND OT SETSED AND ACCORDANCE WITH (HTT FLOE CALLFORNIA ENERGY COMMISSION TO COMPLY WITH EFFICIENCY STANDARDS PER TITLE-24 SECTIONS CAS314 (A)(B). ALL DUCTWORK SHALL BE CONTRUCTED, SCALED, ERECTED AND TESTED NACCORDANCENTLS, OR THE APPLICABLE STANDARDS ADOPTED BY THE SHEET METAL AND AIR CONDITIONING CONTRACTORS NATIONAL ASSOCIATION. DUCT WORK HANDLING CONDITIONED AIR SHALL BE FINDLATED O' LOCAL REGULATIONS, PROCEDURES BETALED IN THE ASHRAE HANDBOOK OF FUNDAMENTALS, OR THE APPLICABLE STANDARDS ADOPTED BY THE SHEET METAL AND AIR CONDITIONING CONTRACTORS ADOPTED BY TH	F.	
 SUBMITTING HISHER BID IN ORDER TO VERIFY ALL EXISTING FIELD CONDITIONS. THE HVAC DRAWINGS ARE ESSENTIALLY DIAGRAMMATIC AND ANY OFFSETS DUE TO EXISTING CONDITIONS SHALL BE THE RESPONSIBILITY OF THE CONTRACTOR. COORINATE ENTIRE INSTALLATION OF THE HVAC SYSTEM WITH THE WORK OF ALL OTHER TRADES PRIOR TO ANY FABRICATION OR INSTALLATION. PROVIDE ALL FITTINGS, OFFSETS AND TRANSITIONS AS REQUIRED FOR A COMPLETE WORKABLE INSTALLATION. CONTRACTOR SHALL COORDINATE WIRING, FUSED DISCONNECT SWITCHES AND CONDUIT REQUIREMENTS WITH ELECTRICAL CONTRACTOR. CONTRACTOR SHALL GOORDINATE WIRING, FUSED DISCONNECT SWITCHES AND CONDUIT REQUIREMENTS WITH ELECTRICAL CONTRACTOR. THE EXACT LOCATION OF ALL MECHANICAL EQUIPMENT SHALL BE VERIFIED WITH THE ARCHITECT AND STRUCTURAL ENGINEER PRIOR TO COMMENCEMENT OF WORK. ALL EQUIPMENT SHALL BE INSTALLATION. MAINTENANCE LABEL SHALL BE ANSTALLED IN ACCORDANCE WITH MANUFACTURER'S RECOMMENDATION. MAINTENANCE LABEL SHALL BE ARTICLE WORKABLE INSTALLATION. MAINTENANCE LABEL SHALL BE CERTIFIED BY THE CALIFORNIA ENERG' COMMISSION TO COMPLY WITH EFFICIENCY STANDARDS PER TITLE:24 SECTIONS (2-3314 (A)(B)). ALL HVAC EQUIPMENT SHALL BE CONSTRUCTED, SEALED, ERECTED AND TESTED IN ACCORDANCE WITH VHEFT 6/ CMC. THE MOST RESTRICTO PUCAURA EQUIVATIONS, PROCEDURES DETAILED IN THE ASHRAE HANDBOOK OF FUNDAMENTALS, OR THE APPLICABLE STANDARDS ADOPTED BY THE SHEET METAL AND ANE CONDITIONING CONTRACTOR NATIONAL ASSOCIATION. DUCT WORK HANDLING CONDITIONED AIR SHALL BE INSULATED OR LINED. INSULATION, SHALL BE 1*THICK, 34* LB PER CUBIC FOOT D RESIT WITH MINIMUM RE2, 1 EXCLUDING FLM RESISTANCE ALL DUCT WORK NATIONAL ASSOCIATION. PAINT INSIDE OF DUCT FLAT BLACK WHERE VISIBLE THRU AIR OUTLETS (VISIBLE LINER SHALL BE ACCESSIBLE THROUGH FEIT STRIPPED ACCESS SHALL BE INTERNALLY AND RECOMPRE VISIBLE THRU AIR OUTLETS (VISIBLE LINER SHALL BE ACCESSIBLE THROUGH FEIT STRIPPED ACCE		•
 WORK OF ALL OTHER TRADES PRIOR TO ANY FABRICATION OR INSTALLATION. PROVIDE ALL FITTINGS, OFFSETS AND TRANSITIONS AS REQUIRED FOR A COMPLETE WORKABLE INSTALLATION. CONTRACTOR SHALL COORDINATE WIRNG, FUSED DISCONDECT SWITCHES AND CONDUIT REQUIREMENTS WITH ELECTRICAL CONTRACTOR. THE EXACT LOCATION OF ALL MECHANICAL EQUIPMENT SHALL BE VERIFIED WITH THE ARCHITECT AND STRUCTURAL ENGINEER PRIOR TO COMMENCEMENT OF WORK. LI ALL EQUIPMENT SHALL BE INSTALLED IN ACCORDANCE WITH MANUFACTURER'S RECOMMENDATIONS. PROVIDE ALL FITTINGS, TRANSITIONS DAMPERS, VALVES AND OTHER DEVICES REQUIRED FOR A COMPLETE WORKABLE INSTALLATION. MAINTENANCE LABLE SHALL BE AFFIXED TO ALL MECHANICAL EQUIPMENT AND A MAINTENANCE MANUAL SHALL BE PROVIDED FOR TH OWNERS USE. ALL HVAC EQUIPMENT SHALL BE CERTIFIED BY THE CALIFORNIA ENERGY SECTIONS (25314 (A)(B)). ALL HVAC EQUIPMENT SHALL BE CONSTRUCTED, SEALED, ERECTED AND TESTED IN ACCORDANCE WITH CHPT 6 OF CMC. THE MOST RESTRICTION OF LOCAL REQULATIONS. PROCEDURES DETAILED IN THE ASHRAE HANDBOOK OF FUNDAMENTALS, OR THE APPLICABLE STANDARDS ADOPTED BY THE SHET METAL AND AIR CONDITIONING CONTRACTORS NATIONAL ASSOCIATION. DUCT WORK HANDLING CONDITIONED AIR SHALL BE INSULATED OR UNROW UNDER THE ANDLING CONDITIONED AIR SHALL BE INSULATED OR CONCECTION TO CELLING DIFFUSERS WITH INSULATED OR UNROL MONECTION TO CELLING DIFFUSERS WITH INSULATED OR UNROL MONECTION TO CELLING MERSISTANCE. ALL DUCT WORK EXPOSED SHALL BE INTERNALLY LIMED. ACOUSTIC LINER SHALLE DE 1-1/2 OMAKE CONNECTION TO CELLING MERSISTANCE. ALL DUCT WORK EXPOSED SHALL BE INTERNALLY UNED. ACOUSTIC LINER SHALL BE 1-1/2 OMAKE CONNECTION TO CELLING MERSISTANCE. ALL DUCT WORK EXPOSED SHALL BE INTERNALLY UNED. ACOUSTIC LINER SHALL BE 1-1/2 OMAKE CONNECTION TO CELLING MERSISTANCE. ALL DUCT WORK EXPOSED SHALL BE INTERNALLY UNED. ACOUSTIC LINER SHALL BE 1-1/2 OMAKE CONNECTION TO AND PRESSING AND REGISTERS. FOR CONCECLIED AN PRESSING DUCT. PR	H.	SUBMITTING HIS/HER BID IN ORDER TO VERIFY ALL EXISTING FIELD CONDITIONS. THE HVAC DRAWINGS ARE ESSENTIALLY DIAGRAMMATIC AND ANY OFFSETS DUE TO EXISTING CONDITIONS SHALL BE THE
 SWITCHES AND CONDUIT REQUIREMENTS WITH ELECTRICAL CONTRACTOR. THE EXACT LOCATION OF ALL MECHANICAL EQUIPMENT SHALL BE VERIFIED WITH THE ARCHITECT AND STRUCTURAL ENGINEER PRIOR TO COMMENCEMPT OF WORK. ALL EQUIPMENT SHALL BE INSTALLED IN ACCORDANCE WITH MANUFACTURER'S RECOMMENDATIONS. PROVIDE ALL FITTINGS, TRANSITIONS DAMPERS, VALVES AND OTHER DEVICES REQUIRED FOR A COMPLETE WORKABLE INSTALLATION. MAINTENANCE LABEL SHALL BE AFFIXED TO ALL MECHANICAL EQUIPMENT AND A MAINTENANCE MANUAL SHALL BE PROVIDED FOR TH OWNERS USE. ALL HVAC EQUIPMENT SHALL BE CERTIFIED BY THE CALIFORNIA ENERG' COMMISSION TO COMPLY WITH EFFICIENCY STANDARDS PER TITLE-24 SECTIONS (2-5314 (A)(B)). ALL DUCTWORK SHALL BE CONSTRUCTED, SEALED, ERECTED AND TESTED IN ACCORDANCE WITH CHPT 6 OF CMC. THE MOST RESTRICT OF LOCAL REGULATIONS, PROCEDURES DETALLED IN THE ASHRAE HANDBOOK OF FUNDAMENTALS, OR THE APPLICABLE STANDARDS ADOPTED BY THE SHEET METAL AND AIR CONDITIONING CONTRACTORS' NATIONAL ASSOCIATION. DUCT WORK HANDLING CONTITIONED AIR SHALL BE INSULATED OR LINED. INSULATION SHALL BE 'T THICK, 34' LB PER CUBIC FOOT DENSITY WITH MINIMUM R2.1, EXCLUDING FLIM RESISTANCE. ALL DUCT WORK EXPOSED SHALL BE INTERNALLY LINED. ACOUSTIC LINER SHALL BE 1-1/2 MAKE CONNECTION TO CEILING DIFFUSERS WITH INSULATED OR LINED. INSULATION SHALL BE INTERNALLY LINED. ACOUSTIC LINER SHALL BE 1-1/2 MAKE CONNECTION TO CEILING DIFFUSERS WITH INSULATED OR LINED. INSULATION SHALL BY ENCLUDING SERVICE OR ADJUST WITH MINIMUM. PAINT INSIDE OF DUCT FLAT BLACK WHERE VISIBLE THRU AIR OUTLETS (VISIBLE LINER SHALL BE ACCUDING SERVICE OR ADJUST MENT, PROVIDI 'SLASSFLEX' LOW PRESSURE FLEXIBLE DUCT. PROVIDE 5-0' LENGTH MINIMUM. PAINT INDUC AND PRESS SHALL BE PROVIDED IN ALL DUCT BRANCHE TAKE OFF'S TO INDIVIDUAL DIFFUSERS AND REGISTERS. FOR CONCEALED ITEMS REQUIRING SERVICE OR ADJUST MENT, PROVIDI AN ELECTRIC BALANCE DAMPERS SHALL BE A	I.	WORK OF ALL OTHER TRADES PRIOR TO ANY FABRICATION OR INSTALLATION. PROVIDE ALL FITTINGS, OFFSETS AND TRANSITIONS AS
 VERIFIED WITH THE ARCHITECT AND STRUCTURAL ENGINEER PRIOR TO COMMENCEMENT OF WORK. ALL EQUIPMENT SHALL BE INSTALLED IN ACCORDANCE WITH MANUFACTURER'S RECOMMENDATIONS. PROVIDE ALL FITTINGS, TRANSITIONS DAMPERS, VALVES AND OTHER DEVICES REQUIRED FOR A COMPLETE WORKABEL INSTALLATION. MAINTENANCE LABEL SHALL BE AFFIXED TO ALL MECHANICAL EQUIPMENT AND A MAINTENANCE MANUAL SHALL BE PROVIDED FOR TH OWNERS USE. ALL HVAC EQUIPMENT SHALL BE CERTIFIED BY THE CALIFORNIA ENERGY COMMISSION TO COMPLY WITH EFFICIENCY STANDARDS PER TITLE-24 SECTIONS (2-5314 (A)(B)). ALL DUCTWORK SHALL BE CONSTRUCTED, SEALED, ERECTED AND TESTED IN ACCORDANCE WITH CHPT. 6 OF CMC. THE MOST RESTRICTIN OF LOCAL REGULATIONS. PROCEDURES DETAILED IN THE ASHRAE HANDBOK OF FUNDAMENTALS, OR THE APPLICABLE STANDARDS ADOPTED BY THE SHEET METAL AND AIR CONDITIONING CONTRACTORS NATIONAL ASSOCIATION. DUCT WORK HANDLING CONDITIONED AIR SHALL BE INSULATED OR LINED. INSULATION SHALL BE 1'THICK, 34' LB PER CUBIC FOOT DENSITY WITH MINIMUM R*2.1 EXCLUDING FILM RESISTANCE. ALL DUCT WORK EXPOSED SHALL BE INTERNALLY LINED. ACOUSTIC LINER SHALL BE 1-1/2 MAKE CONNECTION TO CEILING DIFFUSERS WITH INSULATED "GLASSFLEX' LOW PRESSURE FLEXIBLE DUCT. PROVIDE 5'.0' LENGTH MINIMUM. PAINT INSIDE OF DUCT FLAT BLACK WHERE VISIBLE THRU AIR OUTLETS (VISIBLE LINER SHALL HAVE BLACK FACING). MANUAL VOLUME DAMPERS SHALL BE PROVIDED IN ALL DUCT BRANCHE TAKE OFFS TO INDIVIDUAL DIFFUSERS AND REGISTERS. FOR CONCEALED ITEMS REQUIRING SERVICE OR ADJUSTMENT, PROVIDI AN ELECTRIC ADARCE DAMPER WHERE NO ACCESS IS AVAILABLE. SEE SHEET MAIL DE ACCESSIBLE THROUGH FELT STRIPPED ACCESS PANEL. FLEX DUCTS SHALL BE ACCESSIBLE THROUGH FELT STRIPPED ACCESS PANEL. FLEX DUCTS SHALL BE FACTORY FABRICATED INSULATED OWNER ACCESS PANEL. FLEX DUCTS SHALL BE FACTORY FABRICATE INSULATED LOW PRESSURE DUCT WITH THE FOLLOWING CHARARCATERISTICS: 1. XINC	J.	SWITCHES AND CONDUIT REQUIREMENTS WITH ELECTRICAL
 ALL EQUIPMENT SHALL BE INSTALLED IN ACCORDANCE WITH MANUFACTURER'S RECOMMENDATIONS. PROVIDE ALL FITTINGS, TRANSITIONS DAMPERS, VALVES AND OTHER DEVICES REQUIRED FOR A COMPLETE WORKABLE INSTALLATION. MAINTENANCE LABEL SHALL BE AFFIXED TO ALL MECHANICAL EQUIPMENT AND A MAINTENANCE MANUAL SHALL BE PROVIDED FOR TH OWNERS USE. ALL HVAC EQUIPMENT SHALL BE CERTIFIED BY THE CALIFORNIA ENERG' COMMISSION TO COMPLY WITH EFFICIENCY STANDARDS PER TITLE-24 SECTIONS (2-5314 (A)(B)). ALL DUCTWORK SHALL BE CONSTRUCTED, SEALED, ERECTED AND TESTED IN ACCORDANCE WITH CHPT. 6 OF CMC. THE MOST RESTRICTIN OF LOCAL REGULATIONS. PROCEDURES DETAILED IN THE ASHRAE HANDBOOK OF FUNDAMENTALS, OR THE APPLICABLE STANDARDS ADOPTED BY THE SHEET METAL AND AIR CONDITIONING CONTRACTORS NATIONAL ASSOCIATION. DUCT WORK HANDLING CONDITIONED AIR SHALL BE INSULATED OR LINED. INSULATION SHALL BE 1" THICK, 3/4" LB PER CUBIC FOOT DENSITY WITH MINUM R=2.1, EXCLUDING FILM RESISTANCE. ALL DUCT WORK EXPOSED SHALL BE INTERNALLY LINED. ACOUSTIC LINER SHALL BE 1-1/2 MAKE CONNECTION TO CEILING DIFFUSERS WITH INSULATED "GLASSFLEX" LOW PRESSURE FLEXIBLE DUCT. PROVIDE 5-0" LENGTH MINIMUM. PAINT INSIDE OF DUCT FLAT BLACK WHERE VISIBLE THRU AIR OUTLETS (VISIBLE LINER SHALL HAVE BLACK FACING). MANUAL VOLUME DAMPERS SHALL BE PROVIDED IN ALL DUCT BRANCHE TAKE OFFS TO INDIVIDUAL DIFFUSERS AND REGISTERS. FOR CONCEALED ITEMS REQUIRING SERVICE OR ADJUSTMENT, PROVID AN ELECTRIC BALANCE DAMPER WHERE NO ACCESS IS AVAILABLE. SEE SHEET M401 DETAIL 7. ALL DAMPERS SHALL BE ACCESSIBLE THROUGH FELT STRIPPED ACCESS IS AVAILABLE. REAME AND TAG FOR EASY IDENTIFICATION AFTER INSTALLATION. DAMPERS IN LAY-IN CEILING AREA DO NOT REQUIRE ACCESS PANEL. FLEXIBLE DUCTS SHALL BE ACCESSIBLE THROUGH FELT STRIPPED ACCESS IS AVAILABLE. REME AND TAG FOR CARACTERISTICS: ZINC CONTRACTOR SHALL BE ACCESSIBLE THROUGH FELT STRIPPED ACCESS IS AND DATAIL	K.	THE EXACT LOCATION OF ALL MECHANICAL EQUIPMENT SHALL BE VERIFIED WITH THE ARCHITECT AND STRUCTURAL ENGINEER PRIOR TO
 MAINTENANCE LABEL SHALL BE AFFIXED TO ALL MECHANICAL EQUIPMENT AND A MAINTENANCE MANUAL SHALL BE PROVIDED FOR TH OWNERS USE. ALL HVAC EQUIPMENT SHALL BE CERTIFIED BY THE CALIFORNIA ENERG' COMMISSION TO COMPLY WITH EFFICIENCY STANDARDS PER TITLE-24 SECTIONS (2-5314 (A)(B)). ALL DUCTWORK SHALL BE CONSTRUCTED, SEALED, ERECTED AND TESTED IN ACCORDANCE WITH CHPT. 6 OF CMC. THE MOST RESTRICTIN OF LOCAL REGULATIONS, PROCEDURES DETAILED IN THE ASHRAE HANDBOOK OF FUNDAMENTALS, OR THE APPLICABLE STANDARDS ADOPTED BY THE SHEET METAL AND AIR CONDITIONING CONTRACTORS NATIONAL ASSOCIATION. DUCT WORK HANDLING CONDITIONED AIR SHALL BE INSULATED OR LINED. INSULATION SHALL BE 1" THICK, 3/4" LB PER CUBIC FOOT DENSITY WITH MINIMUM R=2.1, EXCLUDING FILM RESISTANCE. ALL DUCT WORK EXPOSED SHALL BE INTERNALLY LINED. ACOUSTIC LINER SHALL BE 1-1/2 MAKE CONNECTION TO CELING DIFFUSERS WITH INSULATED "GLASSFLEX" LOW PRESSURE FLEXIBLE DUCT. PROVIDE 5'-0" LENGTH MINIMUM. PAINT INSIDE OF DUCT FLAT BLACK WHERE VISIBLE THRU AIR OUTLETS (VISIBLE LINER SHALL HAVE BLACK FACING). MANUAL VOLUME DAMPERS SHALL BE PROVIDED IN ALL DUCT BRANCHE TAKE OFFS TO INDIVIDUAL DIFFUSERS AND REGISTERS. FOR CONCEALED ITEMS REQUIRING SERVICE OR ADJUSTMENT, PROVIDI AN ELECTRIC BALANCE DAMPER WHERE NO ACCESS IS AVAILABLE. SEE SHEET M401 DETAIL 7. ALL DAMPERS SHALL BE ACCESSIBLE THROUGH FELT STRIPPED ACCESS PANEL IN DUCT AND SHALL BE THE FULL SIZE OF THE DUCT, CONSTRUCT WITH CHANNEL FRAME AND TAG FOR EASY IDENTIFICATION AFTER INSTALLATION. DAMPERS IN LAY-IN CEILING AREA DO NOT REQUIRE ACCESS PANEL. FLEX DUCTS ARE NOT ALLOWED FOR TOILET EXHAUST. FLEXIBLE DUCTS SHALL BE FACTORY FABRICATED INSULATED LOW PRESSURE DUCT WITH THE FOLLOWING CHARACTERISTICS: INSTRUCTOR SHALL BE ACCESSIBLE THROUGH FELT STRIPPED ACCESS PANEL. FLEXIBLE DUCT SHALL BE FACTORY FABRICATED INSULATED LOW PRESSURE DUCT WITH THE FOLLOWING CHARACTERISTI	L.	ALL EQUIPMENT SHALL BE INSTALLED IN ACCORDANCE WITH MANUFACTURER'S RECOMMENDATIONS. PROVIDE ALL FITTINGS, TRANSITIONS DAMPERS, VALVES AND OTHER DEVICES REQUIRED FOR A
 ALL HVAC EQUIPMENT SHALL BE CERTIFIED BY THE CALIFORNIA ENERGY COMMISSION TO COMPLY WITH EFFICIENCY STANDARDS PER TITLE-24 SECTIONS (2-5314 (A)(B)). ALL DUCTWORK SHALL BE CONSTRUCTED, SEALED, ERECTED AND TESTED IN ACCORDANCE WITH CHPT. 6 OF CMC. THE MOST RESTRICTIN OF LOCAL REGULATIONS, PROCEDURES DETAILED IN THE ASHRAE HANDBOOK OF FUNDAMENTALS, OR THE APPLICABLE STANDARDS ADOPTED BY THE SHEET METAL AND AIR CONDITIONING CONTRACTORS NATIONAL ASSOCIATION. DUCT WORK HANDLING CONDITIONED AIR SHALL BE INSULATED OR LINED. INSULATION SHALL BE 1" THICK, 3/4" LB PER CUBIC FOOT DENSITY WITH MINIMUM R=2.1, EXCLUDING FILM RESISTANCE. ALL DUCT WORK EXPOSED SHALL BE INTERNALLY LINED. ACOUSTIC LINER SHALL BE 1-1/2 MAKE CONNECTION TO CEILING DIFFUSERS WITH INSULATED "GLASSFLEX" LOW PRESSURE FLEXIBLE DUCT. PROVIDE 5'-0" LENGTH MINIMUM. PAINT INSIDE OF DUCT FLAT BLACK WHERE VISIBLE THRU AIR OUTLETS (VISIBLE LINER SHALL HAVE BLACK FACING). MANUAL VOLUME DAMPERS SHALL BE PROVIDED IN ALL DUCT BRANCHE TAKE OFFS TO INDIVIDUAL DIFFUSERS AND REGISTERS. FOR CONCEALED ITEMS REQUIRING SERVICE OR ADJUSTMENT, PROVIDI AN ELECTRIC BALANCE DAMPER WHERE NO ACCESS IS AVAILABLE. SEE SHEET M401 DETAIL 7. ALL DAMPERS SHALL BE ACCESSIBLE THROUGH FELT STRIPPED ACCESS PANEL IN DUCT AND SHALL BE THE FULL SIZE OF THE DUCT, CONSTRUC WITH CHANNEL FRAME AND TAG FOR EASY IDENTIFICATION AFTER INSTALLATION. DAMPERS IN LAY-IN CEILING AREA DO NOT REQUIRE ACCESS PANEL. FLEX DUCTS ARE NOT ALLOWED FOR TOILET EXHAUST. V FLEX DUCTS SHALL BE FACTORY FABRICATED INSULATED LOW PRESSURE DUCT WITH THE FOLLOWING CHARACTERISTICS: ZINC COATED SPRING STEEL HELIX WITH (1) ONE INCH THICK FIBERGLASS INSULATION, SHEATHED IN A SEAMLESS VAPOR BARRIER JACKET. INTERIOR FIRE RESISTANT COATED TO PREVENT FIBER EROSION. CLASS 1 WITH A FLAME SPREAD OF 25 OR LESS, SMOKE DEVELOPED O 50 OR LESS AS DEFINED IN NFPA-90(A) AND BEARING A U.L. LABEL. ALL LINE AND LOW VOLTAG		MAINTENANCE LABEL SHALL BE AFFIXED TO ALL MECHANICAL EQUIPMENT AND A MAINTENANCE MANUAL SHALL BE PROVIDED FOR THE
 ALL DUCTWORK SHALL BE CONSTRUCTED, SEALED, ERECTED AND TESTED IN ACCORDANCE WITH CHPT. 6 OF CMC. THE MOST RESTRICTIN OF LOCAL REGULATIONS, PROCEDURES DETAILED IN THE ASHRAE HANDBOOK OF FUNDAMENTALS, OR THE APPLICABLE STANDARDS ADOPTED BY THE SHEET METAL AND AIR CONDITIONING CONTRACTORS NATIONAL ASSOCIATION. DUCT WORK HANDLING CONDITIONED AIR SHALL BE INSULATED OR LINED. INSULATION SHALL BE 1" THICK, 34" LB PER CUBIC FOOT DENSITY WITH MINIMUM R=2.1, EXCLUDING FILM RESISTANCE. ALL DUCT WORK EXPOSED SHALL BE INTERNALLY LINED. ACOUSTIC LINER SHALL BE 1-1/2 MAKE CONNECTION TO CEILING DIFFUSERS WITH INSULATED "GLASSFLEX" LOW PRESSURE FLEXIBLE DUCT. PROVIDE 5'-0" LENGTH MINIMUM. PAINT INSIDE OF DUCT FLAT BLACK WHERE VISIBLE THRU AIR OUTLETS (VISIBLE LINER SHALL HAVE BLACK FACING). MANUAL VOLUME DAMPERS SHALL BE PROVIDED IN ALL DUCT BRANCHE TAKE OFFS TO INDIVIDUAL DIFFUSERS AND REGISTERS. FOR CONCEALED ITEMS REQUIRING SERVICE OR ADJUSTMENT, PROVIDI AN ELECTRIC BALANCE DAMPER WHERE NO ACCESS IS AVAILABLE. SEE SHEET M401 DETAIL 7. ALL DAMPERS SHALL BE ACCESSIBLE THROUGH FELT STRIPPED ACCESS PANEL IN DUCT AND SHALL BE THE FULL SIZE OF THE DUCT, CONSTRUCT WITH CHANNEL FRAME AND TAG FOR EASY IDENTIFICATION AFTER INSTALLATION. DAMPERS IN LAY-IN CEILING AREA DO NOT REQUIRE ACCESS PANEL. FLEX DUCTS ARE NOT ALLOWED FOR TOILET EXHAUST. FLEXIBLE DUCTS SHALL BE FACTORY FABRICATED INSULATED LOW PRESSURE DUCT WITH THE FOLLOWING CHARACTERISTICS: ZINC COATED STRING STEEL HELX WITH (1) ONE INCH THICK FIBERGLASS INSULATION, SHEATHED IN A SEAMLESS VAPOR BARRIER JACKET. INTERIOR FIRE RESISTANT COATED TO PREVENT FIBER EROSION. CLASS 1 WITH A FLAME SPREAD OF 25 OR LESS, SMOKE DEVELOPED O 50 OR LESS AS DEFINED IN NFPA-90(A) AND BEARING A ULL LABEL. Y. ALL LINE AND LOW VOLTAGE WIRING SHALL BE INSTALLED IN A CONDUIT ALL CONDUITS SHALL BE FACTORY FABRICATED INSULATED LOW PRESSURE DUCT WITH THE FOLLOWING CHARACTERISTICS: 	N.	ALL HVAC EQUIPMENT SHALL BE CERTIFIED BY THE CALIFORNIA ENERGY
 P. DUCT WORK HANDLING CONDITIONED AIR SHALL BE INSULATED OR LINED. INSULATION SHALL BE 1" THICK, 3/4" LB PER CUBIC FOOT DENSITY WITH MINIMUM R=2.1, EXCLUDING FILM RESISTANCE. ALL DUCT WORK EXPOSED SHALL BE INTERNALLY LINED. ACOUSTIC LINER SHALL BE 1-1/2 Q. MAKE CONNECTION TO CEILING DIFFUSERS WITH INSULATED "GLASSFLEX" LOW PRESSURE FLEXIBLE DUCT. PROVIDE 5-0" LENGTH MINIMUM. R. PAINT INSIDE OF DUCT FLAT BLACK WHERE VISIBLE THRU AIR OUTLETS (VISIBLE LINER SHALL HAVE BLACK FACING). S. MANUAL VOLUME DAMPERS SHALL BE PROVIDED IN ALL DUCT BRANCHE TAKE OFF'S TO INDIVIDUAL DIFFUSERS AND REGISTERS. T. FOR CONCEALED ITEMS REQUIRING SERVICE OR ADJUSTMENT, PROVIDI AN ELECTRIC BALANCE DAMPER WHERE NO ACCESS IS AVAILABLE. SEE SHEET M401 DETAIL 7. U. ALL DAMPERS SHALL BE ACCESSIBLE THROUGH FELT STRIPPED ACCESS PANEL IN DUCT AND SHALL BE THE FULL SIZE OF THE DUCT, CONSTRUC WITH CHANNEL FRAME AND TAG FOR EASY IDENTIFICATION AFTER INSTALLATION. DAMPERS IN LAY-IN CEILING AREA DO NOT REQUIRE ACCESS PANEL. V. FLEX DUCTS ARE NOT ALLOWED FOR TOILET EXHAUST. W. FLEXIBLE DUCTS SHALL BE FACTORY FABRICATED INSULATED LOW PRESSURE DUCT WITH THE FOLLOWING CHARACTERISTICS: I. ZINC COATED SPRING STEEL HELIX WITH (1) ONE INCH THICK FIBERGLASS INSULATION, SHEATHED IN A SEAMLESS VAPOR BARRIER JACKET. I. INTERIOR FIRE RESISTANT COATED TO PREVENT FIBER EROSION. CLASS 1 WITH A FLAME SPREAD OF 25 OR LESS, SMOKE DEVELOPED O 50 OR LESS AS DEFINED IN NFPA-90(A) AND BEARING A U.L. LABEL. Y. ALL LINE AND LOW VOLTAGE WIRING SHALL BE INSTALLED IN A CONDUIT ALL CONDUITS SHALL BE FURNISHED AND INSTALLED IN A CONDUIT ALL CONDUITS SHALL BE FURNISG SHALL BE INSTALLED IN A CONDUIT ALL CONDUITS SHALL BE FURNISG SHALL BE INSTALLED IN A CONDUIT ALL CONDUITS SHALL BE FURNISG BOLES HAVING JURISDICTION THEREOF. Z. CONTRACTOR SHALL RAISE EXISTING DUCTWORK TO ACCOMMODATE NEW CEILING HEIGHT AS NEEDED. A. RE-BALANCE THE SYSTEM AIRFLOW PER THE NEW	0.	ALL DUCTWORK SHALL BE CONSTRUCTED, SEALED, ERECTED AND TESTED IN ACCORDANCE WITH CHPT. 6 OF CMC. THE MOST RESTRICTIV OF LOCAL REGULATIONS, PROCEDURES DETAILED IN THE ASHRAE HANDBOOK OF FUNDAMENTALS, OR THE APPLICABLE STANDARDS ADOPTED BY THE SHEET METAL AND AIR CONDITIONING CONTRACTORS
 "GLASSFLEX" LOW PRESSURE FLEXIBLE DUCT. PROVIDE 5'-0" LENGTH MINIMUM. R. PAINT INSIDE OF DUCT FLAT BLACK WHERE VISIBLE THRU AIR OUTLETS (VISIBLE LINER SHALL HAVE BLACK FACING). S. MANUAL VOLUME DAMPERS SHALL BE PROVIDED IN ALL DUCT BRANCHE TAKE OFF'S TO INDIVIDUAL DIFFUSERS AND REGISTERS. T. FOR CONCEALED ITEMS REQUIRING SERVICE OR ADJUSTMENT, PROVIDI AN ELECTRIC BALANCE DAMPER WHERE NO ACCESS IS AVAILABLE. SEE SHEET M401 DETAIL 7. U. ALL DAMPERS SHALL BE ACCESSIBLE THROUGH FELT STRIPPED ACCESS PANEL IN DUCT AND SHALL BE THE FULL SIZE OF THE DUCT, CONSTRUC WITH CHANNEL FRAME AND TAG FOR EASY IDENTIFICATION AFTER INSTALLATION. DAMPERS IN LAY-IN CEILING AREA DO NOT REQUIRE ACCESS PANEL. V. FLEX DUCTS ARE NOT ALLOWED FOR TOILET EXHAUST. W. FLEXIBLE DUCTS SHALL BE FACTORY FABRICATED INSULATED LOW PRESSURE DUCT WITH THE FOLLOWING CHARACTERISTICS: 1. ZINC COATED SPRING STEEL HELIX WITH (1) ONE INCH THICK FIBERGLASS INSULATION, SHEATHED IN A SEAMLESS VAPOR BARRIER JACKET. 2. INTERIOR FIRE RESISTANT COATED TO PREVENT FIBER EROSION. 3. CLASS 1 WITH A FLAME SPREAD OF 25 OR LESS, SMOKE DEVELOPED O 50 OR LESS AS DEFINED IN NFPA-90(A) AND BEARING A U.L. LABEL. Y. ALL LINE AND LOW VOLTAGE WIRING SHALL BE INSTALLED IN A CONDUIT ALL CONDUITS SHALL BE FURNISHED AND INSTALLED IN A CONDUIT ALL CONDUITS SHALL BE INSTALLED IN ACCORDANCE WITH ALL APPLICABLE CODES AN REGULATIONS OF GOVERNING BODIES HAVING JURISDICTION THEREOF. Z. CONTRACTOR SHALL RAISE EXISTING DUCTWORK TO ACCOMMODATE NEW CEILING HEIGHT AS NEEDED. A.R. RE-BALANCE THE SYSTEM AIRFLOW PER THE NEW MECHANICAL PLANS THAT'S INCLUDE DIFFUSERS, GRILLES & VAV BOXES. AB. REUSE ALL THE EXISTING THERMOSTATS AND RELOCATE SOME OF THEI AS NOTED ON THE MECHANICAL PLAN TO COMPLY WITH RENOVATION A 		DUCT WORK HANDLING CONDITIONED AIR SHALL BE INSULATED OR LINED. INSULATION SHALL BE 1" THICK, 3/4" LB PER CUBIC FOOT DENSITY
 (VISIBLE LINER SHALL HAVE BLACK FACING). S. MANUAL VOLUME DAMPERS SHALL BE PROVIDED IN ALL DUCT BRANCHE TAKE OFF'S TO INDIVIDUAL DIFFUSERS AND REGISTERS. T. FOR CONCEALED ITEMS REQUIRING SERVICE OR ADJUSTMENT, PROVIDI AN ELECTRIC BALANCE DAMPER WHERE NO ACCESS IS AVAILABLE. SEE SHEET M401 DETAIL 7. U. ALL DAMPERS SHALL BE ACCESSIBLE THROUGH FELT STRIPPED ACCESS PANEL IN DUCT AND SHALL BE THE FULL SIZE OF THE DUCT, CONSTRUCT WITH CHANNEL FRAME AND TAG FOR EASY IDENTIFICATION AFTER INSTALLATION. DAMPERS IN LAY-IN CEILING AREA DO NOT REQUIRE ACCESS PANEL. V. FLEX DUCTS ARE NOT ALLOWED FOR TOILET EXHAUST. W. FLEXIBLE DUCTS SHALL BE FACTORY FABRICATED INSULATED LOW PRESSURE DUCT WITH THE FOLLOWING CHARACTERISTICS: 1. ZINC COATED SPRING STEEL HELIX WITH (1) ONE INCH THICK FIBERGLASS INSULATION, SHEATHED IN A SEAMLESS VAPOR BARRIER JACKET. 2. INTERIOR FIRE RESISTANT COATED TO PREVENT FIBER EROSION. 3. CLASS 1 WITH A FLAME SPREAD OF 25 OR LESS, SMOKE DEVELOPED O 50 OR LESS AS DEFINED IN NFPA-90(A) AND BEARING A U.L. LABEL. Y. ALL LINE AND LOW VOLTAGE WIRING SHALL BE INSTALLED IN A CONDUIT ALL CONDUITS AHALL BE FURISHED AND INSTALLED BY THE ELECTRICAL CONTRACTOR AS INDICATED ON THE ELECTRICAL DRAWINGS OR AS SPECIFIED IN THE ELECTRICAL SPECIFICATIONS. ALL ELECTRICAL WORK SHALL BE INSTALLED IN ACCORDANCE WITH ALL APPLICABLE CODES AN REGULATIONS OF GOVERNING BODIES HAVING JURISDICTION THEREOF. Z. CONTRACTOR SHALL RAISE EXISTING DUCTWORK TO ACCOMMODATE NEW CEILING HEIGHT AS NEEDED. AA. RE-BALANCE THE SYSTEM AIRFLOW PER THE NEW MECHANICAL PLANS THAT'S INCLUDE DIFFUSERS, GRILLES & VAV BOXES. AB. REUSE ALL THE EXISTING THERMOSTATS AND RELOCATE SOME OF THEI AS NOTED ON THE MECHANICAL PLAN TO COMPLY WITH RENOVATION AND THAT'S INCLUDE DIFFUSERS, GRILLES & VAV BOXES. 	Q.	"GLASSFLEX" LOW PRESSURE FLEXIBLE DUCT. PROVIDE 5'-0" LENGTH
 TAKE OFF'S TO INDIVIDUAL DIFFUSERS AND REGISTERS. T. FOR CONCEALED ITEMS REQUIRING SERVICE OR ADJUSTMENT, PROVIDIAN ELECTRIC BALANCE DAMPER WHERE NO ACCESS IS AVAILABLE. SEESHEET M401 DETAIL 7. U. ALL DAMPERS SHALL BE ACCESSIBLE THROUGH FELT STRIPPED ACCESS PANEL IN DUCT AND SHALL BE THE FULL SIZE OF THE DUCT, CONSTRUCT WITH CHANNEL FRAME AND TAG FOR EASY IDENTIFICATION AFTER INSTALLATION. DAMPERS IN LAY-IN CEILING AREA DO NOT REQUIRE ACCESS PANEL. V. FLEX DUCTS ARE NOT ALLOWED FOR TOILET EXHAUST. W. FLEXIBLE DUCTS SHALL BE FACTORY FABRICATED INSULATED LOW PRESSURE DUCT WITH THE FOLLOWING CHARACTERISTICS: ZINC COATED SPRING STEEL HELIX WITH (1) ONE INCH THICK FIBERGLASS INSULATION, SHEATHED IN A SEAMLESS VAPOR BARRIER JACKET. INTERIOR FIRE RESISTANT COATED TO PREVENT FIBER EROSION. CLASS 1 WITH A FLAME SPREAD OF 25 OR LESS, SMOKE DEVELOPED O 50 OR LESS AS DEFINED IN NFPA-90(A) AND BEARING A U.L. LABEL. Y. ALL LINE AND LOW VOLTAGE WIRING SHALL BE INSTALLED IN A CONDUIT ALL CONDUITS SHALL BE FURNISHED AND INSTALLED BY THE ELECTRICA CONTRACTOR AS INDICATED ON THE ELECTRICAL DRAWINGS OR AS SPECIFIED IN THE ELECTRICAL SPECIFICATIONS. ALL ELECTRICAL WORK SHALL BE INSTALLED IN ACCORDANCE WITH ALL APPLICABLE CODES AN REGULATIONS OF GOVERNING BODIES HAVING JURISDICTION THEREOF. CONTRACTOR SHALL RAISE EXISTING DUCTWORK TO ACCOMMODATE NEW CEILING HEIGHT AS NEEDED. AA. RE-BALANCE THE SYSTEM AIRFLOW PER THE NEW MECHANICAL PLANS THAT'S INCLUDE DIFFUSERS, GRILLES & VAV BOXES. AB. REUSE ALL THE EXISTING THERMOSTATS AND RELOCATE SOME OF THEI AS NOTED ON THE MECHANICAL PLAN TO COMPLY WITH RENOVATION AND AND AND AND AND AND AND AND AND AN		
 AN ELECTRIC BALANCE DAMPER WHERE NO ACCESS IS AVAILABLE. SEE SHEET M401 DETAIL 7. U. ALL DAMPERS SHALL BE ACCESSIBLE THROUGH FELT STRIPPED ACCESS PANEL IN DUCT AND SHALL BE THE FULL SIZE OF THE DUCT, CONSTRUCT WITH CHANNEL FRAME AND TAG FOR EASY IDENTIFICATION AFTER INSTALLATION. DAMPERS IN LAY-IN CEILING AREA DO NOT REQUIRE ACCESS PANEL. V. FLEX DUCTS ARE NOT ALLOWED FOR TOILET EXHAUST. W. FLEXIBLE DUCTS SHALL BE FACTORY FABRICATED INSULATED LOW PRESSURE DUCT WITH THE FOLLOWING CHARACTERISTICS: 1. ZINC COATED SPRING STEEL HELIX WITH (1) ONE INCH THICK FIBERGLASS INSULATION, SHEATHED IN A SEAMLESS VAPOR BARRIER JACKET. 2. INTERIOR FIRE RESISTANT COATED TO PREVENT FIBER EROSION. 3. CLASS 1 WITH A FLAME SPREAD OF 25 OR LESS, SMOKE DEVELOPED O 50 OR LESS AS DEFINED IN NFPA-90(A) AND BEARING A U.L. LABEL. Y. ALL LINE AND LOW VOLTAGE WIRING SHALL BE INSTALLED IN A CONDUIT ALL CONDUITS SHALL BE FURNISHED AND INSTALLED BY THE ELECTRICA CONTRACTOR AS INDICATED ON THE ELECTRICAL DRAWINGS OR AS SPECIFIED IN THE ELECTRICAL SPECIFICATIONS. ALL ELECTRICAL WORK SHALL BE INSTALLED IN ACCORDANCE WITH ALL APPLICABLE CODES AN REGULATIONS OF GOVERNING BODIES HAVING JURISDICTION THEREOF. Z. CONTRACTOR SHALL RAISE EXISTING DUCTWORK TO ACCOMMODATE NEW CEILING HEIGHT AS NEEDED. A. RE-BALANCE THE SYSTEM AIRFLOW PER THE NEW MECHANICAL PLANS THAT'S INCLUDE DIFFUSERS, GRILLES & VAV BOXES. AB. REUSE ALL THE EXISTING THERMOSTATS AND RELOCATE SOME OF THEI AS NOTED ON THE MECHANICAL PLAN TO COMPLY WITH RENOVATION AND ASTICLE AND THE MECHANICAL PLANS THAT'S INCLUDE DIFFUSERS, GRILLES AND RELOCATE SOME OF THEI AS NOTED ON THE MECHANICAL PLAN TO COMPLY WITH RENOVATION AND ASTICLED AND THE MECHANICAL PLAN TO COMPLY WITH RENOVATION AND ASTICLED AND THE MECHANICAL PLAN TO COMPLY WITH RENOVATION AND ASTICLED AND THE MECHANICAL PLAN TO COMPLY WITH RENOVATION AND ASTICLED AND THE MECHANICAL PLAN TO COMPLY WITH RENOVATION AND ASTICLED AND THE MECHANICAL		MANUAL VOLUME DAMPERS SHALL BE PROVIDED IN ALL DUCT BRANCHES TAKE OFF'S TO INDIVIDUAL DIFFUSERS AND REGISTERS.
 PANEL IN DUCT AND SHALL BE THE FULL SIZE OF THE DUCT, CONSTRUCT WITH CHANNEL FRAME AND TAG FOR EASY IDENTIFICATION AFTER INSTALLATION. DAMPERS IN LAY-IN CEILING AREA DO NOT REQUIRE ACCESS PANEL. V. FLEX DUCTS ARE NOT ALLOWED FOR TOILET EXHAUST. W. FLEXIBLE DUCTS SHALL BE FACTORY FABRICATED INSULATED LOW PRESSURE DUCT WITH THE FOLLOWING CHARACTERISTICS: ZINC COATED SPRING STEEL HELIX WITH (1) ONE INCH THICK FIBERGLASS INSULATION, SHEATHED IN A SEAMLESS VAPOR BARRIER JACKET. INTERIOR FIRE RESISTANT COATED TO PREVENT FIBER EROSION. CLASS 1 WITH A FLAME SPREAD OF 25 OR LESS, SMOKE DEVELOPED O 50 OR LESS AS DEFINED IN NFPA-90(A) AND BEARING A U.L. LABEL. Y. ALL LINE AND LOW VOLTAGE WIRING SHALL BE INSTALLED IN A CONDUIT ALL CONDUITS SHALL BE FURNISHED AND INSTALLED BY THE ELECTRICAL CONTRACTOR AS INDICATED ON THE ELECTRICAL DRAWINGS OR AS SPECIFIED IN THE ELECTRICAL SPECIFICATIONS. ALL ELECTRICAL WORK SHALL BE INSTALLED IN ACCORDANCE WITH ALL APPLICABLE CODES AN REGULATIONS OF GOVERNING BODIES HAVING JURISDICTION THEREOF. Z. CONTRACTOR SHALL RAISE EXISTING DUCTWORK TO ACCOMMODATE NEW CEILING HEIGHT AS NEEDED. AA. RE-BALANCE THE SYSTEM AIRFLOW PER THE NEW MECHANICAL PLANS THAT'S INCLUDE DIFFUSERS, GRILLES & VAV BOXES. AB. REUSE ALL THE EXISTING THERMOSTATS AND RELOCATE SOME OF THEI AS NOTED ON THE MECHANICAL PLAN TO COMPLY WITH RENOVATION AND AND AND AND AND AND AND AND AND AN	Т.	FOR CONCEALED ITEMS REQUIRING SERVICE OR ADJUSTMENT, PROVIDE AN ELECTRIC BALANCE DAMPER WHERE NO ACCESS IS AVAILABLE. SEE SHEET M401 DETAIL 7.
 V. FLEX DUCTS ARE NOT ALLOWED FOR TOILET EXHAUST. W. FLEXIBLE DUCTS SHALL BE FACTORY FABRICATED INSULATED LOW PRESSURE DUCT WITH THE FOLLOWING CHARACTERISTICS: ZINC COATED SPRING STEEL HELIX WITH (1) ONE INCH THICK FIBERGLASS INSULATION, SHEATHED IN A SEAMLESS VAPOR BARRIER JACKET. INTERIOR FIRE RESISTANT COATED TO PREVENT FIBER EROSION. CLASS 1 WITH A FLAME SPREAD OF 25 OR LESS, SMOKE DEVELOPED O 50 OR LESS AS DEFINED IN NFPA-90(A) AND BEARING A U.L. LABEL. Y. ALL LINE AND LOW VOLTAGE WIRING SHALL BE INSTALLED IN A CONDUIT ALL CONDUITS SHALL BE FURNISHED AND INSTALLED BY THE ELECTRIC/ CONTRACTOR AS INDICATED ON THE ELECTRICAL DRAWINGS OR AS SPECIFIED IN THE ELECTRICAL SPECIFICATIONS. ALL ELECTRICAL WORK SHALL BE INSTALLED IN ACCORDANCE WITH ALL APPLICABLE CODES AN REGULATIONS OF GOVERNING BODIES HAVING JURISDICTION THEREOF. Z. CONTRACTOR SHALL RAISE EXISTING DUCTWORK TO ACCOMMODATE NEW CEILING HEIGHT AS NEEDED. AA. RE-BALANCE THE SYSTEM AIRFLOW PER THE NEW MECHANICAL PLANS THAT'S INCLUDE DIFFUSERS, GRILLES & VAV BOXES. AB. REUSE ALL THE EXISTING THERMOSTATS AND RELOCATE SOME OF THEI AS NOTED ON THE MECHANICAL PLAN TO COMPLY WITH RENOVATION AND 		PANEL IN DUCT AND SHALL BE THE FULL SIZE OF THE DUCT, CONSTRUCT WITH CHANNEL FRAME AND TAG FOR EASY IDENTIFICATION AFTER INSTALLATION. DAMPERS IN LAY-IN CEILING AREA DO NOT REQUIRE
 PRESSURE DUCT WITH THE FOLLOWING CHARACTERISTICS: I. ZINC COATED SPRING STEEL HELIX WITH (1) ONE INCH THICK FIBERGLASS INSULATION, SHEATHED IN A SEAMLESS VAPOR BARRIER JACKET. INTERIOR FIRE RESISTANT COATED TO PREVENT FIBER EROSION. CLASS 1 WITH A FLAME SPREAD OF 25 OR LESS, SMOKE DEVELOPED O 50 OR LESS AS DEFINED IN NFPA-90(A) AND BEARING A U.L. LABEL. Y. ALL LINE AND LOW VOLTAGE WIRING SHALL BE INSTALLED IN A CONDUIT ALL CONDUITS SHALL BE FURNISHED AND INSTALLED BY THE ELECTRIC/ CONTRACTOR AS INDICATED ON THE ELECTRICAL DRAWINGS OR AS SPECIFIED IN THE ELECTRICAL SPECIFICATIONS. ALL ELECTRICAL WORK SHALL BE INSTALLED IN ACCORDANCE WITH ALL APPLICABLE CODES AN REGULATIONS OF GOVERNING BODIES HAVING JURISDICTION THEREOF. Z. CONTRACTOR SHALL RAISE EXISTING DUCTWORK TO ACCOMMODATE NEW CEILING HEIGHT AS NEEDED. AA. RE-BALANCE THE SYSTEM AIRFLOW PER THE NEW MECHANICAL PLANS THAT'S INCLUDE DIFFUSERS, GRILLES & VAV BOXES. AB. REUSE ALL THE EXISTING THERMOSTATS AND RELOCATE SOME OF THEI AS NOTED ON THE MECHANICAL PLAN TO COMPLY WITH RENOVATION AND 	V.	FLEX DUCTS ARE NOT ALLOWED FOR TOILET EXHAUST.
 50 OR LESS AS DEFINED IN NFPA-90(A) AND BEARING A U.L. LABEL. Y. ALL LINE AND LOW VOLTAGE WIRING SHALL BE INSTALLED IN A CONDUIT ALL CONDUITS SHALL BE FURNISHED AND INSTALLED BY THE ELECTRICA CONTRACTOR AS INDICATED ON THE ELECTRICAL DRAWINGS OR AS SPECIFIED IN THE ELECTRICAL SPECIFICATIONS. ALL ELECTRICAL WORK SHALL BE INSTALLED IN ACCORDANCE WITH ALL APPLICABLE CODES AN REGULATIONS OF GOVERNING BODIES HAVING JURISDICTION THEREOF. Z. CONTRACTOR SHALL RAISE EXISTING DUCTWORK TO ACCOMMODATE NEW CEILING HEIGHT AS NEEDED. AA. RE-BALANCE THE SYSTEM AIRFLOW PER THE NEW MECHANICAL PLANS THAT'S INCLUDE DIFFUSERS, GRILLES & VAV BOXES. AB. REUSE ALL THE EXISTING THERMOSTATS AND RELOCATE SOME OF THEI AS NOTED ON THE MECHANICAL PLAN TO COMPLY WITH RENOVATION AND 	1.	PRESSURE DUCT WITH THE FOLLOWING CHARACTERISTICS: ZINC COATED SPRING STEEL HELIX WITH (1) ONE INCH THICK FIBERGLASS INSULATION, SHEATHED IN A SEAMLESS VAPOR BARRIER JACKET.
 ALL CONDUITS SHALL BE FURNISHED AND INSTALLED BY THE ELECTRIC/ CONTRACTOR AS INDICATED ON THE ELECTRICAL DRAWINGS OR AS SPECIFIED IN THE ELECTRICAL SPECIFICATIONS. ALL ELECTRICAL WORK SHALL BE INSTALLED IN ACCORDANCE WITH ALL APPLICABLE CODES AN REGULATIONS OF GOVERNING BODIES HAVING JURISDICTION THEREOF. Z. CONTRACTOR SHALL RAISE EXISTING DUCTWORK TO ACCOMMODATE NEW CEILING HEIGHT AS NEEDED. AA. RE-BALANCE THE SYSTEM AIRFLOW PER THE NEW MECHANICAL PLANS THAT'S INCLUDE DIFFUSERS, GRILLES & VAV BOXES. AB. REUSE ALL THE EXISTING THERMOSTATS AND RELOCATE SOME OF THEI AS NOTED ON THE MECHANICAL PLAN TO COMPLY WITH RENOVATION AND 		50 OR LESS AS DEFINED IN NFPA-90(A) AND BEARING A U.L. LABEL.
 NEW CEILING HEIGHT AS NEEDED. AA. RE-BALANCE THE SYSTEM AIRFLOW PER THE NEW MECHANICAL PLANS THAT'S INCLUDE DIFFUSERS, GRILLES & VAV BOXES. AB. REUSE ALL THE EXISTING THERMOSTATS AND RELOCATE SOME OF THEI AS NOTED ON THE MECHANICAL PLAN TO COMPLY WITH RENOVATION AND 		ALL CONDUITS SHALL BE FURNISHED AND INSTALLED BY THE ELECTRICA
THAT'S INCLUDE DIFFUSERS, GRILLES & VAV BOXES. AB. REUSE ALL THE EXISTING THERMOSTATS AND RELOCATE SOME OF THEI AS NOTED ON THE MECHANICAL PLAN TO COMPLY WITH RENOVATION A		
AS NOTED ON THE MECHANICAL PLAN TO COMPLY WITH RENOVATION A	AA.	
	AB.	AS NOTED ON THE MECHANICAL PLAN TO COMPLY WITH RENOVATION AI

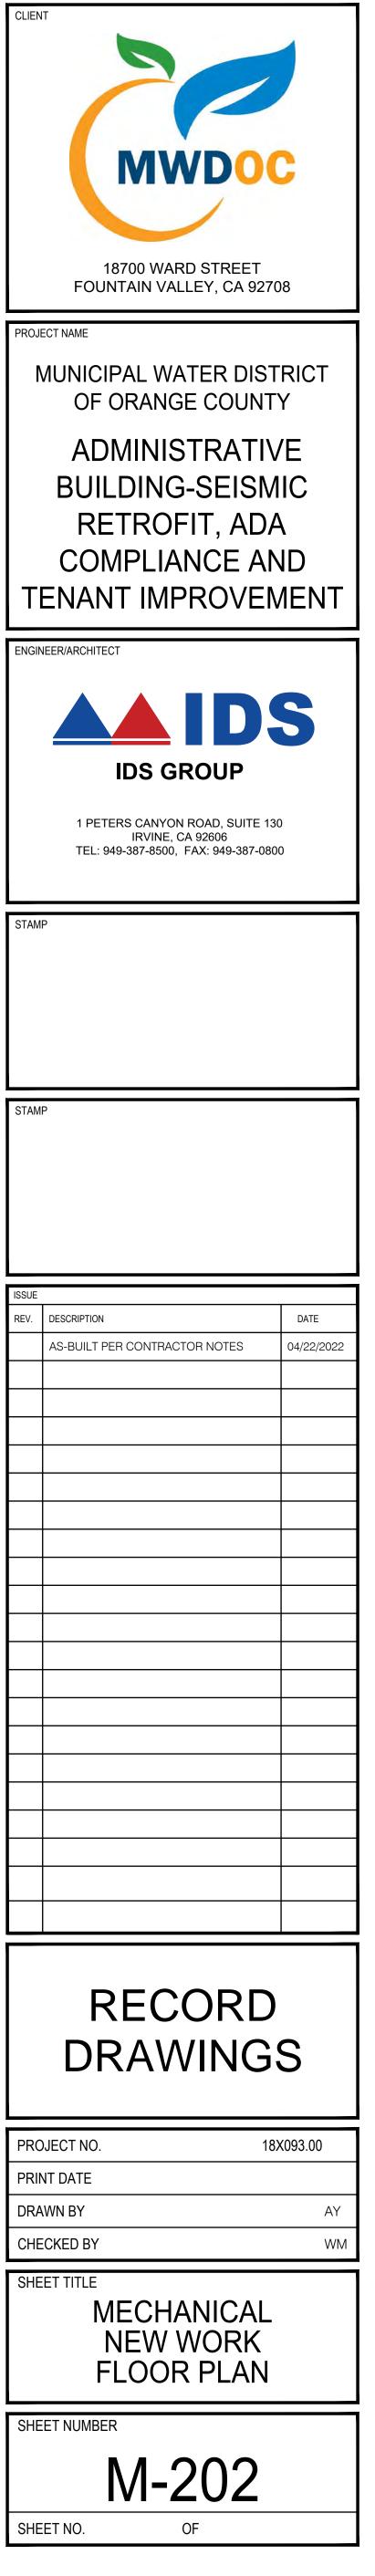


 

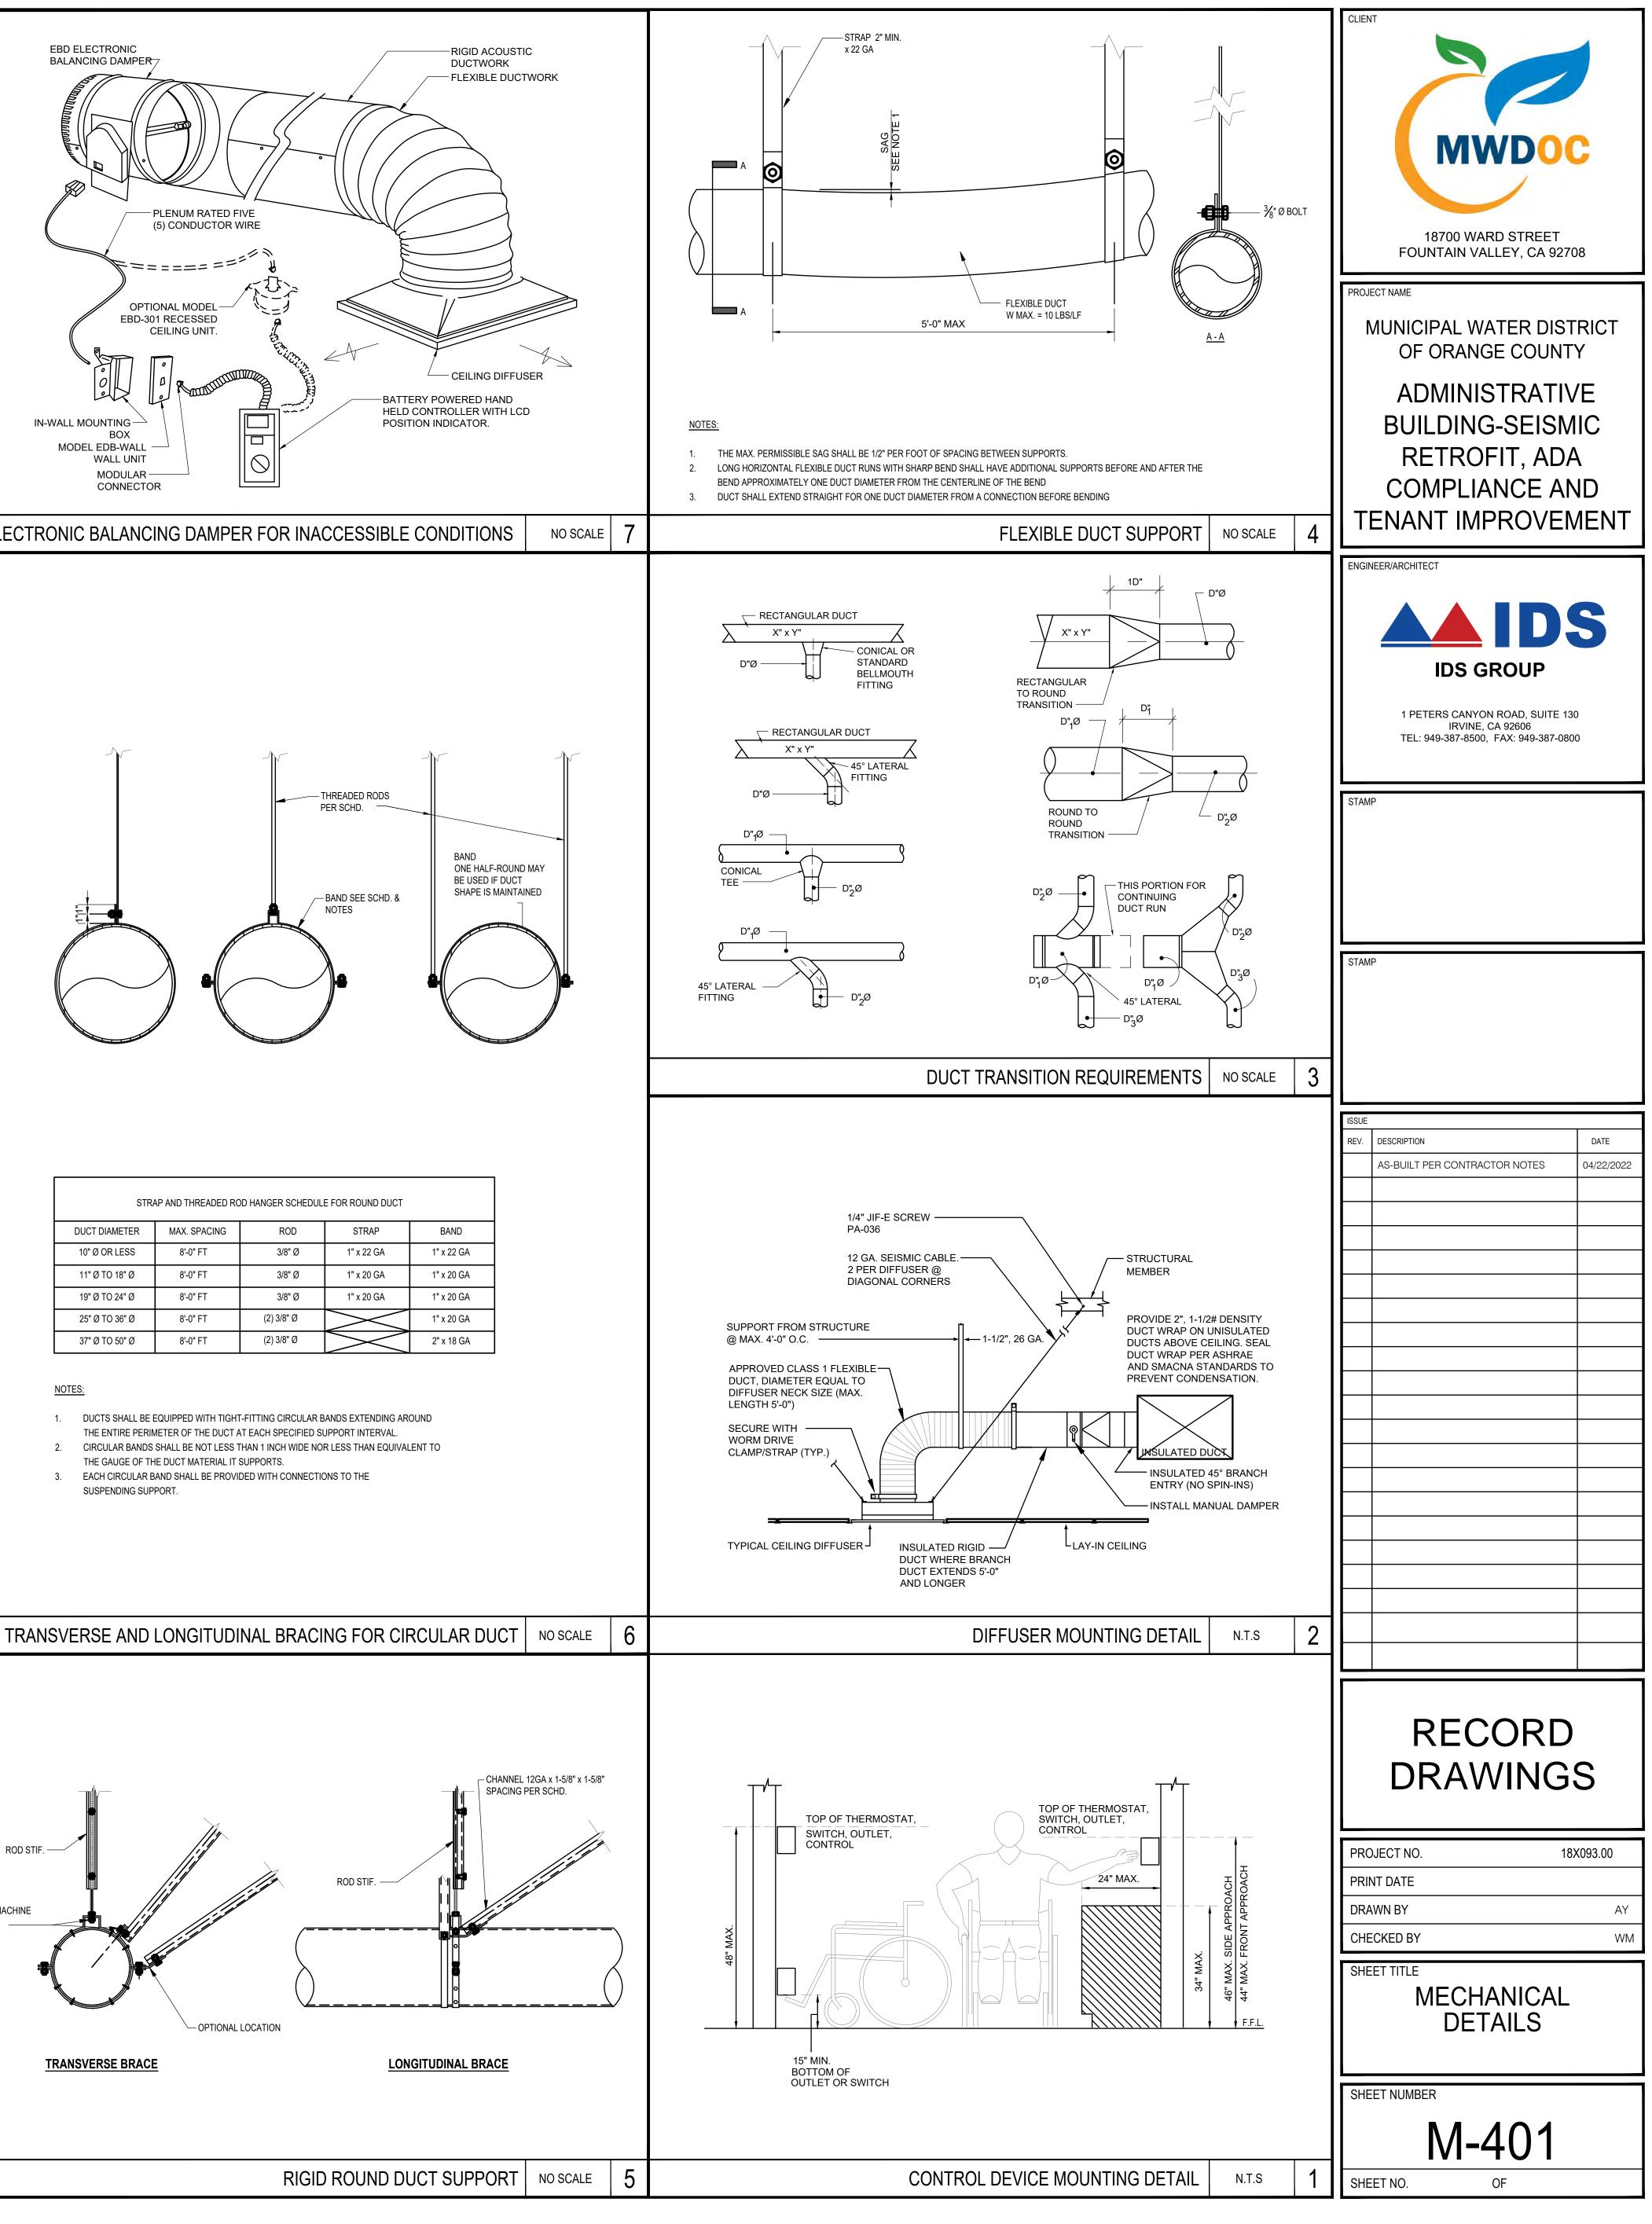

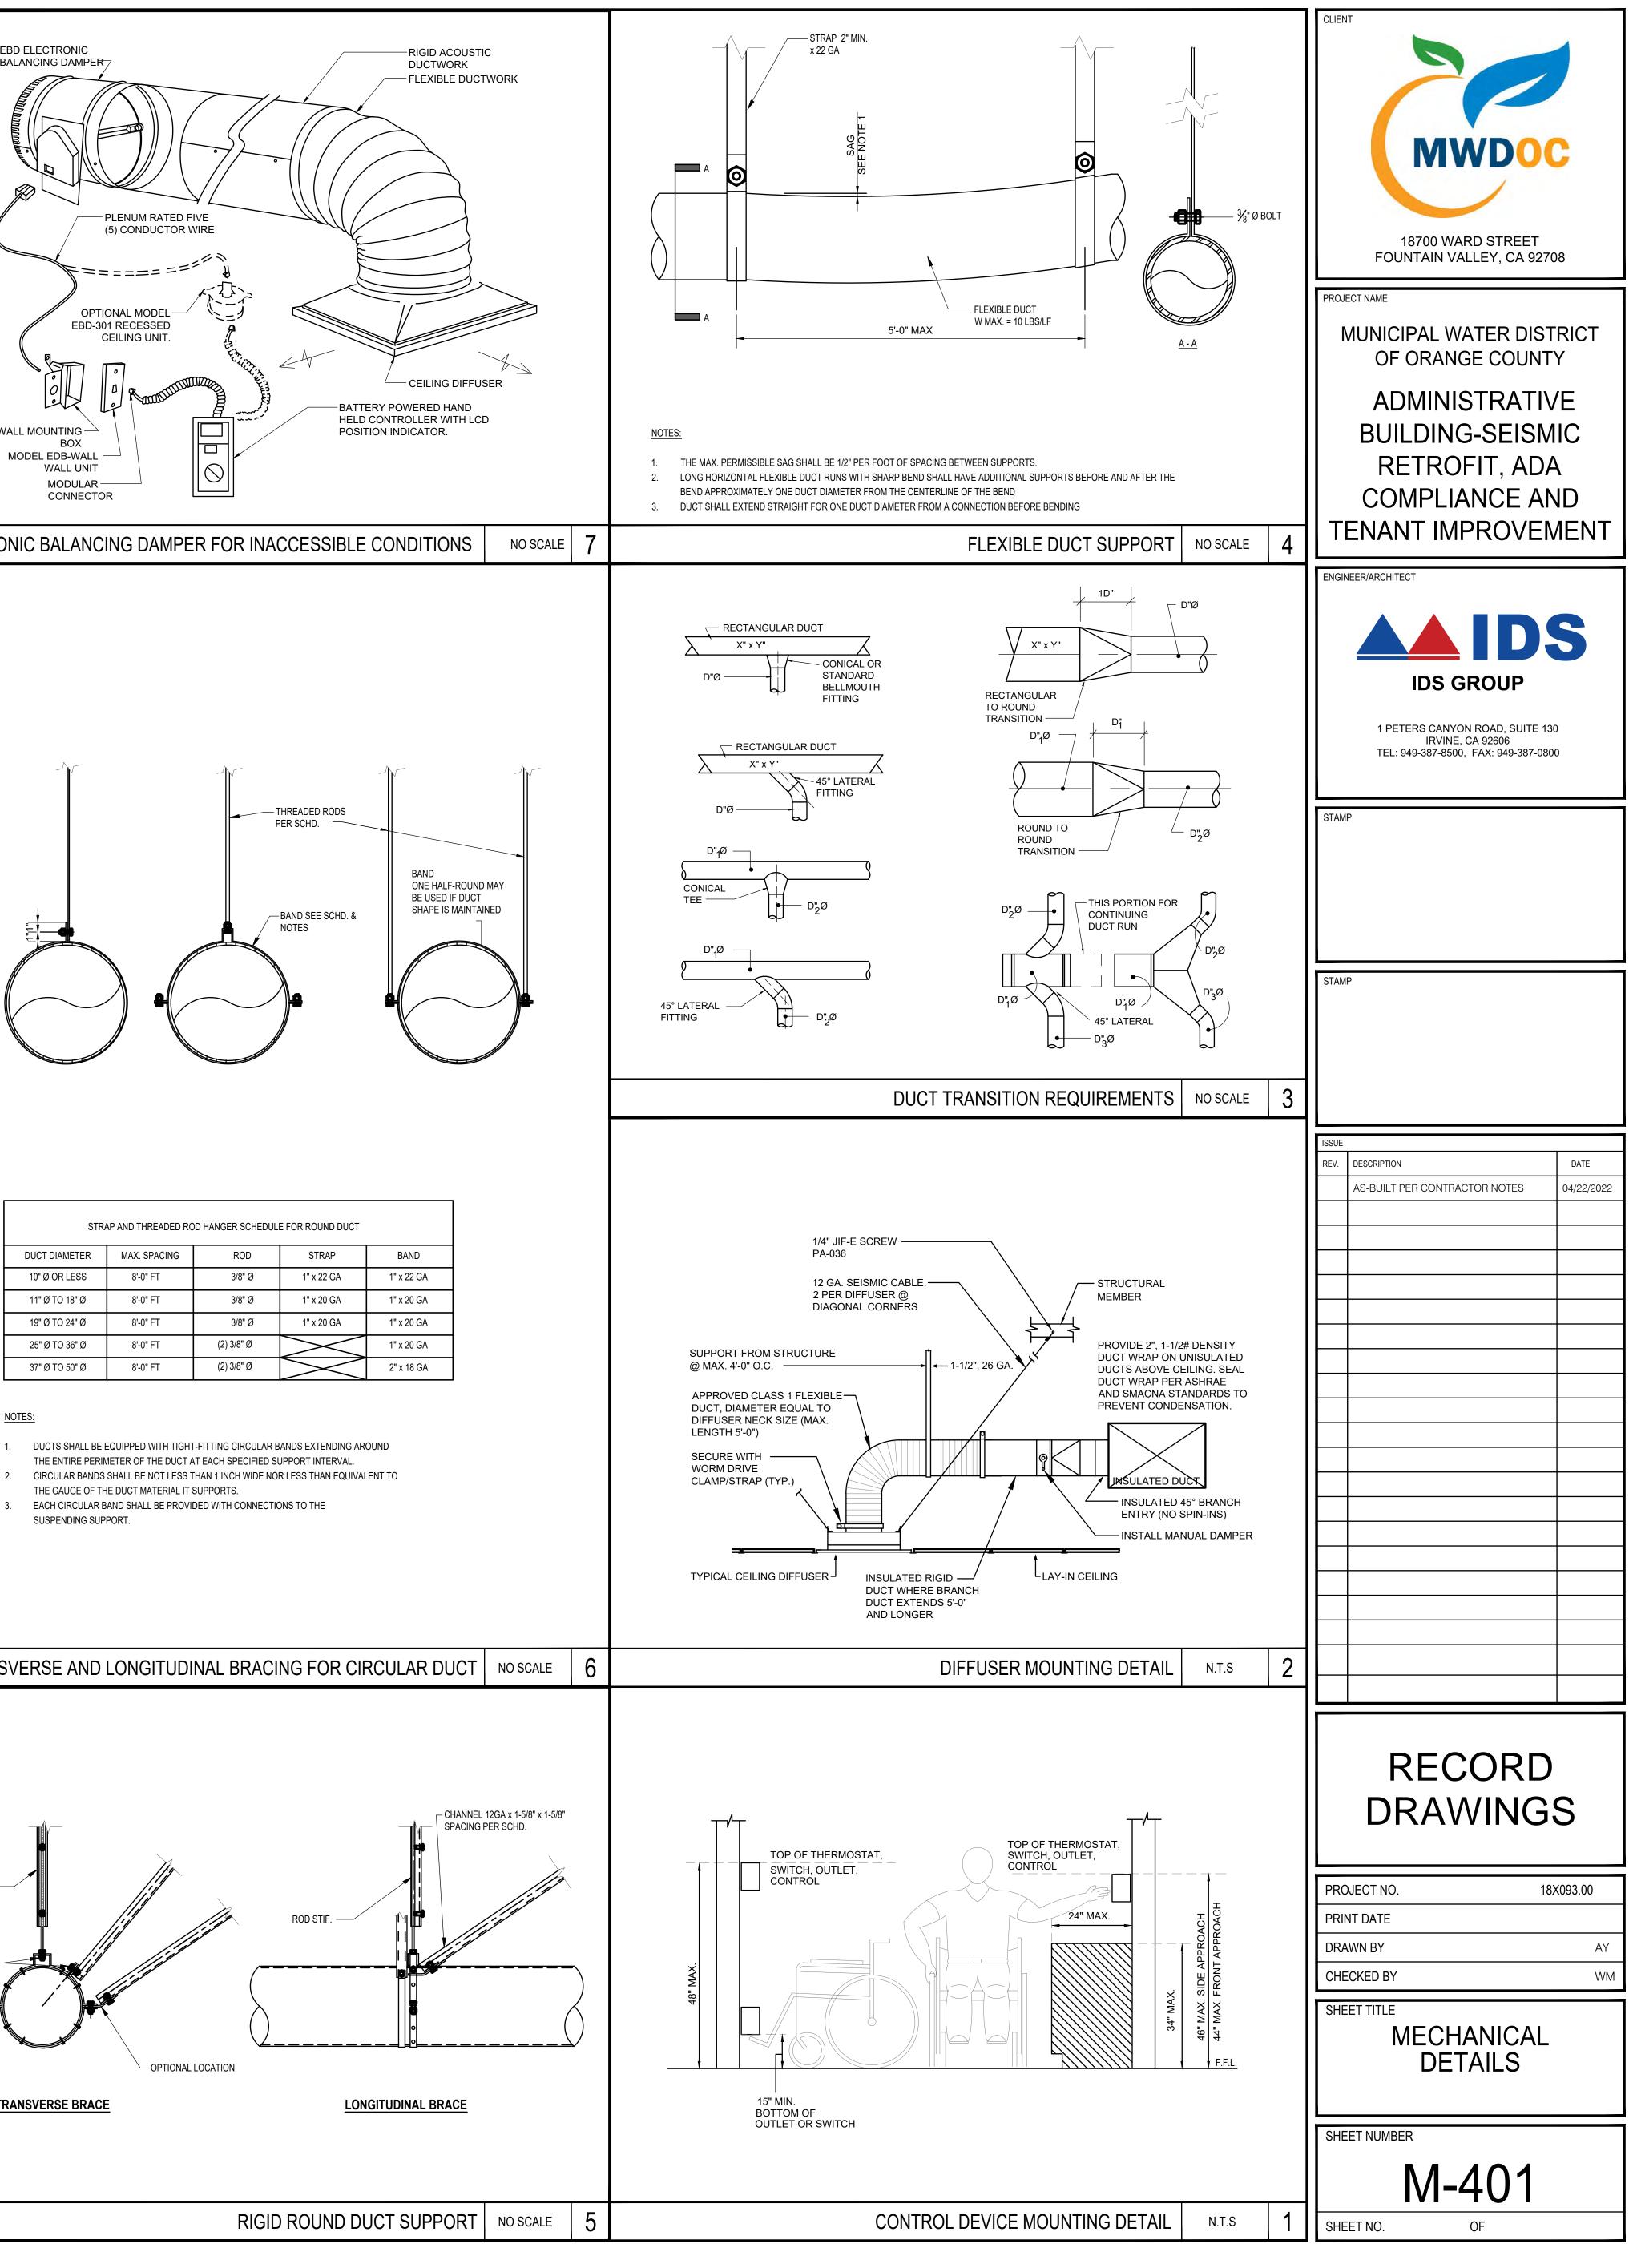

DUCT DIAMETER	MAX. SPACING	ROD	STRAP
10" Ø OR LESS	8'-0" FT	3/8" Ø	1" x 22 GA
11" Ø TO 18" Ø	8'-0" FT	3/8" Ø	1" x 20 GA
19" Ø TO 24" Ø	8'-0" FT	3/8" Ø	1" x 20 GA
25" Ø TO 36" Ø	8'-0" FT	(2) 3/8" Ø	\ge
37" Ø TO 50" Ø	8'-0" FT	(2) 3/8" Ø	\ge

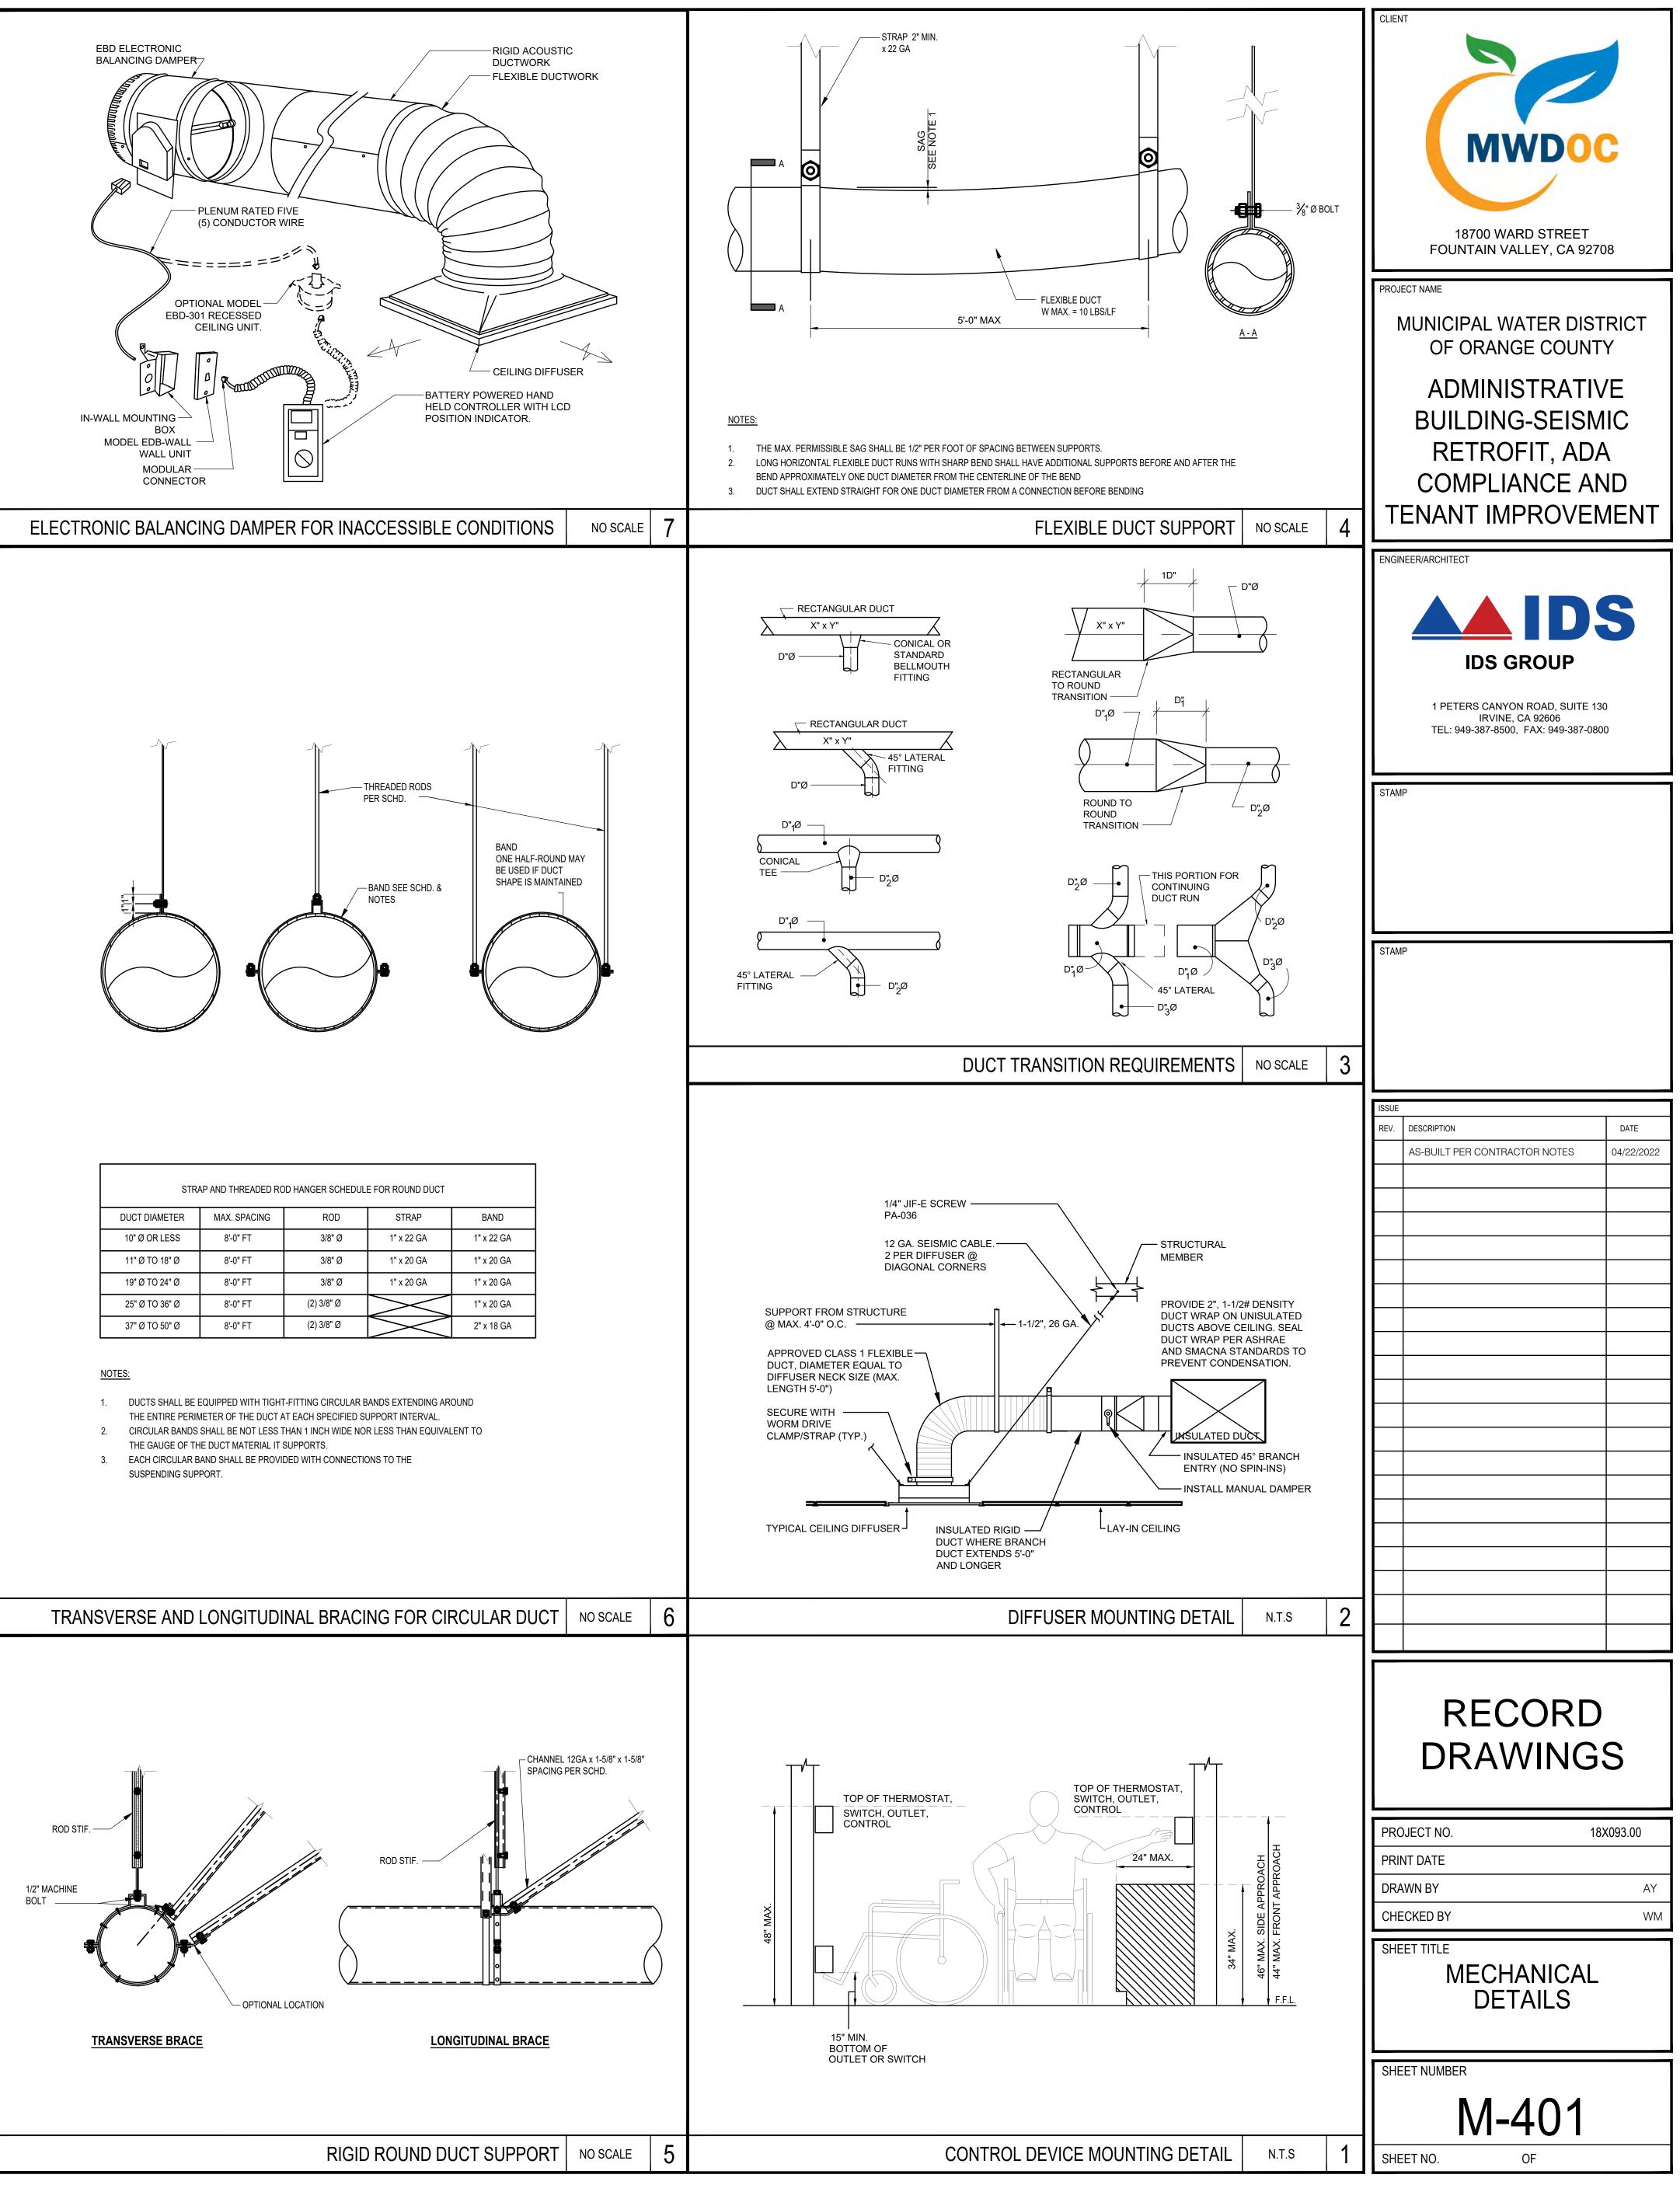

Mechanical Systems NRCC-MCH-E (Created 07/19)										CALIFORNIA	NERGY COMMISSIC	on 🙆
CERTIFICATE OF COMPLIANC			_									NIRCE-MCH
Table Instructions: Include ar or for alterations.	ny mechanicai	systems the	at are	within the	scope o	of the permit	appl	ication and are a	demor	strating complia	nce using the pr	escriptive path outlined in ,
	ISMIC RETRO	A DOLL THE A DOLL THE A						Repo	ort Pag	ge:		
Project Address: 18700 War	d Street, Four	ntain Valley,	CA 9	2708				Date	Prepa	ared:		2020-02-0
A. GENERAL INFORMATIO	N											10
01 Project Location (city)		-	F	ountain Val	ley		04 1	otal Conditioned	d Floo	r Area		8432
02 Climate Zone		6						otal Uncondition	-	and the second se		0
03 Occupancy Types Withi	n Project:						-	of Stories (Habi		and the second se		1
Office	Reta	il			Non-re	efrigerated V	_			tel/ Motel		thool
High-Rise Residential	Relo	catable Clas	s Bldg			(Write In):		10.000		any more		
¹ FOOTNOTES: Climate zone o	an be determ	nined on the	Calife	ornia Energy	Comm	nission's web	site d	at				
B. PROJECT SCOPE		_		_	_		_					
	y mechanical	systems tha	at are	within the s	cope o	f the permit	appl	cation and are d	lemon	strating complian	re using the or	escriptive path outlined in
or for alterations.		systems the	at are		-			ication and are d k all that apply)	lemon	strating compliar	ice using the pro	escriptive path outlined in ,
or for alterations. O	1	systems the	at are		-				lemon	strating compliar	nce using the pro	escriptive path outlined in ,
or for diterations. O Air Sys	1	systems the	at are		roject	consists of (chec	k all that apply)	lemon	strating compliar		
0 O Air Sys	1	systems the	at are		voject We	consists of (02 et System Co	chec	k all that apply)	lemon	strating complian	03 Dry System Cor	
0 Jor diterations. 0 Air Sys Heating Air System Cooling Air System	1 tem(s)	systems the	nt are	Myp	voject We	consists of (02 et System Co	chec	k all that apply)	lemon		03 Dry System Cor er	
0 Jor diterations. 0 Air Sys 1 Heating Air System 2 Cooling Air System Mechanica	1 tem(s)	systems tha	nt are	My p	we we	consists of (02 et System Co izer	chec	k all that apply)	lemon	Air Economiz	03 Dry System Cor er	
0 Air Sys Heating Air System Cooling Air System	1 tem(s)	systems the		My p	We conomi	consists of (02 et System Co izer m Piping	chec	k all that apply)	lemon	Air Economiz	03 Dry System Cor er	
0 Air Sys Air Sys Heating Air System Cooling Air System Mechanical Mechanical	1 tem(s) al Controls	systems the		My p Water Ed Pumps Hydronic Cooling 1 Chillers	We conomi	consists of (02 et System Co izer m Piping	chec	k all that apply)	lemon	Air Economiz Electric Resisi	03 Dry System Cor er	
0 Air Sys Heating Air System Cooling Air System Mechanical Mechanical Controls Scope De	1 tem(s) al Controls scription			My p Water Ec Pumps Hydronic Cooling 1 Cooling 1 Chillers Bailers	We we conomi Syster Towers	consists of (02 et System Co izer m Piping	mpo	k all that apply) nents		 Air Economiz Electric Resist Fan Systems Ductwork Ventilation Zonal System 	03 Dry System Cor er tance Heat s/ Terminal Box	mponents
0 Air Sys Heating Air System Cooling Air System Mechanical Mechanical Controls Scope De	1 tem(s) al Controls scription			My p Water Ec Pumps Hydronic Cooling 1 Cooling 1 Chillers Bailers	We we conomi Syster Towers	consists of (02 et System Co izer m Piping	mpo	k all that apply) nents		 Air Economiz Electric Resist Fan Systems Ductwork Ventilation Zonal System 	03 Dry System Cor er tance Heat s/ Terminal Box	mponents
0 Air Sys Air Sys Air System Cooling Air System Mechanical Mechanical Controls Scope De Describe the scope of the me	1 tem(s) al Controls scription			My p Water Ec Pumps Hydronic Cooling 1 Cooling 1 Chillers Bailers	We we conomi Syster Towers	consists of (02 et System Co izer m Piping	mpo	k all that apply) nents		 Air Economiz Electric Resist Fan Systems Ductwork Ventilation Zonal System 	03 Dry System Cor er tance Heat s/ Terminal Box	mponents
0 Air Sys Air System Cooling Air System Mechanical Controls Scope De Describe the scope of the me C. COMPLIANCE RESULTS	1 tem(s) al Controls scription chanical syste	ems included	I I I I I I I I I I I I I I I I I I I	My p Water Ed Pumps Hydronic Cooling 1 Cooling 1 Chillers Boilers ne permit ap	We conomi Syster owers	consists of (02 et System Co izer m Piping on. Include v	mpo	k all that apply) nents her the systems	arene	 Air Economiz Electric Resist Fan Systems Ductwork Ventilation Zonal System av, or being alter 	03 Dry System Cor er tance Heat s/ Terminal Box ed.	mponents
0 Air Sys Heating Air System Cooling Air System Mechanical Controls Scope De Describe the scope of the me C. COMPLIANCE RESULTS Table Instructions: If any cell	1 tem(s) al Controls scription chanical syste	ems included	I I I I I I I I I I I I I I I I I I I	My p Water Ed Pumps Hydronic Cooling T Cooling T Cooling T Cooling T Boilers be permit ap	We conomi Syster owers	consists of (02 et System Co izer m Piping on. Include to PLIES with Ex	mpo	k all that apply) nents her the systems	arene	Air Economiz Electric Resist Fan Systems Ductwork Ventilation Zonal System w, or being alter	03 Dry System Cor er tante Heat s/ Terminal Box ed. uidance.	res
0 Jor diterations. 0 Air Sys 1 Heating Air System 2 Cooling Air System Mechanica 2 Mechanical Controls	1 tem(s) al Controls scription chanical syste	ems included	I I I I I I I I I I I I I I I I I I I	My p Water Ed Pumps Hydronic Cooling 1 Cooling 1 Chillers Boilers ne permit ap	We conomi Syster owers	consists of (02 et System Co izer m Piping on. Include v	mpo	k all that apply) nents her the systems	arene	 Air Economiz Electric Resist Fan Systems Ductwork Ventilation Zonal System av, or being alter 	03 Dry System Cor er tance Heat s/ Terminal Box ed.	

e Table J)

CA Building Energy Efficiency Standards - 2016 Nonresidential Compliance: http://www.energy.ca.gov/title24/2016standards

Table Continued

(See Table M

COMPLIES

noject Addr D. DECLAR able Instruc- able E. Add	ress: 1870	DOC SEISMIC RETROFIT & TI			JOCC MC
b. DECLAR able Instruction able E. Add	0.000		Report Page:		VRCC-MC
able Instruc able E. Ada	ATION O	00 Ward Street, Fountain Valley, CA 92708	Date Prepared:		2020-0
able Instruc able E. Ada		REQUIRED CERTIFICATES OF ACCEPTANCE AND VERIFICA			
or Certifica	ctions: Sel	ections have been made based on information provided in previo marks. These documents must be provided to the building inspec	ous tables of this document. If any selection needs to be changed, p ctor during construction and can be found online at (for Certificates	lease exploi of Accepta	in why li nce) and
YES	NO	For	m/Title -	Field Inspecto	
0	۲	NRCA-MCH-02-A Outdoor Air must be submitted for all newly Note: MCH02-A can be performed in conjunction with MCH-02 activities overlap.	nstalled HVAC units. 7-A Supply Fan VFD Acceptance (if applicable) since testing	Pass	Fail
0	O	NRCA-MCH-03 A Constant Volume Single Zone HVAC NOTE: This form does not automatically move to "Yes". If con the scope, permit applicant should move this form to "Yes".	stant volume, single zone unitary AC/HP Systems are included in		
0	\odot	NRCA-MCH-04-A Air Distribution Duct Leakage			Ũ
0	۲	NRCV-MCH-04-H Duct Leakage Test NOTE: Must be completed by a HERS Rater			
0	\odot	NRCA-MCH-05-A Air Economizer Controls		Ê	
0	O	NRCA-MCH-06-A Demand Control Ventilation Systems Accept demand controlled ventilation (refer to §120.1(c)3) can vary o carbon dioxide (CO2) concentration setpoints.	ance must be submitted for all systems required to employ outside ventilation flow rates based on maintaining interior		
0	\odot	NRCA-MCH-07-A Supply Fan Variable Flow Controls			
0	\odot	NRCA-MCH-08-A Valve Leakage Test			
0	\odot	NRCA-MCH-09-A Supply Water Temperature Reset Controls			
0	\odot	NRCA-MCH-10-A Hydronic System Variable Flow Controls		D	
0	\odot	NRCA-MCH-11 A Automatic Demand Shed Controls			
0	۲	NRCA-MCH-12-A FDD for Packaged Direct Expansion Units NOTE: This form does not automatically move to "Yes". If pack should move this form to "Yes".	kage DX Systems are included in the scope, permit applicant	ū	
0	0	NRCA-MCH-13-A Automatic FDD for Air Handling Units and Zo	one Terminal Units Acceptance		
0	۲	NRCA-MCH-14-A Distributed Energy Storage DX AC Systems A			
0	O	NRCA MCH-15-A Thermal Energy Storage (TES) System Accept	tance		
0	۲	NRCA-MCH-16-A Supply Air Temperature Reset Controls			
0	O	NRCA-MCH-17-A Condenser Water Temperature Reset Contro	sis		
	0	NRCA-MCH-18 Energy Management Control Systems			

CA Building Energy Efficiency Standards - 2016 Nonresidential Compliance: http://www.energy.ca.gov/title24/2016standards

TERIFICA		evised 01/16)									GALIFORNIA	ENERGY COMM	
Mechanic					-			_		_	_	NRC	C-MCH-01-L
		SEISMIC RETROFIT	0.71						Date	Prepared			Page of
-	WWWDOC.	SEISIVIIC RETROFT	64.11						Maile	Prepared D2/05/	2020		
MECHA	NICALC	OMPLIANCE D	OCUME		VELICETE Lab	ALL ST.		1 1 15		_			
or detaile	d instruct	OMPLIANCE D	ocuive	d all Engrave	History Star	IECK DOX IT W	orksheet is i	ncluded)					
Vote: The	Enforcem	ions on the use o ent Agency may	reauire a	all forms to b	e incornorate	dards complic d anto the bui	ince jorms, rej Idina nlans	fer to the 201	5 Nonresiden	tial Manual			
YES	NO	Comp. Doc./			tle	a write the sai	ang plans.						_
0	0	NRCC-MCH-0				mpliance, Der	laration. Reg	uired on plans	for all submi	ttals			-
\odot	0	NRCC-MCH-0								1-A). Required	on plans for a	all submittals.	
\odot	0	NRCC-MCH-0	1-E (Part							3-A). Required			
\odot	0	NRCC-MCH-0	2-E (Part							Central Air Sy			ns.
\odot	0	NRCC-MCH-0	2-E (Part	2 nf 21 M	echanical We		ummary is rec			h chilled wate			
0	•	NRCC-MCH-0	3-E		echanical Ven tional on plar		eheat is requir	ed for all sub	mittals with n	nultiple zone h	eating and co	oling systems	. It is
0	0	NRCC-MCH-0	7-E (Part	1 of 2) Po	wer Consump	tion of Fans.	Required on p	lans where a	oplicable				
0	0	NRCC MCH-0	7-E (Part	2 of 2) Po	wer Consump	tion of Fans, I	Declaration, R	ation. Required on plans where applicable					
0		and the local	£										
. MECHA	1	VAC ACCEPTA	NCE FOF	RMS (check	box for requ	ired complia	ince docume	ents)					
est Perfor esigner: his complia	med By:	VAC ACCEPTA	by the de	signer and atta	ached to the pl	ans. Listed beig	w are all the ac	ceptance tests i	for HVAC system tt requires a te	ms. The designe st, list the equip	r is required to ment descripti	check the appl on and the nur	cable boxes iber of
. MECHA est Perfor esigner: his complia or all accep ystems. istalling Co he contract	med By: ince docum tance tests intractor: tor who ins	nent is to be used s that apply and lis stalled the equipm	by the de st all equip nent is res	signer and att; ment that rec ponsible to eit	ached to the pluires an accept her conduct th	ans. Listed beio ance test. All e e acceptance te	w are all the acc quipment of the st themselves o	ceptance tests f e same type that or have a qualifi	at requires a te	st, list the equip	ment descripti	on and the num	iber of
MECHA est Perfor esigner: its complia r all accep stems. stalling Co the contract r the accep	med By: ince docum tance tests intractor: tor who ins ptance test t Agency:	nent is to be used s that apply and lis	by the de st all equip nent is res shall sign	signer and att ment that rec ponsible to eit and submit the	ached to the pluires an accept her conduct the certificate of	ans. Listed belo cance test. All e e acceptance te Acceptance app	w are all the acc quipment of the st themselves o licable to the p	ceptance tests f e same type that or have a qualifi ortion of the co	it requires a te ed entity run t instruction or i	st, list the equip he test for them nstallation for w	ment description. If more than the the second	on and the num one person has esponsible.	iber of responsibilit
MECHA st Perfor esigner: is complia r all accep stems. stalling Co e contract r the accep forcemen	med By: ince docum tance tests intractor: tor who ins plance test t Agency: The NRCC-	nent is to be used s that apply and lis stalled the equipm ting, each person	by the de st all equip nent is res shall sign	signer and att ment that rec ponsible to eit and submit the	ached to the pluires an accept her conduct the certificate of	ans. Listed belo cance test. All e e acceptance te Acceptance app	w are all the acc quipment of the st themselves o licable to the p	ceptance tests f e same type that or have a qualifi ortion of the co	it requires a te ed entity run t instruction or i	st, list the equip he test for them nstallation for w	ment description. If more than the the second	on and the num one person has esponsible.	iber of responsibilit
MECHA est Perfor esigner: his complia or all accep vistems. estalling Co he contract or the accep forcemen ancheck -	med By: ince docum tance tests tor who ins plance test t Agency: The NRCC- Test D	nent is to be used s that apply and lis stalled the equipm ting, each person MCH-01-E compli- escription	by the de st all equip nent is res shall sign ance docu # of	signer and atta ment that rec ponsible to eit and submit the ment is not co	ached to the pla ulres an accept her conduct th certificate of nsidered a com	ans. Listed belo cance test. All e e acceptance te Acceptance app apleted docume	w are all the acc quipment of the st themselves o licable to the p ent and is not to	ceptance tests f e same type that or have a qualifi ortion of the co be accepted b	at requires a te ed entity run t instruction or i y the building c	st, list the equip he test for them nstallation for w lepartment unle MCH-08-A Valve	ment description I. If more than in which they are r ess the correct in MCH-09-A Supply Water	on and the num one person has esponsible. boxes are check	iber of responsibilitied. MCH-11- Automat Demand

CA Building Energy Efficiency Standards - 2016 Nonresidential Compliance

Mecha	anical Sy	stems				
NRCC-MCH	-E (Created 07	7/19]			CALIFORNIA ENERGY CO	
	ATE OF CO					NRCC-MCH-E
Project N		WDOC SEISMIC RETROFIT & TI		Report	Page:	
Project A	ddress: 18	3700 Ward Street, Fountain Valley	, CA 92708	Date Pr	repared:	2020-02-0
D. EXCE	PTIONAL	CONDITIONS				100
This table	e is auto-fil	led with uneditable comments be	cause of selections mad	e or data entered in tables throughou	t the form.	
No excep	otional con	ditions apply to this project.				
E. ADDI	TIONAL RE	MARKS				
This table	e includes r	emarks made by the permit appli	cant to the Authority Ha	wing Jurisdiction.		
F. HVAC	SYSTEM	SUMMARY (DRY & WET SYSTE	MS)			12
This Sect.	ion Does N	ot Apply				
G. PUM	PS					2
This Sect	ion Does N	ot Apply				
	and the labor of the	& AIR ECONOMIZERS	-			2
This Sect	ion Does N	at Apply				
I. SYSTE	M CONTR	OLS				2
This Sect	ion Does N	ot Apply				
J. VENTI	LATION					2
This Sect	ion Does N	ot Apply				
K. TERM	INAL BOX	CONTROLS				19
This Section	ion Does N	ot Apply				
Duct Lea	kage Sealir	ng				
The answ apply to f	vers to the the following	questions below ng duct system(s):	AH-2	Duct leakage testing trigg	gered for	No
11	No		ned air to an occupiable	e space for a constant volume, single	zone, space conditioning syst	tem.
12	No	The space conditioning system			also also also also also	12000
13	No			ng locations is more than 25% of the		

CA Building Energy Efficiency Standards - 2016 Nonresidential Compliance: http://www.energy.ca.gov/title24/2016standards

Mechanical Systems NRCC-MCH-E (Created 07/19)		CALIFORNIA ENERGY COMMISSION		
CERTIFICATE OF COMPLIANCE			NRCC-MCH-	
Project Name: MWDOC SEISMIC RETROFIT & TI		Report Page:		
Project Address: 18700 Ward Street, Fountain Valley, CA 92708		Date Prepared:	2020-02-	
	ented in the plan set or c	onstruction documentation. For any mandatory me	asures that do not apply, mork	
P. MANDATORY MEASURES DOCUMENTATION LOCATION Table Instructions: Indicate where mandatory measures are docum	ented in the plan set or c	onstruction documentation. For any mandatory me	asures that do not apply, mork	
	ented in the plan set or c			

CA Building Energy Efficiency Standards - 2016 Nonresidential Compliance: http://www.energy.ca.gov/title24/2016standards

~

CA Building Energy Efficiency Standards - 2016 Nonresidential Compliance

EC-NRCC-MCH-01-E (Revised 01/16)						CAL	FORNIA ENERGY CO	MMISSION
CERTIFICATE OF COMPLIANCE							N	RCC-MCH-01-
Mechanical Systems								Page of
Project Name MWDOC SEISMIC RETROFIT & 1	n				Date Pres	^{nared:} 02/05/2020		
. MECHANICAL HVAC ACCEPTANCE FO	RMS (check box	for required comp	liance document	s)				
est Performed By:		-						
A second s								
ystems. he contractor who installed the equipment or the acceptance testing, each person shale inforcement Agency: fancheck - The NRCC-MCH-01 E compliance	ll sign and submit t e document is not	the Certificate of Accord	eptance applicable t	o the portion of the sourcepters	e construction or ins	tallation for which the	ney are responsible.	
nstalling Contractor: he contractor who installed the equipment or the acceptance testing, each person shal nforcement Agency:	ll sign and submit t e document is not	the Certificate of Accord	eptance applicable t	o the portion of the sourcepters	e construction or ins	tallation for which the	ney are responsible.	
istalling Contractor: he contractor who installed the equipment or the acceptance testing, each person shal nforcement Agency: lancheck - The NRCC-MCH-01 E compliance	ll sign and submit t e document is not	the Certificate of Accord	eptance applicable t	o the portion of the sourcepters	e construction or ins	tallation for which the	ney are responsible.	
Installing Contractor: The contractor who installed the equipment for the acceptance testing, each person shale inforcement Agency: fancheck - The NRCC-MCH-01 E compliance inspector - Before occupancy permit is gran	ll sign and submit t e document is not	the Certificate of Acco considered a comple lied process systems	eptance applicable t ted document and i must be tested to e	o the portion of the s not to be accepte nsure proper opera MCH-14-A	e construction or ins d by the building dep tions.	tallation for which the partment unless the	ney are responsible correct boxes are c	hecked.

	anical S		CALIFORNIA ENERGY COMMISSION	
		OMPLIANCE		NRCC-MCH-E
Project	Name: N	AWDOC SEISMIC RETROFIT & TI	Report Page:	_
Project /	Address: 1	8700 Ward Street, Fountain Valley, CA 92708	Date Prepared:	2020-02-
Table Co	ontinued			
		In a space directly under a roof that h	nas a U-factor greater than the U-factor of the ceiling, or if the roof does not meet the	
		In an unconditioned crawlspace		
		In other unconditioned spaces		
14	No	The scope of the project includes extending an existing	duct system, which is constructed, insulated or sealed with asbestos.	
14 15	No Yes		g duct system, which is constructed, insulated or sealed with asbestos. I that is documented to have been previously sealed as confirmed through field verif	ication and
			em that is documented to have been previously sealed as confirmed through field verif	ication and
			em that is documented to have been previously sealed as confirmed through field verif	
15		The scope of the project includes an existing duct syste	em that is documented to have been previously sealed as confirmed through field verif	
15 M. COC	Yes	The scope of the project includes an existing duct syste	em that is documented to have been previously sealed as confirmed through field verif	
15 M. COC This Sec	Yes	The scope of the project includes an existing duct syste WERS Not Apply	em that is documented to have been previously sealed as confirmed through field verif	ove Last
15 M. COC This Sec	Yes	The scope of the project includes an existing duct syste	em that is documented to have been previously sealed as confirmed through field verif	ove Last
15 M. COC This Sec N. DEC Table In	Yes DLING TOM tion Does N LARATION structions:	The scope of the project includes an existing duct syste WERS Not Apply I OF REQUIRED CERTIFICATES OF INSTALLATION Selections have been made based on information provided	em that is documented to have been previously sealed as confirmed through field verif	ove Last
15 M. COO This Sec N. DEC Table In Table E.	Yes DLING TOV tion Does N LARATION structions: Additional	The scope of the project includes an existing duct syste WERS Not Apply I OF REQUIRED CERTIFICATES OF INSTALLATION Selections have been made based on information provided Remarks. These documents must be provided to the buildin	em that is documented to have been previously sealed as confirmed through field verif Aud Court System(s) Rem in previous tables of this document. If any selection needs to be changed, please explaining inspector during construction and can be found online at Field In	ove Last
15 M. COC This Sec N. DEC Table In	Yes DLING TOV tion Does N LARATION structions: Additional	The scope of the project includes an existing duct syste WERS Not Apply I OF REQUIRED CERTIFICATES OF INSTALLATION Selections have been made based on information provided Remarks. These documents must be provided to the buildin	em that is documented to have been previously sealed as confirmed through field verif Add Court System(s) Rem in previous tables of this document. If any selection needs to be changed, please explaining inspector during construction and can be found online at	n why in


CA Building Energy Efficiency Standards - 2016 Nonresidential Compliance: http://www.energy.ca.gov/title24/2016standards

STATE OF CALIFORNIA			
Mechanical Systems			A
CERTIFICATE OF COMPLIANCE			CALIFORNIA ENERGY COMMISSION
	SMIC RETROFIT & TI	Report P	NRCC-MCH-E
	Street, Fountain Valley, CA 92708	Date Pre	
DOCUMENTATION AUTHO	R'S DECLARATION STATEMENT		
Documentation Author Name	: Alexander Yau	Documentation Author Sig	
Company:	IDS Group	Signature Date:	2020-02-05
Address:	1 Peters Canyon RD Suite 130	CEA/ HERS Certification Id	entification (if applicable):
City/State/Zip:	Irvine/CA/92606	Phone:	(949) 387-8500
3. The energy features and pe	signer)	ts, and manufactured devices for the l	n or system design identified on this Certificate of building design or system design identified on this Certificate
4. The building design feature	s or system design features identified on this Ce	ertificate of Compliance are consistent	with the information provided on other applicable
 I will ensure that a complet the enforcement agency fo 	ed signed copy of this Certificate of Compliance	shall be made available with the build	for approval with this building permit application. ding permit(s) issued for the building, and made available to ate of Compliance is required to be included with the
Responsible Designer Name:	Walter Maclean	Responsible Designer Sign	ature: Walty M Mackan &
Company :	IDS Group	Date Signed:	2020-02-05
Address:	1 Peters Canyon RD Suite 130	License:	M31382
City/State/Zip:	Irvine/CA/92606	Phone:	(949) 387-8500

CA Building Energy Efficiency Standards - 2016 Nonresidential Compliance: http://www.energy.ca.gov/title24/2016standards

MECHANICAL SYSTEMS CEC-NRCC-MCH-01-E (Revised 01/16)	
CERTIFICATE OF COMPLIANCE	NRCC-MCH-01-E
Mechanical Systems	Page of
Project Name MWDOC SEISMIC RETROFIT & TI	Date Prepared: 02/05/2020
DOCUMENTATION AUTHOR'S DECLARATION STATEMENT	
1. I certify that this Certificate of Compliance documentation is accurate and	complete.
Documentation Author Name: Alexander Yau	Documentation Author Signature:
Company: IDS Group	Signature Date: 02/05/2020
Address: 1 Peters Canyon RD Suite 130	CEA/ HERS Certification Identification (if applicable):
City/State/Zip: Irvine/CA/92606	Phone: (949) 387-8500
RESPONSIBLE PERSON'S DECLARATION STATEMENT	
 designer). The energy features and performance specifications, materials, component conform to the requirements of Title 24, Part 1 and Part 6 of the California 	rrect. ept responsibility for the building design or system design identified on this Certificate of Compliance (responsible nts, and manufactured devices for the building design or system design identified on this Certificate of Compliance a Code of Regulations.
 worksheets, calculations, plans and specifications submitted to the enforce I will ensure that a completed signed copy of this Certificate of Compliance agency for all applicable inspections. I understand that a completed signed building owner at occurancy. 	e shall be made available with the building permit(s) issued for the building, and made available to the enforcement d copy of this Certificate of Compliance is required to be included with the documentation the builder provides to the
 worksheets, calculations, plans and specifications submitted to the enforce I will ensure that a completed signed copy of this Certificate of Compliance agency for all applicable inspections. I understand that a completed signer building owner at occupancy. Responsible Designer Name Walter Maclean 	rement agency for approval with this building permit application. e shall be made available with the building permit(s) issued for the building, and made available to the enforcement d copy of this Certificate of Compliance is required to be included with the documentation the builder provides to the Responsible Designer Signature:
 worksheets, calculations, plans and specifications submitted to the enforce I will ensure that a completed signed copy of this Certificate of Compliance agency for all applicable inspections. I understand that a completed signed 	rement agency for approval with this building permit application. e shall be made available with the building permit(s) issued for the building, and made available to the enforcement d copy of this Certificate of Compliance is required to be included with the documentation the builder provides to the Responsible Designer Signature:
 worksheets, calculations, plans and specifications submitted to the enforce I will ensure that a completed signed copy of this Certificate of Compliance agency for all applicable inspections. I understand that a completed signer building owner at occupancy. Responsible Designer Name Walter Maclean 	ement agency for approval with this building permit application. e shall be made available with the building permit(s) issued for the building, and made available to the enforcement d copy of this Certificate of Compliance is required to be included with the documentation the builder provides to the

January 2016

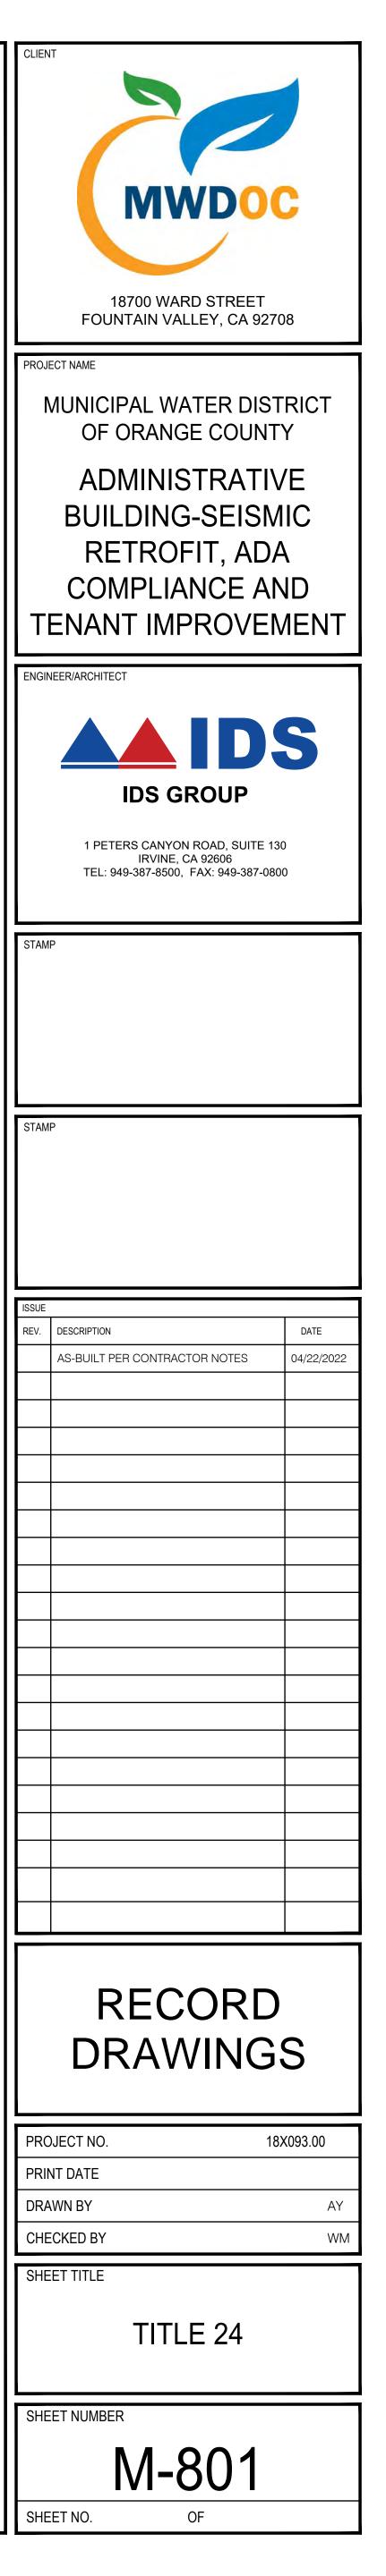

CEC-NRCC-MCH-02-E (Revised 01/16) CERTIFICATE OF COMPLIANCE				NRCC-MCH-D
HVAC Dry System Requirements				(Page 1 o
Project Name: MWDOC SEISMIC RETROFIT & TI			Date Prepared. 02/05/2020	
				-
A. Equipment Tags and System Description	on ¹ - Dry Systems	AH-2		
MANDATORY MEASURES	T-24 Sections	Reference to the R	Requirements in the C	ontract Documen
Heating Equipment Efficiency ³	110.1 or 110.2(a)	N/A		1 mm
Cooling Equipment Efficiency ³	110.1 or 110.2(a)	N/A		
HVAC or Heat Pump Thermostats	110.2(b), 110.2(c)	N/A		· · · · · · · · · · · · · · · · · · ·
Furnace Standby Loss Control	110.2(d)	N/A		
Low Leakage AHUs	110.2(f)	N/A		
Ventilation ⁴	120.1(b)	YES		
Demand Control Ventilation ⁵	120,1(c)4	N/A		
Occupant Sensor Ventilation Control ⁶	120.1(c)5, 120.2(e)3	N/A		
Shutoff and Reset Controls	120.2(e)	N/A		
Outdoor Air and Exhaust Damper Control	120.2(f)	N/A		12 million - 1
Isolation Zones	120.2(g)	N/A		
Automatic Demand Shed Controls	120.2(h)	N/A		
Economizer FDD	120.2(1)	N/A		
Duct Insulation	120.4	YES		5
PRESCRIPTIVE MEASURES				
Equipment is sized in conformance with	100 0 0 11	12 A.	121000	2.0
140.4 (a & b)	140.4(a & b)	O Yes No	O Yes O No	O Yes O N
Supply Fan Pressure Control	140.4(c)	N/A		
Simultaneous Heat/Cool ⁸	140.4(d)	N/A		
Economizer	140.4(e)	N/A		
Heat and Cool Air Supply Reset	140.4(f)	N/A	1	
Electric Resistance Heating ⁹	140.4(g)	N/A		-
Duct Leakage Sealing and Testing.10	140.4(1)	N/A		
Notes:	Ol and sustant description	la a Cinala Proventia	(askast) as a second	
 Provide equipment tags (e.g. AHU 1 to 10 with common requirements can be group 	oj una system descriptio ped together	in le.g. single Duct VA	v renear) as appropria	ne, wantiple units
2. Provide references to plans (i.e. Drawing		specifications linclud	na Section name/nur	ber and relevant
paragraphs) where each requirement is s	the second se			
	must include all of the fo	llowing information: e	'quibment taa. eauibn	
3. The referenced plans and specifications r				
	ulrements, and actual n	ited equipment efficie	ncies. Where multiple	efficiency
3. The referenced plans and specifications r capacity, Title 24 minimum efficiency req	quirements, and actual m id part-load) include all.	ited equipment efficie	ncies. Where multiple	efficiency
 The referenced plans and specifications r capacity, Title 24 minimum efficiency req requirements are applicable (e.g. full an 	quirements, and actual n id part-load) include all. le 20 1601 et seq.	ited equipment efficie Where appliance star	ncies. Where multiple adards apply (110.1), i	e∭iciency dentify where
 The referenced plans and specifications recapacity. Title 24 minimum efficiency requirements are applicable (e.g. full an equipment is required to be listed per Titl. Identify where the ventilation requirement unit schedules and sequences of operation 	pulrements, and actual n id part-load) include all. le 20 1601 et seq. nts are documented for on. If one or more space:	ated equipment efficie Where appliance star each central HVAC sys is naturally ventilate	ncies. Where multiple adards apply (110.1), i tem. Include referenc d identify where this is	efficiency dentify where es to both centra s documented in
 The referenced plans and specifications recapacity. Title 24 minimum efficiency requirements are applicable (e.g. full an equipment is required to be listed per Title Identify where the ventilation requirement unit schedules and sequences of operation the plans and specifications. Multiple zon 	pulrements, and actual n id part-load) include all. le 20 1601 et seq. nts are documented for on. If one or more space: ne central air systems m	ated equipment efficie Where appliance star each central HVAC sys is naturally ventilate ust also provide a MC	ncies. Where multiple adards apply (110.1), i tem. Include referenc d identify where this is H-03-E compliance do	efficiency dentify where es to both centra s documented in cument.
 The referenced plans and specifications in capacity. Title 24 minimum efficiency reg requirements are applicable (e.g. full an equipment is required to be listed per Titl. Identify where the ventilation requirement unit schedules and sequences of operation the plans and specifications. Multiple zon If one or more spaces has demand control 	pulrements, and actual n id part-load) include all. le 20 1601 et seq. nts are documented for on. If one or more space: ne central air systems m	ated equipment efficie Where appliance star each central HVAC sys is naturally ventilate ust also provide a MC	ncies. Where multiple adards apply (110.1), i tem. Include referenc d identify where this is H-03-E compliance do	efficiency dentify where es to both centra s documented in cument.
 The referenced plans and specifications recapacity. Title 24 minimum efficiency requirements are applicable (e.g. full an equipment is required to be listed per Titl. Identify where the ventilation requirement unit schedules and sequences of operation the plans and specifications. Multiple zor 5. If one or more spaces has demand control sequence of operation. 	quirements, and actual n id part-load) include all. le 20 1601 et seq. nts are documented for on. If one or more spaces ne central air systems m olled ventilation identify	ated equipment efficie Where appliance star each central HVAC sys is naturally ventilate ust also provide a MC where it is specified in	ncies. Where multiple adards apply (110.1), in tem. Include reference d identify where this is H-03-E compliance do ncluding the sensor sp	efficiency dentify where es to both centra s documented in cument. ecifications and t
 The referenced plans and specifications recapacity. Title 24 minimum efficiency requirements are applicable (e.g. full an equipment is required to be listed per Titl. Identify where the ventilation requirement unit schedules and sequences of operation the plans and specifications. Multiple zor 5. If one or more spaces has demand control sequence of operation. If one or more space has occupant sensor 	quirements, and actual n id part-load) include all. le 20 1601 et seq. nts are documented for on. If one or more spaces ne central air systems m olled ventilation identify	ated equipment efficie Where appliance star each central HVAC sys is naturally ventilate ust also provide a MC where it is specified in	ncies. Where multiple adards apply (110.1), in tem. Include reference d identify where this is H-03-E compliance do ncluding the sensor sp	efficiency dentify where es to both centra s documented in cument. ecifications and t
 The referenced plans and specifications recapacity. Title 24 minimum efficiency requirements are applicable (e.g. full an equipment is required to be listed per Title 4. Identify where the ventilation requirement unit schedules and sequences of operation the plans and specifications. Multiple zor 5. If one or more spaces has demand control sequence of operation. If one or more space has occupant sensor the sequence of operation 	quirements, and actual n id part-load) include all. ile 20 1601 et seq. nts are documented for on. If one or more space: ne central air systems m olled ventilation identify r ventilation control ider	ated equipment efficie Where appliance star each central HVAC sys is naturally ventilate ust also provide a MC where it is specified in tify where it is specifie	ncies. Where multiple adards apply (110.1), i tem. Include reference d identify where this is H-03-E compliance do ncluding the sensor sp ed including the senso	efficiency dentify where es to both centra s documented in cument. ecifications and t r specifications a
 The referenced plans and specifications recapacity. Title 24 minimum efficiency requirements are applicable (e.g. full an equipment is required to be listed per Title 4. Identify where the ventilation requirement unit schedules and sequences of operation the plans and specifications. Multiple zor 5. If one or more spaces has demand control sequence of operation. If one or more space has occupant sensor the sequence of operation If the system is DDC identify the sequence of operation 	pulrements, and actual n id part-load) include all. le 20 1601 et seq. nts are documented for on. If one or more spaces ne central air systems m alled ventilation identify r ventilation control ider es for the system start/s	Ited equipment efficie Where appliance star each central HVAC sys is naturally ventilate ust also provide a MC where it is specified in tify where it is specified top, optimal start, set	ncies. Where multiple adards apply (110.1), i tem. Include reference d identify where this is H-03-E compliance do ncluding the sensor sp ed including the senso back (if required) and	efficiency dentify where es to bath centra s documented in cument. ecifications and t r specifications a
 The referenced plans and specifications r capacity. Title 24 minimum efficiency req requirements are applicable (e.g. full an equipment is required to be listed per Tit. Identify where the ventilation requirement unit schedules and sequences of operation the plans and specifications. Multiple zor If one or more spaces has demand control sequence of operation. If one or more space has occupant sensor the sequence of operation 	pulrements, and actual n id part-load) include all. le 20 1601 et seq. nts are documented for on. If one or more spaces ne central air systems m olled ventilation identify r ventilation control ider es for the system start/s for the thermostats and	Ited equipment efficie Where appliance star each central HVAC sys is naturally ventilate ust also provide a MC where it is specified in tify where it is specified top, optimal start, set time clocks (if applica	ncies. Where multiple adards apply (110.1), i tem. Include reference d identify where this is H-03-E compliance do ncluding the sensor sp ed including the senso back (if required) and ble).	efficiency dentify where es to both central s documented in cument. ecifications and t r specifications ar setup (if required

9. Enter N/A if there is no electric heating. If the system has electric heating indicate which exception to 140.4(g) applies.

10. If duct leakage sealing and testing is required, a MCH-04-A compliance document must be submitted.

CA Building Energy Efficiency Standards - 2016 Nonresidential Compliance

CA Building Energy Efficiency Standards - 2016 Nonresidential Compliance

STATE OF CALIFORNIA HVAC DRY & WET SY
CEC-NRCC-MCH-02-E (Revised 01/16)
CERTIFICATE OF COMPLIANCE
HVAC Dry & Wet System Requ
Project Name MWDOC SEISMIC RETH

CERTIFICATE OF COMPLIANCE				NRCC-MCH-02-
HVAC Dry & Wet System Requirements			100 million (100 million)	(Page 2 of 3
Project Name MWDOC SEISMIC RETROFIT & TI			Date Prepared 02/05/2020	
	1			
8. Equipment Tags and System Descripti	on ¹ - Wet Systems	AH-2		
MANDATORY MEASURES	T-24 Sections	Reference to the	Requirements in the Co	ontract Documents
Heating Hot Water Equipment Efficiency ³	110.1	N/A		1
Cooling Chilled and Condenser Water Equipment Efficiency ³	110.1, 140.4(i)	N/A	1.	
Open and Closed Circuit Cooling Towers conductivity or flow-based controls	110.2(e) 1	N/A	J	
Open and Closed Circuit Cooling Towers Maximum Achievable Cycles of Concentration (LSI) ⁶	110.2(e) 2	N/A		
Open and Closed Circuit Cooling Towers Flow Meter with analog output	110.2(e) 3	N/A		
Open and Closed Circult Cooling Towers Overflow Alarm	110.2(e) 4	N/A	1	
Open and Closed Circuit Cooling Towers Efficient Drift Eliminators	110.2(e) 5	N/A		1
Pipe Insulation	120.3	N/A		1
PRESCRIPTIVE MEASURES				
Cooling Tower Fan Controls	140.4(h)2, 140.4(h)5	O Yes 🛈 No	O Yes O No	O Yes O No
Cooling Tower Flow Controls	140.4(h)3	N/A		
Centrifugal Fan Cooling Towers	140.4(h)4	N/A		1
Air-Cooled Chiller Limitation	140.4(j)	N/A		1
Variable Flow System Design	140.4(k)	N/A	1	
Chiller and Boiler Isolation	140.4(k)	N/A		
CHW and HHW Reset Controls	140.4(k)	N/A		1
WLHP Isolation Valves	140.4(k)	N/A		7
VSD on CHW, CW & WLHP Pumps >5HP	140.4(k)	N/A		
DP Sensor Location	140.4(k)	N/A		
 Notes: Provide equipment tags (e.g. CH 1 to 3) requirements can be grouped together. Provide references to plans (i.e. Drawin paragraphs) where each requirement i. The referenced plans and specifications capacity, Title 24 minimum efficiency mrequirements are applicable (e.g. full-e the Kadj values. For chillers also note with the Kadj values. 	g Sheet Numbers) and/ar s specified. Enter "N/A" if s must include all of the fo equirements, and actual r and part-load) include all.	specifications (inclu the requirement is n llowing information: ated equipment effic For chillers operation	ding Section name/num at applicable to this sys equipment tag, equipm siencies. Where multiple	nber and relevant stem, ment nominal e efficiency

. Identify the existence of a completed MCH-06-E when open or closed circuit cooling towers are specified to be installed,

dd Row Remove Last

City/State//ip Irvine/CA/92606

CA Building Energy Efficiency Standards - 2016 Nonresidential Compliance

CA Building Energy Efficiency Standards - 2016 Nonresidential Complia

otherwise enter "N/A"_

STATE OF CALIFORNIA REQUIRED ACCEPTANCE TESTS CEC-NRCC-MCH-04-E (Revised 01/16) CERTIFICATE OF COMPLIANCE NRCC-MCH-04 E Required Acceptance Tests Page of Project Name: MWDOC SEISMIC RETROFIT & TI Date Prepared: 02/05/2020 A. MECHANICAL COMPLIANCE FORMS & WORKSHEETS (indicate if worksheet is included) For detailed instructions on the use of this and all Energy Standards compliance documents, refer to the 2016 Nonresidential Manual Note: The Enforcement Agency may require all compliance documents to be incorporated onto the building plans. The NRCC-MCH-04-E and NRCC-MCH-05-E are alternative compliance documents to NRCC-MCH-01-E, NRCC-MCH-02-E and NRCC-MCH-03-E for projects using only single zone packaged HVAC systems. YES NO Form Title Certificate of Compliance. Required on plans when used. \odot NRCC-MCH-04-E (1 of 2) O NRCC-MCH-04-E (2 of 2) Mechanical Acceptance Tests. Required on plans when used. 0 NRCC-MCH-05-E (1 of 2) HVAC Prescriptive Requirements. It is required on plans when used. Mechanical SWH Equipment Summary is required for all submittals with service water heating, pools or spas. It is 0 \odot NRCC-MCH-05 E (2 of 2) required on plans where applicable.

January 2016

C-NRCC-MCH-05-E (Revised 01/16) ERTIFICATE OF COMPLIANCE						ALIFORNIA ENERGY	
equirements for Packaged Single-Zone U	nits						NRCC-MCH-05-
viet Name: MWDOC SEISMIC RETROFIT & TI				Dat	e Prepared on Vor Joco		(Page 1 of)
AND GE SEISING RETROTT & T					02/05/202	0	
Equipment Tag(s) ¹	12	AH-2		1		1	
MANDATORY MEASURES	T-24 Sections	Requirement ³	As Scheduled ³	Requirement	As Scheduled ³	Requirement ³	As Scheduled
Heating Equipment Efficiency ⁴	110,1 or 110.2(a)	N/A		negenement	TIS BUILDING	nequirement	AS JEIEGUIEU
Cooling Equipment Efficiency ⁴	110.1 or 110.2(a)	N/A					
'hermostats ⁵	110.2(b), 110.2(c)	N/A					-
urnace Standby Loss Control ⁶	110.2(d)	N/A					
ow Leakage AHU	110.2(f)	N/A					
entilation ⁷	120.1(b)	2196	2220				
Demand Control Ventilation ⁸	120.1(c)4	N/A	4220			-	
Occupant Sensor Ventilation Control ⁸	120 1(c)5, 120.2(e)3	N/A					
hutoff and Reset Controls ⁹	120.2(e)	N/A					
Jutdoor Air and Exhaust Damper Contro		N/A				-	
Automatic Demand Shed Controls	120.2(h)	N/A			-		
conomizer FDD	120.2(i)	N/A					
Duct Insulation	120.4	YES					
PRESCRIPTIVE MEASURES	1.454.1	1 053				1	
quipment is sized in conformance with 40.4 (a & b)	140.4(a & b)	N/A					
conomizer	140.4(e)	N/A					
ectric Resistance Heating ¹⁰	140.4(g)	N/A					
Duct Leakage Sealing and Testing.11	140.4(I)	N/A			1		
 Iotes: Provide equipment tags (e.g. ACI or ACI Enter the following information as approved (enter "N/A" if no heating); and, rated co For each requirement, enter the minimum the units as specified. Where there is more than one requireme in the left column identify the thermostal capabilities of the thermostat as schedul. If the unit has a furnace which is rated a indicate "N/A". In the left column, enter both the require ventilation as scheduled. If the space is if if the space is required to have either DC Sensor Ventilation Control is provided indo In the left column indicate the required to the left column indicate the required to 	priate: Unit Manufacturer, Un boling capacity (enter "N/A" (f m requirement from the Stand int (e.g. full and part load effici tic requirements from the stan ed. It ≥ 225,000 Btuh of capacity, i noturally ventilated enter "N/A V or Occupant Sensor Ventilati dicate "provided" in the right c ime cantrols from the standard	It Model Number (incl na cooling). For unit c ard in the left column ency) enter both with dard (e.g. programma ndicate the rated stai 120.1A and for the m " in the left column ar an Control indicate "r olumn (otherwise indi I in the right column	uding all accessorie apacities include th (under "Standard R the appropriate lab able setback thermo ndby loss and igniti umber of accupants ad "the space is nat equired" in the left identify the device i	s); Description of th e units (e.g. kBtuh o equirement"). In th bels (e.g. COP and II ostat or heatpump v on source (e.g. IID). times 15 cfm/perso urally ventilated" in column (otherwise i ght column) that provides this fu	e unit (e.g. gas-pac) or tons), e right column (und ER], with electric heat), . If there is no furna on. In the right colum the right colum, ndicate "N/A" in the	c or heat pump; rate er "As Scheduled") e In the right column i ce or the unit is rate nn enter the actual i Heft column). If eith	nter the value for ndicate the ed far <225,000 Bi ninimum ier DCV or Occupa

January 2016

YSTEM REQUIREMENTS

CERTIFICATE OF COMPLIANCE HVAC Wet System Requirements Project Name: MWDOC SEISMIC RETROFIT & TI DOCUMENTATION AUTHOR'S DECLARATION STATEMENT I. I certify that this Certificate of Compliance documentation is accurate and complete.
 Documentation Author Name:
 Alexander Yau
 Documentation Author Signature Signature Date 02/05/2020 Company: IDS Group CEA/ HERS Certification Identification Address 1 Peters Canyon RD Suite 130 City/State/Zip: Irvine/CA/92606 Phone: (949) 387-8500 **RESPONSIBLE PERSON'S DECLARATION STATEMENT** I certify the following under penalty of perjury, under the laws of the State of California: The information provided on this Certificate of Compliance is true and correct. I am eligible under Division 3 of the Business and Professions Code to accept responsibility for the bu identified on this Certificate of Compliance (responsible designer). The energy features and performance specifications, materials, components, and manufactured dev design identified on this Certificate of Compliance conform to the requirements of Title 24, Part 1 and Regulations. The building design features or system design features identified on this Certificate of Compliance an provided on other applicable compliance documents, worksheets, calculations, plans and specification agency for approval with this building permit application. I will ensure that a completed signed copy of this Certificate of Compliance shall be made available w building, and made available to the enforcement agency for all applicable inspections. I understand t Certificate of Compliance is required to be included with the documentation the builder provides to Responsible Designer Name: Walter Maclean Responsible Designer Signature Date Signed: 02/05/2020 Company IDS Group Address: 1 Peters Canyon RD Suite 130 M31382 City/State/Zip: Invine/CA/92606 ^{(bone:} (949) 387-8500

STATE OF CALIFORNIA

CEC-NRCC-MCH-02-E (Revised 01/16)

HVAC SYSTEM REQUIREMENTS

ompliance				January 201	.6						
							CA Buildin	ig Energy Effici	iency Standard	ls - 2016 Nonresi	dential Compliance
STATE OF CALIFORNIA REQUIRED ACCEPTANCE TESTS SEC-NRCC-MCH-04-E (Revised 01/16) CERTIFICATE OF COMPLIANCE Required Acceptance Tests Project Name MWDOC SEISMIC RETROFIT & TI Designer: This compliance document is to be used by the designer and attached to the plan check the applicable boxes by all acceptance tests that apply and list all equipme to a systems Acceptance. Before occupancy permit is granted for a newly constructe hormal use, all control devices serving the building or space shall be certified as r Systems Acceptance. Before occupancy permit is granted all newly installed HVA document is not considered a completed document and is not to be accepted by berson performing the test (Example: HVAC installer, TAB contractor, controls co checked-off forms are required for ALL newly installed and replaced equipment. department that certifies plans, specifications, installation certificates, and opera the building inspector must receive the properly filled out and signed compliance								ē	ALIFORNIA ENERG		
CERTIFICATE OF COMPL	IANCE										NRCC-MCH-04-E
Required Acceptance Te	ests										Page of
Project Name MWDOC SEISM	AIC RETROFIT &	TI						Oate Prepare	d: 02/05/2020)	
normal use, all control de Systems Acceptance. Be document is not conside person performing the te checked-off forms are re department that certifies	evices serving t fore occupancy red a complete est (Example: H quired for ALL s plans, specific	he building o permit is gr d document VAC installer newly install ations, instal	or space shall anted all new and is not to r, TAB contrat ed and replac Ilation certific	be certified a ly installed H be accepted ctor, controls ced equipmen cates, and op	as meeting th VAC equipme by the build contractor, f nt. In addition erating and n	e Acceptance ent must be t ng departme PE in charge c n a Certificate naintenance	e Requirement tested using the nt unless the of project) and of Acceptance information r	its for Code C he Acceptanc correct boxes d what Accep ce compliance neet the requ	ompliance. e Requirements are checked tance test mu e documents uirements of 5	nts. The NRCC-A . The equipmen ist be conducte shall be submit:	MCH-04-E compliance It requiring testing, d. The following ted to the building
The building inspector m	ust receive the	properly fill	ed out and sig	gned complia	nce documer	nts before the	e building can	receive final	occupancy.		
Test Description	MCH-02-4	MCH-03-A	MCH-04-A	MCH-05-A	MCH-06-A	MCH-07-A	MCH-11-A	MCH-12-A	MCH-14-A	MCH-18-A	

Test Description		MCH-02-A	MCH-03-A	MCH-04-A	MCH-05-A	MCH-06-A	MCH-07-A	MCH-11-A	MCH-12-A	MCH-14-A	MCH-18-A	
Equipment Requiring Testing or Verification	# of Units	Outdoor Air	Single Zone Unitary	Air Distribution Ducts	Economizer Controls	Demand Control Ventilation (DCV)	Supply Fan VAV	Automatic Demand Shed Control	FDD for Packaged DX Units	Distributed Energy Storage DX AC Systems	Energy Management Control System	Test Performed By:
None	0											

STATE OF CALIFORNIA REQUIREMENTS FOR PACKAGED SINGLE 2	ONE UNITS	<u>@</u>						
CEC-NRCC-MCH-05-E (Revised 01/16) CERTIFICATE OF COMPLIANCE		CALIFORNIA ENERGY COMMISSION						
Requirements for Packaged Single-Zone Units		(Page 2 of 2)						
Project Name: MWDOC SEISMIC RETROFIT & TI		thate Prepared D2/05/2020						
DOCUMENTATION AUTHOR'S DECLARATION STATEMENT								
 I certify that this Certificate of Compliance documentation is an 								
Documentation Author Name: Alexander Yau	Documentation Author Signature:							
Company: IDS Group	Signature Date 02/05/2020							
Address 1 Peters Canyon RD Suite 130	CEA/ -HERS Combination Identification	(if applicable):						
City/State/Zip Irvine/CA/92606	Phone: (949) 387-8500	Phone: (949) 387-8500						
RESPONSIBLE PERSON'S DECLARATION STATEMENT								
 designer). 3. The energy features and performance specifications, materials conform to the requirements of Title 24, Part 1 and Part 6 of the building design features or system design features identific worksheets, calculations, plans and specifications submitted to 5. I will ensure that a completed signed copy of this Certificate of the second system. 	rue and correct. Tode to accept responsibility for the building des s, components, and manufactured devices for the he California Code of Regulations. ed on this Certificate of Compliance are consistent to the enforcement agency for approval with this F Compliance shall be made available with the builded signed copy of this Certificate of Complian	uilding permit(s) issued for the building, and made available to the enforcement nee is required to be included with the documentation the builder provides to the						
Responsible Designer Name: Walter Maclean	Responsible Designer Signature:	M Maclean @						
Company IDS Group	Date Signed: 02/05/2020							
Address: 1 Peters Canvon RD Suite 130	Learse: M31382							

Phone: (949) 387-8500

CA Building Energy Efficiency Standards - 2016 Nonresidential Compliance

NRCC-MCH-02-
(Page 3 of 3
apared: 02/05/2020
pplicable):
lding design or system design
es for the building design or system
Part 6 of the California Code of
consistent with the information
is submitted to the enforcement
th the building permit(s) issued for the at a completed signed copy of this
ne building owner at occupancy.
1
m Maclean &

January 2016

January 2016


January 2016

CA Building Energy Efficiency Standards - 2016 Nonresidential Compliance

CERTIFICATE OF COMPLIANCE	CALIFORNIA ENERGY COMMISSION
Required Acceptance Tests	Page of
reject Name: MWDOC SEISMIC RETROFIT & TI	Dati Prepared: 02/05/2020

DOCUMENTATION AUTHOR'S DECLARATION STATEMENT	
 I certify that this Certificate of Compliance documentation is accurate 	e and complete.
	Documentation Author Signature:
Company: IDS Group	Signature Date: 02/05/2020
Address: I Peters Canyon RD Suite 130	CLA/ HERS Certification (dentification (if applicable):
City/State/Zip: Irvine/CA/92606	Phone: (949) 387-8500
RESPONSIBLE PERSON'S DECLARATION STATEMENT	
 designer). The energy features and performance specifications, materials, com conform to the requirements of Title 24, Part 1 and Part 6 of the Cali The building design features or system design features identified on worksheets, calculations, plans and specifications submitted to the e I will ensure that a completed signed copy of this Certificate of Compagency for all applicable inspections. I understand that a completed building owner at occupancy. 	ponents, and manufactured devices for the building design or system design identified on this Certificate of Compliance ifornia Code of Regulations. this Certificate of Compliance are consistent with the information provided on other applicable compliance documents, enforcement agency for approval with this building permit application. pliance shall be made available with the building permit(s) issued for the building, and made available to the enforcement signed copy of this Certificate of Compliance is required to be included with the documentation the builder provides to the
	Responsible Designer Signature: Walts M Maclian #
Company DS Group	Date Signed: 02/05/2020
Certify that this Certificate of Compliance documentation is accurate an intation Author Name' Alexander Yau VIDS Group 1 Peters Canyon RD Suite 130 SetZip: Irvine/CA/92606 DNSIBLE PERSON'S DECLARATION STATEMENT Fy the following under penalty of perjury, under the laws of the State of the information provided on this Certificate of Compliance is true and compliance is true and performance specifications, materials, compone onform to the requirements of Title 24, Part 1 and Part 6 of the Californ the building design features or system design features identified on this vorksheets, calculations, plans and specifications submitted to the enformation gency for all applicable inspections. I understand that a completed sign uliding owner at occupancy. Walter Maclean Y IDS Group 1 Peters Canyon RD Suite 130	License: M31382
City/State/Zip: Irvine/CA/926D6	^{Phane:} (949) 387-8500

January 2016

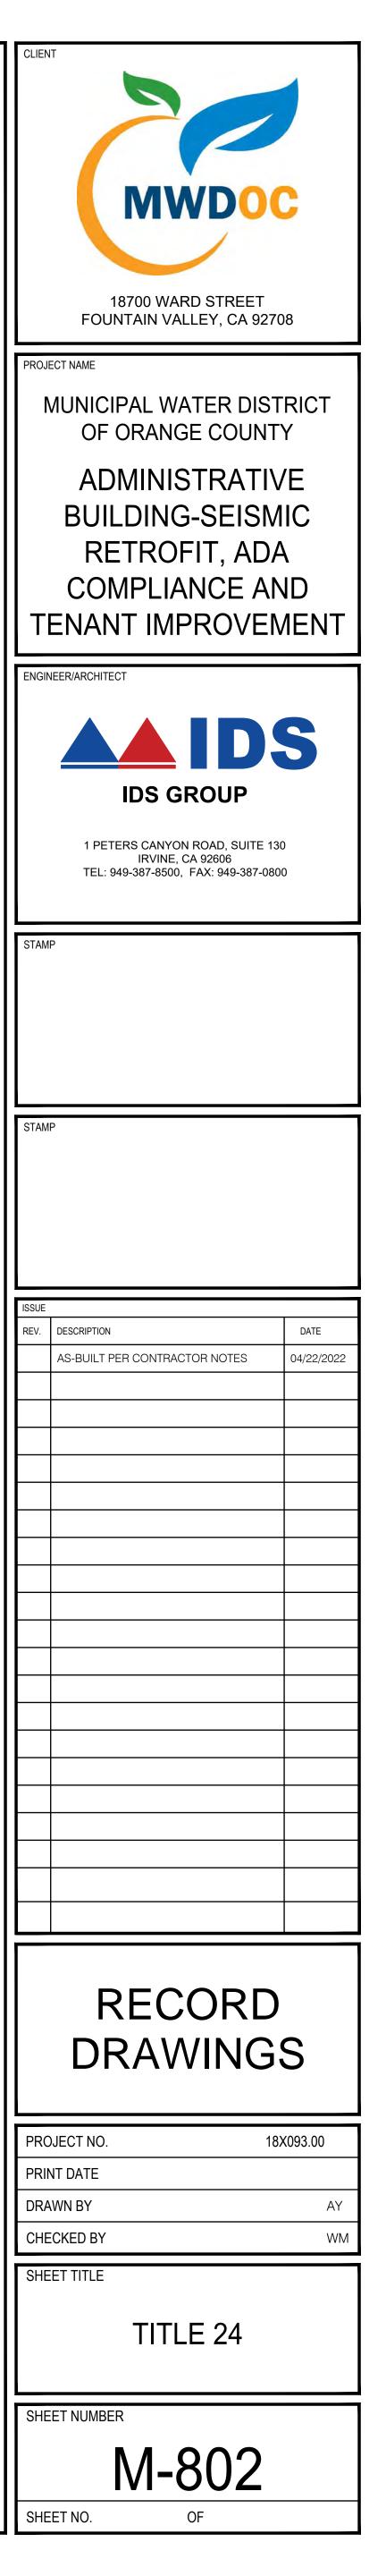

SPECIFICATIONS ALL ELECTRICAL MATERIALS AND EQUIPMENT SHALL BE NEW AND SHALL BE LISTED BY UNDERWRITER'S LABORATORIES (UL) AND BEAR THEIR LABEL, OR LISTED AND CERTIFIED BY A NATIONALLY RECOGNIZED TESTING LABORATORY (NRTL) WHERE UL DOES NOT HAVE A LISTING. THE ELECTRICAL WORK SHALL INCLUDE LABOR, SUPERVISION, MATERIALS, EQUIPMENT, TOOLS, TRANSPORTATION, INSURANCE AND PERFORM OPERATIONS REQUIRED TO CONSTRUCT AND INSTALL COMPLETE AND OPERATIVE ELECTRICAL SYSTEMS IN ACCORDANCE WITH THE SPECIFICATIONS AND DRAWINGS. MATERIALS FURNISHED AND WORK INSTALLED SHALL COMPLY WITH THE CURRENT ACCEPTED VERSION OF THE NEC, MUNICIPAL REQUIREMENTS, STATE OF CALIFORNIA AND APPLICABLE REQUIREMENTS OF OSHA. OBTAIN AND PAY FOR REQUIRED ELECTRICAL PERMITS AND INSPECTIONS. PAY APPLICABLE STATE SALES TAX. WORK INTENDED, BUT HAVING MINOR DETAILS OBVIOUSLY OMITTED OR NOT SHOWN SHALL BE FURNISHED AND INSTALLED COMPLETE TO PERFORM REQUIRED FUNCTION. WHERE CONFLICTS OCCUR ON DRAWINGS AND/OR SPECIFICATIONS THE MOST STRINGENT APPLICATION SHALL APPLY. THE ENTIRE ELECTRICAL SYSTEM SHALL BE LEFT IN PROPER WORKING ORDER. REPLACE ANY WORK OR MATERIAL PROVIDED FOR UNDER THIS CONTRACT WHICH DEVELOPS DEFECTS WITHIN ONE (1) YEAR OF FINAL ACCEPTANCE BY OWNER. COORDINATE WORK SO THAT IT DOES NOT INTERFERE WITH THE WORK OF OTHER TRADES. IT SHALL BE THIS CONTRACTOR'S RESPONSIBILITY TO SEE THAT THIS WORK IS INSTALLED IN A TIMELY MANNER. PROVIDE AND MAINTAIN AN ADEQUATE TEMPORARY POWER, FIRE ALARM AND LIGHTING SYSTEM. REMOVE AFTER CONSTRUCTION IS COMPLETE. INTERIOR WIRING SHALL BE IN "EMT", WITH SET-SCREW STEEL FITTINGS. TYPE MC CABLE MAY BE USED FOR BRANCH CIRCUIT WIRING WHERE CONCEALED ABOVE DROP CEILING AND WHERE ALLOWED BY CODE AND OWNER. MINIMUM CONDUIT SHALL BE 3/4 INCH UNLESS OTHERWISE NOTED. ALL RACEWAYS TO CONTAIN SEPARATE EQUIPMENT GROUNDING CONDUCTOR SIZED PER CEC 250. WIRE SHALL BE "THHN" OR "XHHW", COPPER, 90 DEGREES CELSIUS, 600 VOLTS. SOLID SIZE 10 AND SMALLER, STRANDED SIZE 8 AND LARGER. PROVIDE FEEDER AND BRANCH CIRCUITS WITH A GREEN-INSULATED EQUIPMENT GROUNDING CONDUCTOR SIZED PER CEC 250-122. TERMINATIONS FOR ELECTRICAL EQUIPMENT SHALL BE RATED FOR 75 DEGREES CELSIUS. PROVIDE LIGHTING FIXTURES COMPLETE WITH LAMPS, HANGERS AND INCIDENTALS. FIXTURES SHALL BE INDEPENDENTLY SUPPORTED FROM THE STRUCTURE ABOVE. PROVIDE PANELBOARDS WITH COPPER BUSBARS, FULLY RATED, OF THE SAME MANUFACTURER. (SQUARE D, CUTLER-HAMMER, GE OR SIEMENS). PROVIDE SCREW-ON ENGRAVED NAMEPLATES FOR DISTRIBUTION EQUIPMENT. DISCONNECT SWITCHES SHALL BE HEAVY DUTY. LOCATE LIGHTING FIXTURES AS SHOWN ON ARCHITECTURAL REFLECTED CEILING PLAN. WHERE THERE IS A CONFLICT BETWEEN THE ARCHITECTURAL AND ELECTRICAL DRAWINGS ON QUANTITY AND LOCATION, CONTACT THE ELECTRICAL ENGINEER TO VERIFY THE DESIGN PRIOR TO BID. REFER TO MECHANICAL DRAWINGS FOR EXACT LOCATION OF MECHANICAL EQUIPMENT. ALL PENETRATIONS OF FIRE RATED FLOORS OR SHAFT WALLS SHALL BE PROTECTED BY MATERIALS AND INSTALLATION DETAILS THAT CONFORM TO UNDERWRITER LABORATORIES LISTINGS FOR THROUGH PENETRATION FIRE STOP SYSTEMS. THE CONTRACTOR SHALL SUBMIT SHOP DRAWING DETAILS WHICH SHOW COMPLETE CONFORMANCE TO THE U.L. LISTING TO THE ARCHITECT/ENGINEER AND SUCH DRAWINGS SHALL BE AVAILABLE TO THE CITY INSPECTORS. THE DRAWINGS SHALL BE SPECIFIC FOR EACH PENETRATION WITH ALL VARIABLES DEFINED. SUBMIT FOR APPROVAL EIGHT (8) SETS OF SHOP DRAWINGS ON THE FOLLOWING: PANELBOARDS, CIRCUIT BREAKERS, DISCONNECT SWITCHES, LIGHTING FIXTURES, LAMPS, DEVICES AND COVERPLATES AND ANY OTHER ITEMS REQUESTED BY THE ARCHITECT. PROVIDE EQUIPMENT AND MATERIAL AS SPECIFIED, APPROVED MANUFACTURERS ARE LISTED. SUBSTITUTIONS OF EQUAL OR BETTER WILL BE CONSIDERED BY ENGINEER. . VISIT THE SITE AND CONFIRM EXISTING CONDITIONS EFFECTING SCOPE OF WORK. VERIFY ALL ROUTING OF SYSTEMS AND FEEDERS. PROVIDE SPECIFICATION GRADE WIRING DEVICES WITH HIGH IMPACT THERMO-PLASTIC COVER PLATES. COLOR AS SELECTED BY ARCHITECT. CONTROLLED RECEPTACLES SHALL BE MARK/IDENTIFIED. WIRING DEVICES SHALL BE ARROW-HART, GE, PASS & SEYMOUR OR LEVITON. THESE DRAWINGS ARE DIAGRAMMATIC. CONTRACTOR IS REQUIRED TO VERIFY DIMENSIONS, SIZES, LOCATION OF EQUIPMENT, ROUTING OF CONDUITS AND LAYOUT WITH OTHER WORK. PROVIDE THE NECESSARY QUANTITY OF CONDUCTORS TO MAKE THE SYSTEMS COMPLETE AND OPERATIONAL. UPDATE PANEL DIRECTORY CARD FOR ANY MODIFICATION TO EXISTING DISTRIBUTION AND PANEL BOARD, INCLUDING CIRCUITS CONVERTED TO SPARES. PREPARE AND SUBMIT AS-BUILT DRAWINGS FOR ALL WORK INCLUDED IN DIVISION 26. AS-BUILT DRAWINGS SHALL INCLUDE ALL FIELD CHANGES PERFORMED DURING CONSTRUCTION AND SHALL REFLECT AS CLOSELY AS POSSIBLE THE ACTUAL INSTALLATION, SIZING, CONFIGURATIONS AND NOTATIONS. CONDUITS WHICH ARE INSTALLED AT THIS TIME AND LEFT EMPTY FOR FUTURE USE SHALL HAVE PULL WIRE LEFT IN PLACE, LABEL AND IDENTIFY PER CODE. KEEP RACEWAYS AT LEAST 6 INCHES AWAY FROM PARALLEL RUNS OF HOT-WATER PIPES OR OTHERWISE. . PROVIDE MINIMUM CONDUIT SIZE, 3/4" IF APPLICABLE DEPTH OF THE ELECTRICAL BOX REQUIRED FOR PROPOSED CONSTRUCTION. (1-1/4" DEEP Vs 2 -1/8") 4 INCHES SQUARE BOXES. WHENEVER SPECIFICATION OR DRWAING ITEMS ARE SPECIFIED NOTED OR DRAWN MULTIPLE AND / OR CONFLICTING REQUIREMENTS, THE MOST STRINGENT CRITERIA SHALL APPLY.

CABLING NOTES

- WIRING ONLY WIRING METHODS CONSISTING OF TYPE MC CABLE EMPLOYING A SMOOTH OR CORRUGATED IMPERVIOUS METAL SHEATH WITHOUT AN OVERALL NONMETALLIC COVERING, ELECTRICAL METALLIC TUBING, INTERMEDIATE METAL CONDUIT, OR RIGID METAL CONDUIT IS PERMITTED. FLEXIBLE METAL CONDUIT AND LIQUID TIGHT FLEXIBLE METAL CONDUIT SHALL BE PERMITTED, IN LENGTHS NOT TO EXCEED 4 FEET, TO CONNECT PHYSICALLY ADJUSTABLE EQUIPMENT AND DEVICES THAT ARE PERMITTED IN THE PLENUM. (NEC 300-22b).
- COMMUNICATION CABLES CABLES INSTALLED IN DUCTS, PLENUMS AND OTHER SPACES USED FOR ENVIRONMENT AIR SHALL BE TYPE CMP. TYPES CMP, CMR, CMG, CM AND CMX AND COMMUNICATIONS WIRE SHALL BE INSTALLED IN ELECTRICAL METALLIC TUBING, INTERMEDIATE METAL CONDUIT, RIGID METAL CONDUIT, FLEXIBLE METAL CONDUIT, OR, WHERE ACCESSIBLE, SURFACE METAL RACEWAY OR WIRE WAY WITH METAL COVERS OR SOLID BOTTOM METAL CABLE TRAY WITH SOLID METAL COVERS. (NEC 800-53a, 300-22)

ALL CABLES IN OPEN PLENUM CEILING SHALL BE RATED "OPEN PLENUM". FIRE ALARM NOTE

FIRE ALARM SYSTEM IS COMPLETELY DESIGN BUILT. ELECTRICAL CONTRACTOR AND FIRE ALARM CONTRACTOR SHALL PREPARE FIRE ALARM DRAWINGS LOCATING ALL REQUIRED DEVICES, ROUTING OF CONDUIT INDICATING ALL WIRING, VOLTAGE DROP AND BATTERY CALCULATIONS ALL TO COMPLY WITH FIRE DEPARTMENT REQUIREMENTS AND SUBMIT TO FIRE DEPARTMENT FOR APPROVAL. THE APPROVED DRAWINGS SHALL BE USED BY ELECTRICAL CONTRACTOR TO INSTALL ALL BOXES, CONDUIT ETC AT NO ADDITIONAL COST TO OWNER.

GREEN BUILDING STANDARD NOTES

- MINIMUM OF 50% OF NON HAZARDOUS CONSTRUCTION WASTE IS TO BE RECYCLE. CGC 5.713.8.1. TESTING AND ADJUSTING OF NEW SYSTEMS SHALL COMPLY AS OUTLINED IN CGC SECTION 5.713.10.4.2.
- OPERATIONS AND MAINTENANCE SCHEDULE (O&M) AS LISTED IN CGC SECTION 5.713.10.4.5 SHALL TEL BE DELIVERED TO THE BUILDING OWNER OR REPRESENTATIVE AND THE FACILITIES OPERATOR.
- DURING CONSTRUCTION, ENDS OF DUCT OPENING ARE TO BE SEALED, AND MECHANICAL EQUIPMENT IS TO BE COVERED. CGC 5.714.4.3.
- VOC'S MUST COMPLY WITH THE LIMITATIONS LISTED IN SECTION 5.504.4 AND TABLES 4.504.1, 5.504.4.1, 5.504.4.2, 5.504.4.3 AND 5.504.4.5 FOR: ADHESIVES, SEALANTS, PAINTS, AND COATINGS, CARPET AND COMPOSITION WOOD PRODUCTS. CGC 5.714.4.4.
- ALL NONEMERGENCY INTERIOR LUMINAIRES SHALL BE TURNED OFF BETWEEN 11PM AND 5AM.

SEISMIC BRACING

ALL SUSPENDED UTILITY SYSTEMS WHICH INCLUDE:

INSPECTION.

ELECTRICAL, MECHANICAL, AND PLUMBING EQUIPMENT AND ASSOCIATED CONDUIT, DUCTWORK, AND PIPING ARE REQUIRED TO HAVE SEISMIC RESTRAINT ATTACHMENTS DESIGNED TO RESIST THE TOTAL DESIGN SEISMIC FORCES PRESCRIBED IN SECTION 1632.2. PROVIDE TYPICAL SEISMIC RESTRAINT DETAILS. DOCUMENTATION SUBSTANTIATING COMPLIANCE WITH SECTION 1632 OF THE 2000 UNIFORM BUILDING CODE(2013 CALIFORNIA BUILDING CODE) TO INCLUDE SEISMIC RESTRAINT ASSEMBLY DETAILS. ANCHORAGE TO OVERHEAD STRUCTURES WITH SUPPORTING ENGINEERING STAMP BY A LICENSED CIVIL OR STRUCTURAL ENGINEER IS REQUIRED AT TIME OF

I IGHTING

	LIGHTING	
) но	FLUORESCENT, INCANDESCENT, AND/OR HID LIGHTING FIXTURES COMPLETE WITH LAMPS. REFER TO LIGHTING FIXTURE SCHEDULE FOR ADDITIONAL INFORMATION.	
	EXIT LIGHTS. REFER TO LIGHTING FIXTURE SCHEDULE FOR DETAILS. SURFACE MOUNT ON WALL OR CEILING AS INDICATED.	
	LIGHTING FIXTURE NOTATION A, 1, b INDICATES: L-1 = FIXTURE TYPE, REFER TO SCHEDULE 1 = CIRCUIT NUMBER b = SWITCH CONTROLLING FIXTURE	— EX —
	ab =BI-LEVEL/DUAL SWITCH CONTROL HALF SHADED FIXTURE FURNISHED WITH EMERGENCY BATTERY PACK BALLAST, UNSWITCHED CIRCUIT TO BATTERY CHARGER.	
Sab	20 AMP, SINGLE POLE SWITCH. MOUNT AT 44" AFF TO CENTERLINE UNLESS NOTED OTHERWISE	(
	SUBSCRIPTS: "ab" - NUMBER OF SWITCH CONTROL OR CHANNELS.	
	 "3" - 3-WAY SWITCH. "4" - 4-WAY SWITCH. "D" - DIMMER SWITCH. "M" - MOTOR-RATED TOGGLE SWITCH WITH OVERLOAD PROTECTION. 	
S _{Dab}	20 AMP, DUAL TECHNOLOGY OCCUPANCY SENSOR, "D" DENOTES DIMMABLE WITH ON/OFF, RAISE/LOWER CONTROL, "ab" INDICATES NUMBER OF CHANNELS. MOUNT AT +44" AFF UNLESS NOTED OTHERWISE.	FSD J
D TC	LOW VOLTAGE, DIMMER SWITCH WITH ON/OFF, RAISE/LOWER CONTROL, "ab" INDICATES NUMBER OF CHANNELS. MOUNT AT +44" AFF UNLESS NOTED OTHERWISE. TIME CLOCK.	
S S	CEILING OR WALL MOUNTED DUAL TECHNOLOGY OCCUPANCY SENSOR, COMPLETE WITH POWER PACKS AND RELAYS AS NECESSARY.	RTS
PP	CEILING OR WALL MOUNTED DUAL TECHNOLOGY PHOTOCELL WITH DIMMING, COMPLETE WITH POWER PACKS AND RELAYS AS NECESSARY.	F
PS PS OS	CEILING OR WALL MOUNTED DUAL TECHNOLOGY OCCUPANCY SENSOR/PHOTOCELL WITH DIMMING, COMPLETE WITH POWER PACKS AND RELAYS AS NECESSARY. OCCUPANCY SENSOR	100cd
OR	2 HR. PROGRAMMABLE LOW VOLTAGE OVERRIDE SWITCH.	100cd
\$	SWITCH	S
WIFI	WIFI	H
		Ŵ
	POWER	
	480V - LIGHTING AND APPLIANCE PANELBOARD - FLUSH MOUNTED.	
	480V - LIGHTING AND APPLIANCE PANELBOARD - SURFACE MOUNTED. 208V - LIGHTING AND APPLIANCE PANELBOARD - FLUSH MOUNTED.	FACP
	208V - LIGHTING AND APPLIANCE PANELBOARD - SURFACE MOUNTED.	NACPS
	JUNCTION BOX IN ACCESSIBLE CEILING SPACE OR FLUSH IN WALL WITH BLANK COVER PLATE TO MATCH DEVICE PLATES.	FATC
Œ	20 AMP, 125 VOLT, DUPLEX GROUNDING TYPE RECEPTACLE. MOUNT AT 18" AFF TO CENTERLINE UNLESS NOTED OTHERWISE.	DH
	GFCI 20 AMP, 125 VOLT, DUPLEX GROUNDING TYPE RECEPTACLE. RECESS FLOOR MOUNTED DUPLEX RECEPTACLE, POKE THRU LEGRAND MODEL 6AT.	SD
\bigcirc	SPECIAL PURPOSE OUTLET. REFER TO DRAWINGS FOR DESCRIPTION. VERIFY EXACT LOCATION AND MOUNTING HEIGHT WITH ARCHITECT PRIOR TO ROUGH-IN.	F
—	SPLIT WIRED 20 AMP, 125 VOLT, DUPLEX GROUNDING TYPE RECEPTACLE (UPPER HALF SWITCHED, LOWER HALF ENERGIZED CONTINUOUSLY). MOUNT 18" AFF UNLESS NOTED OTHERWISE.	
—	20 AMP, 125 VOLT, QUADRUPLEX GROUNDING TYPE RECEPTACLES. MOUNT IN COMMON BOX WITH COMMON PLATE AT 18" AFF TO CENTERLINE UNLESS NOTED OTHERWISE.	
	20 AMP, 125 VOLT, DUPLEX TYPE RECEPTACLE. MOUNT ABOVE COUNTER, VERIFY MOUNTING HEIGHT. SHADED INDICATES SPLIT WIRED.	
	GFCI RECEPTACLE ABOVE COUNTER	
#	20 AMP, 125 VOLT, QUADRUPLEX GFI TYPE RECEPTACLES. MOUNT IN COMMON BOX WITH COMMON PLATE AT 18" AFF TO CENTERLINE UNLESS NOTED OTHERWISE.	
\bigoplus	20 AMP, 125 VOLT, QUADRUPLEX GROUNDING TYPE RECEPTACLES. POKE-THRU FLOOR MOUNTED IN COMMON BOX WITH COMMON PLATE.	
	COMBINATION FLOOR OUTLET WITH DEVICES AS INDICATED	
A (COMBINATION AV/ POWER OUTLET	#
5	MOTOR FURNISHED AND INSTALLED BY OTHERS, WIRED BY ELECTRICAL CONTRACTOR. CONNECT AS DIRECTED BY MOTOR SUPPLIER. NUMERAL INDICATES HORSEPOWER RATING "HP".	HEI
F 30/15/3	DISCONNECT SWITCH "F" DENOTES FUSIBLE, HEAVY DUTY TYPE (UNLESS NOTED OTHERWISE ON DRAWINGS) COMPLETE WITH FUSETRONS SIZED TO PROTECT MOTOR, EQUIPMENT OR CONDUCTORS (WHICHEVER IS APPLICABLE). SIZE, POLES, AND TYPE AS INDICATED. HORSEPOWER RATED, QUICK-MAKE, QUICK-BREAK. DISCONNECT SWITCH AND SPECIFICATIONS FOR DETAILS. 30/15/3 REFERS TO FRAME/TRIP/POLE.	
30/15/3	COMBINATION MOTOR STARTER AND HEAVY DUTY DISCONNECT SWITCH. 30/15/3 REFERS TO FRAME/TRIP/POLE. '0' REFERS TO NEMA SIZE. MOTOR STARTER. '0' REFERS TO NEMA SIZE.	
Τ	POWER TRANSFORMER. SIZE AND TYPE NOTED ON PLANS. REFER TO SPECIFICATIONS FOR DETAILS.	SHEET N
VAV	VARIABLE AIR VOLUME BOX (BY DIV 15).	E-001 E-002
CFSD	COMBINATION FIRE SMOKE DAMPER BOX (BY DIV 15). MOTORIZED DAMPER (BY DIV 15)	E-003 E-101
	POWER POLE.	E-102
		E-201 E-202
		E-401
	SPECIAL SYSTEMS	E-402 E-403
	TELEPHONE MOUNTED BACKBOARD "TMB". 3/4 INCH SANDED AND PAINTED (FIRE PROOFED) CPX PLYWOOD, 4' X 8' UNLESS NOTED OTHERWISE.	E-600
TA 🔁 2	TELEPHONE/DATA OUTLET DEVICE BOX. PROVIDE WITH 1" MINIMUM EMPTY CONDUIT	

TELEPHONE/DATA OUTLET DEVICE BOX. PROVIDE WITH 1" MINIMUM EMPTY CONDUIT WITH PULL STRING TO 4" ABOVE ACCESSIBLE CEILING. MOUNT AT 18" AFF TO CENTERLINE UNLESS NOTED OTHERWISE. TELEPHONE/DATA WIRING AND DEVICES BY OTHERS. "NUMERAL" ADJACENT INDICATES NUMBER OF TEL/DATA DROPS.
CABLE TELEVISION OUTLET. MOUNT AT 18" AFF TO CENTERLINE UNLESS NOTED OTHERWISE. VERIFY LOCATION WITH ARCHITECT PRIOR TO ROUGH-IN. USE 4-11/16" SQUARE BOX WITH SINGLE GANG PLASTER RING. PROVIDE BLANK COVERPLATE OVER ALL UNUSED OUTLETS. (SUBSCRIPT CCTV INDICATES CLOSED-CIRCUIT T.V. OUTLET)
VOLUME CONTROL AND CEILING RECESS SPEAKER. CONTRACTOR TO INSTALL J-BOX WITH 3 /4"C EXTENDED TO THE CEILING SPACE. SPEAKERS TO BE RADIO SHACK 8" DIA. MODEL 40-1366. INCLUDE WIRING FROM EACH VOLUME CONTROL TO THE SPEAKERS.
WIRELESS ACCESS POINT.


SECURITY SENSOR


EXISTING TO BE REMAIN (D)


- (E) DEMOLITION
- (R) RELOCATED

			•	AND ABBREVIATIONS
		Δ.	ABBREVIATIONS	
C	ACEWAY AND CONDUCTORS CONCEALED ABOVE CEILING OR IN WALL AT ELECTRICAL ONTRACTOR'S OPTION. #12 AWG MINIMUM SIZE CONDUCTOR UNLESS NOTED THERWISE.	A - A - AFF	AMPERE ABOVE FINISHED FLOOR	
	ONDUIT BELOW FLOOR OR UNDERGROUND. DEPTH OF UNDERGROUND CONDUITS HALL BE PER CEC.	AF AMP AFG	ARC FAULT, FUSE ABOVE FINISHED GRADE	LIGHTING FIXTURE PER DRAWINGS AND SCHEDULE
	XISTING CONDUIT OR BRANCH CIRCUIT TO REMAIN.	AIC AIC ARCH'L	AMPERE INTERRUPTING CAPACITY AL ALUMINUM ARCHITECTURAL AS AMP SWITCH	
	ACEWAY DOWN. #12 AWG MINIMUM SIZE CONDUCTOR UNLESS NOTED OTHERWISE.	AWG - B -	AMERICAN WIRE GAUGE	(5)
	ACEWAY UP. #12 AWG MINIMUM SIZE CONDUCTOR UNLESS NOTED OTHERWISE.	BC BLDG	BARE COPPER BUILDING BLDG	CEILING GRID AS CALLED FOR ON
Ć	ONTRACTOR MAY COMBINE UP TO THREE CIRCUITS IN ONE RACEWAY.	- C - C	CONDUIT	ARCH.'L DRAWINGS
	ONDUIT STUB OUT, CAP END OF CONDUIT.	CAB CAT C/B	CABINET CATALOG/CATEGORY CIRCUIT BREAKER	KEY NOTES:
	ONDUIT SLEEVE.	CKT CLG	CIRCUIT CEILING	(1) ATTACH WIRE TO FIXTURE (3 MIN. IN 1 1/2" MAX.).
	FIRE ALARM (NOT USED)	CO, CC CU	CONDUIT ONLY COMM COMMUNICATION COPPER	2 "TEK" SCREW GRID TO FIXTU 3 CORNER.
	PHOTOELECTRIC SMOKE DETECTOR, DUCT TYPE COMPLETE WITH PROBE, FURNISHED	- D - DEMO	DEMOLITION/DEMOLISH	ATTACH HANGER WIRES TO PER STRUCTURAL & ARCHIT
N	AND WIRED BY ELECTRICAL CONTRACTOR, INSTALLED AND CONTROL WIRING BY MECHANICAL CONTRACTOR.	DISC. DN DWG	DISCONNECT DOWN DRAWING	DETAILS.
	IUNCTION BOX FOR SMOKE/FIRE DAMPER BY OTHERS. PROVIDE 120V POWER TO IUNCTION BOX AND PROVIDE PHOTOELECTRIC, DUCT TYPE SMOKE DETECTOR ON SUPPLY SIDE OF DAMPER. CONNECT DUCT-TYPE SMOKE DETECTOR TO FIRE ALARM	(D) - E -	DEMOLITION	
	SYSTEM FOR MONITORING ONLY. VERIFY EXACT LOCATIONS OF SMOKE/FIRE DAMPER AND COORDINATE WIRING REQUIREMENTS WITH EQUIPMENT SUPPLIER PRIOR TO ROUGH-IN.	EA ELEC. ELEV	EACH ELECTRICAL ELEVATOR	
RTS	REMOTE TEST/STATUS STATION FOR DUCT SMOKE DETECTOR. FURNISHED AND	ELEV EM EMT	ELEVATOR EMERGENCY ELECTRICAL METALLIC TUBING	STEEL STUD 1 HOUR GYPSUM STEEL STUD 1 HOUR 3M FIRE BARRIER SM FIRE BA CONCRETE BARRIER CP 25WP CA
	NSTALLED BY ELECTRICAL CONTRACTOR. LOCATE BELOW UNIT, ABOVE FALSE CEILING.	EQUIP (E)	EQUIPMENT EXISTING TO REMAIN	WALLBOARD ASSEMBLY 4" 4" 4-5/8" 5-3/8" 4"
	AT 44" AFF TO CENTERLINE UNLESS NOTED OTHERWISE.	- F - FBO FF	FURNISHED BY OTHERS FINISHED FLOOR	MAX. 4" DIA. STEEL PIPE, CONDUIT OR
	AT 80" AFF TO CENTERLINE UNLESS NOTED OTHERWISE. NUMBER INDICATES CANDELA RATING.	FIXT FLEX	FIXTURE FLEXIBLE METALLIC CONDUIT(STEEL)	WIREMOLD. UL #WL1001 PENETRATION THRU GYPSUM BOARD WALL F NO SCALE NO
	NALL MOUNTED FIRE ALARM VISUAL ONLY SIGNAL. REFER TO SPECIFICATIONS FOR DETAILS. MOUNT AT 80" AFF TO CENTERLINE UNLESS NOTED OTHERWISE. NUMBER	FLOR FT	FLUORESCENT FEET OR FOOT	PENETRATION SHALL BE SPACED AT : REMETIRATION SIZE SHALL NOT EXCE DIAMETER.
F	NDICATES CANDELA RATING. FIRE ALARM SMOKE DETECTOR, PHOTOELECTRIC TYPE UNLESS NOTED OTHERWISE.	- G - GFA GFCI	GROUND FAULT ALARM GROUND FAULT CIRCUIT INTERRUPTER	SYSTEM NO. WL1001 (FORMERLY SYSTEM NO. 147) F RATINGS - 1,2,3, AND 4 HR (SEE ITEMS 2 AND 3) T RATINGS - 0,1,2,3, AND 4 HR (SEE ITEM 3)
	CEILING MOUNTED, REFER TO SPECIFICATIONS FOR DETAILS.	GND - H - HP	GROUND	L RATING AT AMBIENT - LESS THAN 1 CFM/SQ FT (SEE ITEM 3) L RATING AT 400 F - LESS THAN 1 CFM/SQ FT (SEE ITEM 3)
	SPRINKLER SYSTEM FLOW SWITCH FURNISHED AND INSTALLED BY FIRE PROTECTION	HVAC	HEATING, VENTILATING & AIR CONDITIONING	NOTES: 1. WALL ASSEMBLY - THE 1,2,3 OR 4 HR FIRE -RATED GYPSUM W BOARD/STUD WALL ASSEMBLY SHALL BE CONSTRUCTED OF MATERIALS AND IN THE MANNER DESCRIBED IN THE INDIVIDU
F F	CONTRACTOR, CONNECTED TO FIRE ALARM SYSTEM BY ELECTRICAL CONTRACTOR. PROVIDE ZONE ADDRESSABLE (MONITOR) MODULE AS REQUIRED FOR CONNECTION TO FIRE ALARM SYSTEM. VERIFY EXACT LOCATION WITH EQUIPMENT SUPPLIER PRIOR TO	IBC IMC	INTERNATIONAL BUILDING CODE INTERMEDIATE METAL CONDUIT	OR JEMALS AND IN THE MANURE DESIGNED BUT HE DULFIRE OR U400 SERIES WALL OR PARTITION DESIGN IN THE ULFIRE RESISTANCE DIRECTORY AND SHALL INCLUDE THE FOLLOWIN CONSTRUCTION FEATURES :
	ROUGH-IN. SPRINKLER SYSTEM TAMPER SWITCH FURNISHED AND INSTALLED BY FIRE PROTECTION	IN IRC ISC	INCH(ES) INTERNATIONAL RESIDENTIAL CODE SHORT CIRCUIT AMPERES	a. STUDS - WALL FRAMING MAY CONSIST OR EITHER WOOD MAX.2 HR FIRE RATED ASSEMBLIES) OR STEEL CHANNEL WOOD STUDS TO CONSIST OF NOM 2 BY 4 IN. LUMBER SP 18 IN. OC WIT NOM 2 BY 4 IN. LUMBER AND PLATES AND BRACES. STEEL STUDS TO BE MIN 3-8/8 IN. WIDE BY 1-3/8
F	CONTRACTOR, CONNECTED TO FIRE ALARM SYSTEM BY ELECTRICAL CONTRACTOR. PROVIDE ZONE ADDRESSABLE (MONITOR) MODULE AS REQUIRED FOR CONNECTION TO FIRE ALARM SYSTEM. VERIFY EXACT LOCATION WITH EQUIPMENT SUPPLIER PRIOR TO	JB, J-BOX	JUNCTION BOX	CHANNELS SPACED MAX 24 IN. CC . b. WALLBOARD, GYPSUM - NOM 1/2 OR 8/8 IN.THICK , 4 FT.W. SQUARE OR TAPERED EDGES. THE GYPSUM WALLBOARD
F	ROUGH-IN.	- K - KCMIL, MCM KVA	THOUSAND CIRCULAR MILS KILOVOLT AMPERE	THICKNESS,NUMBER OF LAYERS, FASTENER TYPE AND S ORIENTATION SHALL BE SPECIFIED IN THE INDIVIDUAL U3 U400 SERIES DESIGN IN THE UL FIRE RESISTANCE DIREC MAX DIA. OF OPENING IS 13-1/2 IN.
FAAD	FIRE ALARM SYSTEM CONTROL PANEL. REFER TO SPECIFICATIONS FOR DETAILS.	KW - L -	KILOWATT	
	DETAILS.	LTG - M -		TYP. CONDUIT THROUG
	FIRE ALARM TERMINAL CABINET.	MAX. MCB MECH.	MAXIMUM MAIN CIRCUIT BREAKER MECHANICAL	
	AGNETIC DOOR HOLDER FURNISHED BY GENERAL CONTRACTOR, INSTALLED AND WIRED BY ELECTRICAL CONTRACTOR. PROVIDE ZONE ADDRESSABLE (CONTROL) ADDULE AS REQUIRED TO CONNECT TO FIRE ALARM SYSTEM. VERIFY EXACT LOCATION	MIN. MLO	MINIMUM MAIN LUGS ONLY	
, , , , , , , , , , , , , , , , , , ,	AND MOUNTING REQUIREMENTS WITH ARCHITECT PRIOR TO ROUGH-IN.	MTD - N - NC	MOUNTED	
5	FIRE ALARM (CEILING MOUNTED) SMOKE DETECTOR	NEC NECA	NATIONAL ELECTRICAL CODE NATIONAL ELECTRICAL CONTRACTOR'S ASSOCIATION	WALL MOUNTED PANEL/TERMINAL CABINET. 150 POUNDS
	FA PULL STATION (WALL MOUNTED)	NEMA NEUT NFC	NATIONAL ELECTRICAL MANUFACTURERS ASSOCIATION NEUTRAL	MAXIMUM.
	HORN STROBE (CEILING MOUNTED)	NF NIC	NATIONAL FIRE CODE NON-FUSIBLE NOT IN CONTRACT	×
	WIRING	NL NO	NIGHT LIGHT NORMALLY OPEN	6'-0" MAX
	CONDUIT ROUTED UNDERFLOOR / UNDERGROUND RACEWAY W/#12 CONDUCTORS UNO	NPCO NTS (N)	NEVADA POWER COMPANY NOT TO SCALE NEW	
	→ RACEWAY TURNED UP → RACEWAY TURNED DOWN	- 0 - OCP	OVERCURRENT PROTECTION	
	HOMERUN TO PANELBOARD 1/2"C W/3#12 CONDUCTORS UNO	- P - P	POLE	
(CONDUIT CAP-OFF	PH PNL PV	PHASE PANEL PV PHOTOVOLTAIC	
	MISCELLANEOUS	PVC PWR	POLYVINYL CHLORIDE POWER	T
		QTY	QUANTITY	
#	EQUIPMENT TAG	- R - RECEP REQ'D	RECEPTACLE REQUIRED	EC
# SHEET	DIAGRAM TAG	RSC (R)	RIGID STEEL CONDUIT RELOCATED	
	REVISION SYMBOL	- S - SCHED SECT	SCHEDULE SECTION	
	KEYNOTE SYMBOL	SP SN	SINGLE POLE SOLID NEUTRAL	
		SPEC SW SWBD	SPECIFICATION SWITCH SWITCHBOARD	
	ELECTRICAL SHEET INDEX	SWBD SWGR SYS	SWITCHBOARD SWITCH GEAR SYSTEM	
SHEET NO	. SHEET TITLE	- T - TEMP	TEMPORARY	
E-001	GENERAL NOTES, ABBREVIATIONS, SYMBOL LIST & SHEET INDEX	TELE T-STAT TTB	TELEPHONE THERMOSTAT TELEPHONE TERMINAL BACKBOARD	
E-002 E-003	SINGLE LINE DIAGRAM PANEL SCHEDULE	TTB TYP.	TELEPHONE TERMINAL CABINET TYPICAL	
E-101 E-102	DEMOLITION POWER PLAN DEMOLITION LIGHTING PLAN	- U - UBC		
E-201	POWER PLAN	UL U.N.O. - V -	UNDERWRITERS LABORATORY UNLESS NOTED OTHERWISE	
E-202 E-401	LIGHTING PLAN AND LIGHTING FIXTURE PHOTOMETRIC CALCULATION	V VA	VOLT OR VOLTAGE VOLT AMPERE	
E-402	EMERGENCY PHOTOMETRIC CALCULATION	VD VP	VOLTAGE DROP VAPOR PROOF	
E-403 E-600	IOBBY PHOTOMETRIC CALCULATION TITLE 24 INDOOR COMPLIANCE FORMS	- W - W WCB	WATT, WIRE	
	APPLICABLE CODES	WCR WP	WITHSTAND CURRENT RATING UL LISTED WEATHERPROOF, NEMA 3R	
• 2016	CALIFORNIA ADMINISTRATIVE CODE (CAC)	- X - XFMR	TRANSFORMER	
	PART 1, TITLE 24, CALIFORNIA CODE OF REGULATIONS (CCR)			
• 2016		1		
	PART 2, TITLE 24, CALIFORNIA CODE OF REGULATIONS (CCR)			
• 2016	CALIFORNIA ELECTRICAL CODE (CEC) PART 3, TITLE 24, CALIFORNIA CODE OF REGULATIONS (CCR)			
 2016 2016	CALIFORNIA ELECTRICAL CODE (CEC) PART 3, TITLE 24, CALIFORNIA CODE OF REGULATIONS (CCR) CALIFORNIA MECHANICAL CODE (CMC) PART 4, TITLE 24, CALIFORNIA CODE OF REGULATIONS (CCR)			
• 2016	CALIFORNIA ELECTRICAL CODE (CEC) PART 3, TITLE 24, CALIFORNIA CODE OF REGULATIONS (CCR) CALIFORNIA MECHANICAL CODE (CMC)			


PART 6, TITLE 24, CALIFORNIA CODE OF REGULATIONS (CCR) 2016 CALIFORNIA FIRE CODE (CFC) PART 9, TITLE 24, CALIFORNIA CODE OF REGULATIONS (CCR) CALIFORNIA GREEN BUILDING CODE (CGBC) • 2016 PART 11, TITLE 24, CALIFORNIA CODE OF REGULATIONS (CCR)

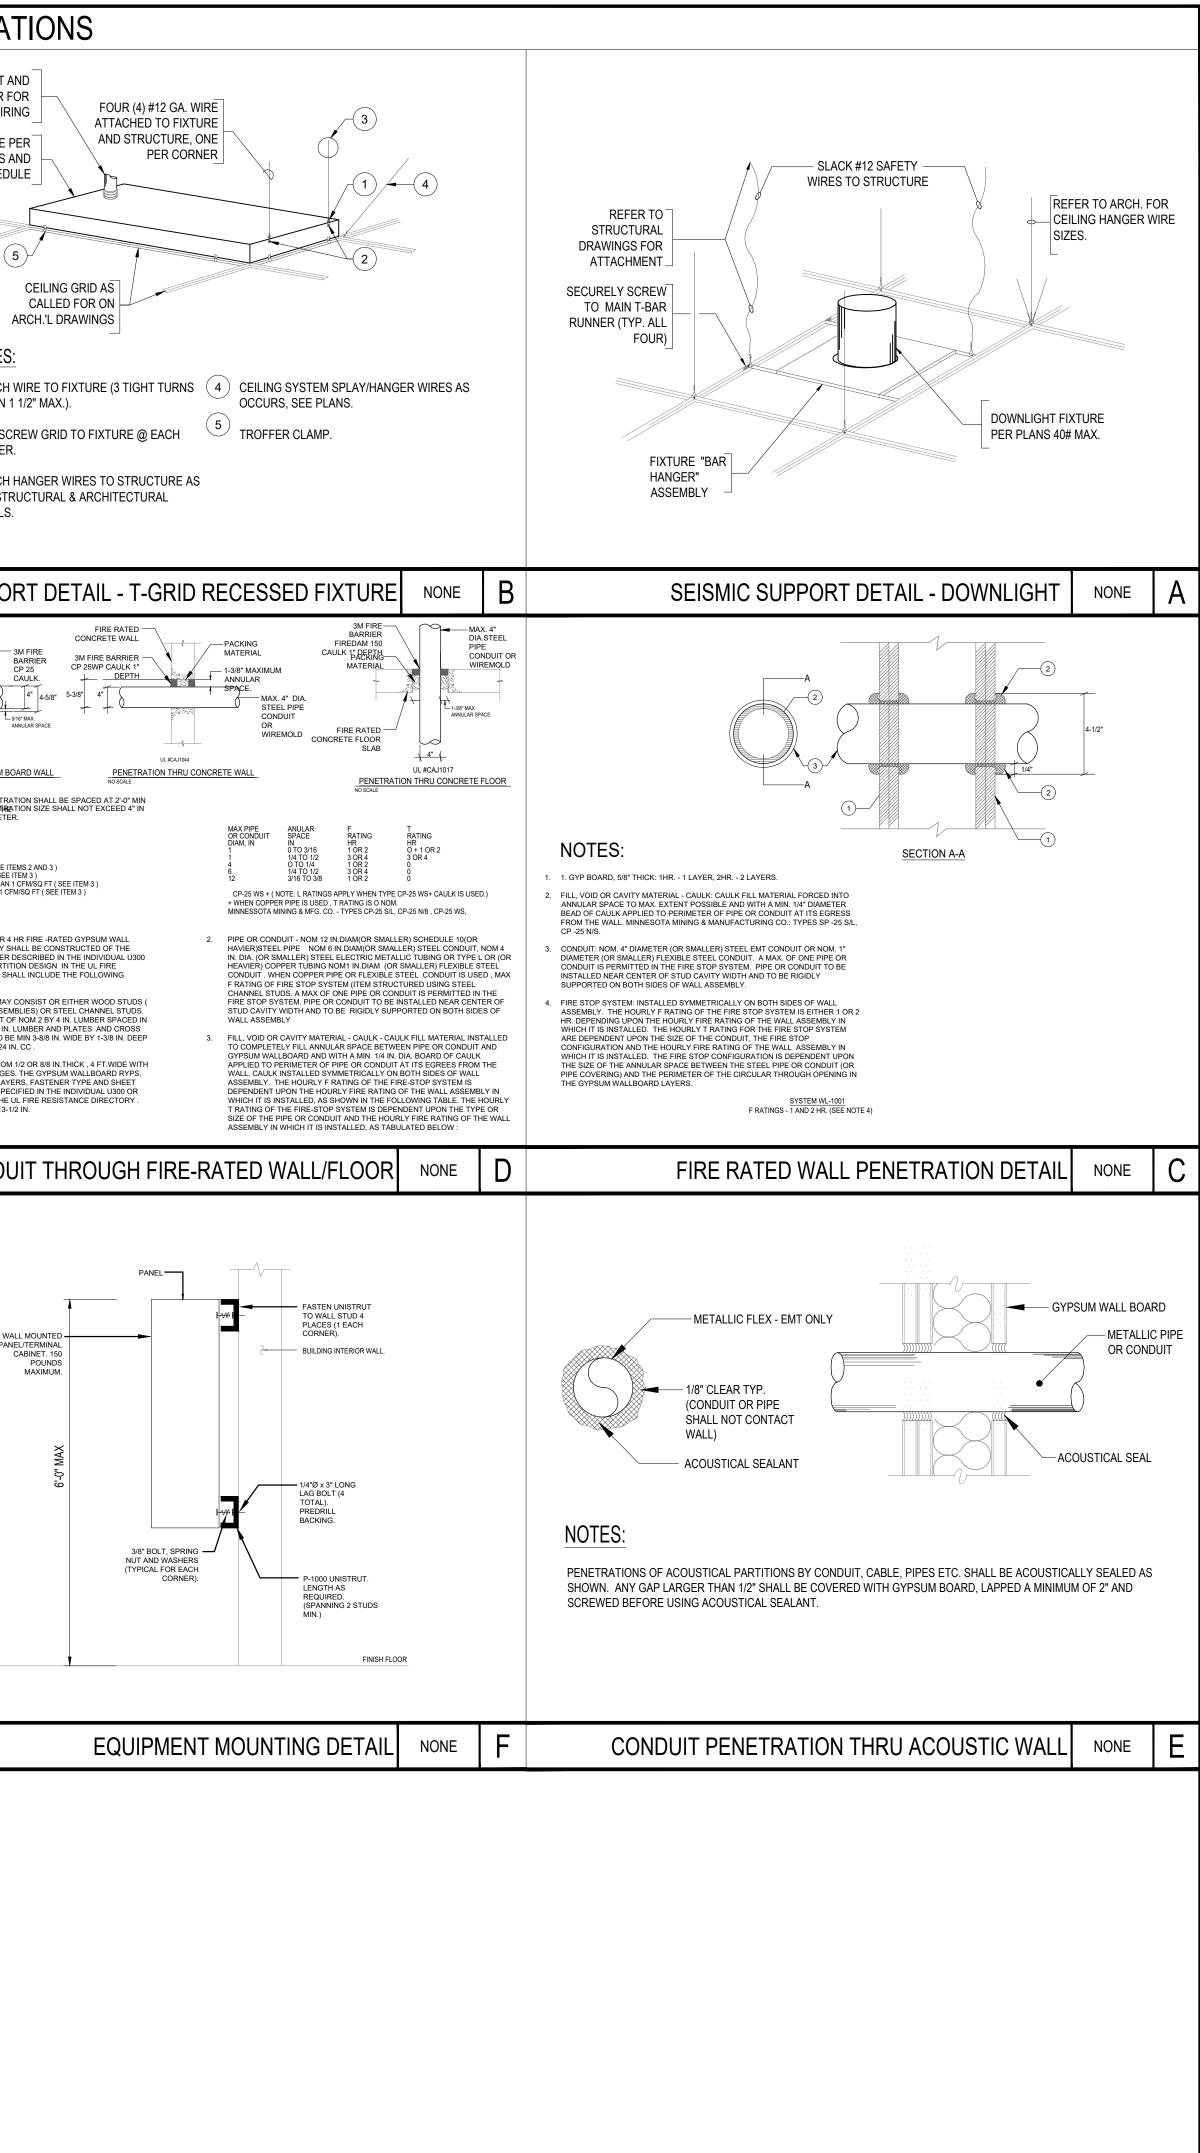

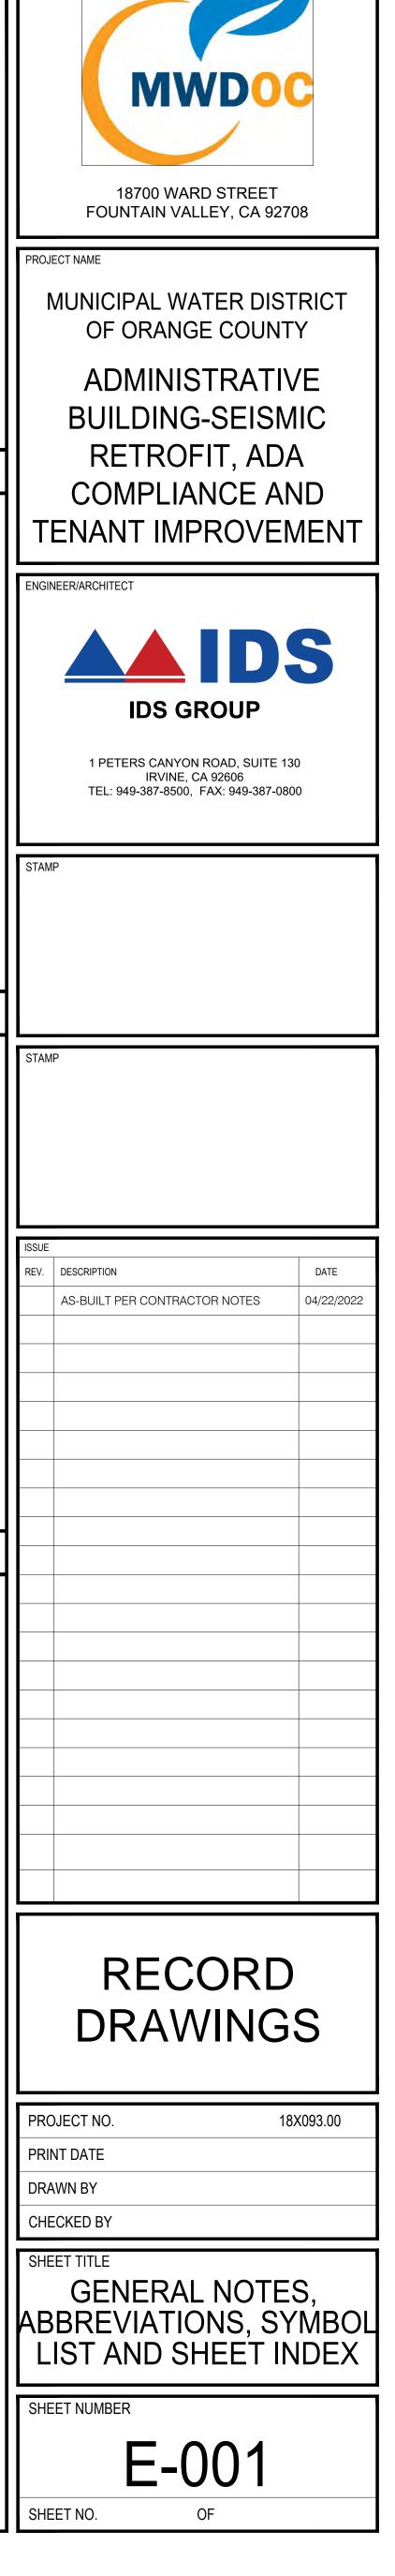

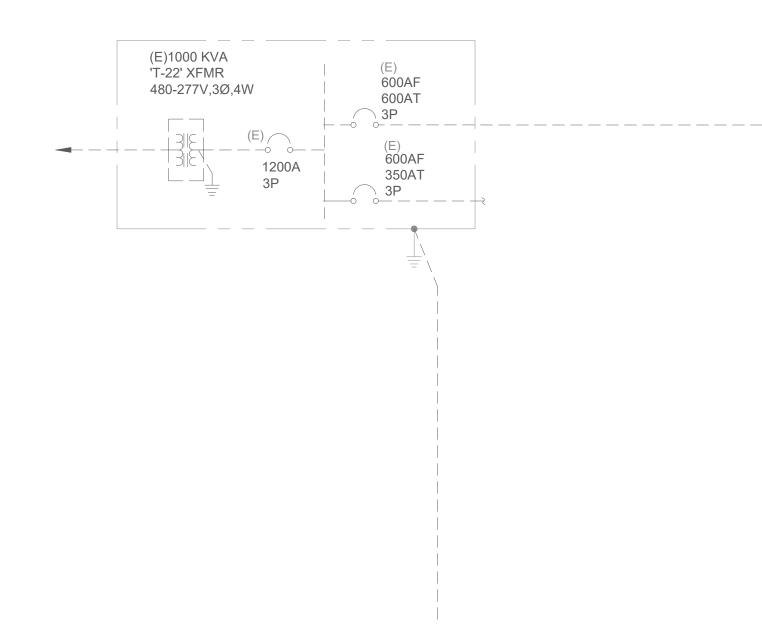

MOTOR	VOLTS	PH	HP	FLA	FLAx4
(E) CHILLER NO. 1	480	3		107	429
(E) CHILLER NO.2	480	3		107	429
(E) AHU-2	480	3	1.5	22	88
	480	3			0
	480	3			0
	480	3			0
	480	3	r = 1		0
	480	3			0
	480	3			0
	480	3	= 1		0
TOTAL			200		946

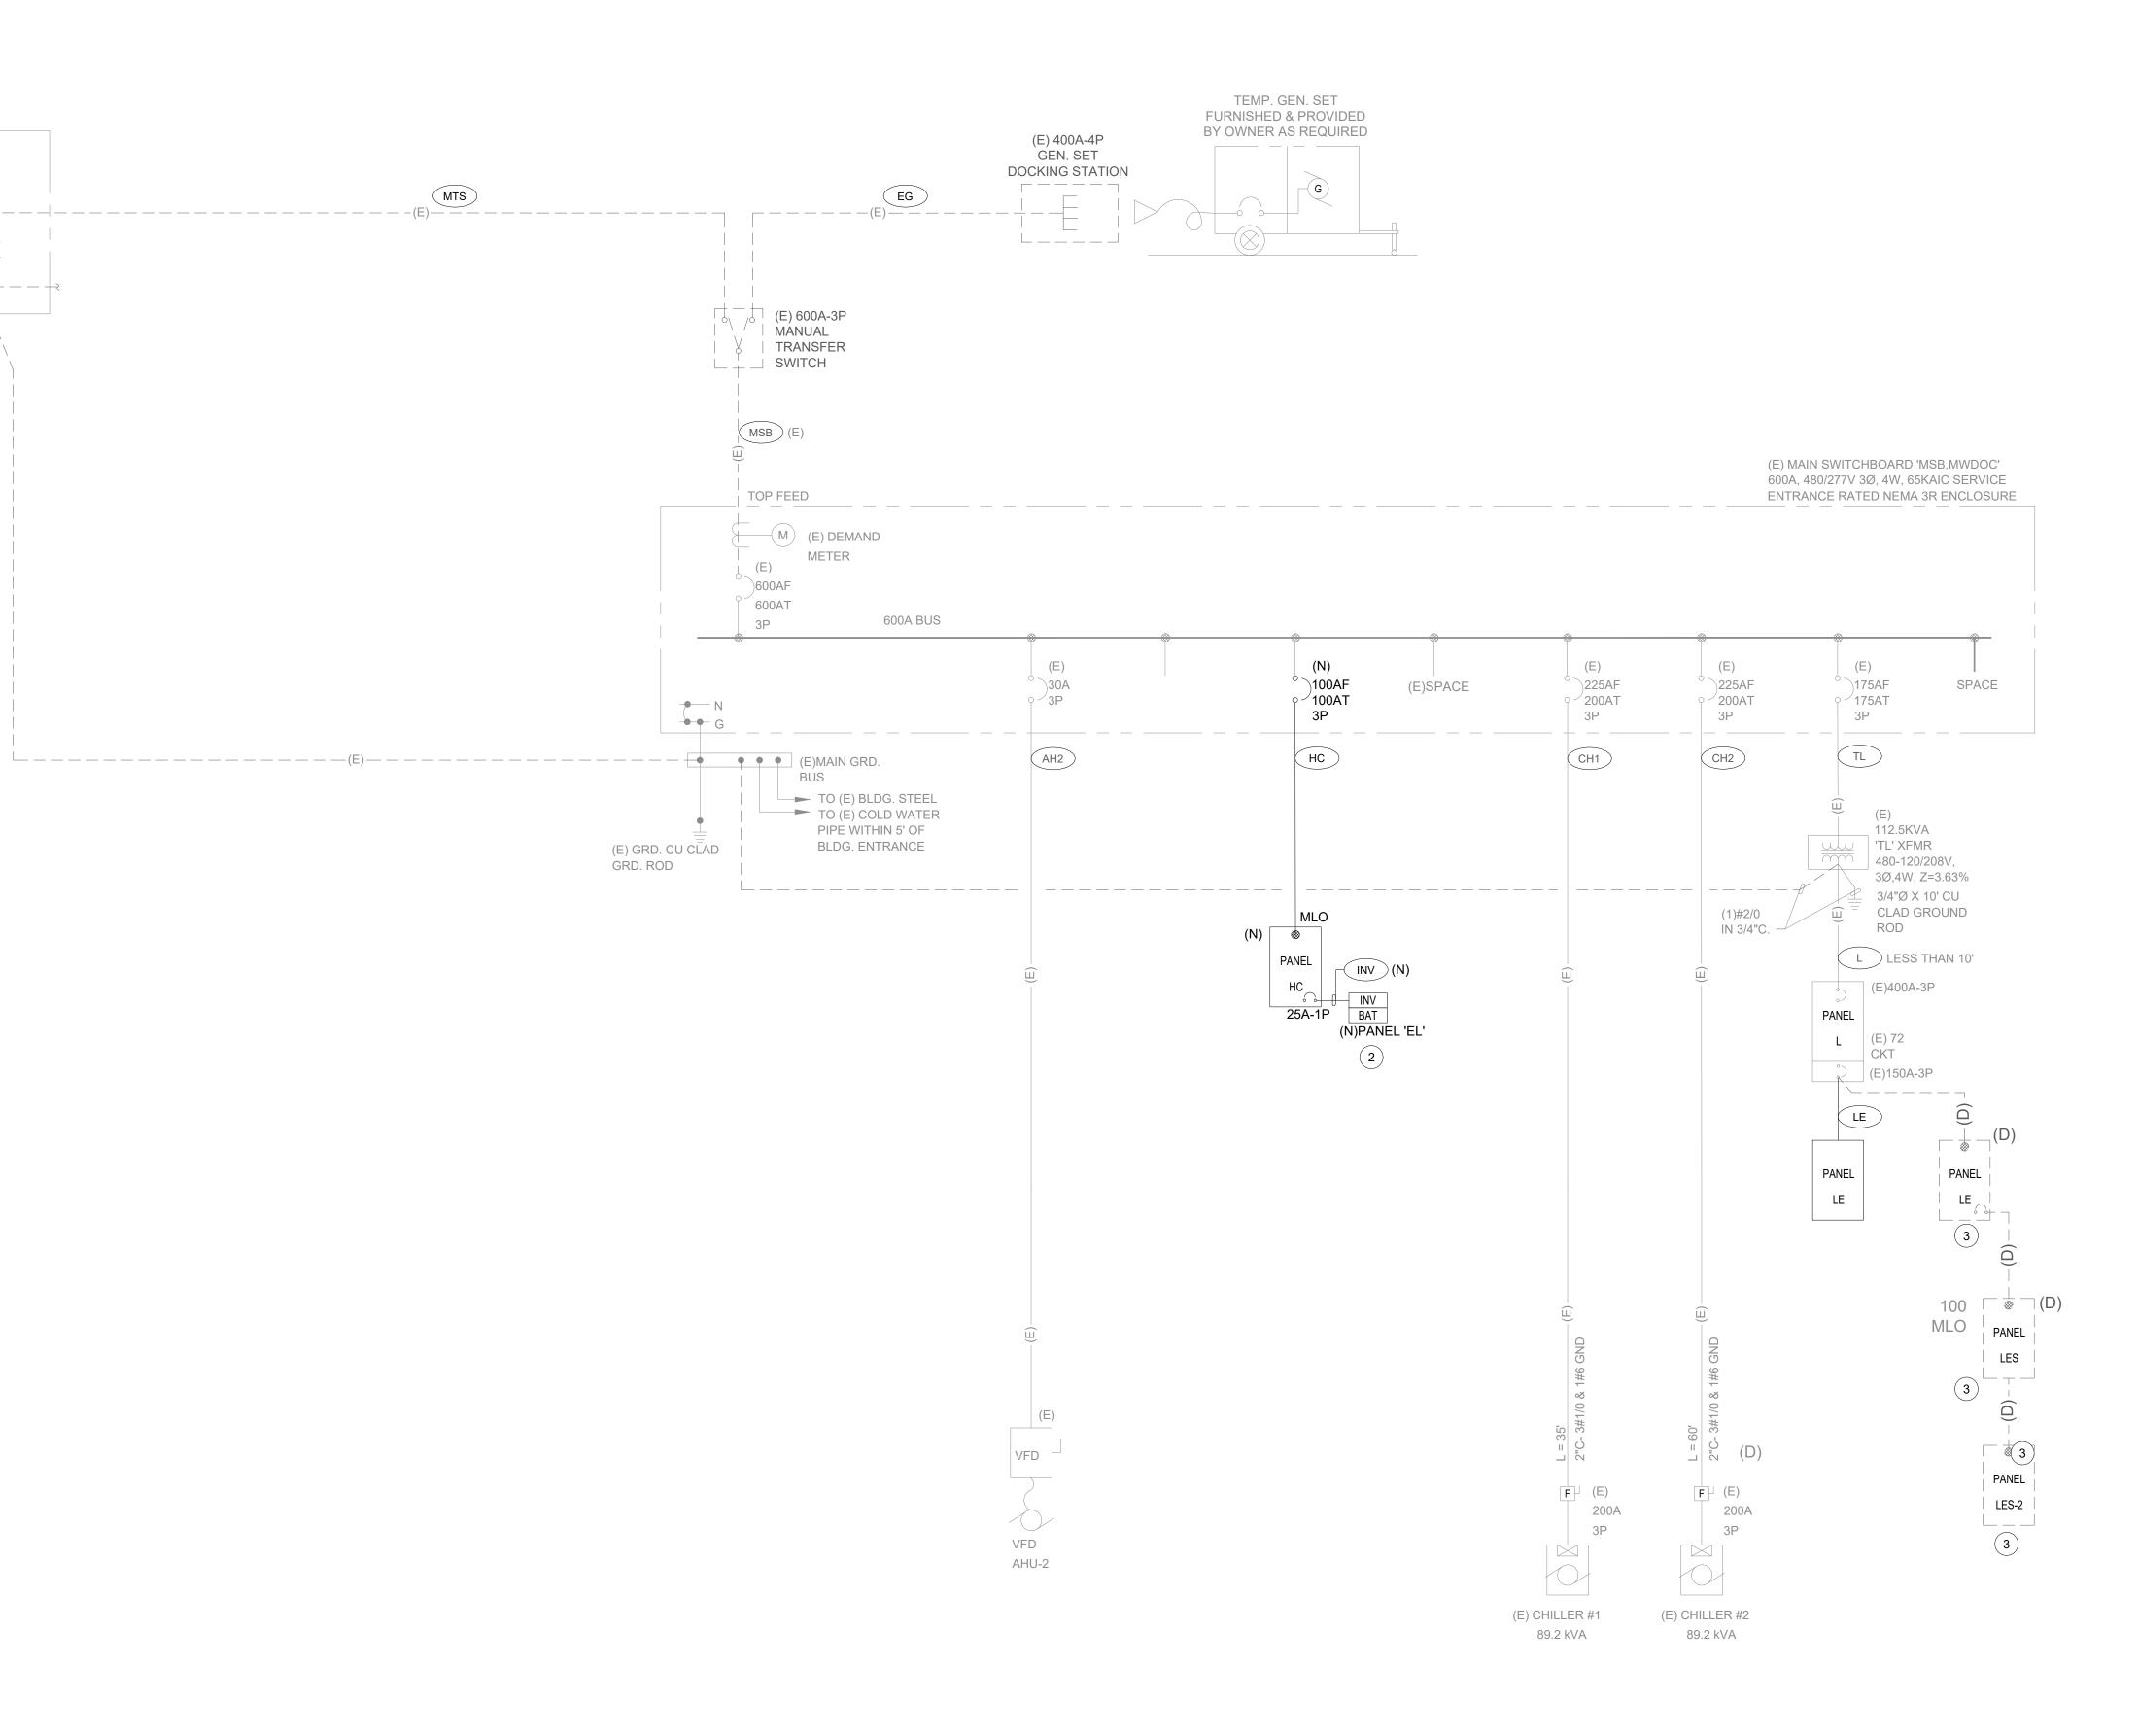


DISTRIBUTION BOARD '	MSB-MWDOC'	- 'FEEDER SCHEI	DULE AND L	CALCULATIONS

LOAD								FEEDERS								VOLTAGE DROP CALCULATIONS				AFC CALCULATIONS		
NAME	PF	VOLTS	ø	CONN	NECTED	DEMAND		#	co	γ		IRE PER	GND.PER CONDUIT	EST.	REMARKS	FEEDER SEGMENT DROP ONLY		NET DROP AT DEVICE		AFC FROM	MOTOR CONTRI-	NET AFC AT
				HP	KVA	KVA	AMPS		#	SIZE	#	SIZE	SIZE	DIST.		VOLTS DROP	%	VOLTS DROP	%		BUTION	DEVIC
																						<u> </u>
(E) GEN SET DOCK STATION	0.80	480	3					EG	1	4"	3	600kcmil	#3	80								
(E) MTS (FED FROM 'T-22'	1.00	480	3		375	309	371	MTS	2	4''	3	350kcmil	#1	300	EXISTING CONDITIONS	5.79	1.2%	5.79	1.2%	21,900		21,90
(E) SWBD. 'MSB-MWDOC'	1.00	480	3		SAME	SAME		MSB	2	4"	3	350kcmil	#1	20	EXISTING CONDITIONS	0.31	0.1%	6.10	1.3%	21,900	946	22,00
(E) CHILLER NO. 1	1.00	480	3		89.2	89.2	107	CH1	1	4''	3	3/0	#6	80	INTERCEPTED FDR	1.40	0.3%	7.50	1.6%	22,002		14,72
(E) CHILLER NO.2	1.00	480	3		89.2	89.2	107	CH2	1	4"	3	3/0	#6	80	INTERCEPTED FDR	1.40	0.3%	7.50	1.6%	22,002		14,72
(E) AHU-2	1.00	480	3		20.0	20.0	24	AH2	1	4"	3	#10	#10	40	INTERCEPTED FDR	1.83	0.4%	7.93	1.7%	22,002		5,193
(D) PANEL 'HC	1.00	480	3												DISC. / REMOVE							
(D) XFMR "TB"		480	3												DISC. / REMOVE							
(D) PANEL 'LE'		208	3												DISC. / REMOVE							1
(D PANEL 'LES'		208	3												DISC. / REMOVE							
(D) PANEL 'LES-2'		208	3												DISC. / REMOVE							
(N) PANEL 'HC'	1.00	480	3		60	50	61	н	1	(E)2''	4	#1	#8	40	EMT / COPPER	0.67	0.1%	6.77	1.4%	22,002		15,32
(N) INVERTER	1.00	277	1		3.75	4	14	н	1	3/4"	2	#12	#10	5	EMT / COPPER	0.20	0.1%	6.97	2.5%	15,327		8,080
(E) TRANSFORMER 'T-L'		480	3		112.5			TL	1	2"	3	2/0	#6	10	EMT / COPPER	0.00	0.0%	0.00	0.0%	21,900		20,40
(E) PANEL 'L'		208	3			56	156	L	2	2"	4	3/0	#3	23	EMT / COPPER	0.29	0.1%	0.29	0.1%	20,401		6,899
(N) PANEL 'LE'		208	3			20	25	LE	1	2"	4	1/0	#6	20	EMT / COPPER	0.11	0.1%	0.40	0.2%	6,899		6,112

	CIRCUIT CALCULATIONS AND THE AIC RATING INDICATED FOR EAU DEVICE IS ADEQUATE TO PROTECT THE EQUIPMENT AND THE ELECTRICAL SYSTEM.
2.	THE DESIGN PROFESSIONAL HAS PERFORMED REQUIRED VOLTAGE DROP CALCULATIONS AND BRANCH CIRCUITS AND FEEDERS COMPLY WITH NEC 210-19(A) FPN NO. 4.
3.	FAULT CURRENT CALCULATIONS ASSUME UTILITY PROVIDED KVA UTILITY TRANSFORMER WITHA OF AVAILABLE FAUL CURRENT LOCATED FEET FROM MAIN SWITCHBOARD. REFER T POWER UTILITY DRAWINGS FOR EXACT SIZE AND LOCATION. NOT ENGINEER IN WRITING IF TRANSFORMER SIZE IS INCREASED OR DISTANCE IS DECREASED.
4.	 GROUND FAULT RELAY SETTINGS: A. TO MINIMIZE NUISANCE TRIPPING OF THE MAIN AND FEEDER BREAKER, THE CONTRACTOR SHALL ADJUST THE GROUND FAULT RELAY SETTINGS FOR THE GFP DEVICES TO BE HIGHE THAN DOWNSTREAM GFP AND NON-GFP DEVICES. THE GROU FAULT CURRENT PICK-UP AND TIME DELAY SETTINGS SHALL ADJUSTED, PER THE MANUFACTURERS RECOMMENDATIONS, RESULTING FROM A CONTRACTOR /MANUFACTURER PREPAR COORDINATION STUDY - WHICH SHALL BE DOCUMENTED IN T SHOP DRAWING SUBMITTAL.
	B. DURING THE CONSTRUCTION PHASE OF THE PROJECT, GROU FAULT RELAYS SHALL BE SET AT THE SHORTEST AVAILABLE TIME DELAY.
	 C. AFTER SETTINGS HAVE BEEN ADJUSTED, THE CONTRACTOR SHALL HAVE THE GROUND FAULT SYSTEM TESTED BY AN INDEPENDENT TESTING AGENCY PER NEC 230-95 (C). THIS TE SHALL BE PERFORMED IN THE PRESENCE OF THE LOCAL AUTHORITY HAVING JURISDICTION AND THE TEST RESULTS SHALL BE DELIVERED TO THE ENGINEER OF RECORD.
K	EY NOTES
	EXISTING INFORMATION IS BASED ON AS-BUILT CONDITIONS VERIFIE MAY 2020.
(1 (2	MAY 2020. 3.75KW CENTRAL LIGHTING BATTERY INVERTER, 277V INPUT/OUTPU OPERATION, 90° BATTERY OPERATION, SUITABLE FOR LED & H.I.D.
	MAY 2020.
	 MAY 2020. 3.75KW CENTRAL LIGHTING BATTERY INVERTER, 277V INPUT/OUTPUT OPERATION, 90° BATTERY OPERATION, SUITABLE FOR LED & H.I.D. LIGHT FIXTURES. 10KAIC RATED. EQUIP WITH (6) 20A-1P CIRCUIT BREAKERS. MEYERS #CM SERIES OR EQUAL. SEE DETAIL 1, SHEET E-003. CONTRACTOR SHALL FIELD VERIFY ALL EXISTING LOADS, DISCONNE FROM EXISTING PANEL, INTERCEPT CIRCUITS IN A NEW WIREWAY ABOVE CEILING AND EXTEND TO UPGRADED PANELS. UPDATE PANE
	 MAY 2020. 3.75KW CENTRAL LIGHTING BATTERY INVERTER, 277V INPUT/OUTPUT OPERATION, 90° BATTERY OPERATION, SUITABLE FOR LED & H.I.D. LIGHT FIXTURES. 10KAIC RATED. EQUIP WITH (6) 20A-1P CIRCUIT BREAKERS. MEYERS #CM SERIES OR EQUAL. SEE DETAIL 1, SHEET E-003. CONTRACTOR SHALL FIELD VERIFY ALL EXISTING LOADS, DISCONNE FROM EXISTING PANEL, INTERCEPT CIRCUITS IN A NEW WIREWAY
	 MAY 2020. 3.75KW CENTRAL LIGHTING BATTERY INVERTER, 277V INPUT/OUTPUT OPERATION, 90° BATTERY OPERATION, SUITABLE FOR LED & H.I.D. LIGHT FIXTURES. 10KAIC RATED. EQUIP WITH (6) 20A-1P CIRCUIT BREAKERS. MEYERS #CM SERIES OR EQUAL. SEE DETAIL 1, SHEET E-003. CONTRACTOR SHALL FIELD VERIFY ALL EXISTING LOADS, DISCONNE FROM EXISTING PANEL, INTERCEPT CIRCUITS IN A NEW WIREWAY ABOVE CEILING AND EXTEND TO UPGRADED PANELS. UPDATE PANE
	 MAY 2020. 3.75KW CENTRAL LIGHTING BATTERY INVERTER, 277V INPUT/OUTPUT OPERATION, 90° BATTERY OPERATION, SUITABLE FOR LED & H.I.D. LIGHT FIXTURES. 10KAIC RATED. EQUIP WITH (6) 20A-1P CIRCUIT BREAKERS. MEYERS #CM SERIES OR EQUAL. SEE DETAIL 1, SHEET E-003. CONTRACTOR SHALL FIELD VERIFY ALL EXISTING LOADS, DISCONNE FROM EXISTING PANEL, INTERCEPT CIRCUITS IN A NEW WIREWAY ABOVE CEILING AND EXTEND TO UPGRADED PANELS. UPDATE PANE
	 MAY 2020. 3.75KW CENTRAL LIGHTING BATTERY INVERTER, 277V INPUT/OUTPU^T OPERATION, 90° BATTERY OPERATION, SUITABLE FOR LED & H.I.D. LIGHT FIXTURES. 10KAIC RATED. EQUIP WITH (6) 20A-1P CIRCUIT BREAKERS. MEYERS #CM SERIES OR EQUAL. SEE DETAIL 1, SHEET E-003. CONTRACTOR SHALL FIELD VERIFY ALL EXISTING LOADS, DISCONNE FROM EXISTING PANEL, INTERCEPT CIRCUITS IN A NEW WIREWAY ABOVE CEILING AND EXTEND TO UPGRADED PANELS. UPDATE PANE
	 MAY 2020. 3.75KW CENTRAL LIGHTING BATTERY INVERTER, 277V INPUT/OUTPU^T OPERATION, 90° BATTERY OPERATION, SUITABLE FOR LED & H.I.D. LIGHT FIXTURES. 10KAIC RATED. EQUIP WITH (6) 20A-1P CIRCUIT BREAKERS. MEYERS #CM SERIES OR EQUAL. SEE DETAIL 1, SHEET E-003. CONTRACTOR SHALL FIELD VERIFY ALL EXISTING LOADS, DISCONNE FROM EXISTING PANEL, INTERCEPT CIRCUITS IN A NEW WIREWAY ABOVE CEILING AND EXTEND TO UPGRADED PANELS. UPDATE PANE
	 MAY 2020. 3.75KW CENTRAL LIGHTING BATTERY INVERTER, 277V INPUT/OUTPU OPERATION, 90° BATTERY OPERATION, SUITABLE FOR LED & H.I.D. LIGHT FIXTURES. 10KAIC RATED. EQUIP WITH (6) 20A-1P CIRCUIT BREAKERS. MEYERS #CM SERIES OR EQUAL. SEE DETAIL 1, SHEET E-003. CONTRACTOR SHALL FIELD VERIFY ALL EXISTING LOADS, DISCONNE FROM EXISTING PANEL, INTERCEPT CIRCUITS IN A NEW WIREWAY ABOVE CEILING AND EXTEND TO UPGRADED PANELS. UPDATE PANE

GENERAL NOTES

| 1

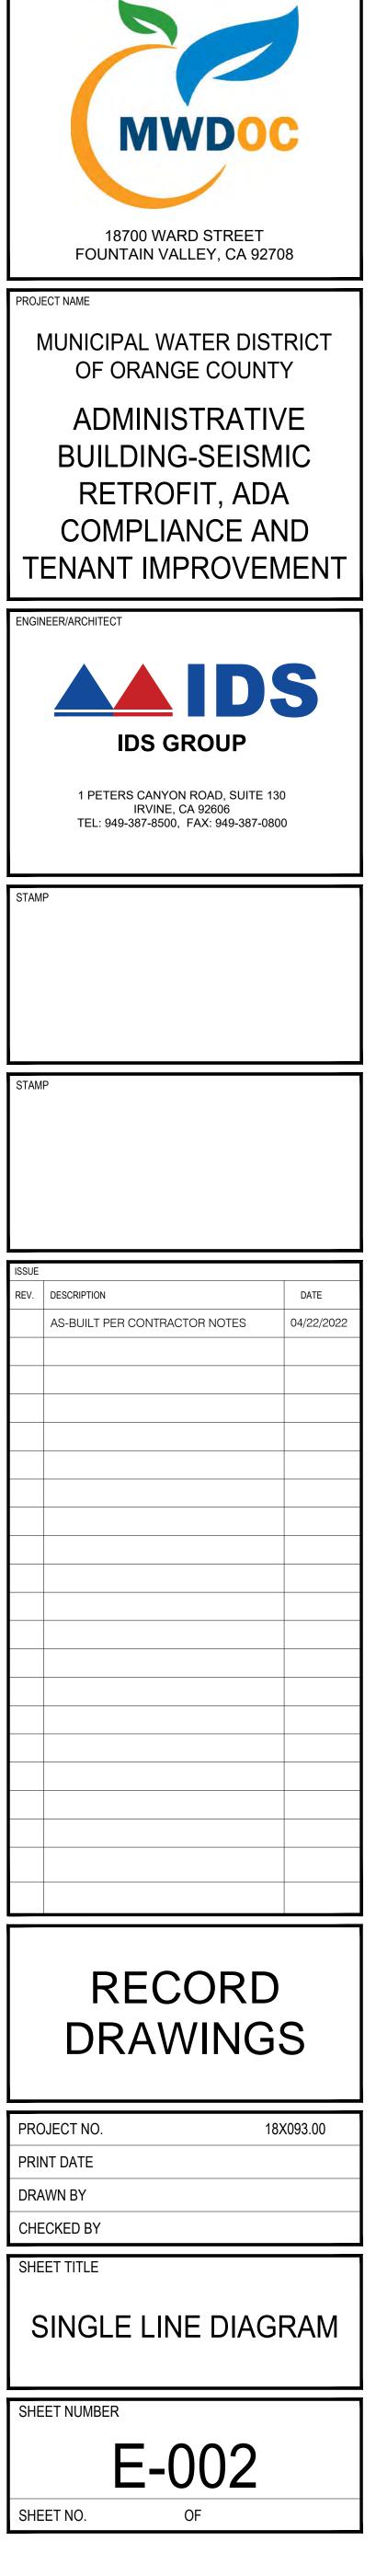


CLIENT

				ł	PA	NELI	30	A	R) '(N) Ll	E'		
MAIN:	208/120VOLT,3-PH,4-V	WIRE & G	ND FE			: TOP				REAKER	,		MOUNTIN	IG: FLUSH
BUS:	1 SEC.: SINGLE LUG	S		Е	NCL.	: NEMA 1				BUS	: 225	AMP	MIN A.I.C. R	ATING: 10K
LOAD VA	LOAD DES	CRIPTION		о01 м		- CB/P	CKT #	PHASE	CKT #	CB / P		LETS R M	LOAD DESCRIPTION	LOAD VA
360	(E) RECEPT WIFI				0	20/1	1	A	2	20/1	0		RECEPT CUBICALS 113	1920
1200	(E)LOAD				0	20/1	3	B	4	20/1	0		RECEPT CUBICALS 113	1920
500	(E)LOAD				0	20/1	5	С	6	20/1	0		RECEPT CUBICALS 113, 103	1920
500	(E)LOAD			-	C	20/1	7	A	8	20/1	0		RECEPT CONF RM 101	720
500	(E)LOAD			-	0	20/1	9	в	10	20/1	0		RECEPT CONF RM 101	720
500	SPARE				0	20/1	11	c	12	20/1	0		RECEPT CONF RM 101	720
500	(E) RECEPT GB UND	ER CAB L	TS.		- o	20/1	13	A	14	20/1	0		RECEPT CONF RM 101	720
500	(E) RECEPT KITCHEN				0	20/1	15	в	16	20/1	0		ADA MOTORIZED DOOR EQUIPT. LOBBY	468
500	(E) RECEPT KITCHEN				0	20/1	17	С	18	20/1	0		ADA MOTORIZED DOOR EQUIPT. LOBBY	468
	SPARE				0	20/1	19	A	20	20/1	0		ADA MOTORIZED DOOR EQUIPT. LOBBY	468
	SPARE				0	20/1	21	в	22	20/1	0		KITCHEN FRIDGE RECEPT	500
	SPARE				0	20/1	23	С	24	20/1	0		SPARE	
	SPARE SPARE				0	20/1	25	Α	26	20/1	0		SPARE	
500	(E) RECEPT OFFICE	136, 137			0	20/1	27	в	28	20/1	0		SPARE	
500	(E) RECEPT OFFICE	105, 135,	136, 137		0	20/1	29	С	30	20/1	0		SPARE	
	SPARE				0	20/1	31	A	32	20/1	0		RECEPT CUBICALS 140	500
	SPARE				0	20/1	33	в	34	20/1	0		RECEPT CUBICALS 140	500
500	(E) RECEPT CONFER	ENCE TV			0	20/1	35	С	36	20/1	0		RECEPT CUBICALS 140	500
500	(E) RECEPT CONFER	ENCE TV			0	20/1	37	Α	38	20/1	0		SPARE	
500	(E) RECEPT OFFICE	127 PRIN	TER		0	20/1	39	В	40	20/1	0		SPARE	
	SPACE				0		41	С	42		0		SPACE	
	PHASE		А		В	С				PANEL	TOTAL	-	PANEL LOCATION: ELEC. ROOM	
PHASE TO	TAL CONNECTED VA:		6188	73	308	6108	1			19.6	KVA		FED BY: PANEL 'L'	
CONTINUO	US LOAD @125%:	(0)	0		0	0				0.0	KVA			
KITCHEN E	QUIP. @ 65%	(0)	0		0	0				0.0	KVA			
LARGEST	MOTOR @125%:	(0)	0		0	0				0.0	KVA			
HVAC @ 100% (0)		(0)	0		0	0	1			0.0	KVA			
GEN. RECEPT. DEMAND (0)			0		0	0	1			0.0	KVA		100.0% (NET GEN. REC. DEMAND FAC	TOR)
REMAINING	EMAINING @100%				308	6108	1			19.6	KVA			
PANEL TO	TAL W/ DEMAND:		6188	7	308	6108				19.6	KVA			
FULL LOAD	AMPS:		52		61	51	1			54.4	AMP	s		

				(E)	PAN	IE	LE	BC	DARD) '	2				
MAIN:	208/120VOLT, 3-PH, 4-V	VIRE & GND	FEE			BOTTOM	_			REAKER:		-	P		MOUNTING:	SURFAC
BUS:	1 SEC.: SINGLE LUG	S		ENC	L.: N	NEMA 1				BUS:	400	A			MIN. AIC F	ATING: 1
100000	and sure	a lin letter	C	UTLE	TS	Set 14	#	Щ	#		OU	TLE	TS	- Salahad	Paren .	a constant of
LOAD VA	LOAD DESC	RIPTION	Ν	/ R	L	CB / P	CKT #	PHASE	CKT #	CB / P	L	R	м	LOAD DESCRI	PTION	LOAD V
1920	(E) RECEPT - CONF	RM 102 & ADM	IN 10			20/1	1	Α	2							2000
1920	(E) RECEPT - CONF	RM 102 & ADM	IN 10			20/1	3	в	4	30/3			1	(E) AC UNIT		2000
1920	(E) RECEPT - CONF	RM 102				20/1	5	С	6							2000
900	(E) RECEPT - OUTSI	DE				20/1	7	Α	8	20/1				(E) RECEPT - ROOF		180
900	(E)RECEPT					20/1	9	в	10							2000
1080	(E) RECEPT - OFFICI	E 126. 128. 129				20/1	11	С	12	30/3			1	(E)FAU		2000
540	(E) RECEPT - 122. 12	.4				20/1	13	-	14							2000
600	(E) PATIO LIGHTS					20/1	15		16	20/1	_			SPARE		
180	(E) WATER HEATER					20/1	17	С	18	20/1			-	(E) RECEPT KITCHEN	1	1920
540	(E) RECEPT COPY R	A. A				20/1	19	0.0	20	20/1			_	SPARE		
1920	(E) RECEPT COPY R					20/1	21	-	22	20/1	-		-	(E) RECEPT 123 RM EC	2	900
1920	(E) RECEPT - OFFICI	E 114, 115	-			20/1	-	С	24	20/1	_		_	(E) RECEPT WIFI		1920
	SPARE					20/1	25	-	26	20/1		-	_	SPARE		
900	(E) RECEPT OFFICE				_	20/1	27	-	28	20/1		_	_	(E) RECEPT KITCHEN		504
1920	(E) RECEPT OFFICE					20/1	29	-	30	20/1			-	SPARE		1
1920	(E) RECEPT HALLWA		_		-	20/1	31	-	32	20/1	_		_	(E) RECEPT KITCHEN		1080
360	RECEPT - CONF RM 1	1512	_			20/1	33		34	20/1				(E) RECEPT VANITY LTS		504
720	(E) RECEPT - OFFICI	E 106, 107, 108				20/1	35		36	20/1			_	RECEPT DRINKING FOUN		504
360	(E) RECEPT IT RM					20/1	37		38	20/1			-	RECEPT OFFICE 137, 13	9, 140	504
360	(E) RECEPT IT RM (E) LOAD OFFICE 124, 125					20/1		в	40	20/1			_	(E) RECEPT RR		900
1920						20/1		С	42	20/1			_	(E) RECEPT IT RM		1920
	RECEPT - OPEN OFFI	The second second				20/1	-	Α	44	20/1		_		(E) RECEPT 121, 123,, 12		540
540	RECEPT - OPEN OFFI		_			20/1		в	46	20/1			-	(E) RECEPT 118, 119, 120		540
540	RECEPT - OPEN OFFI	a service and the service of the ser				20/1	47	С	48	20/1			_	(E) RECEPT 118, 119, 120		540
360	RECEPT - OPEN OFFI	CE RM 127				20/1	49		50	20/1			_	(E) RECEPT 126, HALLW	AY	540
	SPARE					20/1	51	1.1	52	20/1			_	RECEPT COPY RM		1100
	SPARE					20/1	53	-	54	20/1			-	RECEPT COPY RM		360
	SPARE					20/1	55	1.11	56	20/1			-	SPARE		
	SPARE					20/1	57	-	58	20/1			-	SPARE		
	SPARE					20/1	59	-	60	20/1			-	(E) RECEPT HVAC CC	All store and the second second	360
720	(E) RECEPT COPY RM		_		_	20/1	61	1. 1. 1. 1.	62	20/1				(E) RECEPT HVAC CC	ONTROLS	360
720	(E) RECEPT COPY RM		_			20/1	63	-	64	20/1			_	SPARE		
1920	(E) RECEPT COPY RM	1	_		_	20/1	65		66	20/1		-	_	SPARE		
	SPARE		_			20/1	67		68	20/1			_	(E) LIGHTS - CHILLER P	IT	600
	SPARE		_			20/1	69	-	70	20/1			-	SPARE		
	SPARE					20/1	71	С	72	20/1			-	SPARE		
								A				_	_		-	6188
			_					В		(E)150/3			_	(N)PANEL 'L	-E'	7308
			-	-	-		-	С							(International parts)	6108
	PHASE	A		В	-	С				PANEL T				PANEL LOCATION		
	TAL CONNECTED VA:	1578		1666	_	23644	_		_		KVA		-		MSB-MWDOC	
CONTINUO	US LOAD @125%:	(5040) 315	0	750		2400				6.3	KVA	λ.		CONTRACTOR SHALL UF	DATE DIRECTO	RY BASE
KITCHEN E	TCHEN EQUIP. @ 65% (0) 0			0		0				0.0	KVA	4	1	FIELD VERIFICATION OF	ALL EXISTING C	ONDITIO
ARGEST	RGEST MOTOR @125%: (0) 0			0		0				0.0	KVA	\	1	LOADS RELOCATED FRO	DM (E) PANELS	LE, LES
HVAC @ 10	/AC @ 100% (0) 0			0		0				0.0	KVA	1				
GEN. RECE	PT. DEMAND	(0) 0		0		0				0.0	KVA	VA 100.0% (NET GEN. REC. DEMAND FACTOR)			TOR)	
PANEL TOT	TAL W/ DEMAND:	1893	34	1741	В	26044				62.4	KVA	A.				
A CONTRACTOR OF A CONTRACTOR	LOAD AMPS: 15					217				173.2	AM	20				

ORDERING GUIDE

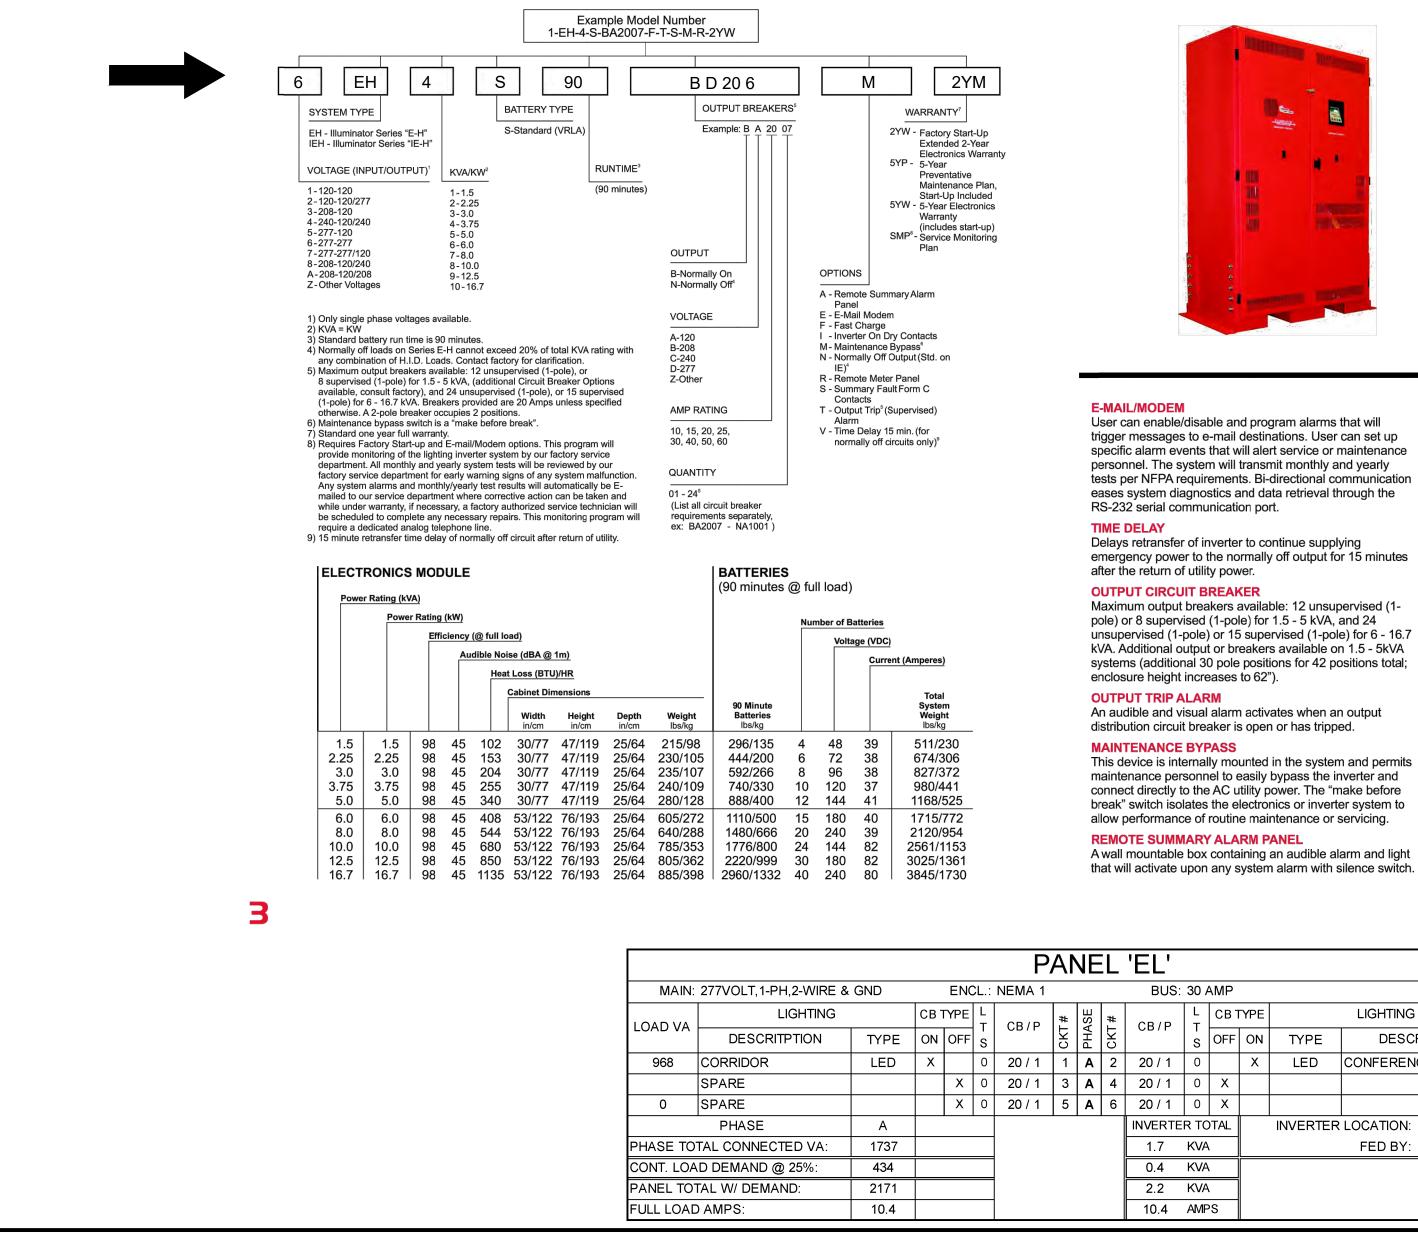

TING	SURFACE		· · · · · · · · · · · · · · · · · · ·	=	··- ==	= =							= <u>-</u>
	ATING: 10K		· · · ·			• •		·		·		-	· ·
	LOAD VA	· _ · · _	- <u>-</u>	· · . ·			-				· · · · ·		·
	2000	2000						- -	 				1.1.1. 1.1.1.
	2000	1						. ·					· .
	2000			···· ·									
	180							· ·					-
	2000												•••
	2000		· · ·										:
	2000							•					
											· · ·		
-	1920												
	10000							•			· · · · · · · · · · · · · · · · · · ·		
	900		· · · · · · · · · · · · · · · · · · ·				·						
_	1920							. •					
_								· · · · · ·			· · · · · ·		
_	504							· . ·					
	1000							· · ·					
_	1080										· · ·		
_	504 504												
-	504						· · ·			•	· · · ·		
	900			. :				n Angelon († 1947) Angelon († 1947)					
-	1920			:									
_	540												
_	540					<u>.</u>							
	540												
-	540			· .	-		· .			N			
	1100		· · · ·										
	360		· · · · · · · ·	· .	21.		2.5						
- 1	-										· · · · · · · ·		
_	360		··· · ···										
	360	.: •	. .		• • • •	- ¹	20 - 10 - 10 - 10		• •				
		:			2.5	11.2			· .				
		· _	- ·										
	600									·			
	6188												
	7308												
	6108												
MOOM	and all shares in the second												
NDOC	VIA TLE												
ECTOR	RY BASED												
ING C	ONDITIONS												

ILLUMINATOR E/IE-H SINGLE PHASE



(See chart on page 3 for dimensional details)

OPTIONS AVAILABLE

SUMMARY FORM C CONTACT Form "C" contacts rated at 5 amps maximum at 250VAC/30VDC. Dry contact will change state when any system alarm activates. Contacts change state with the following alarms: High/low battery charger fault, near low battery, low battery, load reduction fault, output overload, high/low AC input volts, high ambient temperature, inverter fault, test failure, and optional circuit breaker trip alarm. **INVERTER ON FORM C CONTACT**

Form "C" dry contact that will change state when the inverter transfers to battery operation. STATUS MONITORING CONTACTS

Multiple Form "C" dry contacts capable of monitoring system and option statuses (Inverter On, Inverter Off, AC Present, High Temperature, Summary Alarm, System Bypass*, and OTA*) *Requires purchase of Maintenance Bypass and/or Output Trip Alarm options. FAST CHARGE


This is a battery charger upgrade which decreases the time to recharge a fully discharged battery bank to a full charge. The recharge time is decreased from the standard 24-hour period to a 12-hour period.


NORMALLY OFF OUTPUT (Standard on Series IE) This output circuit is dedicated for emergency only lighting fixtures. Emergency only loads operate during power outages and when the system is on battery back up. This option leaves selective load circuits off during normal utility power conditions.

Power Products, Inc. 2


	PANEL 'EL'														
	ENC	CL.:	NEMA 1				BUS:	30 /	AMP			MIN A.I.C. RATING: 10K			
CB TYPE L		CB/P	#	SE	#	CB/P	L	СВТ	YPE		LIGHTING	LOAD VA			
ON	OFF			CKT	PHASE	CKT		S	OFF	ON	TYPE	DESCRIPTION	LOAD VA		
Х		0	20 / 1	1	Α	2	20 / 1	0		Х	LED	CONFERENCE ROOM	769		
	Х	0	20 / 1	3	Α	4	20 / 1	20/1 0 X					0		
	Х	0	20 / 1	5	Α	6	20 / 1	20/1 0 X					0		
				•	•		INVERTE	R TC	TAL		INVERTER	LOCATION: ELEC ROOM			
							1.7	KVA	١			FED BY: PANEL HC			
							0.4	KVA	۱						
							2.2	KVA	\						
							10.4	AMF	۶						


N/A

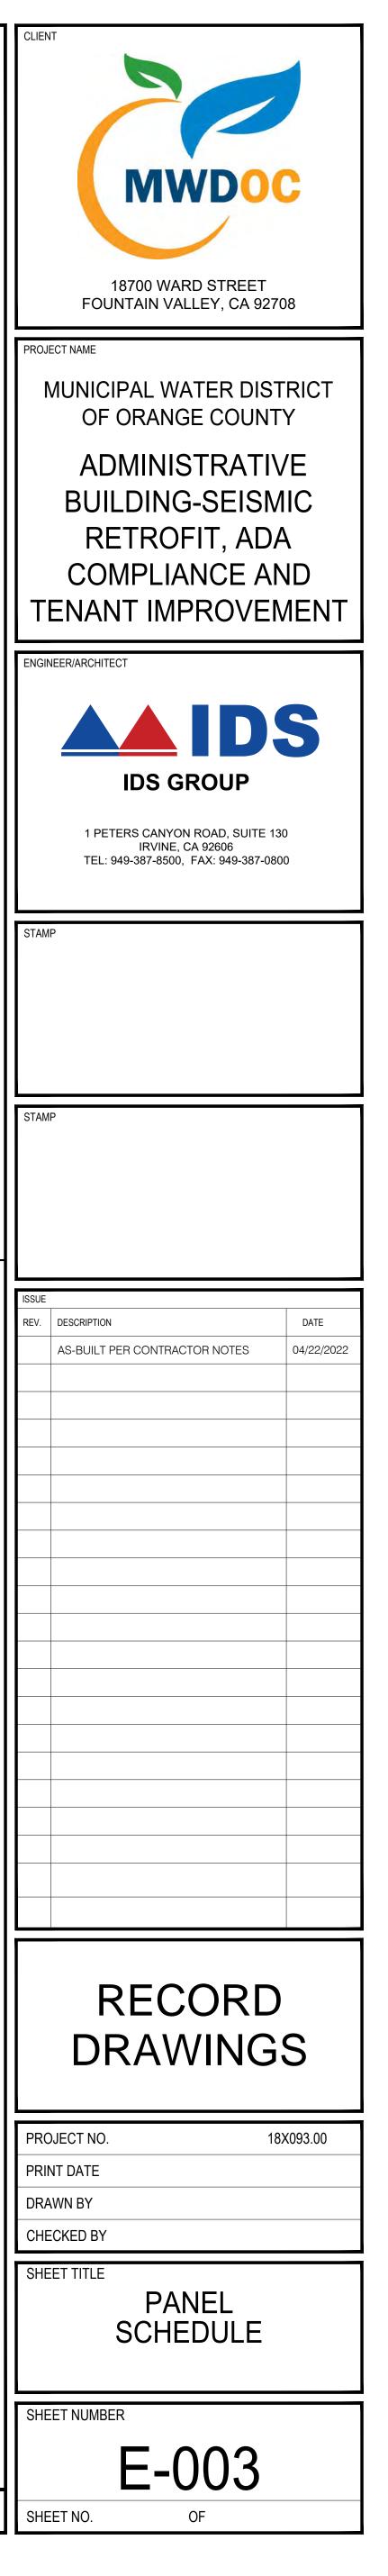


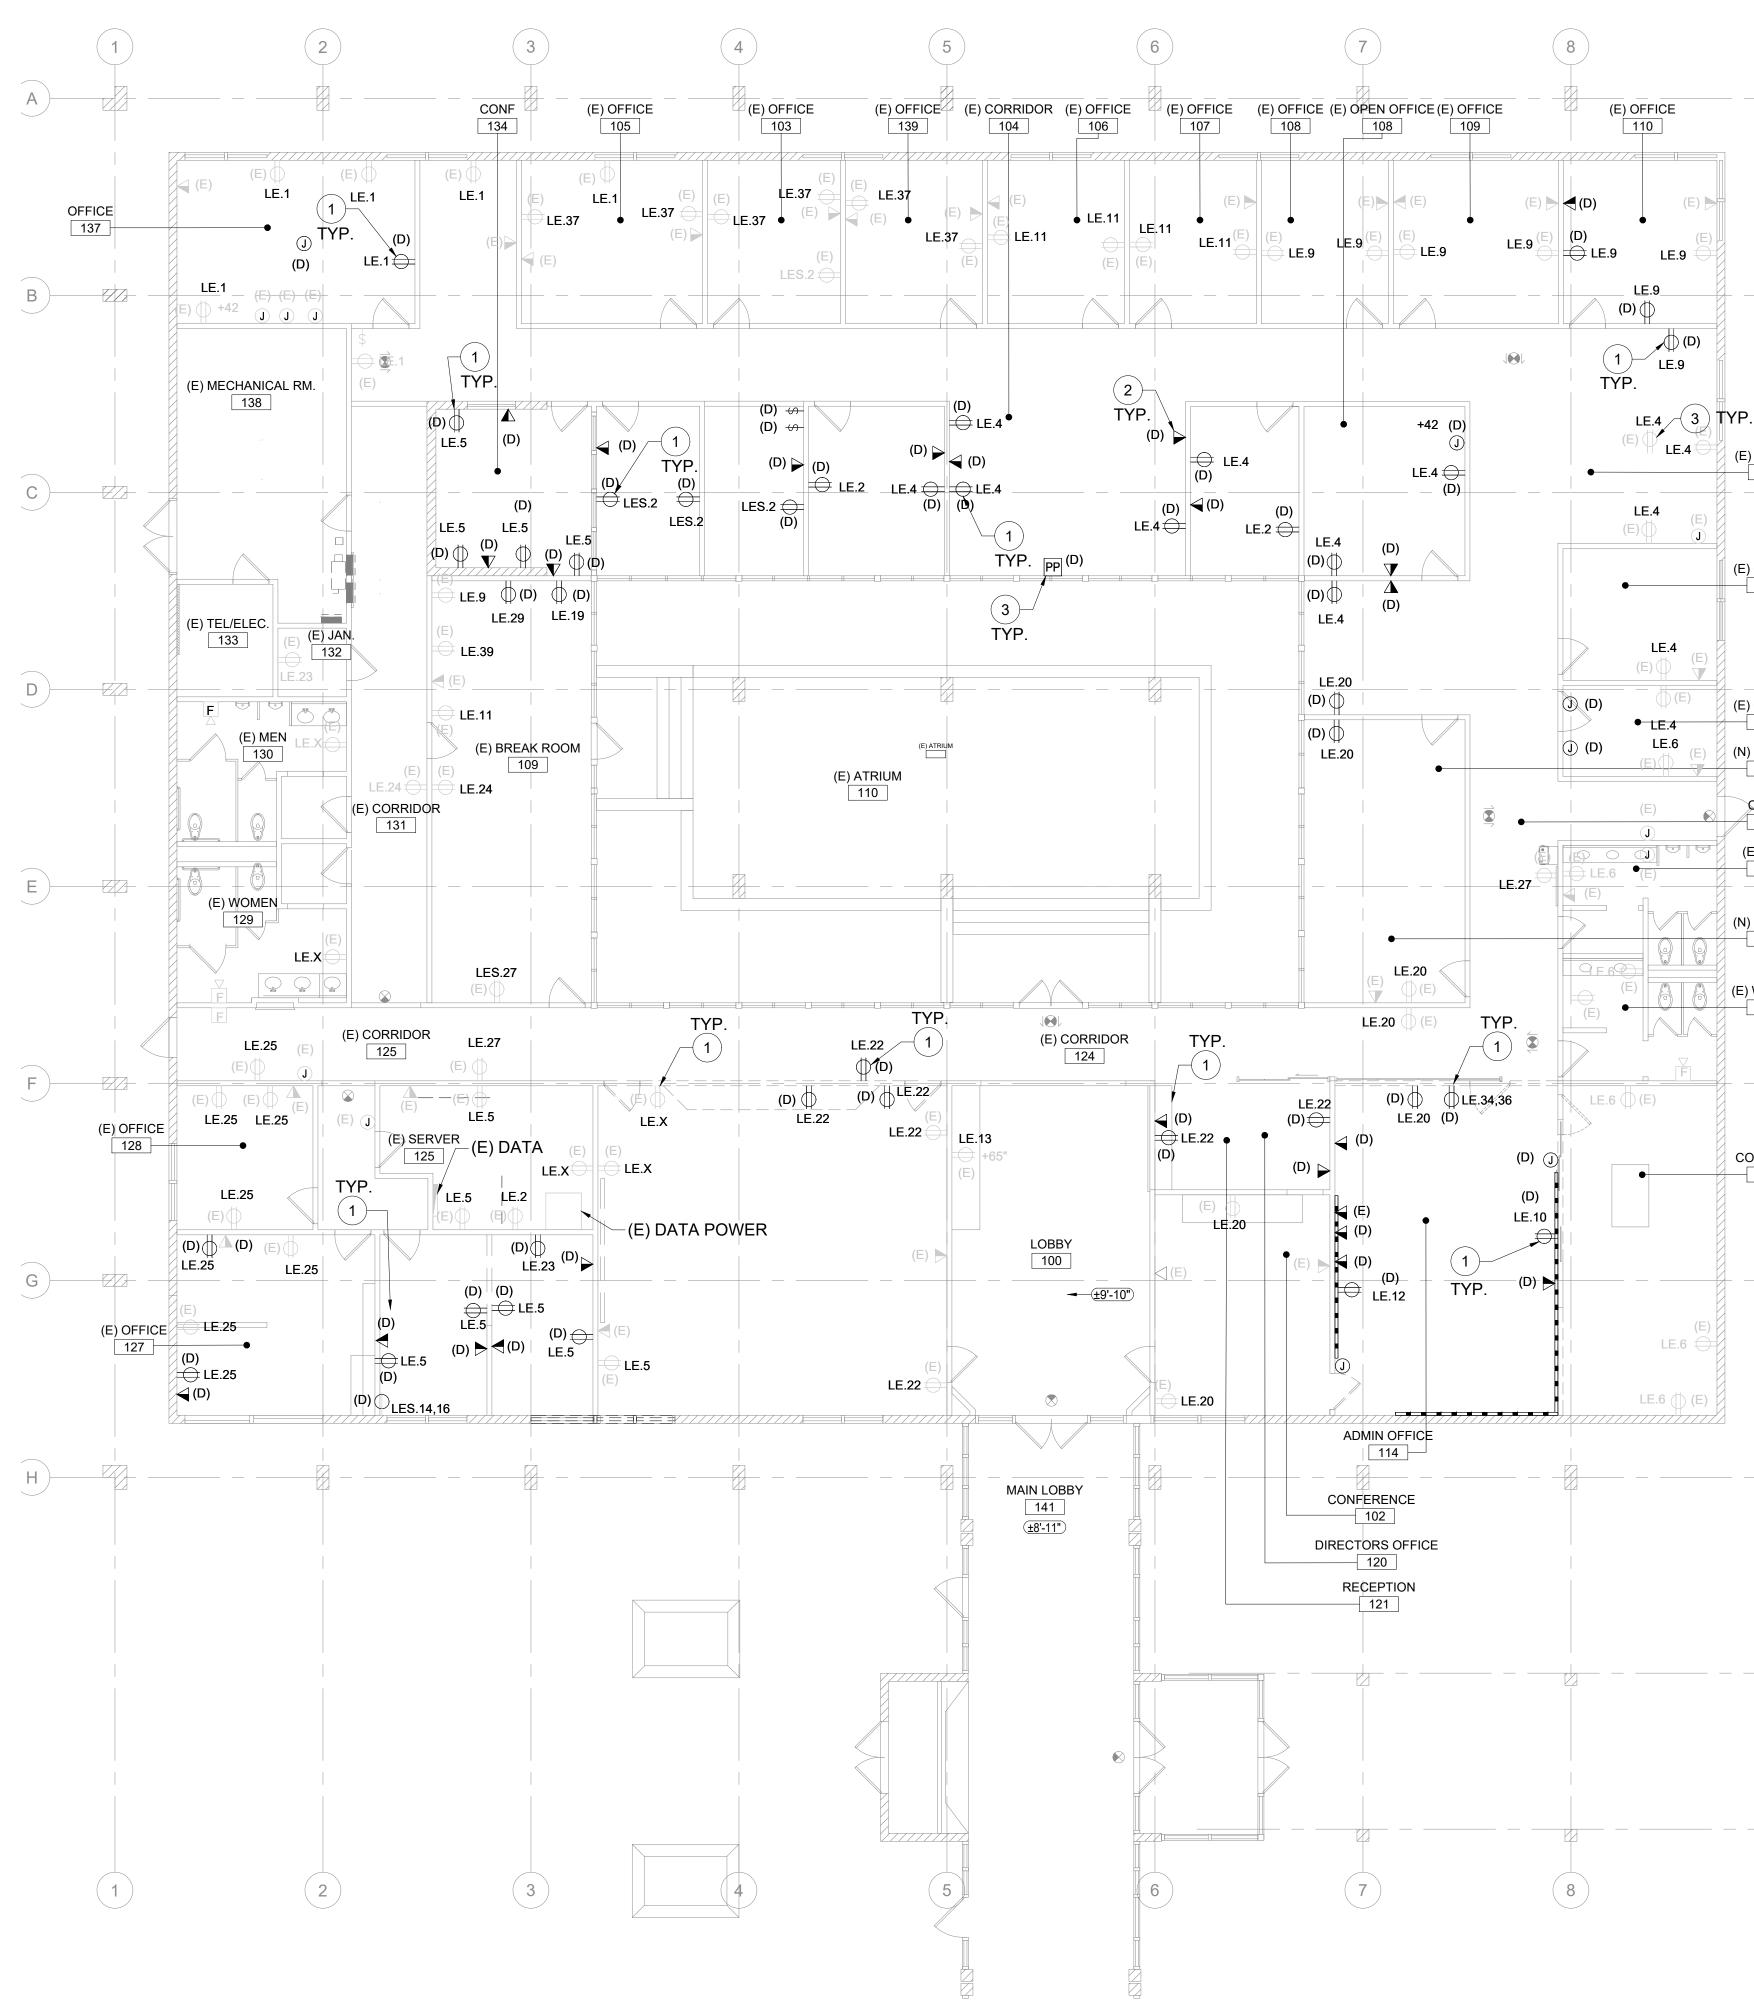


		GENERAL DEMOLITION NOTES
		 REFER TO ARCH'L REFLECTED CEILING PLAN FOR EXACT LOCATION OF LIGHTING FIXTURES. VERIFY EXACT CEILING CONSTRUCTION W/ ARCH'L REFLECTED CEILING PLAN AND PROVIDE LIGHTING FIXTURES W/ NECESSARY MOUNTING HARDWARE. COORDINATE EXACT LIGHTING FIXTURE LOCATIONS W/ MECHANICAL EQUIPMENT AND DUCT WORK PRIOR TO ROUGH-IN. DIMMING BRANCH CIRCUITS SHALL BE PROVIDED W/ A DEDICATED NEUTRAL CONDUCTOR FOR EACH ZONE/CHANNEL. PROGRAM ALL LIGHTING CONTROLS TO MEET THE LATEST REQUIREMENTS OF THE LIGHTING TITLE 24. LIGHTING FIXTURES AND CONTROLS ARE NEW UNLESS OTHERWISE NOTED.
9	A	 RECEPTACLES ON COMMON WALLS SHALL BE SEPARATE BOXES AND OFFSET 12" MINIMUM. FIRE RATED WALLS SHALL HAVE AN OFFSET OF 24" MINIMUM. COORDINATE W/ ARCH'L FIRE RATED WALL DETAILS. HEIGHT OF RECEPTACLES AT COUNTER SHELVES, ETC., SHALL BE VERIFIED W/ OWNER PRIOR TO ROUGH-IN. PROVIDE G.F.C.I. TYPE RECEPTACLE WITHIN 6 FEET OF ANY SINK. EACH AND EVERY 15 AND 20 AMP, 120 VOLT RECEPTACLE IN KITCHEN, FOOD PREPARATION, BAR AREAS AND RESTROOMS SHALL BE GFCI TYPE PROTECTION. COORDINATE EXACT LOCATION OF MECHANICAL EQUIPMENT AND POWER CONNECTION LOCATION WITH MECHANICAL CONTRACTOR PRIOR TO INSTALLATION. SEE MECHANICAL EQUIPMENT SCHEDULE FOR CIRCUIT DESIGNATION, CONDUIT AND WIRE SIZES.
	B	 11. THE EXISTING FIRE ALARM AND ENERGY MANAGEMENT SYSTEM AND OPERATIONAL REQUIREMENTS SHALL REMAIN AS IS. CONTRACTOR SHALL TAKE CAUTION PRIOR TO DISCONNECTING ANY DEVICES, EQUIPMENT, PRESERVE WIRING AND CIRCUITRY. RE-INSTALL ANY DEVICES, AS PART OF THE CONSTRUCTION COORDINATION, TO MATCH EXISTING CONDITIONS.
) OFFICE 111 - 22 () OFFICE 112	C	
) OFFICE 113) OFFICE 115	D	GENERAL NOTES 1. EXISTING EQUIPMENT WERE TAKEN FROM EXISTING CONDITION OF THE BUILDING. THE ELECTRICAL CONTRACTOR TO FIELD VERIFY EXACT LOCATIONS AND EXISTING CIRCUIT NUMBERS; ADJUST AND UPDATE THE PANELBOARD DIRECTORIES.
COOR 123 E) MEN 117 OFFICE 116 WOMEN 118	E	 COORDINATE THE EXTENT OF WORK WITH ARCHITECT AND OWNER. REMOVE CONTROL DEVICES INDICATED ON PLANS UNLESS OTHERWISE NOTED. EQUIPMENT TO BE REMOVED SHALL INCLUDE ASSOCIATED CONDUIT, WIRING AND APPURTENANCES BACK TO THE PANEL BOARD OR EXISTING DEVICE OR FIXTURE TO REMAIN. COORDINATE WITH OWNER FOR SHUTDOWN OF PANELS / LOADS AFFECTED BY THE PROJECT.
(0PY RM.	F	
119 	G	 KEY NOTES PRESERVE EXISTING CIRCUIT IN CEILING SPACE FOR TENANT IMPROVEMENT CIRCUITRY. DISCONNECT & REMOVE EXISTING DATA CABLING BACK TO SERVER ROOM, REMOVE BACK BOX OF ASSOCIATED DATA JACK DEVICE. DISCONNECT & REMOVE EXISTING POWER POLE COMPLETE. PRESERVE EXISTING CIRCUIT.
	H	
	J	
9	K	
	N w	
		5 = 1'-0" 1

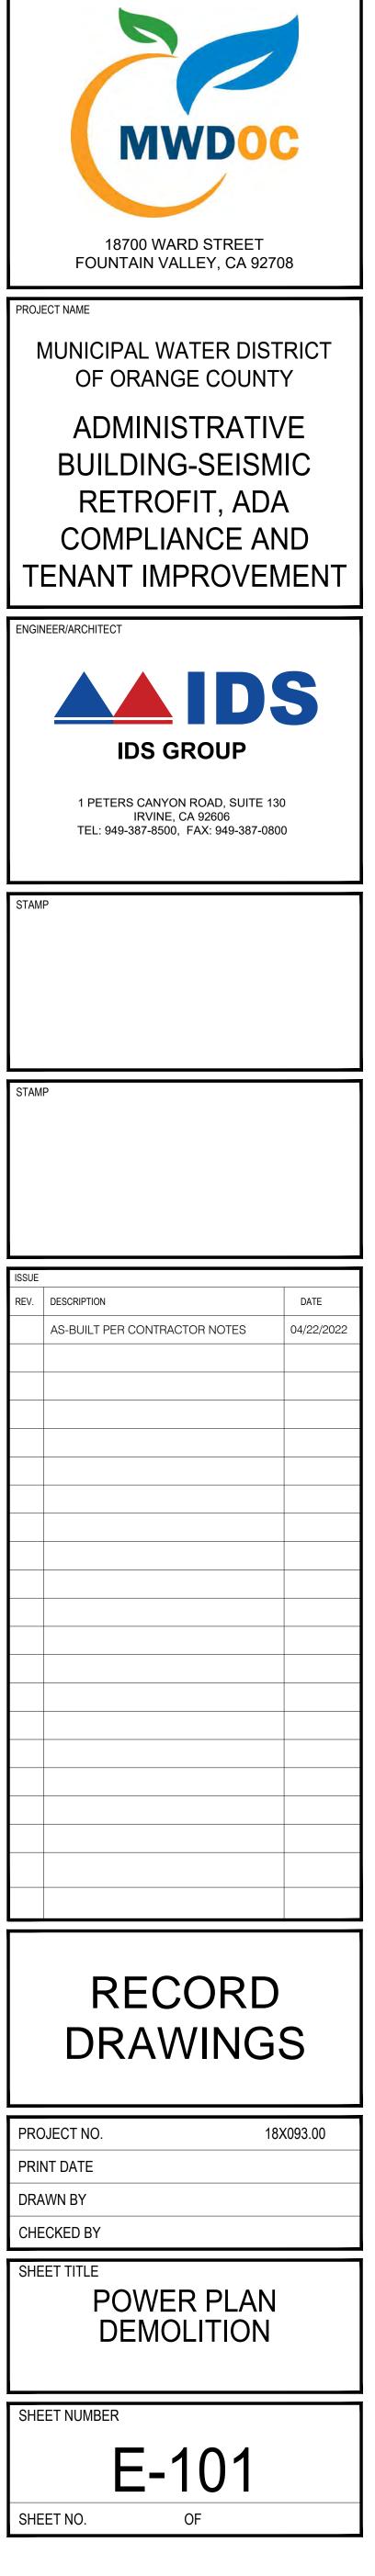

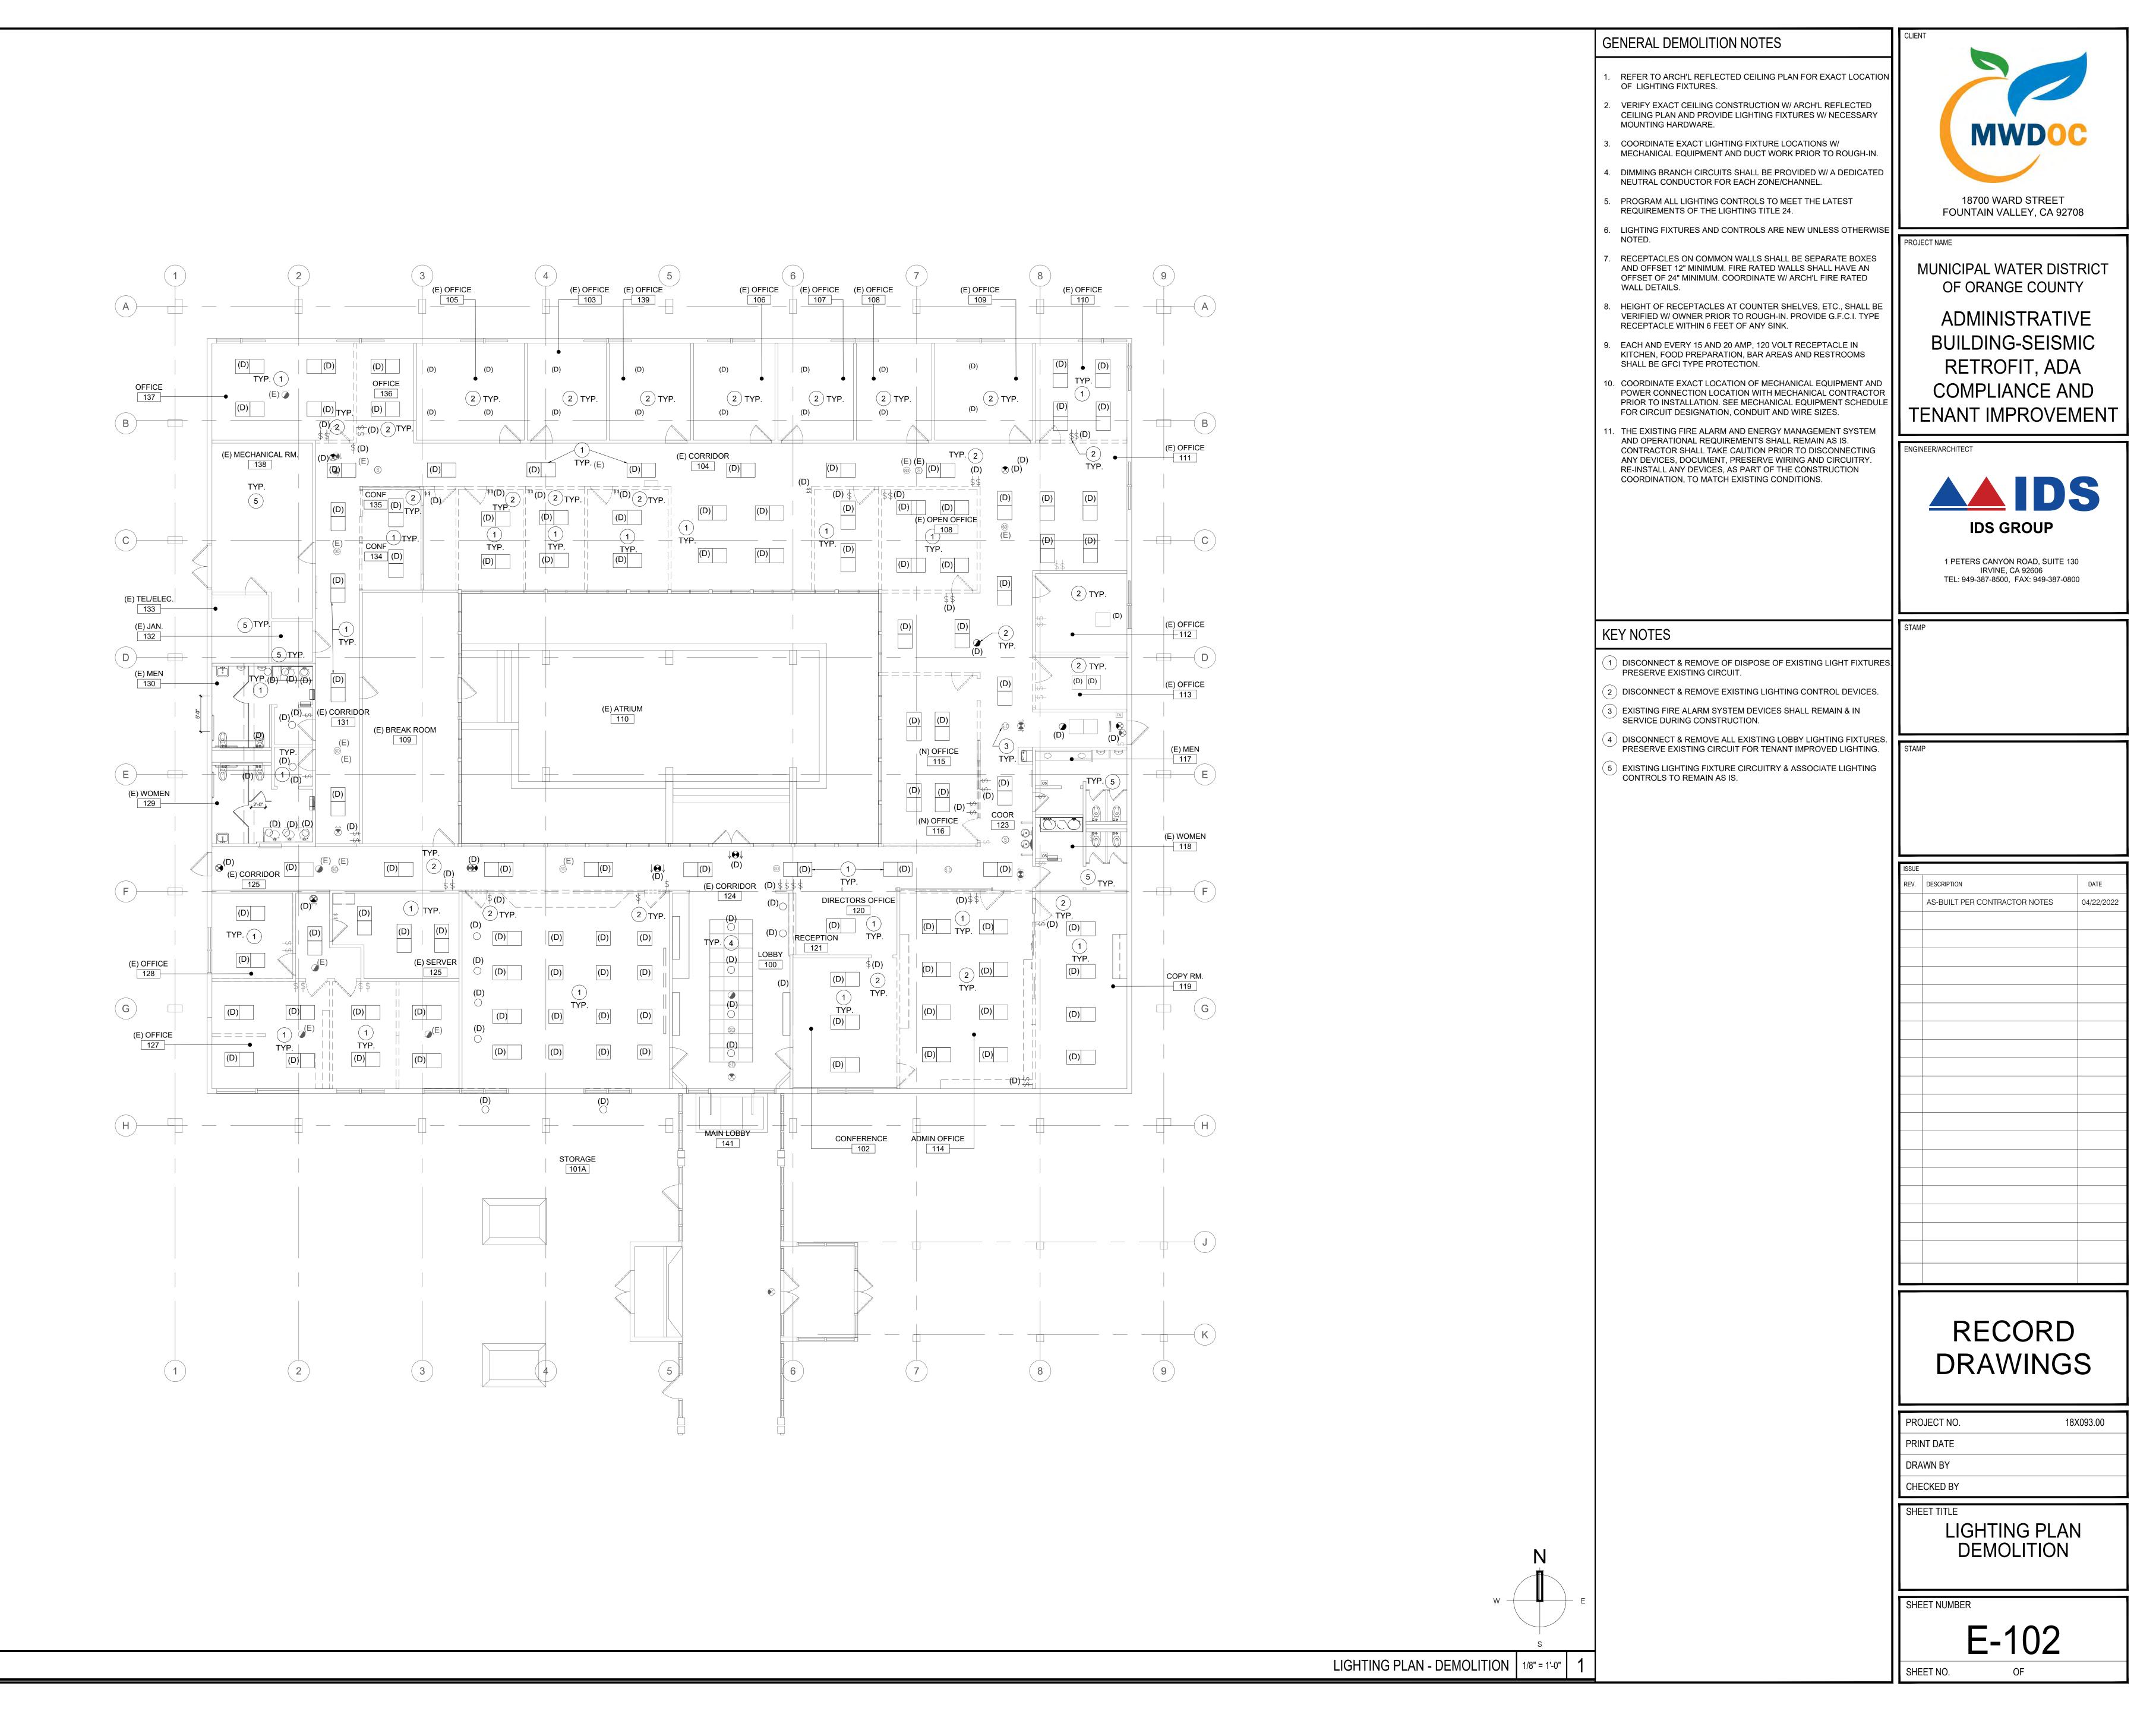

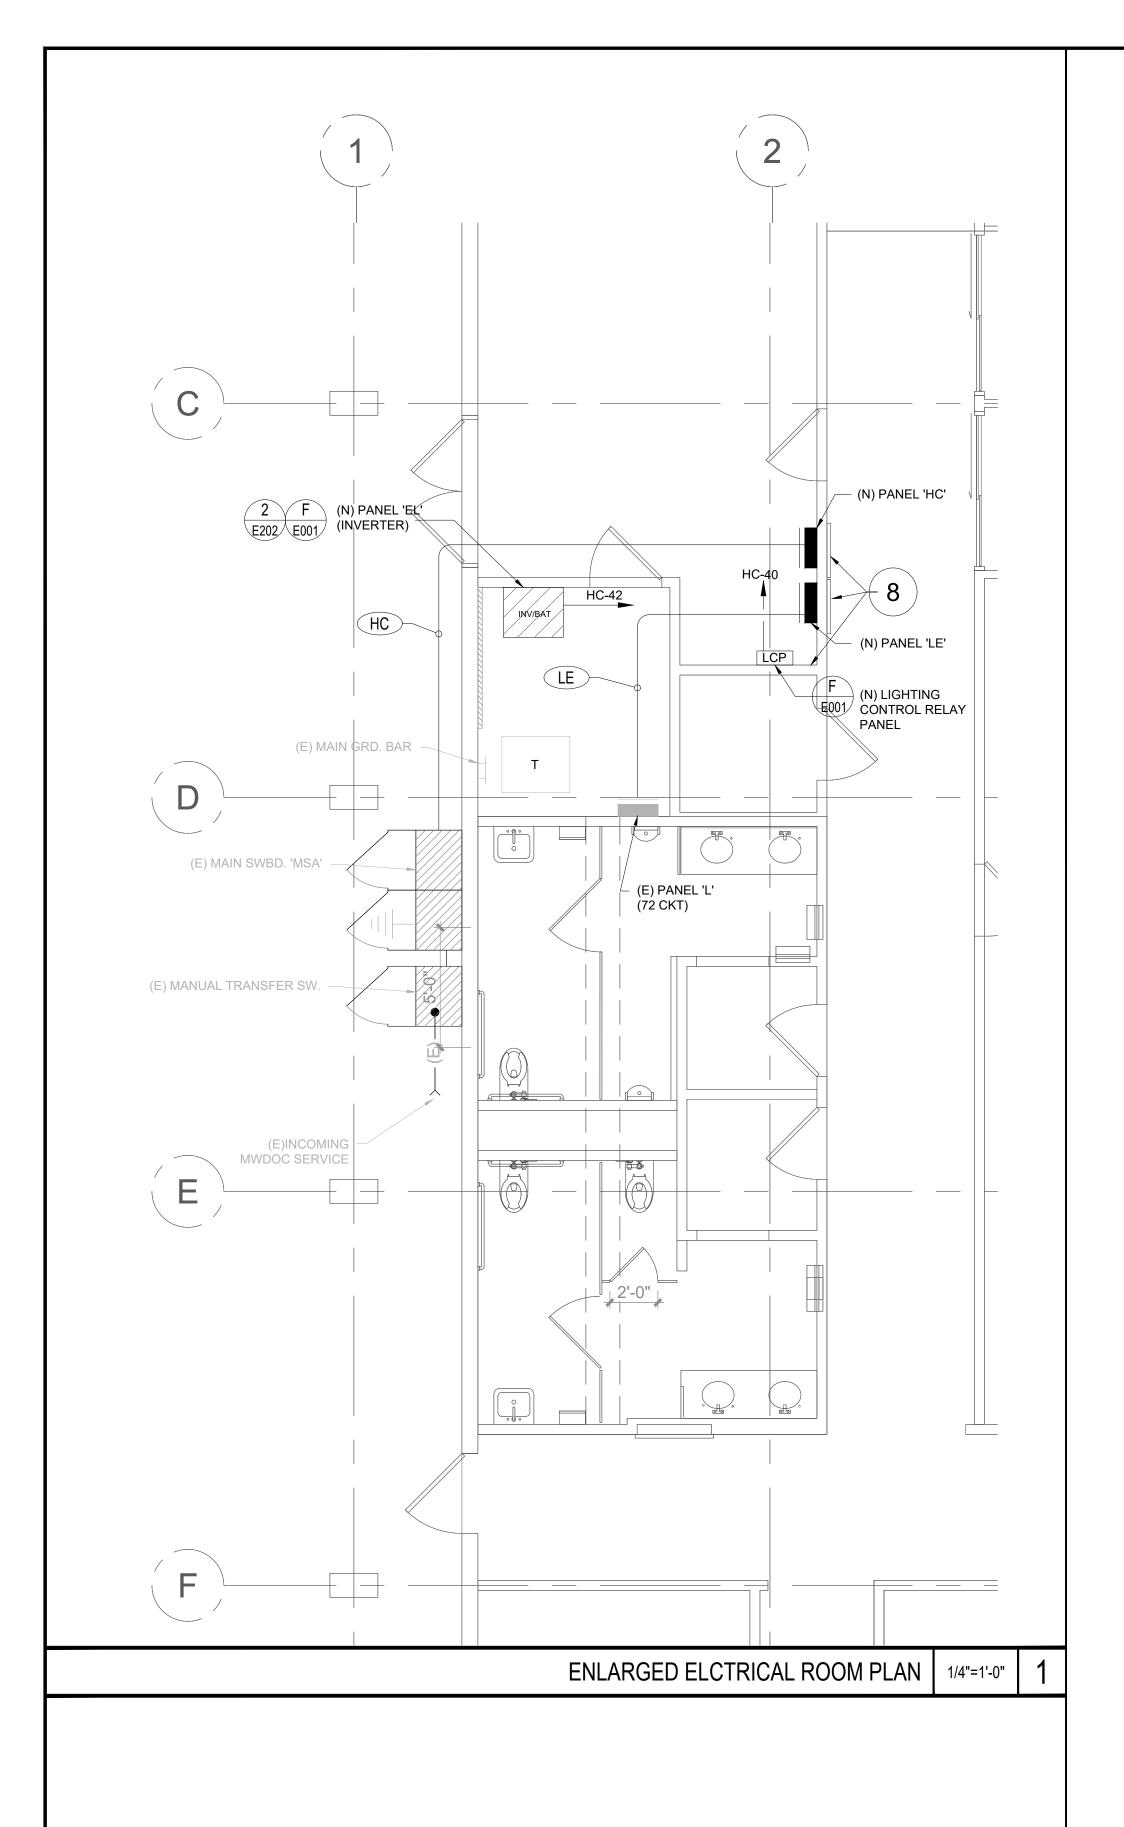

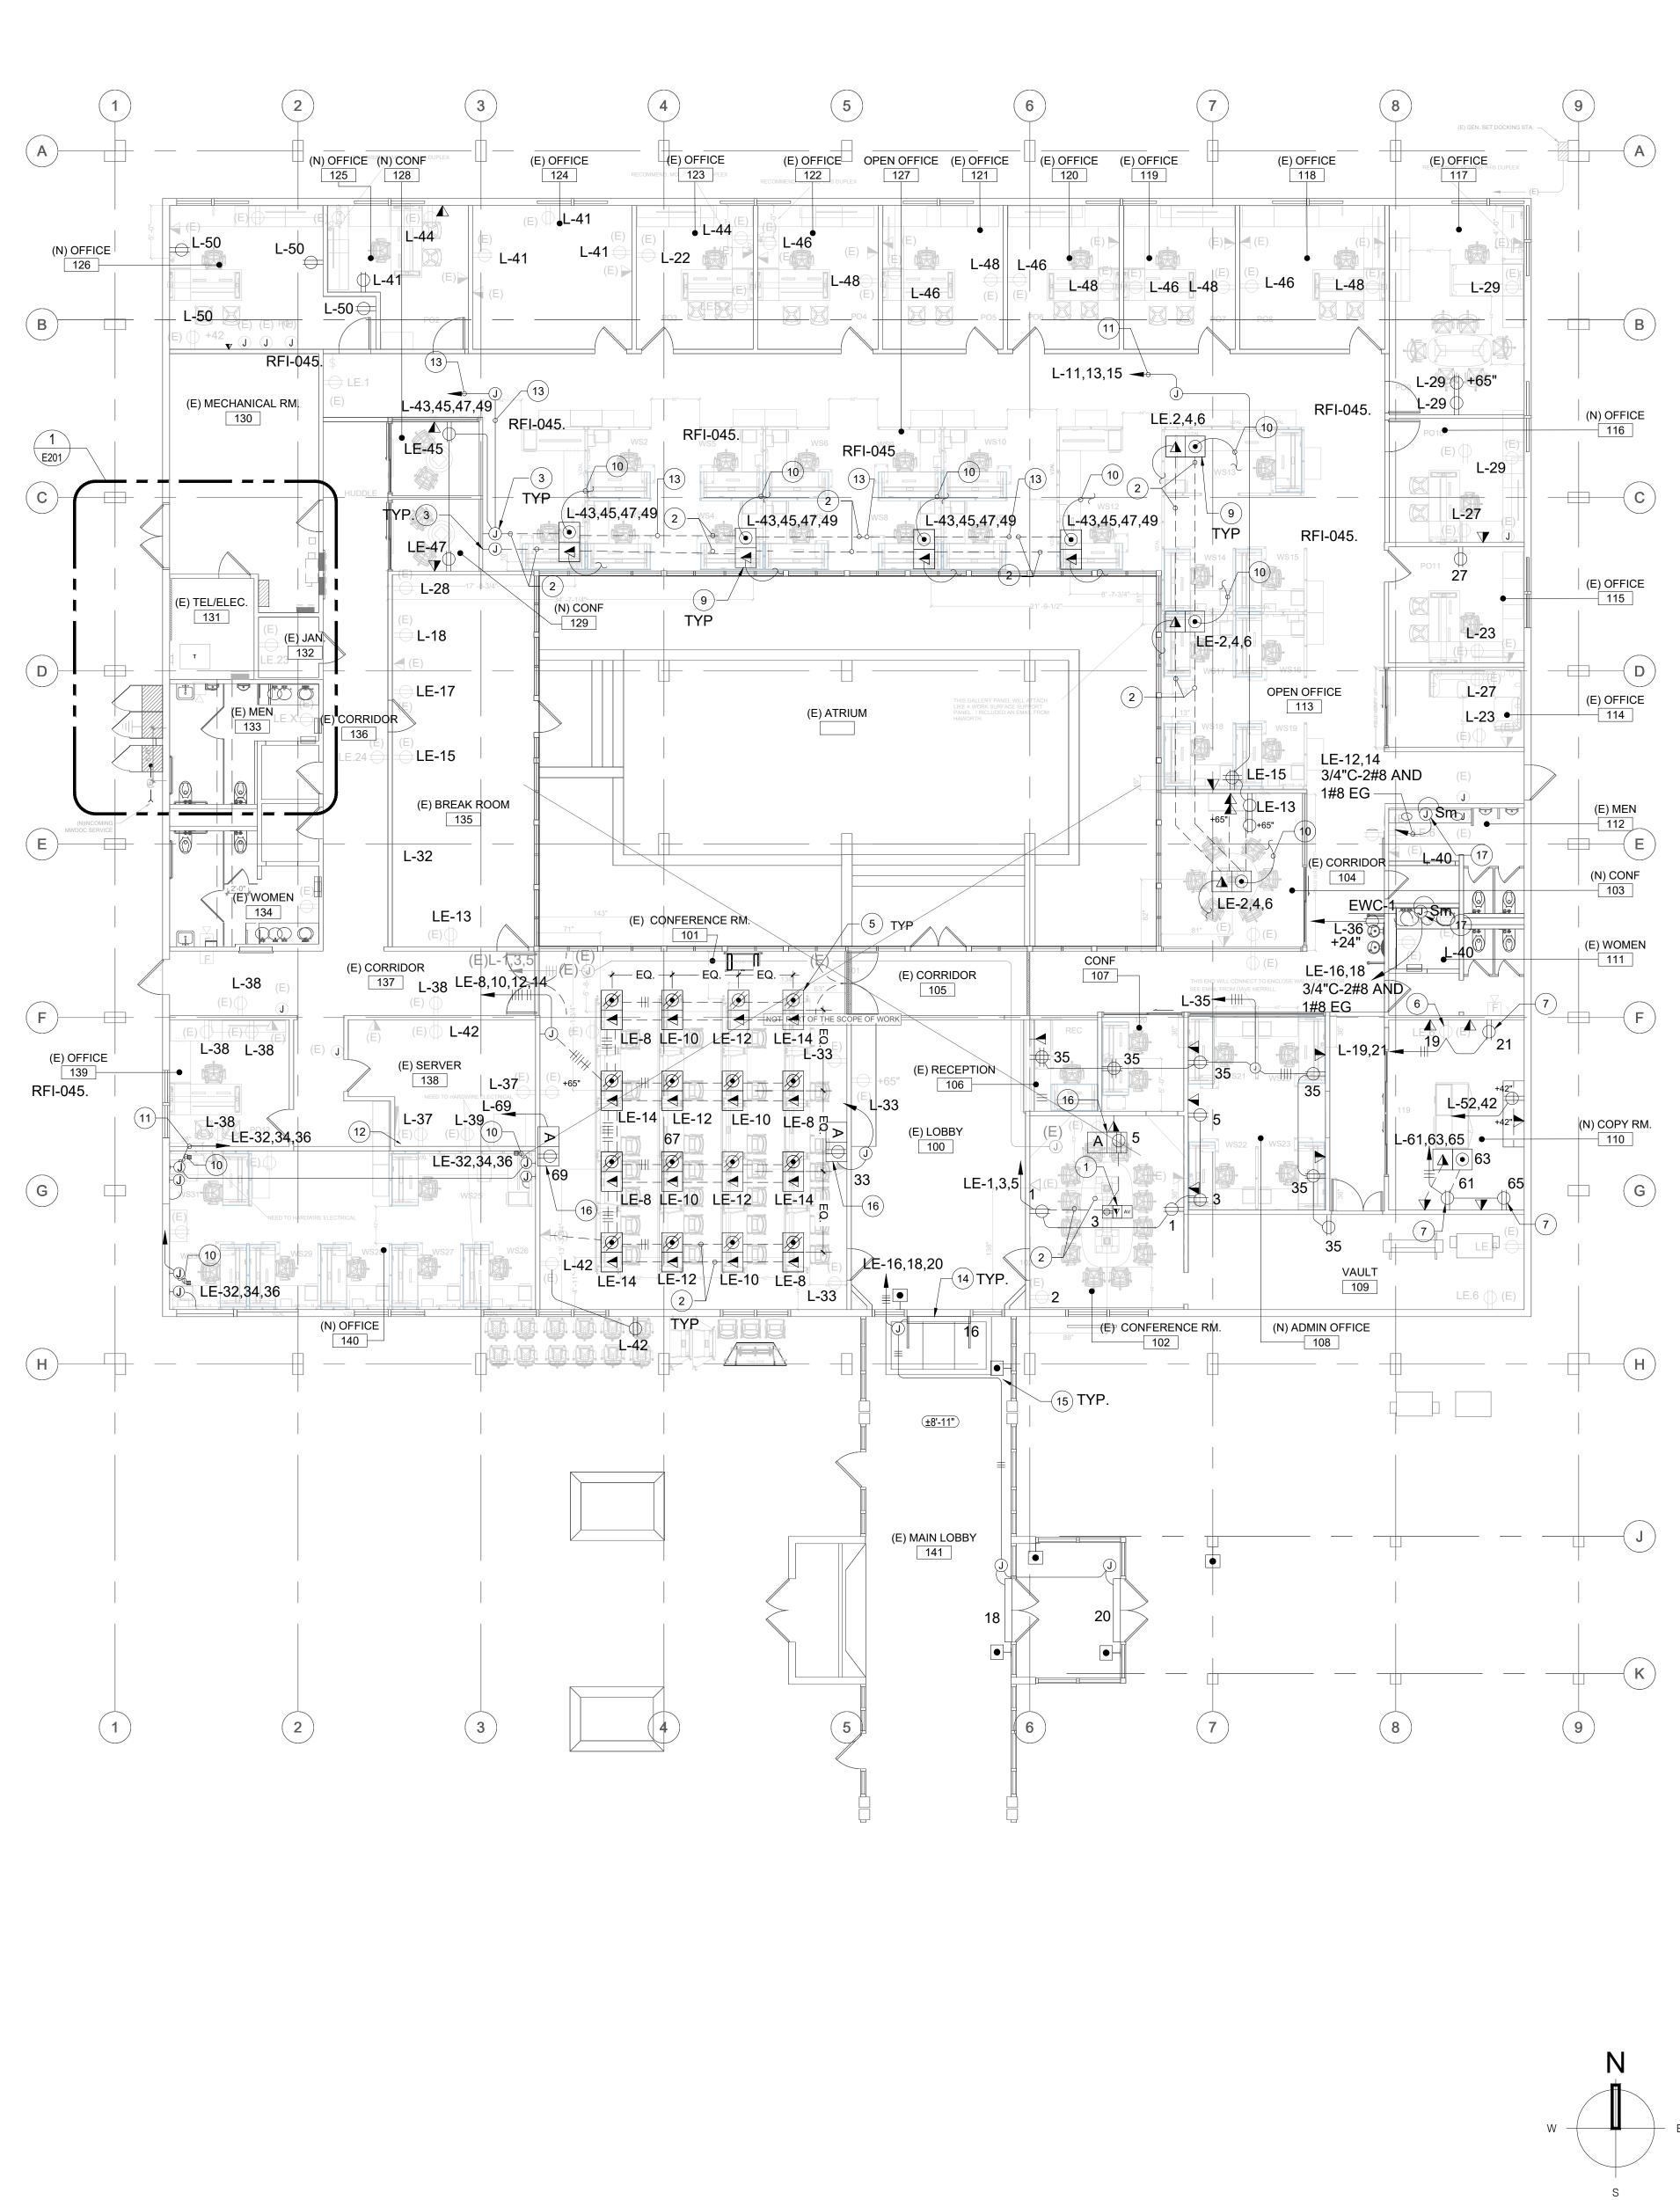


GENERAL NOTES

- RECEPTACLS ON COMMON WALLS SHALL BE SEPARATE BOXES AND OFFSET 12" MINIMUM. FIRE RATED WALLS SHALL HAVE AN OFFSET OF 24" MINIMUM. COORDINATE W/ ARCH'L FIRE RATED WALL DETAILS.
- HEIGHT OF RECEPTACLS AT COUNTER SHELVES, ETC., SHALL BE VERIFIED W/ OWNER PRIOR TO ROUGH-IN. PROVIDE G.F.C.I. TYPE RECEPTACL WITHIN 6 FEET OF ANY SINK.
- EACH AND EVERY 15 AND 20 AMP, 120 VOLT RECEPTACL IN RESTROOMS SHALL BE GFCI TYPE PROTECTION.
- COORDINATE EXACT LOCATION OF MECHANICAL EQUIPMENT AND POWER CONNECTION LOCATION WITH MECHANICAL CONTRACTOR PRIOR TO INSTALLATION. SEE MECHANICAL EQUIPMENT SCHEDUL FOR CIRCUIT DESIGNATION, CONDUIT AND WIRE SIZES.
- THE EXISTING FIRE ALARM AND ENERGY MANAGEMENT SYSTEM AND OPERATIONAL REQUIREMENTS SHALL REMAIN AS IS. CONTRACTOR SHALL TAKE CAUTION PRIOR TO DISCONNECTING ANY DEVICES, DOCUMENT, PRESERVE WIRING AND CIRCUITRY. RE-INSTALL ANY DEVICES, AS PART OF THE CONSTRUCTION COORDINATION, TO MATCH EXISTING CONDITIONS.
- PRIOR TO SAW CUTTING CONCRETE FLOOR, CONTRACTOR SHALL PROVIDE AN ULTRASONIC DETECTION OF THE AREA AND CONFIRM THAT THE SLAB IS SUITABL FOR RENOVATION WORK.

KEY NOTES

- PROVIDE 3 GANG CAST FLOOR BOX WITH FLIP LIP COVERS. ALUMINUM FINISH. PROVIDE 125V, 15A, L5-15R TYPE RECEPTACL IN ONE GANG, DATA JACK IN SECOND & THE THIRD GANG WILL BE AVAILABL FOR AUDIO VISUAL PROVISIONS. COORDINATE WITH MWDOC FOR DATA JACK & AV REQUIREMENTS.
- SAW CUT EXISTING CONCRETE FLOOR, COORDINATE FLOOR & INSTALL (1) 3/4" PVC POWER CONDUIT & (1) 1 1/4" PVC DATA CONDUIT REPAIR FLOOR TO MATCH EXISTING CONDUITS.
- INTERCEPT EXISTING POWER AND EXTEND TO UNDER FLOOR POWER BOX.
- PROVIDE A FLUSH 12"X12"X4" HINGE COVER NEMA 1 PULL BOX EXTEND 1 1/4"C (EMT) ABOVE CEILING W/A 90" BEND & CONDUIT BUSHING EXTEND 1 1/4" CONDUIT UNDER FLOOR.
- PROVIDE DUAL GANG CAST FLOOR BOX WITH FLIP LIP COVERS, ALUMINUM FINISH. PROVIDE (2) 125V, 15A, 25-15R TYPE RECEPTACLS IN DUAL GANG & 1" PVC WILL BE EQUIP FOR DATA CONDUIT. COORDINATE WITH MWDOC FOR DATA JACK PREORDINATION.
- DISCONNECT, REMOVE AND REPLACE RECEPTACL WITH A 125V, 20A RATED RECEPTACL WITH COVER PLATE.
- RECEPTACL SHALL BE RATED FOR 125V, 20A.
- CONTRACTOR SHALL VERIFY ALL EXISTING CIRCUITS ASSOCIATED WITH THE EXISTING RECEPTACL, MECHANICAL EQUIPMENT, AND LIGHTING (ETC) TAG AND EXTEND TO NEW PANELS. CONTRACTOR SHALL PROVIDE UPDATE PANEL DIRECTORIES UPON COMPLTION. ONCE ALL BRANCH CIRCUITS HAVE BEEN RELOCATED, THE CONTRACTOR SHALL DISCONNECT & REMOVE EXISTING PANEL INTERIORS, BACKBOX AND CONDUIT. COORDINATE WITH THE GENERAL CONTRACTOR FOR WALL REPAIR AND FINISHES.
- PROVIDE 2 GANG CAST FLOOR BOX WITH PROVISIONS TO PROVIDE FURNITURE WHIP FLEXIBLE CONNECTORS FOR POWER AND DATA. ALUMINUM FINISH.
- (10) FOR FURNITURE WHIP WILL BE PROVIDED BY FURNITURE MANUFACTURER.
- 11) FOR FURNITURE WHIP RUN (3) #12 HOT, (3)#12 NEUTRAL & (1) #12 GROUND IN ¾" C.
- 12) (4) 3" C.O. WITH 90 DEGREE BEND ABOVE CEILING WITH BUSHINGS.
- 13) FOR FURNITURE WHIP RUN (4) #12 HOT, (4)#12 NEUTRAL & (1) #12 GROUND IN ¾" C.
- 14) AUTOMATIC ADA COMPLIANT MOTORIZED DOORS. REFER TO ARCHITECTURAL PLANS. MANUFACTURER'S EQUIPMENT BATTERY FOR 100 CYCLE OPERATION.
- ADA PUSH WIRELESS BUTTON CONTROL PER DOOR MANUFACTURER. REFER TO ARCHITECTURAL PLANS AND SPECIFICATIONS.
- BACK BOX WILL BE FURNISHED AND INSTALLED BY AV CONTRACTOR. ELECTRICAL CONTRACTOR SHALL MAKE THE FINAL TERMINATING POWER.
- PROVIDE 250V MOTOR RATED SWITCH AND SEAL TITE CONNECTION TO INSTA HOT LOCATED UNDER SINK. COORDINATE WITH PLUMBING CONTRACTOR.

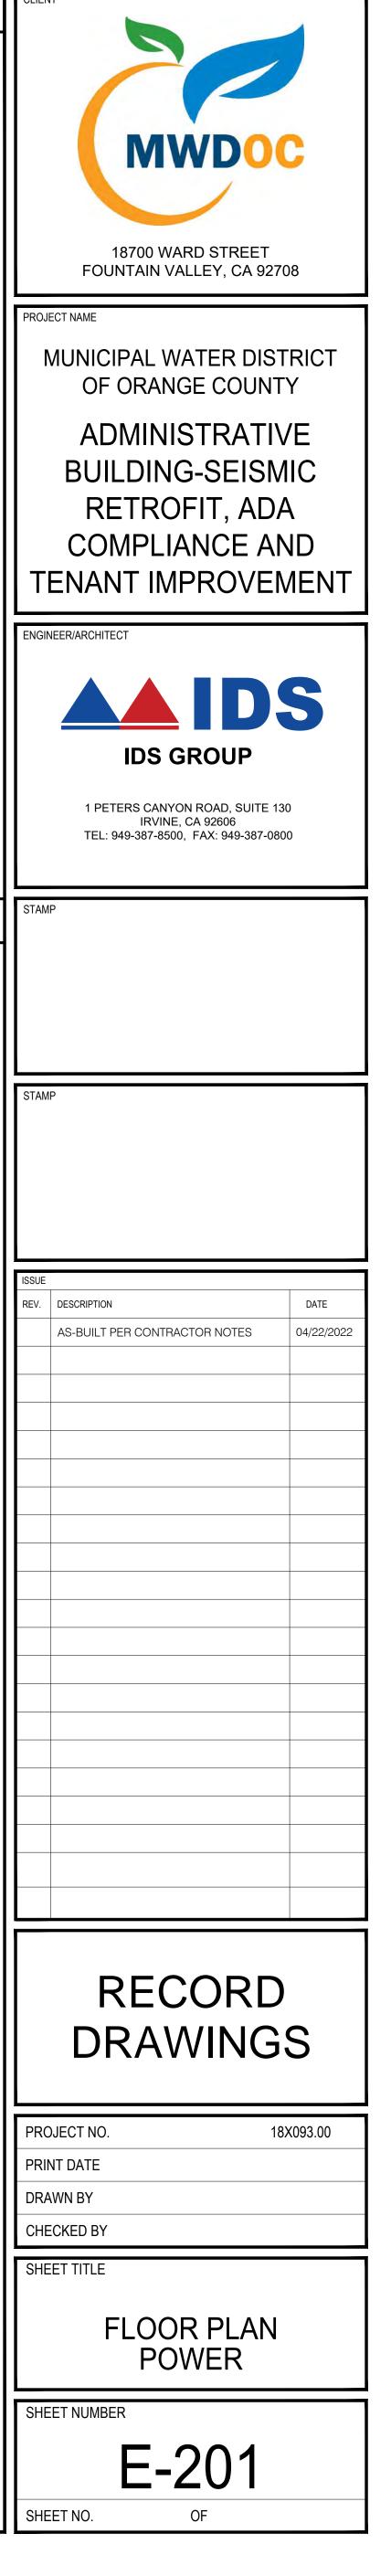


FIXTURE NOTES


	S SHALL INCLUDE ALL ACCESSORIES FOR INSTALLATION AS REQUIRED BY CALIFORNIA AND LOCAL ELECTRICAL CODES.
	RACTOR) SHALL
	RIFY ALL FIXTURES SHALL HAVE APPROPRIATE UL, ETL OR OTHER RECOGNIZED AND ACCEPTED TESTING AGENCY FOR
	Y, DAMP, OR WET LOCATION INSTALLATION AS REQUIRED BY CALIFORNIA AND LOCAL ELECTRICAL CODES.
	RIFY ALL INTEGRAL OR REMOTE DRIVERS ARE RECOGNIZED BY UL, ETL OR OTHER RECOGNIZED TESTING AGENCY.
	AOTE DRIVERS SHALL BE LISTED AS AN "ASSEMBLY" TO OPERATE WITH THE LUMINAIRE
	RK WITH THE CONTRACTOR TO VERIFY ITEMS OUTLINED IN SECTION 5 BELOW
	O THE RELEASE OF THE LIGHTING FIXTURE ORDER, CONTRACTOR SHALL WORK WITH THE LIGHTING PROCUREMENT
	: RIFY FIXTURE LOCATION AND ABOVE-CEILING CLEARANCES FOR RECESSED FIXTURES. CONTRACTOR SHALL NOTIFY THE
	HTING DESIGNER OF ANY CONFLICTS.
	RIFY FINAL FIXTURE VOLTAGE
	RIFY CEILING TRIM COMPATIBILITY (E.G. GYP. OR SUSPENDED CEILING)
VER	RIFY FIELD LENGTHS OF COVE OR PERIMETER LIGHTING. THESE FIXTURES MUST NOT BE DIMENSIONED FROM PLANS
	NTIFY FIRE RATED CEILING OR FLOOR ASSEMBLIES AND PROVIDE FIRE RATED ENCLOSURES FOR FIXTURES TO BE
	TALLED IN THESE CONDITIONS NTIFY INSULATED CEILING AREAS AND PROVIDE IC RATED HOUSING OPTIONS FOR FIXTURES TO BE INSTALLED IN THESE
	NTIFT INSULATED CEILING AREAS AND PROVIDE IC RATED HOUSING OPTIONS FOR FIXTORES TO BE INSTALLED IN THESE NDITIONS. CONTRACTOR SHALL NOTIFY THE LIGHTING DESIGNER IF AN IC OPTION IS NOT AVAILABLE FOR THE SPECIFIED
	FURE(S)
	OR LED LIGHT ENGINES SHALL BE INSTALLED AS OUTLINED IN THE FIXTURE SCHEDULE BELOW.
7. CEILING	THICKNESSES IN EXCESS OF 3/4" SHALL BE IDENTIFIED IN WRITING BY THE ARCHITECT OR CONTRACTOR
	DIRECTLY ILLUMINATED (E.G. "WALL GRAZING" OR PERIMETER LIGHTING SYSTEMS) SHALL BE A LEVEL 5 FINISH, AS
	N GYPSUM ASSOCIATION GA 216-96.
	CHITECT AND LIGHTING DESIGNER SHALL APPROVE FIXTURE SUBSTITUTIONS PRIOR TO BID, IN ACCORDANCE WITH 16 00 00 SPECIFICATIONS. IF NON-SPECIFIED OR NON-APPROVED ALTERNATES ARE INSTALLED, THEY SHALL BE REPLACED
	INTRACTORS SOLE EXPENSE (INCLUDING BACKCHARGES BY OTHER TRADES SUCH AS DRYWALL, PAINTING, ETC.), WITH
	ONAL COST TO THE OWNER.

Latest revisions in BOLD


LIGHT FIXTURE SCHEDULE


TYPE	DESCRIPTION	LOCATION	MANUFACTURER & CATALOG#	LUMENS OUTPUT / KELVIN TEMP	TOTAL WATTS	VOLTS	REMARKS
А	2x4 LED TROFFER. 0-10V DIMMING DRIVER	OFFICES & CORRIDOR	SAYLITE #SBX SERIES	5000	40	277	RECESSED T-GRID. PROVIDE SEISMIC SUPPORTS
В	4" DIA LED DOWN LIGHT WITH 0- 10V DIMMING DRIVER. W/ A REGRESSED REFLECTOR LENS	CONF. ROOMS	DMF #DRD2 STANDARD SERIES	1090 / 3500K	12.8	277	T-GRID FRAME KIT
BW	4" DIA LED WALL WASH DOWN LIGHT WITH 0-10V DIMMING DRIVER	CONF. ROOMS	DMF #DRD2 STANDARD SERIES	1090 / 3500K	12.8	277	GYP. BD. CEILING. EQUIP FRAME KIT
С	4', 2"x3" PERIMETER LINEAR LED FIXTURE WITH CONTINOUS SNAP ON LENS AND CAST ALUMNIMUM HOUSING. 0-1V DIMMING.		PRUDENTIAL # BOLT BOX SERIES	2565 / 3500K	5.75/LF	277	SURFACE MOUNTED TO SUSPENDED GYP. BD. CEILING. REFER TO ARCHITECTURAL
D2	LINEAR WALL SLOT LED FIXTURE WITH GRID TRIM. WHITE FINISH. FIELD CONFIRM LENGHTS FOR EXACT LINEAR COVE RUN	RESTROOMS	LITE CONTROL # WALL SLOT 6000 SERIES (2LF)	1200 / 3500K	18	277	GYP. BD. CEILING. EQUIP WITH EXTRUDED ALUM. MOUNTING RAILS. REFER TO ARCHITECTURAL DETAILS
D4	LINEAR WALL SLOT LED FIXTURE WITH GRID TRIM. WHITE FINISH. FIELD CONFIRM LENGHTS FOR EXACT LINEAR COVE RUN	RESTROOMS	LITE CONTROL # WALL SLOT 6000 SERIES (4LF & 8LF RUNS)	1200 / 3500K	18	277	GYP. BD. CEILING. EQUIP WITH EXTRUDED ALUM. MOUNTING RAILS. REFER TO ARCHITECTURAL DETAILS
E	6LF LINEAR LED ASYMMETRIC WALL WASH FIXTURE WITH 0-10V DRIVER.	LOBBY	PRUDENTIAL #MICRO WASH SERIES (6LF RUNS)	460lm/ft / 3500K	47	277	SURFACE MOUNTED. REFER TO ARCHITECTURAL DETAILS. FIELD ADJUST DIMMING
F	3' DIA SEMI-RECESSED LED LIGHT FIXTURE WITH OPAL LENS & 0-10V DIMMING DRIVER, LOW LIGHT OUTPUT	LOBBY	PRUDENTIAL #9030 SKY SERIES	LO LUMEN OUTPUT / 3500K	56	277	RECESSED GYP. BD. CEILING
G	LED COVE LIGHT WITH EXTRUDED ALUMINUM CHANNEL AND LENS	CONF. ROOMS AND LOBBY	INFINEX CHANNEL SERIES TAPE LIGHT	91 LUMENS / LF 3500K	1.5₩/LF	277	EQUIP WITH MANUFACTURERS STEPDOWN TRANSFORMER AND POWER SUPPLY. REFER TO ARCHITECTURAL DETAILS FOR MOUNTING
Н	ASYMETRICAL WALL WASH LINEAR FIXTURE, 2 1/2" WIDE		PRUDENTAIL #23 SERIES	3500K	45W	277V	T-GRID RECSSED FIXTURE. SEE AREA DETAILS
X	EXIT SIGN. GREEN LED EDGE LIT		DUAL #EDGE LIT SERIES	5 / GREEN	5	277	CEILING MOUNTED. REFER TO ARCHTECTURAL PLANS FOR DIRECTIONAL ARROW REQUIREMENTS

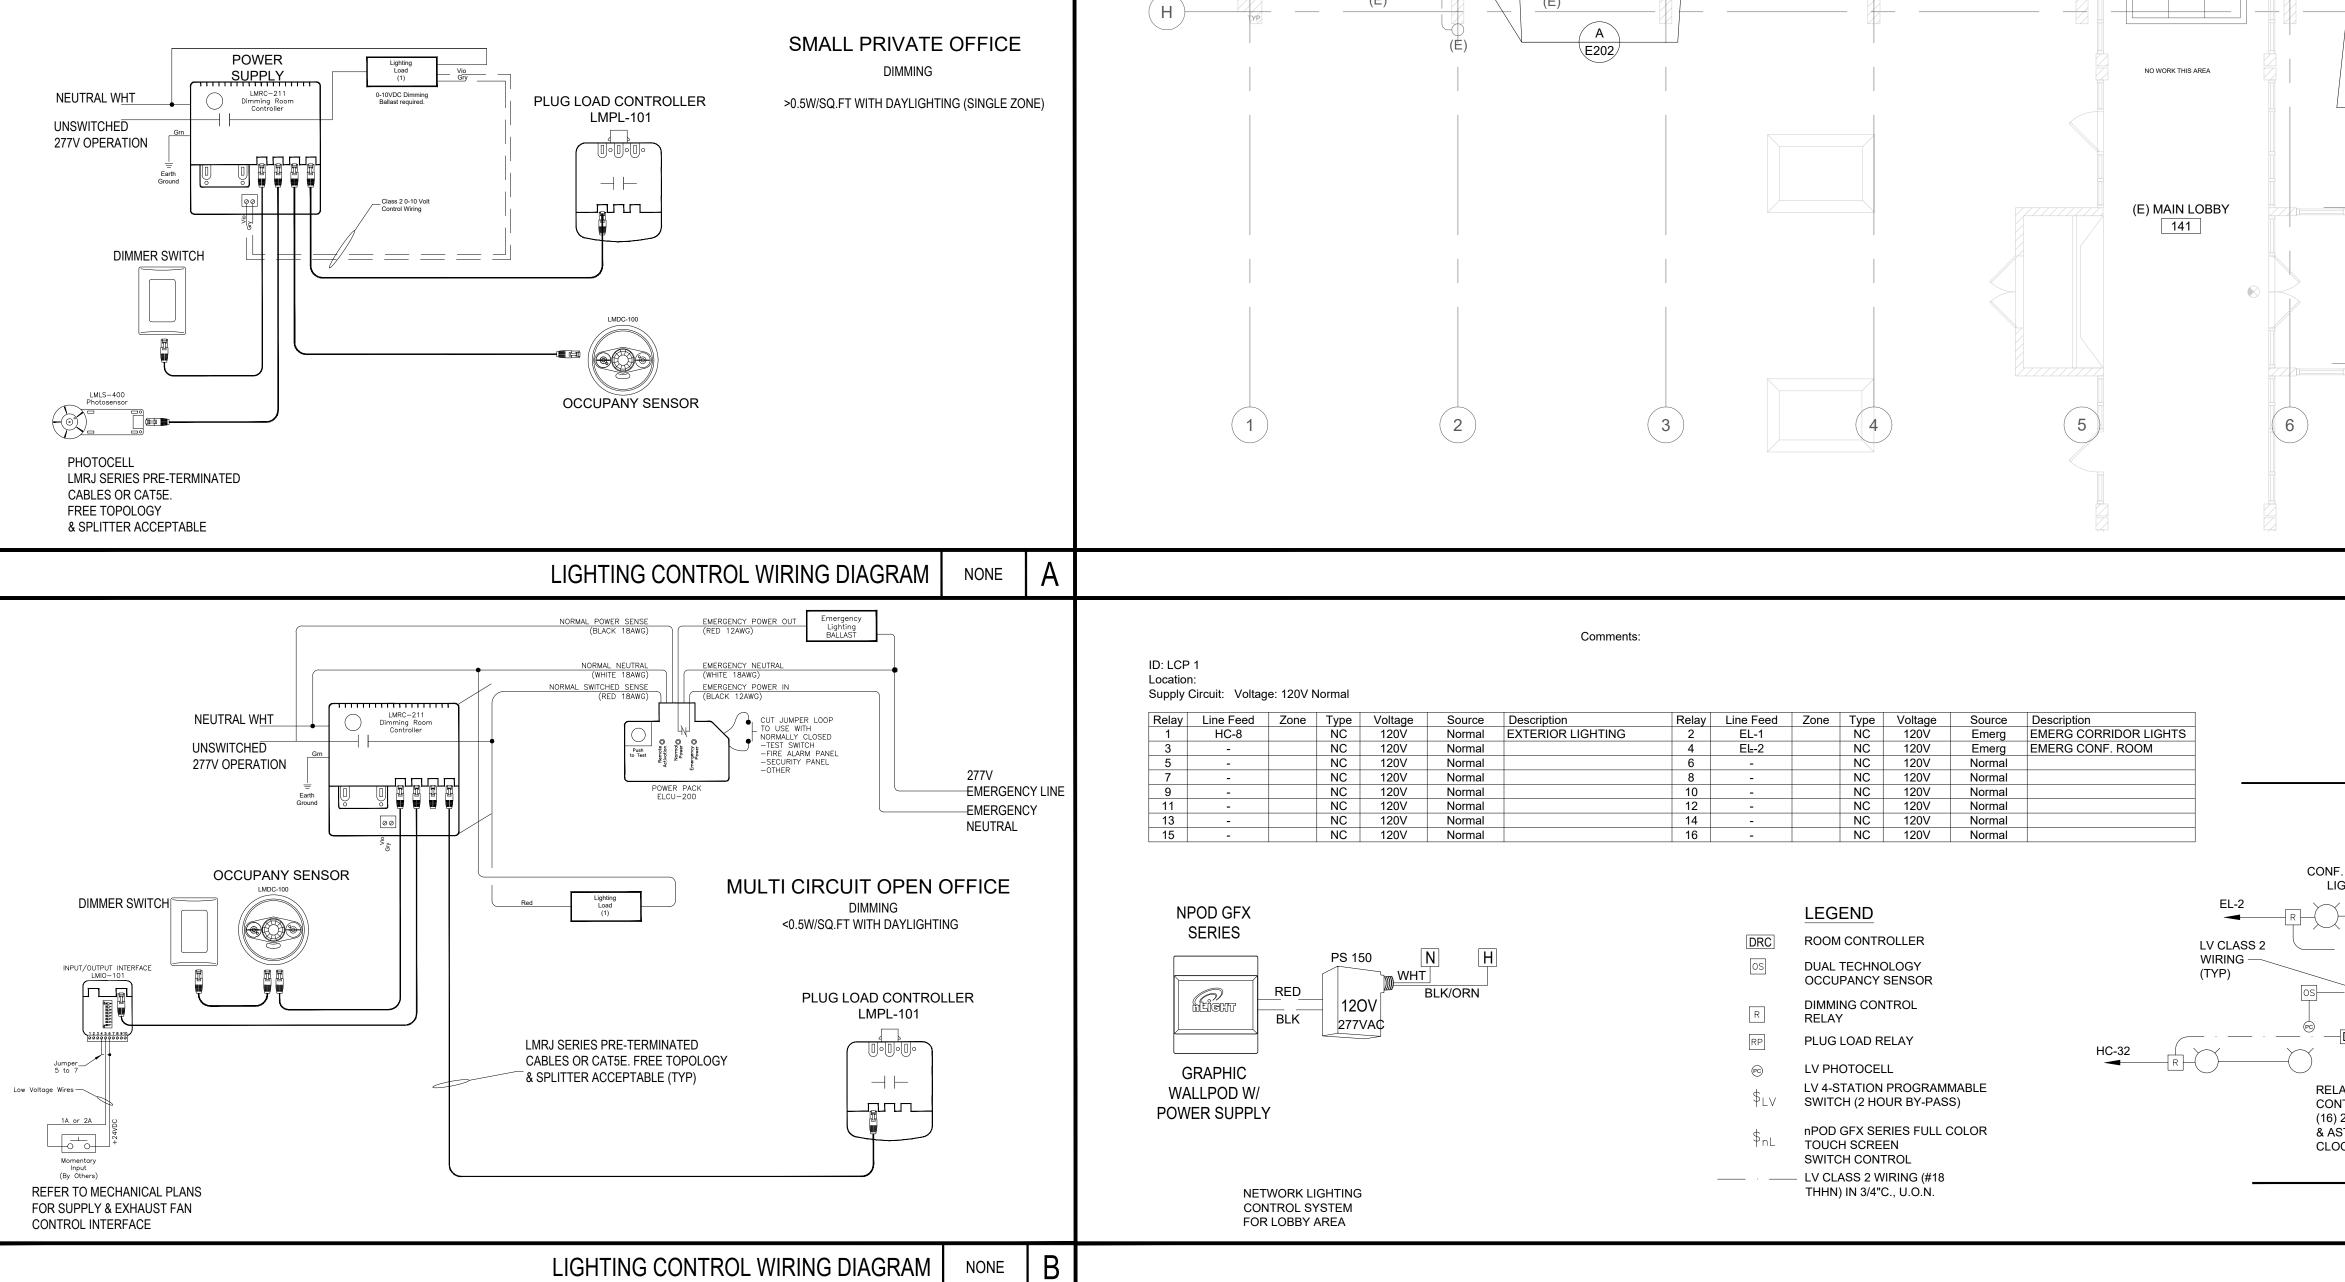

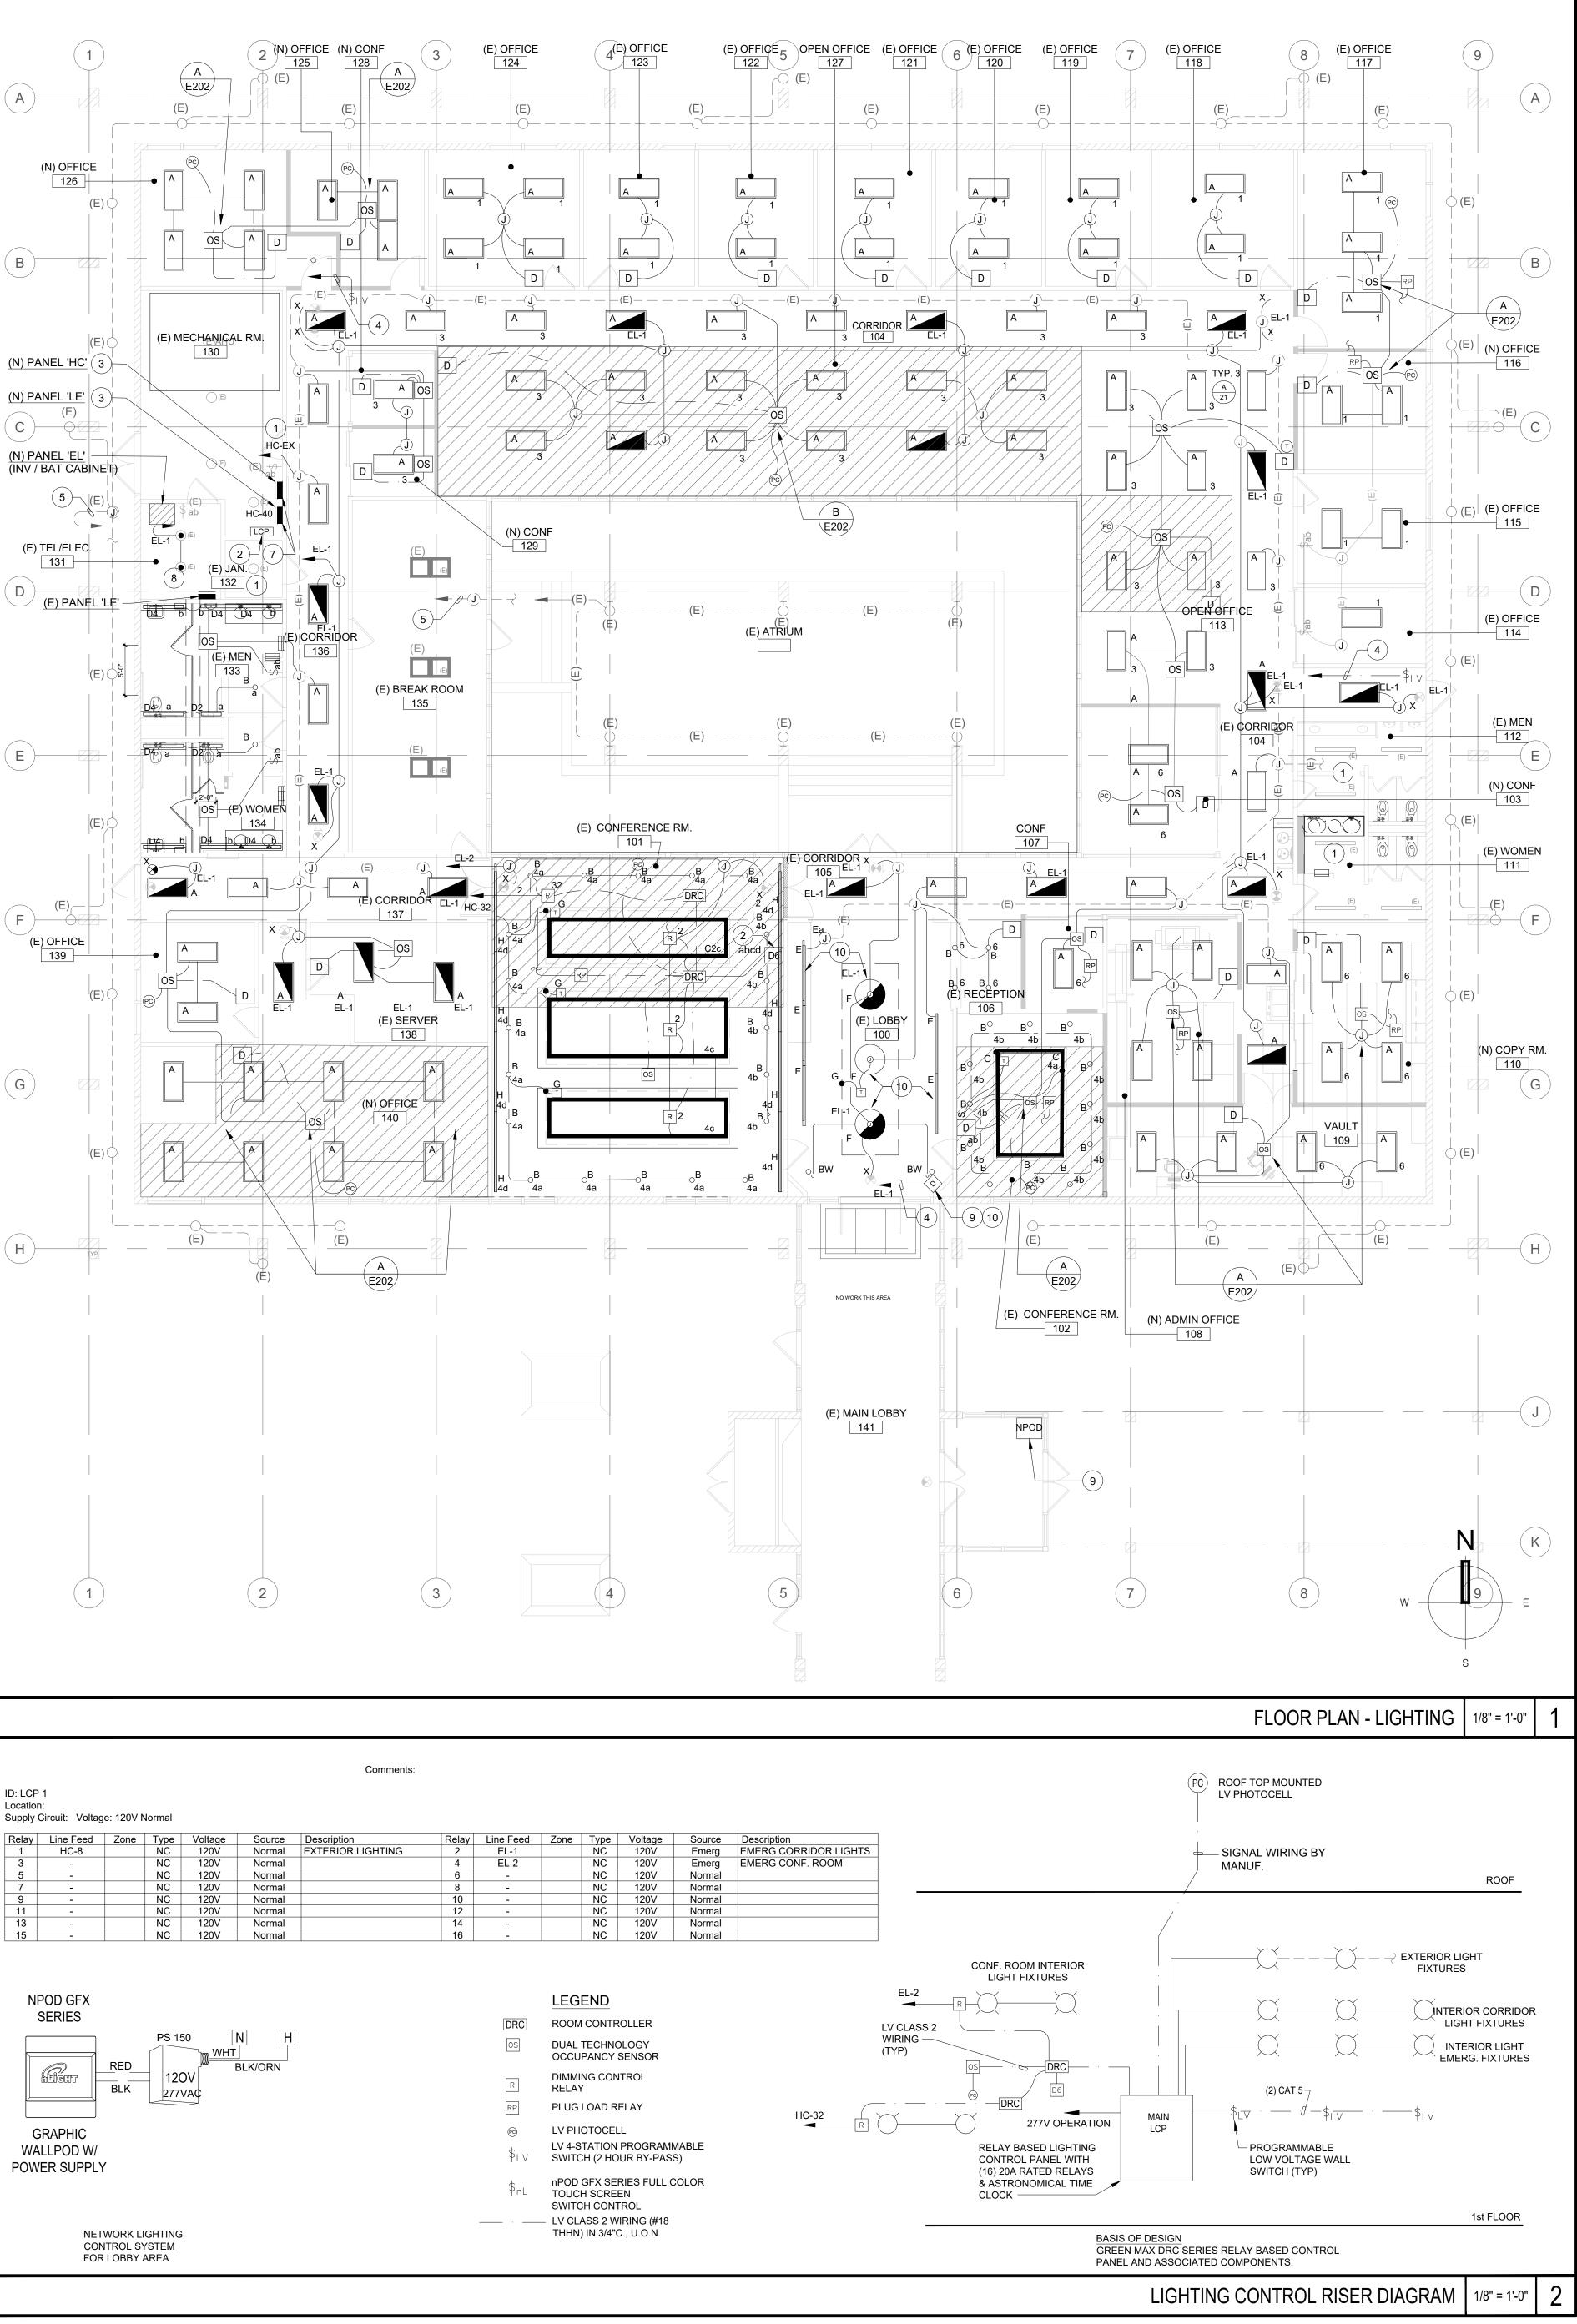

GENERAL NOTES	CLIENT
 PROVIDE A DISCONNECTING MEANS FOR EACH MULTI-WIRE LIGHTING BRANCH CIRCUIT IN ACCORDANCE w/ NEC 410.130(G)(1) THRU (3). DISCONNECTING MEANS SHALL BE LOCATED AT POINT WHERE CIRCUIT ORIGINATES AND SHALL SIMULTANEOUSLY DISCONNECT ALL UNGROUNDED CONDUCTORS. REFER TO ARCHITECTURAL REFLECTED CEILING PLAN FOR EXACT LOCATION OF LIGHTING FIXTURES. 	
 VERIFY EXACT CEILING CONSTRUCTION W/ ARCHITECTURAL REFLECTED CEILING PLAN AND PROVIDE LIGHTING FIXTURES W/ NECESSARY MOUNTING HARDWARE. COORDINATE EXACT LIGHTING FIXTURE LOCATIONS W/ MECHANICAL EQUIPMENT AND DUCT WORK PRIOR TO ROUGH-IN. 	
 RECESSED FIXTURES SHALL BE PROVIDED W/ ALL REQUIRED STRUCTURAL SUPPORTS AS REQUIRED BY CURRENTLY ACCEPTED EDITION OF APPLICABLE NATIONAL, STATE, AND CITY CODES, ORDINANCES, AND AMENDMENTS. DIMMING BRANCH CIRCUITS SHALL BE PROVIDED W/ A DEDICATED NEUTRAL CONDUCTOR FOR EACH ZONE/CHANNEL. LOW VOLTAGE WIRING NOT RUN IN CONDUIT SHALL BE PLENUM RATED. CONTRACTOR TO PROVIDE NECESSARY TRAVELER CONDUCTORS FOR ALL 3 AND 4 WAY SWITCHING APPLICATIONS. GENERAL CONTRACTOR SHALL VERIFY CEILING FIRE RATING WITH ARCHITECT, AND BOX OR TENT RECESSED LIGHT FIXTURES, IF REQUIRED, TO MAINTAIN CEILING FIRE RATING. PENETRATIONS THROUGH FIRE RATED WALLS SHALL BE PROTECTED 	PROJEC
 FROM THE SPREAD OF FIRE WITH AN APPROVED FIRESTOP SYSTEM EQUAL OR GREATER THAN THE FIRE RATING OF THE WALL. 11. A CERTIFICATE OF ACCEPTANCE SHALL BE SUBMITTED TO THE ENFORCEMENT AGENCY UNDER TITLE 24, 130.4(a) OF PART 1 FOR: A. 	TE
 LIGHTING CONTROLS. 12. VERIFY EXACT CEILING CONSTRUCTION AT SITE AND PROVIDE LIGHTING FIXTURES W/ ALL NECESSARY MOUNTING HARDWARE. 13. ALL NEW FIXTURES SHALL BE PROVIDED W/ ALL REQUIRED STRUCTURAL SUPPORTS AS REQUIRED BY CURRENTLY ACCEPTED EDITION OF ALL APPLICABLE NATIONAL, STATE, AND CITY CODES, ORDINANCES, AND AMENDMENTS. 14. PROGRAM ALL LIGHTING CONTROLS TO MEET THE LATEST REQUIREMENTS OF THE LIGHTING TITLE 24. 15. ALL LIGHTING FIXTURES AND CONTROLS ARE NEW UNLESS OTHERWISE NOTED. 16. LIGHT FIXTURES WITH INTERFACE WITH THE MECHANICAL VARIABLE REFRIGERATION SUPPLY AND EXHAUST FANS. CONTRACTOR SHALL REFER AND COORDINATE WITH THE MECHANICAL PLANS FOR LIGHTING OCCUPANCY SENSOR 0-10VDC OUTPUT SIGNAL. ELECTRICAL CONTRACTOR SHALL PROVIDE PLENUM RATED LOW VOLTAGE WIRING TO THE MECHANICAL EQUIPMENT ACCORDINGLY. 	ENGINE
 CONTRACTOR SHALL FIELD VERIFY ALL CIRCUITS ASSOCIATED WITH EXISTING PANEL 'HC', TAG AND EXTEND TO PANEL 'HC' NEW LOCATION AND RECONNECT. UPDATE PANEL DIRECTORIES ACCORDINGLY. THE EXISTING FIRE ALARM AND ENERGY MANAGEMENT SYSTEM AND OPERATIONAL REQUIREMENTS SHALL REMAIN AS IS. CONTRACTOR SHALL TAKE CAUTION PRIOR TO DISCONNECTING ANY DEVICES, DOCUMENT, PRESERVE WIRING AND CIRCUITRY. RE-INSTALL ANY DEVICES, AS PART OF THE CONSTRUCTION COORDINATION, TO MATCH EXISTING CONDITIONS. 	
	STAMP ISSUE REV. [
KEY NOTES	
 EXISTING LIGHTING & ASSOCIATED CONTROL TO REMAIN AS IS. RELAY BASED LIGHTING CONTROL PANEL. ALL PROGRAMMING 	
 SHALL BE COORDINATED WITH THE OWNER FOR SEQUENCE OF OPERATION. DISCONNECT, REMOVE, AND EXTEND ALL EXISTING CIRCUITS IN EXISTING PANEL TO NEW PANEL 'HC'. PROVIDE AN ABOVE CEILING WIREWAY ABOVE PANEL FOR INTERCEPTING EXISTING CIRCUITS. 	
 4 EXTEND CAT 5 WIRING TO LIGHTING CONTROL RELAY PANEL. REFER TO LIGHT CONTROL RISER DIAGRAM, DETAIL 2/SHEET E-202 5 INTERCEPT EXISTING EXTERIOR LIGHTING CIRCUIT AND EXTEND TO NEW PANEL VIA THE LIGHTING CONTROL RELAY CABINET. 6 PROVIDE A SIX STATION PROGRAMMABLE DIMMING STATION WITH ASSOCIATED RELAYS, COMBINATION OCCUPANCY SENSOR / DUDTO THE DIMMING STATION PROGRAMMABLE DIMMING STATION WITH 	
 PHOTOCELL, ROOM CONTROLLER AND LOW VOLTAGE WIRING. LEVITON # GREEN MAX DRC SERIES. FIELD VERIFY EXISTING CIRCUIT, EXTEND TO UPGRADED PANEL LOCATION, AND RECONNECT. UPDATE PANEL DIRECTORY FOR EXACT CIRCUIT IDENTIFIED. 	
 8 DISCONNECT AND REMOVE EXISTING CIRCUIT AND RECONNECT TO PANEL EL-1. 9 LV LCD TOUCH SCREEN, PROGRAMMABLE WIRING CONTROL DEVICE WITH 2 HOUR BY PASS NLIGHT # nPOD GFX. 10 PROGRAM LIGHT FIXTURE FOR DIMMING CAPABILITIES. 	
	PROJ PRINT DRAW CHEC SHEE
	SHEF

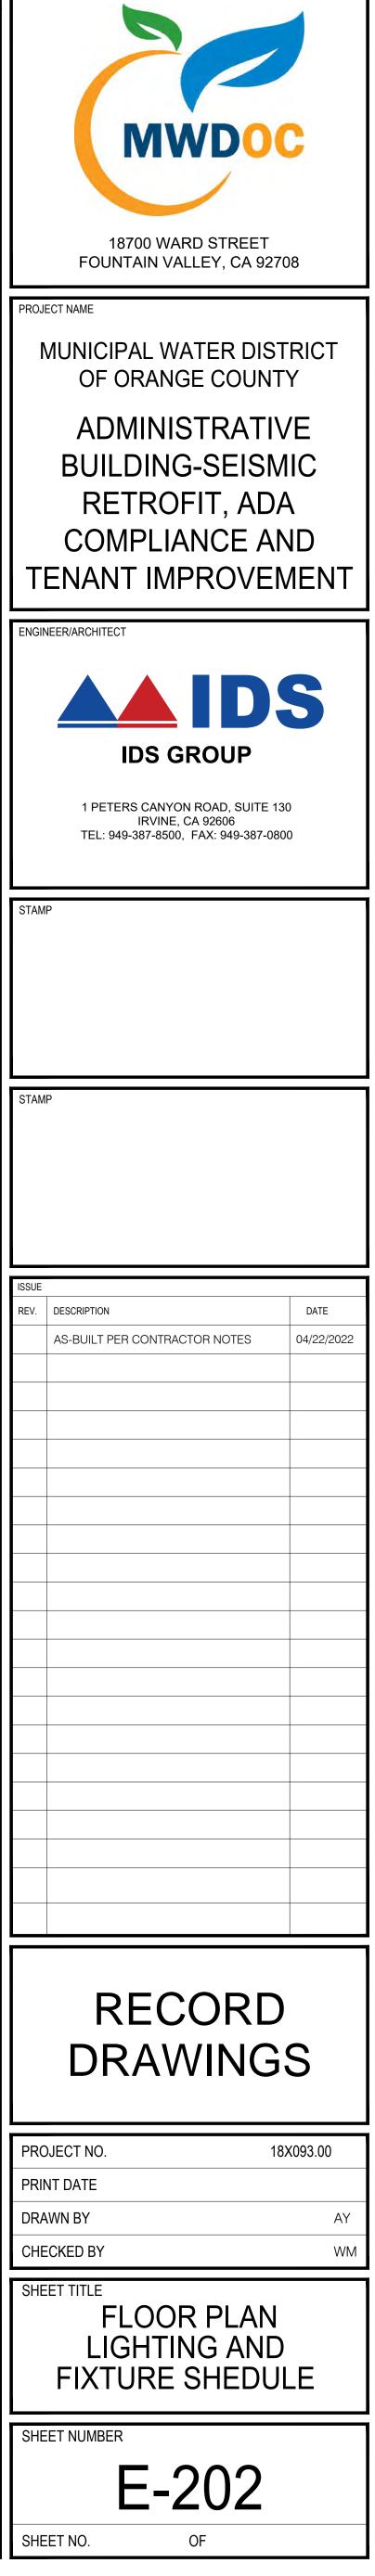

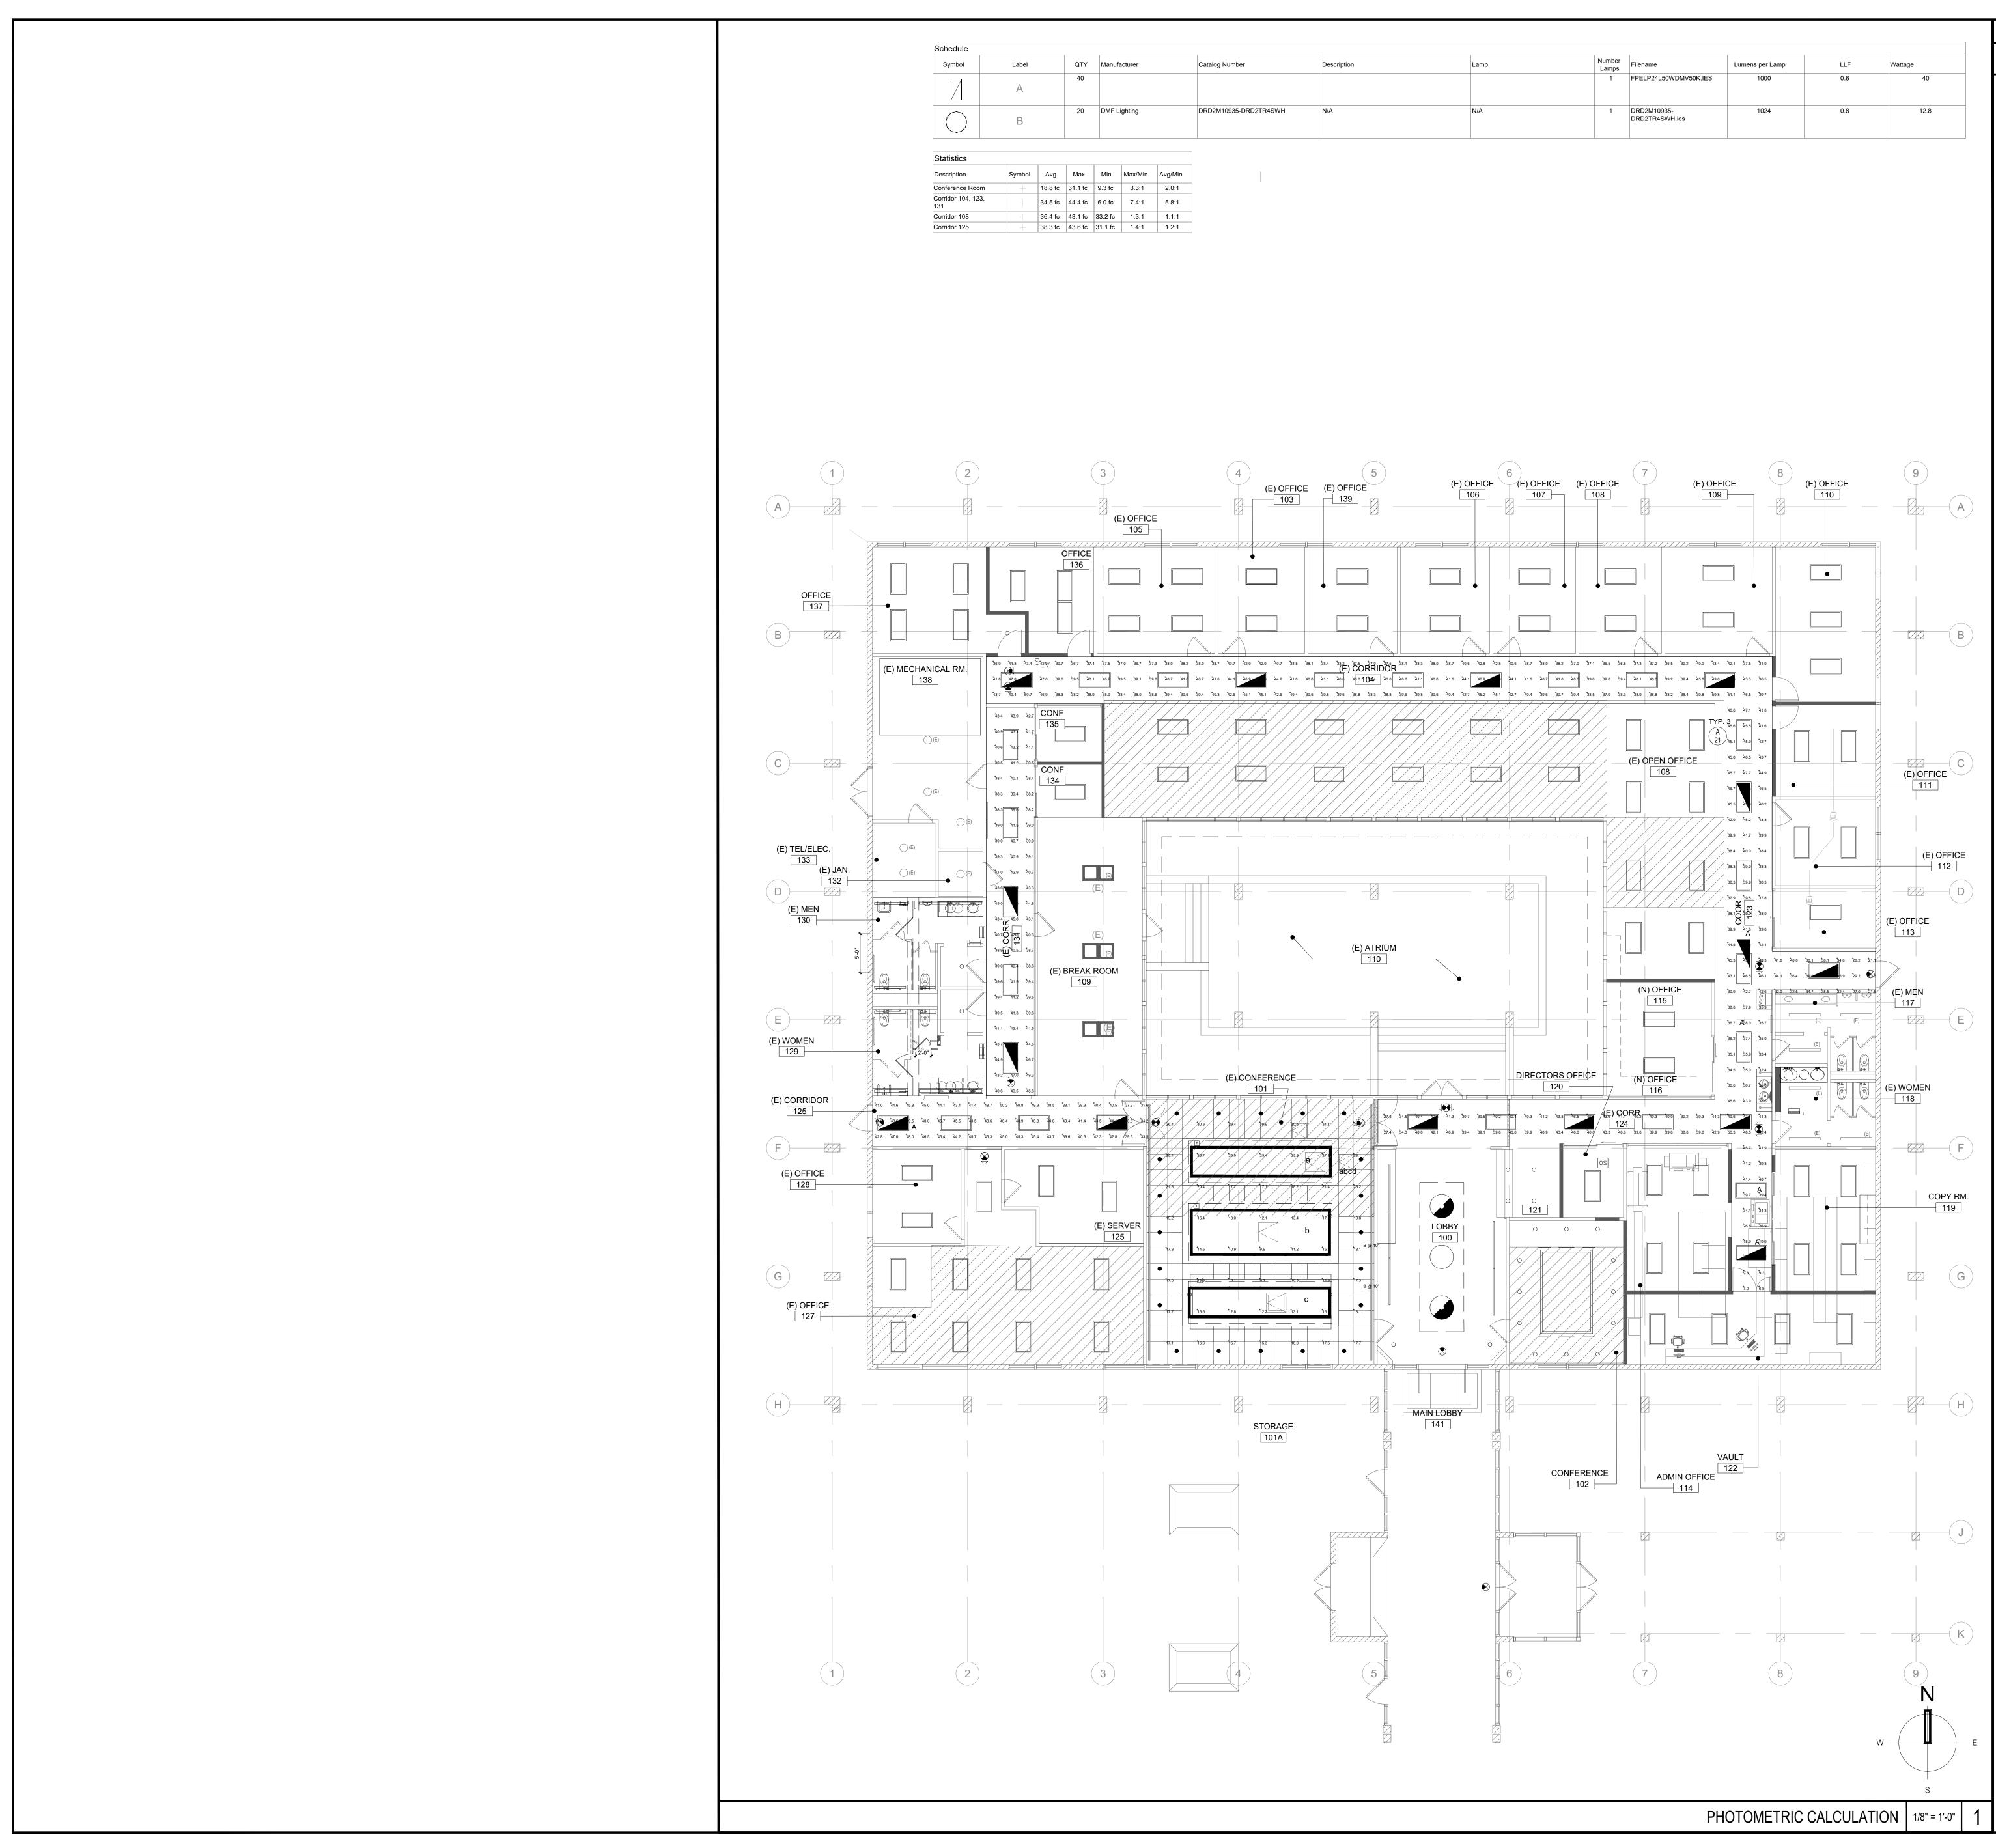


Schedule									
Symbol	Label		QTY	Manufacturer			Catalog Number	Description	Lamp
	А		40						
\bigcirc	В	В		DMF Lighting			DRD2M10935-DRD2TR4SWH	N/A	N/A
Statistics		1	1		1				'
Description	Symbol	Avg	Max	Min	Max/Min	Avg/Min			
Conference Room	+	18.8 fc	31.1 fc	9.3 fc	3.3:1	2.0:1			
Corridor 104, 123, I31	+	34.5 fc	44.4 fc	6.0 fc	7.4:1	5.8:1			
			-	-			1		

Number Lamps	Filename	Lumens per Lamp	LLF	Wattage
1	FPELP24L50WDMV50K.IES	1000	0.8	40
1	DRD2M10935- DRD2TR4SWH.ies	1024	0.8	12.8

G	ENERAL NOTES	
1.	PROVIDE A DISCONNECTING MEANS FOR EACH MULTI-WIRE LIGHTING BRANCH CIRCUIT IN ACCORDANCE w/ NEC 410.130(G)(1) THRU (3). DISCONNECTING MEANS SHALL BE LOCATED AT POINT WHERE CIRCUIT ORIGINATES AND SHALL SIMULTANEOUSLY DISCONNECT ALL UNGROUNDED CONDUCTORS.	
2.	REFER TO ARCHITECTURAL REFLECTED CEILING PLAN FOR EXACT LOCATION OF LIGHTING FIXTURES.	
3.	VERIFY EXACT CEILING CONSTRUCTION W/ ARCHITECTURAL REFLECTED CEILING PLAN AND PROVIDE LIGHTING FIXTURES W/ NECESSARY MOUNTING HARDWARE.	
4.	COORDINATE EXACT LIGHTING FIXTURE LOCATIONS W/ MECHANICAL EQUIPMENT AND DUCT WORK PRIOR TO ROUGH-IN.	
5.	RECESSED FIXTURES SHALL BE PROVIDED W/ ALL REQUIRED STRUCTURAL SUPPORTS AS REQUIRED BY CURRENTLY ACCEPTED EDITION OF APPLICABLE NATIONAL, STATE, AND CITY CODES, ORDINANCES, AND AMENDMENTS.	
6.	DIMMING BRANCH CIRCUITS SHALL BE PROVIDED W/ A DEDICATED NEUTRAL CONDUCTOR FOR EACH ZONE/CHANNEL.	
7.	LOW VOLTAGE WIRING NOT RUN IN CONDUIT SHALL BE PLENUM RATED.	
8.	CONTRACTOR TO PROVIDE NECESSARY TRAVELER CONDUCTORS FOR ALL 3 AND 4 WAY SWITCHING APPLICATIONS.	
9.	GENERAL CONTRACTOR SHALL VERIFY CEILING FIRE RATING WITH ARCHITECT, AND BOX OR TENT RECESSED LIGHT FIXTURES, IF REQUIRED, TO MAINTAIN CEILING FIRE RATING.	
10.	PENETRATIONS THROUGH FIRE RATED WALLS SHALL BE PROTECTED FROM THE SPREAD OF FIRE WITH AN APPROVED FIRESTOP SYSTEM EQUAL OR GREATER THAN THE FIRE RATING OF THE WALL.	
11.	A CERTIFICATE OF ACCEPTANCE SHALL BE SUBMITTED TO THE ENFORCEMENT AGENCY UNDER TITLE 24, 130.4(a) OF PART 1 FOR: A. LIGHTING CONTROLS.	
12.	VERIFY EXACT CEILING CONSTRUCTION AT SITE AND PROVIDE LIGHTING FIXTURES W/ ALL NECESSARY MOUNTING HARDWARE.	
13.	ALL NEW FIXTURES SHALL BE PROVIDED W/ ALL REQUIRED STRUCTURAL SUPPORTS AS REQUIRED BY CURRENTLY ACCEPTED EDITION OF ALL APPLICABLE NATIONAL, STATE, AND CITY CODES, ORDINANCES, AND AMENDMENTS.	
14.	PROGRAM ALL LIGHTING CONTROLS TO MEET THE LATEST REQUIREMENTS OF THE LIGHTING TITLE 24.	
15.	ALL LIGHTING FIXTURES AND CONTROLS ARE NEW UNLESS OTHERWISE NOTED.	
16.	LIGHT FIXTURES WITH INTERFACE WITH THE MECHANICAL VARIABLE REFRIGERATION SUPPLY AND EXHAUST FANS. CONTRACTOR SHALL REFER AND COORDINATE WITH THE MECHANICAL PLANS FOR LIGHTING OCCUPANCY SENSOR 0-10VDC OUTPUT SIGNAL. ELECTRICAL CONTRACTOR SHALL PROVIDE PLENUM RATED LOW VOLTAGE WIRING TO THE MECHANICAL EQUIPMENT ACCORDINGLY.	

	MWDO	
	18700 WARD STREET FOUNTAIN VALLEY, CA 9270	8
N	ADMINISTRATIV BUILDING-SEISM RETROFIT, ADA COMPLIANCE AN	Y YE IC ND
ENGI		5
	IDS GROUP 1 PETERS CANYON ROAD, SUITE 130 IRVINE, CA 92606 TEL: 949-387-8500, FAX: 949-387-0800	
STAM	P	
STAM	Ρ	
ISSUE REV.	DESCRIPTION AS-BUILT PER CONTRACTOR NOTES	DATE 04/22/2022
	RECORD DRAWING	S
PRI	DJECT NO. 18> NT DATE WN BY CKED BY	(093.00
SHE	ET TITLE PHOTOMETRIC CALCULATION	
	ET NUMBER E-401 ET NO. OF	

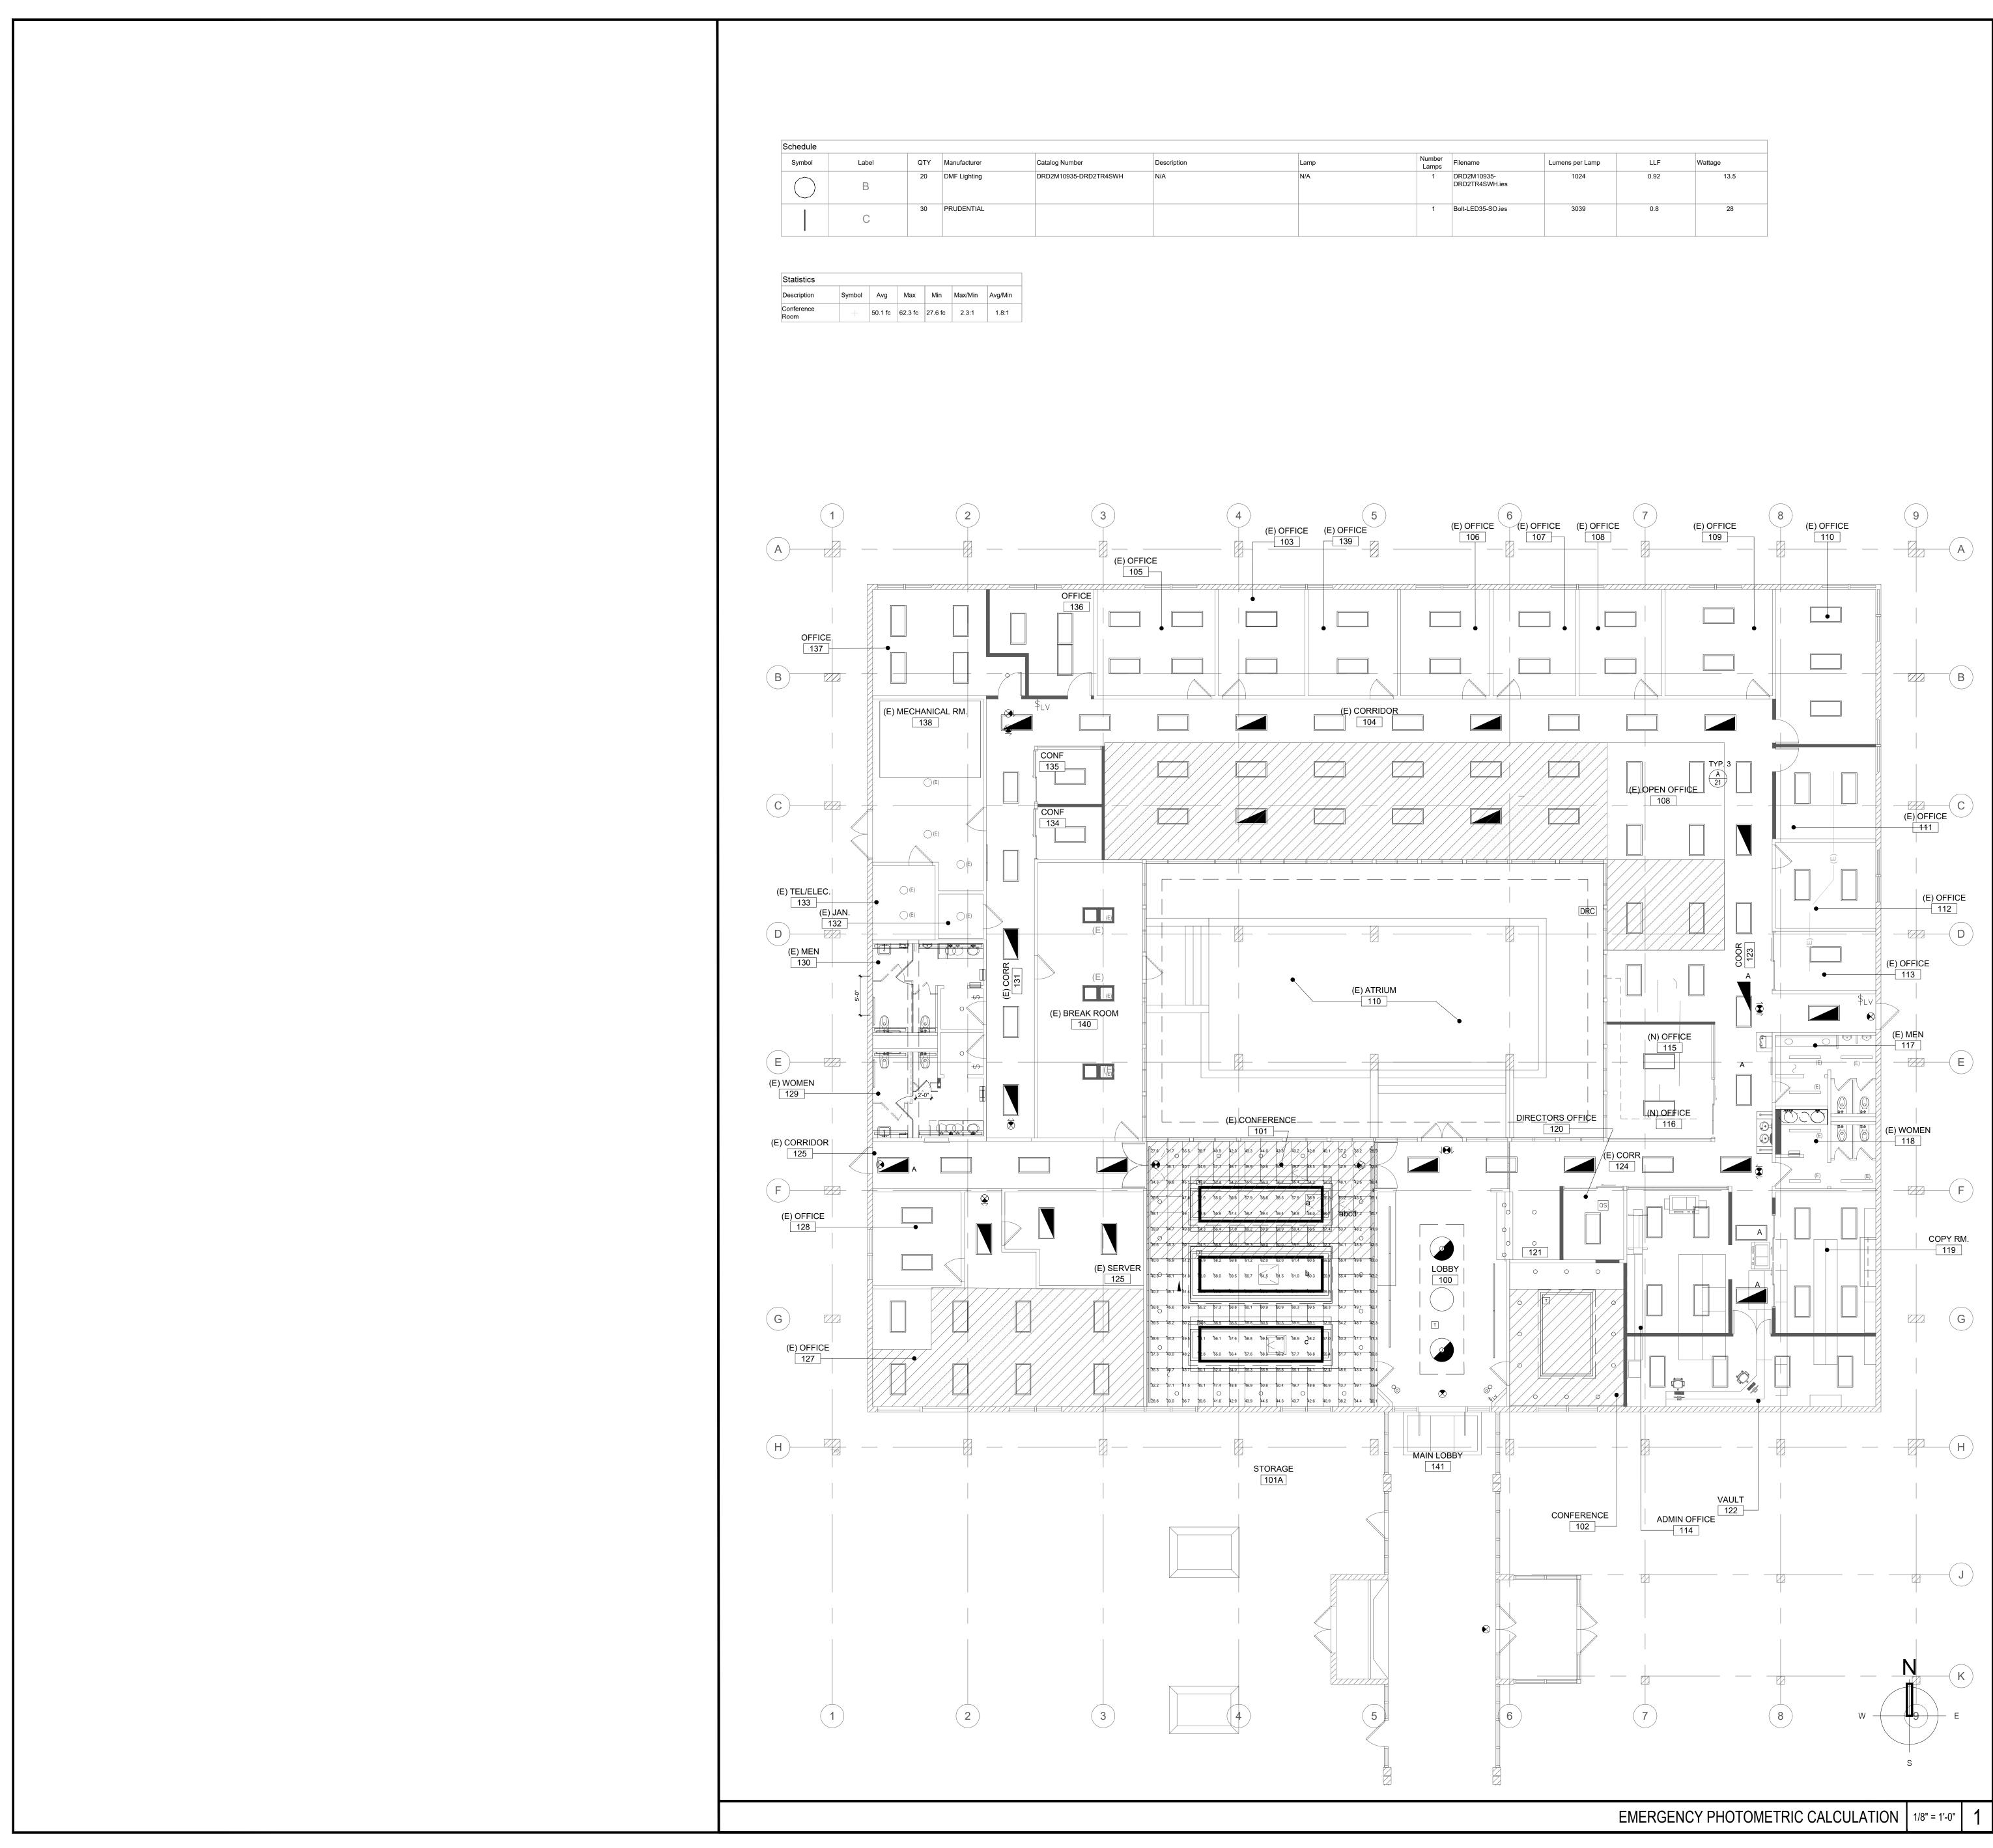


chedule										
Symbol	Label	QTY Manufacturer	Catalog Number	Description	Lamp	Number Lamps	Filename	Lumens per Lamp	LLF	Wattage
\bigcirc	В	20 DMF Lighting	DRD2M10935-DRD2TR4SWH	N/A	N/A	1	DRD2M10935- DRD2TR4SWH.ies	1024	0.92	13.5
	С	30 PRUDENTIAL				1	Bolt-LED35-SO.ies	3039	0.8	28

Statistics									
Description	Symbol	Avg	Max	Min	Max/Min	Avg/Min			
Conference Room	+	50.1 fc	62.3 fc	27.6 fc	2.3:1	1.8:1			

G	ENERAL NOTES
1.	PROVIDE A DISCONNECTING MEANS FOR EACH MULTI-WIRE LIGHTING BRANCH CIRCUIT IN ACCORDANCE w/ NEC 410.130(G)(1) THRU (3). DISCONNECTING MEANS SHALL BE LOCATED AT POINT WHERE CIRCUIT ORIGINATES AND SHALL SIMULTANEOUSLY DISCONNECT ALL UNGROUNDED CONDUCTORS.
2.	REFER TO ARCHITECTURAL REFLECTED CEILING PLAN FOR EXACT LOCATION OF LIGHTING FIXTURES.
3.	VERIFY EXACT CEILING CONSTRUCTION W/ ARCHITECTURAL REFLECTED CEILING PLAN AND PROVIDE LIGHTING FIXTURES W/ NECESSARY MOUNTING HARDWARE.
4.	COORDINATE EXACT LIGHTING FIXTURE LOCATIONS W/ MECHANICAL EQUIPMENT AND DUCT WORK PRIOR TO ROUGH-IN.
5.	RECESSED FIXTURES SHALL BE PROVIDED W/ ALL REQUIRED STRUCTURAL SUPPORTS AS REQUIRED BY CURRENTLY ACCEPTED EDITION OF APPLICABLE NATIONAL, STATE, AND CITY CODES, ORDINANCES, AND AMENDMENTS.
6.	DIMMING BRANCH CIRCUITS SHALL BE PROVIDED W/ A DEDICATED NEUTRAL CONDUCTOR FOR EACH ZONE/CHANNEL.
7.	LOW VOLTAGE WIRING NOT RUN IN CONDUIT SHALL BE PLENUM RATED.
8.	CONTRACTOR TO PROVIDE NECESSARY TRAVELER CONDUCTORS FOR ALL 3 AND 4 WAY SWITCHING APPLICATIONS.
9.	GENERAL CONTRACTOR SHALL VERIFY CEILING FIRE RATING WITH ARCHITECT, AND BOX OR TENT RECESSED LIGHT FIXTURES, IF REQUIRED, TO MAINTAIN CEILING FIRE RATING.
10.	PENETRATIONS THROUGH FIRE RATED WALLS SHALL BE PROTECTED FROM THE SPREAD OF FIRE WITH AN APPROVED FIRESTOP SYSTEM EQUAL OR GREATER THAN THE FIRE RATING OF THE WALL.
11.	A CERTIFICATE OF ACCEPTANCE SHALL BE SUBMITTED TO THE ENFORCEMENT AGENCY UNDER TITLE 24, 130.4(a) OF PART 1 FOR: A. LIGHTING CONTROLS.
12.	VERIFY EXACT CEILING CONSTRUCTION AT SITE AND PROVIDE LIGHTING FIXTURES W/ ALL NECESSARY MOUNTING HARDWARE.

- 3. ALL NEW FIXTURES SHALL BE PROVIDED W/ ALL REQUIRED STRUCTURAL SUPPORTS AS REQUIRED BY CURRENTLY ACCEPTED EDITION OF ALL APPLICABLE NATIONAL, STATE, AND CITY CODES, ORDINANCES, AND
- AMENDMENTS. 4. PROGRAM ALL LIGHTING CONTROLS TO MEET THE LATEST REQUIREMENTS OF THE LIGHTING TITLE 24.
- 5. ALL LIGHTING FIXTURES AND CONTROLS ARE NEW UNLESS OTHERWISE NOTED.
- . LIGHT FIXTURES WITH INTERFACE WITH THE MECHANICAL VARIABLE REFRIGERATION SUPPLY AND EXHAUST FANS. CONTRACTOR SHALL REFER AND COORDINATE WITH THE MECHANICAL PLANS FOR LIGHTING OCCUPANCY SENSOR 0-10VDC OUTPUT SIGNAL. ELECTRICAL CONTRACTOR SHALL PROVIDE PLENUM RATED LOW VOLTAGE WIRING TO THE MECHANICAL EQUIPMENT ACCORDINGLY.

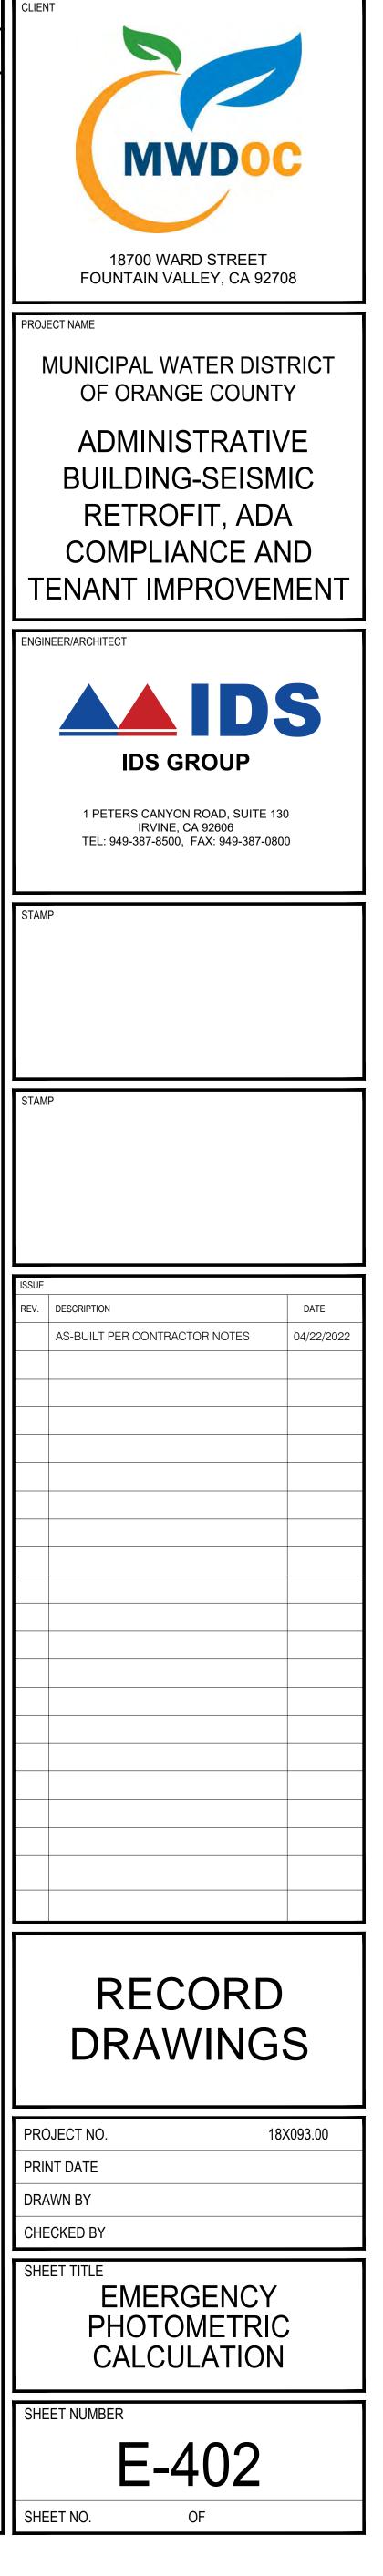



ymbol	Label	Quantity Manufacturer	Catalog Number	Lamp	Number Lamps	Filename	Lumens Per Lamp	Light Loss Factor	Wattage	Description
\hat{O}	BW	2 DMF Lighting	DRD2M7935-DRD2TR4WWH	N/A	1	DRD2M7935-DRD2TR4WWH.ies	709	0.8	11.6	N/A
	E	7 PRUDENTIAL LTG.	MW-LED35-HO-D1		1	MW-LED35-SO.ies	4268	0.8	47	1-3/4"L. x 48W. X 4-3/4"H. LED FIXTURI LINEAR PRISMATIC LENS
	F	3 Prudential Ltg	MW-LED35-HO-D1		1	P3930-LED4-LO-FWA-D1.ies	4932	0.4	56	1-3/4"L. x 48W. X 4-3/4"H. LED FIXTURI LINEAR PRISMATIC LENS

Description	Symbol	Avg	Max	Min	Max/Min	Avg/Min
East Wall WW Fixture Calc	+	20.0 fc	30.7 fc	10.5 fc	2.9:1	1.9:1
Overall Lobby Floor	+	44.3 fc	80.8 fc	17.1 fc	4.7:1	2.6:1
West Wall WW fixture Calc	+	19.9 fc	29.8 fc	9.7 fc	3.1:1	2.1:1


E @ 9'	E@9'	<u> </u>		
16.5	17.0 17.0	⁺ 16.5 ⁺ 15.7	⁺ 14.5 ⁺ 12.6	⁺ 12.6
+28.9	+ 31.8 + 32.5	+ 31.8 ⁺ 29.8	⁺ 25.7 ⁺ 20.5	+ 19.4
+28.1	⁺ 30.4 ⁺ 31.2	+ 30.4 ⁺ 28.3	+ 25.2 ⁺ 21.8	+ 19.1
26.3	+ 27.9 ⁺ 28.4	+ 27.6 ⁺ 25.6	+ 23.3 ⁺ 20.7	+ 18.0

EAST WALL ELEVATION PHOTOMETRIC

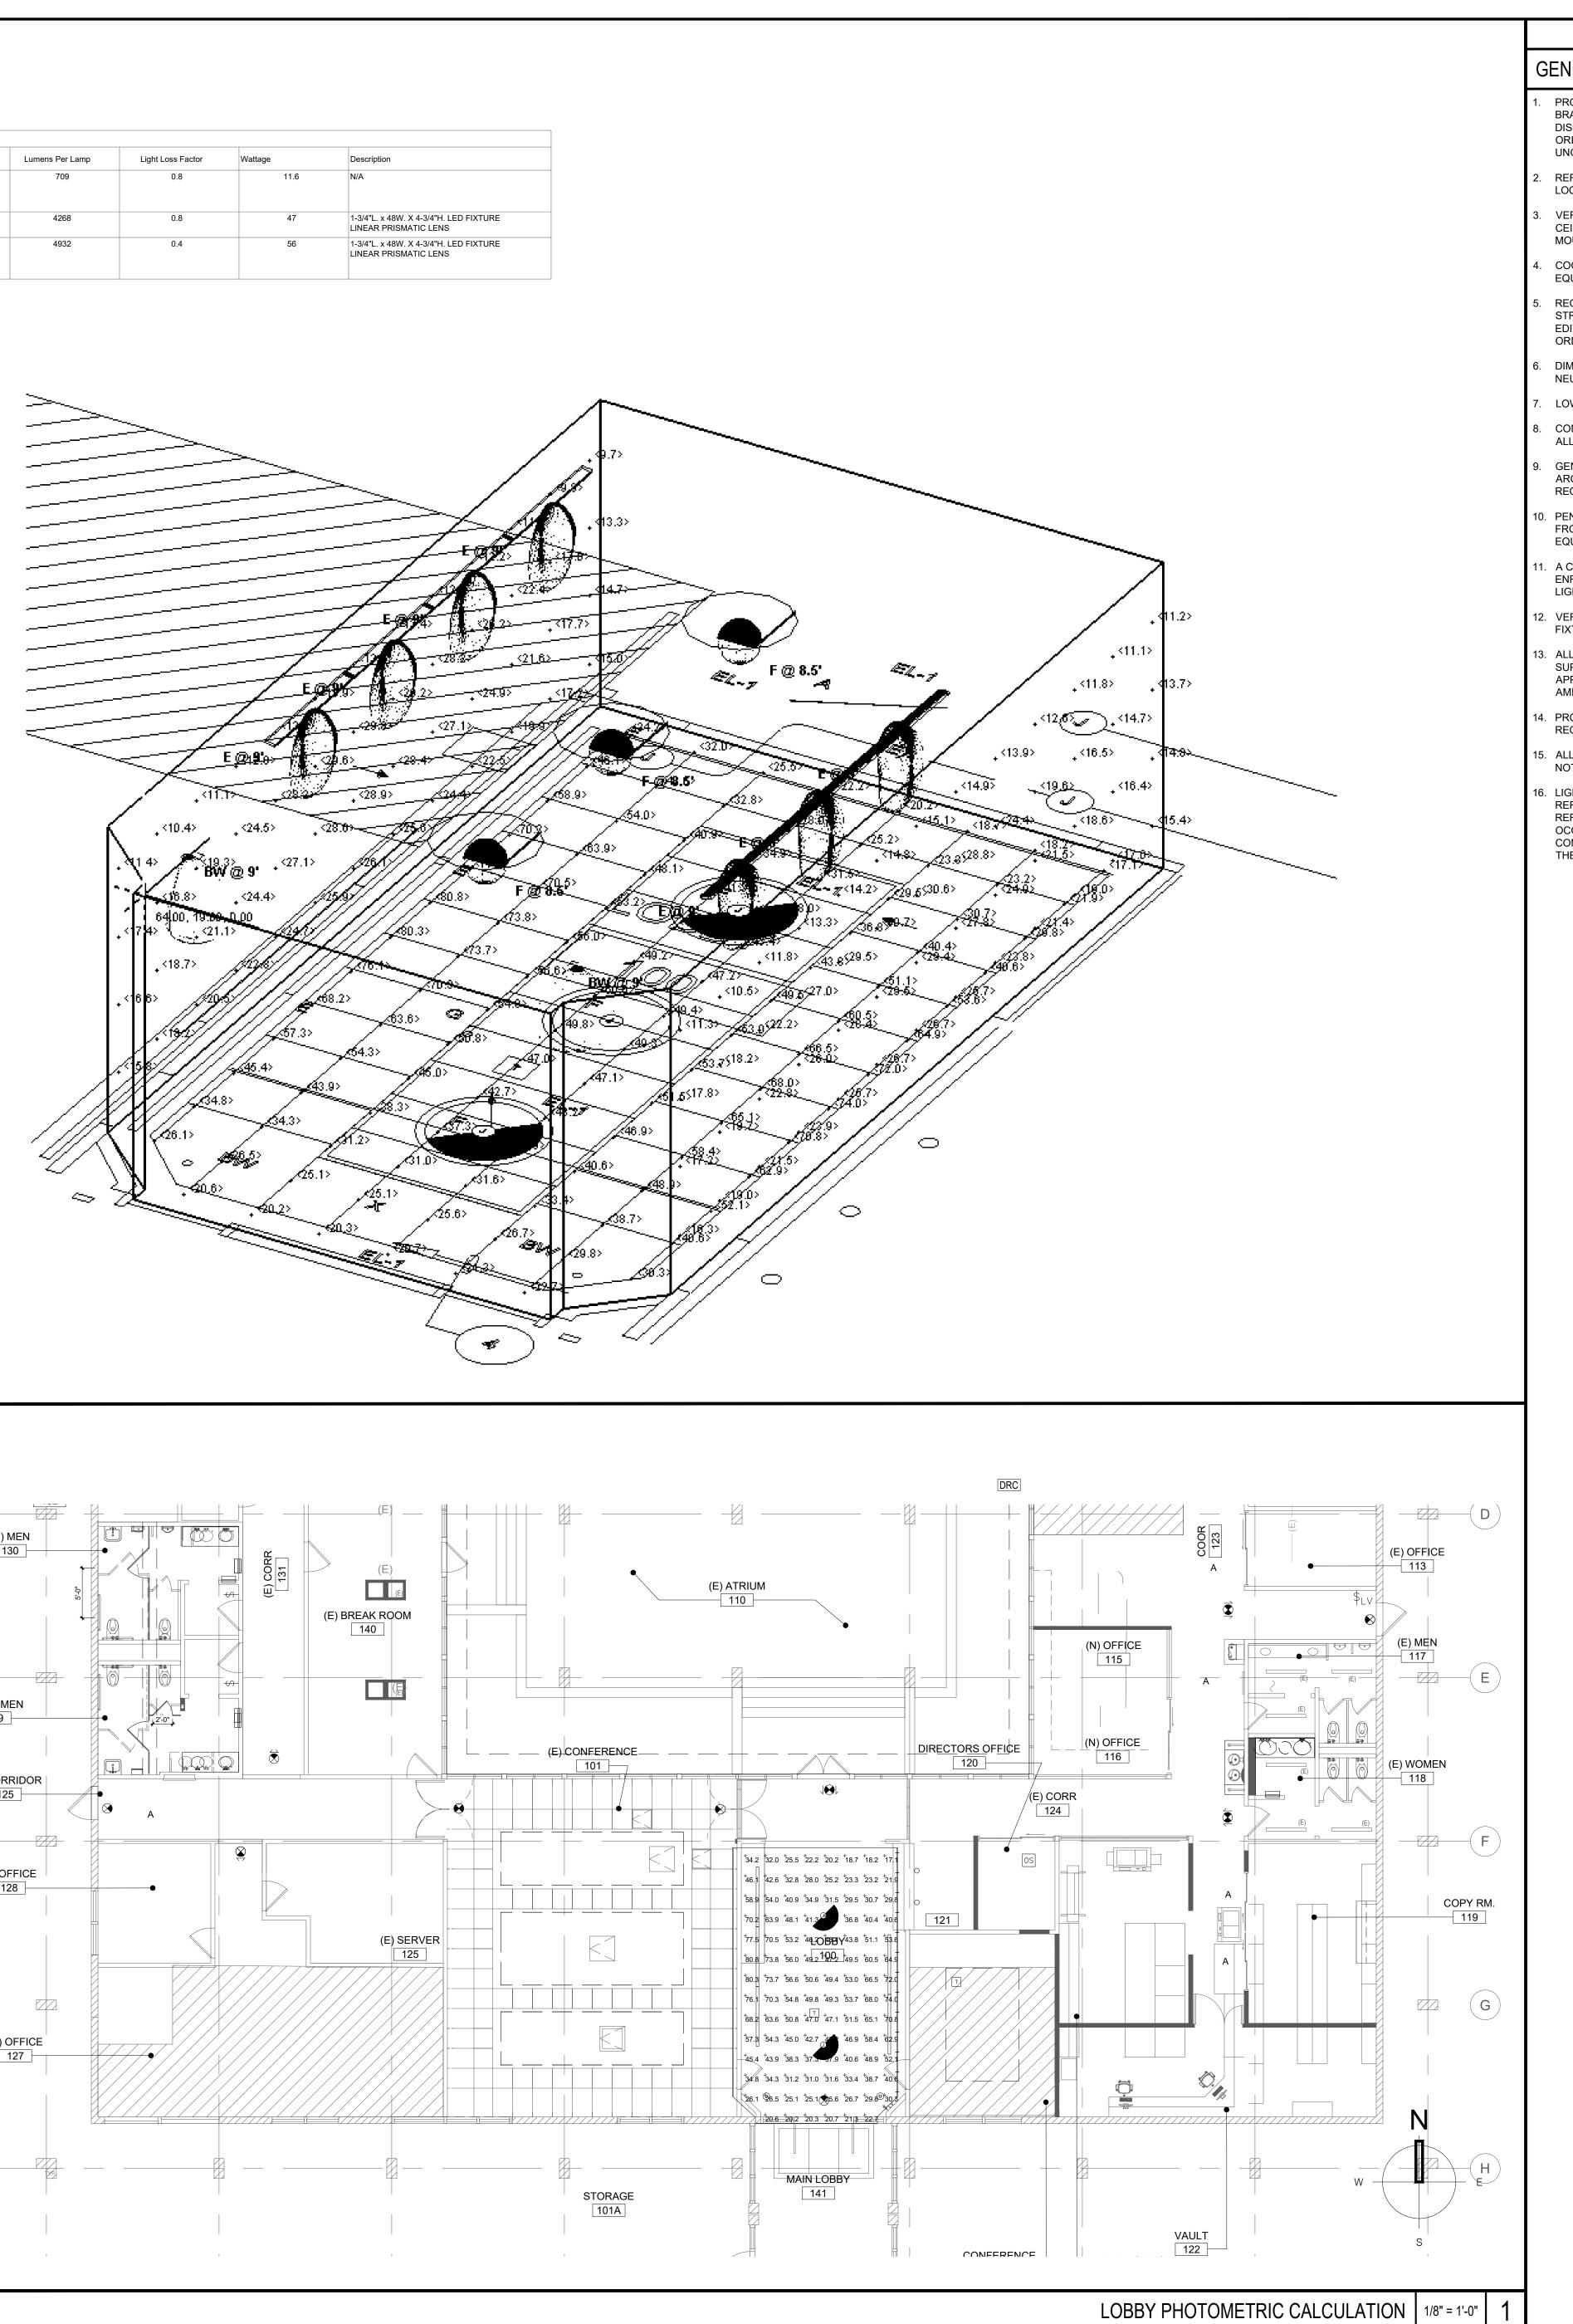

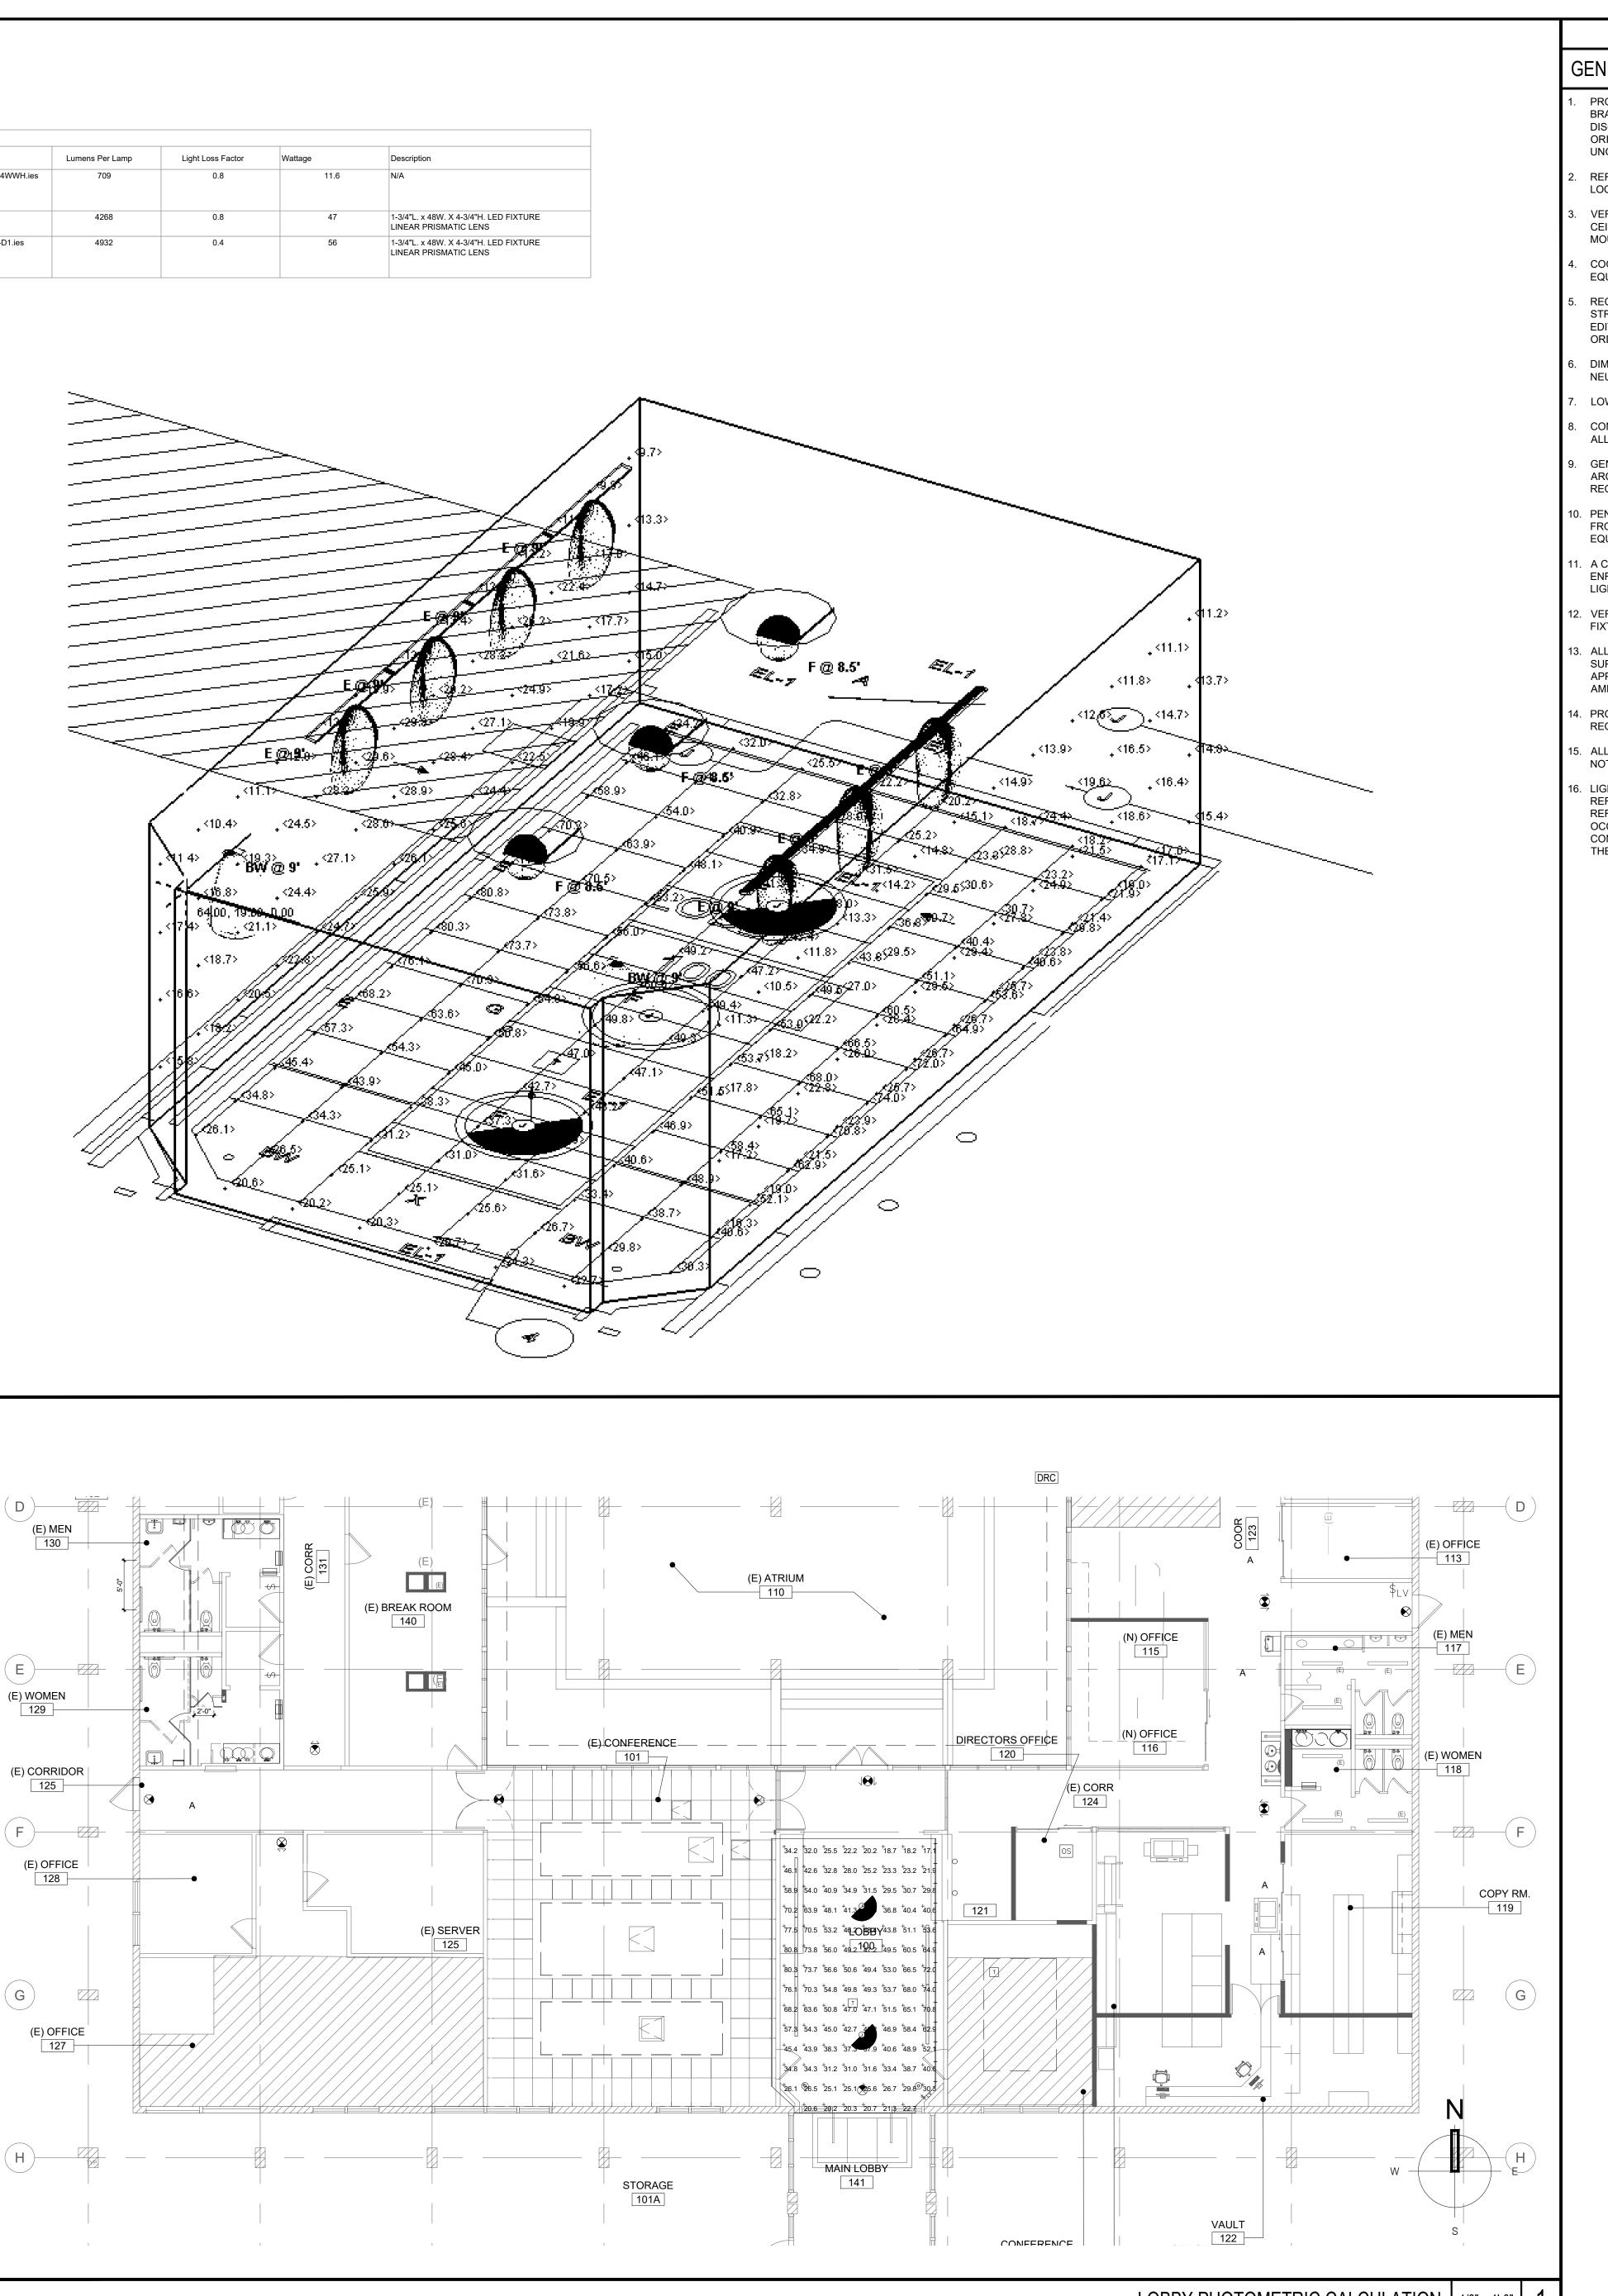

		CLIENT
G	ENERAL NOTES	
1.	PROVIDE A DISCONNECTING MEANS FOR EACH MULTI-WIRE LIGHTING BRANCH CIRCUIT IN ACCORDANCE w/ NEC 410.130(G)(1) THRU (3). DISCONNECTING MEANS SHALL BE LOCATED AT POINT WHERE CIRCUIT ORIGINATES AND SHALL SIMULTANEOUSLY DISCONNECT ALL UNGROUNDED CONDUCTORS.	
2.	REFER TO ARCHITECTURAL REFLECTED CEILING PLAN FOR EXACT LOCATION OF LIGHTING FIXTURES.	
3.	VERIFY EXACT CEILING CONSTRUCTION W/ ARCHITECTURAL REFLECTED CEILING PLAN AND PROVIDE LIGHTING FIXTURES W/ NECESSARY MOUNTING HARDWARE.	
4.	COORDINATE EXACT LIGHTING FIXTURE LOCATIONS W/ MECHANICAL EQUIPMENT AND DUCT WORK PRIOR TO ROUGH-IN.	
5.	RECESSED FIXTURES SHALL BE PROVIDED W/ ALL REQUIRED STRUCTURAL SUPPORTS AS REQUIRED BY CURRENTLY ACCEPTED EDITION OF APPLICABLE NATIONAL, STATE, AND CITY CODES, ORDINANCES, AND AMENDMENTS.	PROJEC
3.	DIMMING BRANCH CIRCUITS SHALL BE PROVIDED W/ A DEDICATED NEUTRAL CONDUCTOR FOR EACH ZONE/CHANNEL.	M
7.	LOW VOLTAGE WIRING NOT RUN IN CONDUIT SHALL BE PLENUM RATED.	
3.	CONTRACTOR TO PROVIDE NECESSARY TRAVELER CONDUCTORS FOR ALL 3 AND 4 WAY SWITCHING APPLICATIONS.	
9.	GENERAL CONTRACTOR SHALL VERIFY CEILING FIRE RATING WITH ARCHITECT, AND BOX OR TENT RECESSED LIGHT FIXTURES, IF REQUIRED, TO MAINTAIN CEILING FIRE RATING.	
10.	PENETRATIONS THROUGH FIRE RATED WALLS SHALL BE PROTECTED FROM THE SPREAD OF FIRE WITH AN APPROVED FIRESTOP SYSTEM EQUAL OR GREATER THAN THE FIRE RATING OF THE WALL.	
11.	A CERTIFICATE OF ACCEPTANCE SHALL BE SUBMITTED TO THE ENFORCEMENT AGENCY UNDER TITLE 24, 130.4(a) OF PART 1 FOR: A. LIGHTING CONTROLS.	
12.	VERIFY EXACT CEILING CONSTRUCTION AT SITE AND PROVIDE LIGHTING FIXTURES W/ ALL NECESSARY MOUNTING HARDWARE.	ENGINE
13.	ALL NEW FIXTURES SHALL BE PROVIDED W/ ALL REQUIRED STRUCTURAL SUPPORTS AS REQUIRED BY CURRENTLY ACCEPTED EDITION OF ALL APPLICABLE NATIONAL, STATE, AND CITY CODES, ORDINANCES, AND AMENDMENTS.	
14.	PROGRAM ALL LIGHTING CONTROLS TO MEET THE LATEST REQUIREMENTS OF THE LIGHTING TITLE 24.	
15.	ALL LIGHTING FIXTURES AND CONTROLS ARE NEW UNLESS OTHERWISE NOTED.	
16.	LIGHT FIXTURES WITH INTERFACE WITH THE MECHANICAL VARIABLE REFRIGERATION SUPPLY AND EXHAUST FANS. CONTRACTOR SHALL REFER AND COORDINATE WITH THE MECHANICAL PLANS FOR LIGHTING OCCUPANCY SENSOR 0-10VDC OUTPUT SIGNAL. ELECTRICAL CONTRACTOR SHALL PROVIDE PLENUM RATED LOW VOLTAGE WIRING TO	
	THE MECHANICAL EQUIPMENT ACCORDINGLY.	STAMP
		STAMP

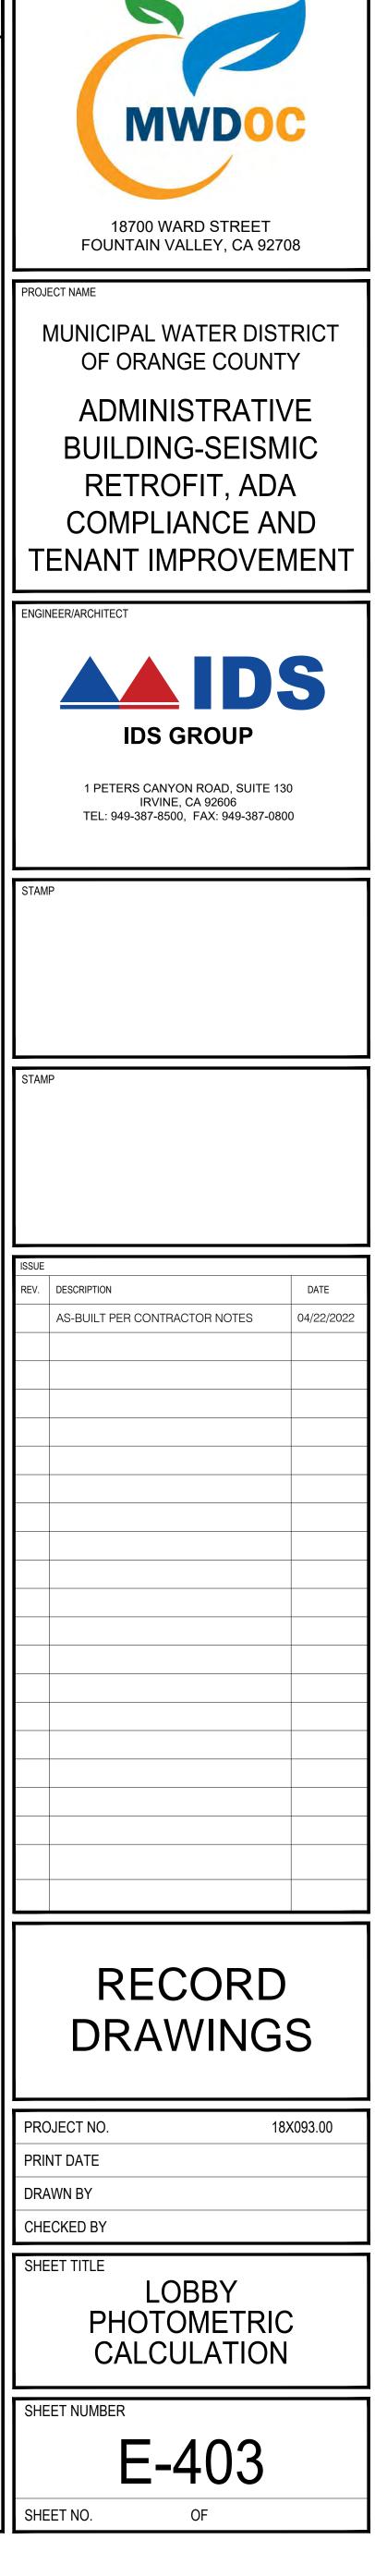

state of california Indoor Lighting										
NRCC-LTI-E (Created 7/18) CERTIFICATE OF COMP							CALIF	ORNIA ENERGY C		DN 2000 RCC-LTI-
))C - Seismic Retrofit				Report Page:					age 3 of
Project Address: 1870	-				Date Prepared					2/2/202
H. INDOOR LIGHTING	G CONTROLS (Not Including PAFs)									
Table Instructions:	, , ,		Building	Level Controls						
	controls for conditioned and uncondition			01		1	02		C	03
	nen an option having a * is selected, th		M	andatory Demand	Response	Sł	nut-off Controls			specto
•	st be completed. The lighting controls			§130.1(e			§130.1(c)		Pass	Fail
NOT COMPLY" if the no	mary Table on the first page will show tes are left blank	DUES		Not Required < 1	-	Who	le Building: EM	CS		
Area Level Controls				nornequireu + 1	0,000 0.		ie sundingi ziri			
04	05	0	6	07	08	09	10	11	1	12
Area Description	Complete Building or Area Category Primary Function Area	Area C	ontrols	Multi-Level Controls	Shut-Off Controls	Primary/Skylit Daylighting	Secondary Daylighting	Interlocked Systems		nspector
	Fillinary Function Alea	8120	<u>).1(a)</u>	§130.1(b)	§130.1(c)	<u>§130.1(d)</u>	§140.6(d)	§140.6(a)1	Pass	Fail
Entry Lobby 100	Lobby, Main Entry	Manual	ON/OFF	Dimmer	Occ Sensor	N/A	N/A			
Conference 101	Convention/Conference/Meeting	Manual	ON/OFF	Bi-level Switch	Occ Sensor	N/A	N/A			
Office 136, 137,110, 111, 127, 128	Office <= 250 sqft	Manual	ON/OFF	Dimmer	Occ Sensor	N/A	N/A			
Corridor 104,123.124,125 and 131	Corridor/Restroom/Support	Manual	ON/OFF	Bi-level Switch	See Bldg Leve	I N/A	N/A			
Open Office Area 115	Office > 250 sqft	Manual	ON/OFF	Dimmer	Occ Sensor	Included	N/A			
Conference 102	Convention/Conference/Meeting	Manual	ON/OFF	Dimmer	Occ Sensor	Included	N/A			
Office 127	Office > 250 sqft	Manual	ON/OFF	Dimmer	Occ Sensor	Included	N/A			
*NOTES: Controls with	a * require a note in the space below e	explaining	g how cor	npliance is achiev	ed.		1	.3		
EX: Conference 1: Prime EXCEPTION 1 to <u>§130.1</u>	ary/Skylight Daylighting: Exempt becau (<u>d)2</u>	ise less th	an 120 w	atts of general lig	hting;	F	lan Sheet Show	ving Daylit Zor	ies:	
I. LIGHTING POWER	ALLOWANCE: COMPLETE BUILDING	G OR AR	EA CATE	GORY METHOD	s			8		2
	plete the table for each area complyin <u>c)</u> or adjustments per <u>§140.6(a)</u> are be		•	ete Building or Are	ea Category Me	thods per <u>§140.6(l</u>	<u>)</u> . Indicate if a	dditional light	ing powe	
Conditioned Spaces										
01	02			03	04	05		06		
Area Descript	on Complete Building or		egory	Allowed Density		llowed Wattage		Allowances /		A
Whole Buildi	Primary Function			(W/ft ²) 0.8	(ft ²) 8,543	(Watts) 6,834.4	Footnotes	PAF	Porta	able Ltg
Table Continued		шg		0.0	0,545	0,054.4				

STATE OF CALIFORNIA Indoor Lighting

IRCC-LTI-E (Cr	eated 7/18)		CALIFORNIA ENERGY COMMI	ISSION 💒
CERTIFICAT	E OF COMP	PLIANCE		NRCC-LT
roject Nan	ne: MWI	D)C - Seismic Retrofit Report Page:		Page 6 o
roject Add	lress: 1870	0 Ward Street Date Prepared:		2/2/20
. DECLAR	RATION OF	REQUIRED CERTIFICATES OF ACCEPTANCE		
able E Ad	ditional Pon	and a the second second second by an added to the first time second second second second second by a second se	rough an Accontance Test Te	chnician
ertification.	n Provider (/	narks. These documents must be provided to the building inspector during construction and must be completed th ATTCP). For more information visit: <u>http://www.energy.ca.gov/title24/attcp/providers.html</u>		
				spector Fail
ertificatior	n Provider (/	ATTCP). For more information visit: <u>http://www.energy.ca.gov/title24/attcp/providers.html</u>	Field In	spector
ertificatior YES	n Provider (/ NO	ATTCP). For more information visit: <u>http://www.energy.ca.gov/title24/attcp/providers.html</u> Form/Title	Field In	spector
ertification YES	n Provider () NO	ATTCP). For more information visit: http://www.energy.ca.gov/title24/attcp/providers.html	Field In	spector

CA Building Energy Efficiency Standards - 2016 Nonresidential Compliance: http://www.energy.ca.gov/title24/2016standards

NRCC-LTI-E (Cr							C/	ALIFORNIA ENERGY C		
	E OF COMPLIANCE ne: MWD)C - Seismic Retrofit				Report Page:					RCC-LTI-E ge 2 of 7
-	ress: 18700 Ward Street				Date Prepared	J:				2/2/2021
	IONAL CONDITIONS									5
	auto-filled with uneditable comme	nts herause of s	elections made o	r data entere	d in tables through	out the form	_		-	
						out the joint.				
NO exceptio	onal conditions apply to this project.									
. ADDITIC	DNAL REMARKS									2
	ncludes remarks made by the permit	applicant to th	e Authority Havir	ng Jurisdiction						
. INDOOF	LIGHTING FIXTURE SCHEDULE									3
able Instru	ictions: Include all permanent desigi	ned lighting and	l all portable ligh	ting in offices.						
01	02		03	04	05	06	07	08	0	9
Name or Item Tag	Complete Luminaire Description	Specialized L Track	uminaire Types Portable	Watts per luminaire ¹	How Wattage is determined	Total number luminaires	Exempt per §140.6(a)3	Design Watts	Field In Pass	spector Fail
A	2'x4' Flat Panel LED			40	Mfr. Spec ¹	95		3,800		
В	4" Downlight LED			12.8	Mfr. Spec ¹	37		473.6		
BW	4" Wall Wash LED			12.8	Mfr. Spec ¹	2	5	25.6		
С	1X4 Linear LED C8			23	Mfr. Spec ¹	5		115		
D2	1X2 Linear Wall Slot LED			18	Mfr. Spec ¹	2		36		
D4	1X4 Linear Wall Slot LED			18	Mfr. Spec ¹	8		144		
E	1X8 Linear LED			39	Mfr. Spec ¹	13		507		
F	3' DIa Pendant LED	E.		56	Mfr. Spec ¹	3	<u>.</u>	168		
G	Cove Light 1.5LF			1.5	Mfr. Spec ¹	218		327		
X	Exit Sign			5	Mfr. Spec ¹	8		40		
					lotal Designed	d Watts CONDIT	IONED SPACES	5,636.2		
NOTES: Au	thority Having Jurisdiction may ask	for Luminaire cu	it sheets to confi	rm wattaae us	sed for compliance	per §130.0(c) N	/attaae used m	ust be the maxin	num rateo	d for the
	not the lamp.			0			J			
TRACK	LIGHTING									2
	Does Not Apply									
A Building E	Energy Efficiency Standards - 2016 Nonr	esidential Compli	ance: http://www.	energy.ca.gov/	title24/2016standard	ls				July 2018
TATE OF CALI	FORNIA									
ndoor L										
	eated 7/18)						C/	ALIFORNIA ENERGY C	COMMISSIO	N N
	E OF COMPLIANCE									RCC-LTI-E

2/2/2021	
2	
n why in chnician	
spector	
Fail	

This Section	Does Not A	Apply						
. DECLAR	ATION OF	REQUIRED CERTIFICATES OF INSTALLATION						
able E. Add	litional Rer	ections have been made based on information provided in previous tables of this document. If any selection needs to be changed, pl marks. These documents must be provided to the building inspector during construction and can be found online at <u>http://</u> 015publications/CEC-400-2015-033/appendices/forms/NRCI	ease explain	why in				
YES	NO	Form/Title						
			Pass	Fail				
۲	0	NRCI-LTI-01-E - Must be submitted for all buildings						
۲	0	NRCI-LTI-02-E - Must be submitted for a lighting control system, or for an Energy Management Control System (EMCS), to be recognized for compliance.						
0	۲	NRCI-LTI-03-E - Must be submitted for a line-voltage track lighting integral current limiter, or for a supplementary overcurrent protection panel used to energize only line-voltage track lighting, to be recognized for compliance.						
0	۲	NRCI-LTI-04-E - Must be submitted for two interlocked systems serving an auditorium, a convention center, a conference room, a multipurpose room, or a theater to be recognized for compliance.						
0	۲	NRCI-LTI-05-E - Must be submitted for a Power Adjustment Factor (PAF) to be recognized for compliance.						
0	۲	NRCI-LTI-06-E - Must be submitted for additional wattage installed in a video conferencing studio to be recognized for compliance.						

CA Building Energy Efficiency Standards - 2016 Nonresidential Compliance: http://www.energy.ca.gov/title24/2016standards

July 2018

City/State/Zip:

Irvine, CA 92606


CA Building Energy Efficiency Standards - 2016 Nonresidential Compliance: http://www.energy.ca.gov/title24/2016standards

Phone:

(949) 387-8500


STATE OF CALIFORNIA													
Indoor Light NRCC-LTI-E (Created 7 CERTIFICATE OF C	ing 7/18)										CALIFORNIA EN	ERGY COMM	
This document is	<i>used to demo</i> MWD)C - Seis	mic Retrofit	ance with requirements i	n <u>§110.</u>	<u>9, §130.0, §1</u>	<u>30.1</u> , <u>§</u>	140.6, and Report Pa Date Prej	age:	indoor lig	ihting s	scopes using the	e prescript	
A. GENERAL INF			Fountain Va	lley		04 To	tal Conditi	ioned Floor Area	a (ft ²)		8,	543	2
		Project (select	6 all that apply):			06 # c	of Stories (ditioned Floor A Habitable Above	e Grade)			0 1	
✓ Office✓ Parking Ga	irage	Retail High-Rise		ehouse catable			otel/Mote ther (write		chool		Supp	ort Areas	
	s: Include any l		ns that are within the sco										
<u>§140.6</u> or <u>§141.0</u> calculation metho	od, please ope		NG: Changing the Calcula or use "Save As".	tion Me			ned Space		data prev	viously	Unconditioned		nge the
My		01 ts of (check all	that apply):		02 Calculation			03 Area (ft ²)		Calcula	04 Ition Method		05 Area (ft ²)
New Lighting	g System												
✓ Altered Light	ting System	Entire L	uminaire Alteration		Complete I		-	8,543		Compl	lete Building		0
C. COMPLIANCE	E RESULTS		Total Area of Work (ft ²)			8,	543				0		2
Table Instructions		Allowed Light	s "DOES NOT COMPLY" o ing Power per §140.6(b))	xceptio	Actua	al Lighting Powe	er per §14	+	(Watts)	Complia	ance Results
conditioned and unconditioned	01 Complete	02 Area	03 04 Area Category Tailore		05		06 Total	07 Adjust			09	-	10
spaces must not be combined for compliance per	Building §140.6(c)1	Category §140.6(c)2	Footnotes §140.6(c) §140.6(c)2G (+)		Total Allowed (Watts)	2	Designed (Watts)	Portable Lighting §140.6(a)	PAF Cont Credits §140.6(a	s =	Total Actual (Watts) *Includes		ust be≥09 <u>140.6</u>
<u>§140.6(b)1</u> .	(See Table I)	(See Table I)	(+) (See Table K) (See Table	e L)			ee Table F	(-)) (See Table J)	(-) (See Table	e R)	Adjustments		MOLIEC
Conditioned: Unconditioned:	6,834.4			=	6,834.4	≥ ≥	5,636.2	ance (See Table	H for Det	= = (2lic	5,636.2	MPLIES	MPLIES
				Ra			-	ance (See Table		-		Applicable	9
CA Building Energy	Efficiency Stand	dards - 2016 Nor	nresidential Compliance: htt	p://www	w.energy.ca.go	ov/title2	24/2016sta	ndards					July 2018
STATE OF CALIFORNIA													
NRCC-LTI-E (Created 7 CERTIFICATE OF C	7/18) COMPLIANCE										CALIFORNIA EN	ERGY COMM	NRCC-LTI-E
Project Name: Project Address:	MWD)C - Seis 18700 Ward S						Report Pa Date Pre						Page 4 of 7 2/2/2021
	91 scription	Comp	02 lete Building or Area Cate	egory	03 Allowed D	Density	04 Area	05 Allowed W	'attage	Add	00 itional Allowan		stments
	scription		Primary Function Area		(W/ft	t ²) TOTAL	(ft ²) : 8,54 3	1		Footno	otes PA See Tables J, k		Portable Ltg tail
		RTABLE LIGH	ITING IN OFFICES										2
This Section Does		LLOWANCE:	AREA CATEGORY METI	HOD FO	DOTNOTES								2
This Section Does	,												
L. TAILORED MI This Section Does		RAL LIGHTIN	IG POWER ALLOWANC	E									2
M. ADDITIONAL		LLOWANCE:	TAILORED SPECIAL FU	NCTIO	N AREAS								2
N. ADDITIONAL This Section Does		LLOWANCE:	TAILORED WALL DISPL	AY									?
O. ADDITIONAL This Section Does	and the second	LLOWANCE:	TAILORED FLOOR AND	TASK	LIGHTING								?
	LIGHTING A	LLOWANCE:	TAILORED ORNAMENT	AL/SP	ECIAL EFFEC	CTS							?
Q. ADDITIONAL	LIGHTING A	LLOWANCE:	TAILORED VERY VALU	ABLE N	IERCHAND	ISE							?
This Section Does		GHTING CON	TROL CREDIT (PAF)										2
This Section Does													
CA Building Energy	Efficiency Stand	dards - 2016 Nor	nresidential Compliance: htt	p://www	w.energy.ca.go	ov/title2	24/2016sta	ndards					July 2018
STATE OF CALIFORNIA													
Indoor Light NRCC-LTI-E (Created 7 CERTIFICATE OF C	//18)										CALIFORNIA EN	ERGY COMM	
	MWD)C - Seis						Report Pa Date Pre	-					Page 7 of 7 2/2/2021
		'S DECLARAT	TION STATEMENT					uther Circuit		~//n	, , ,		?
Documentation A Company:	Author Name:		Bob.Kramer IDS					uthor Signature 02/02/2021	:	UK			
Address: City/State/Zip:			s Canyon Road vine, CA 92606			EA/ HE	RS Certific	cation Identifica		plicable 9) 387-	-		
-	wing under pe	enalty of perju	ry, under the laws of the			:							
	nder Division	3 of the Busin	nte of Compliance is true ess and Professions Code			bility f	or the bui	lding design or s	system de	sign id	entified on this	Certifica	te of
3. The energy fea Certificate of 0	atures and per Compliance co	rformance spe onform to the	cifications, materials, co requirements of Title 24,	Part 1	and Part 6 o	f the C	alifornia C	Code of Regulati	ons.	-	_		
compliance do	ocuments, wo	rksheets, calcu	sign features identified o Ilations, plans and specif 7 of this Certificate of Col	ication	s submitted	to the	enforcem	ent agency for a	approval v	vith th	is building perr	nit applica	ation.
documentatio	n the builder		e building owner at occu						e of Comp	liance	is required to b	e include	d with the
Responsible Desig Company :	gner Name:	IDS Electri	Robin O'Neil ical Engineers, Inc.					mer Signature: /02/2021	K	P			
Address:		1 Peters Cany	on Road, Suite 130		L	icense:	-			E1855	57		

July 2018

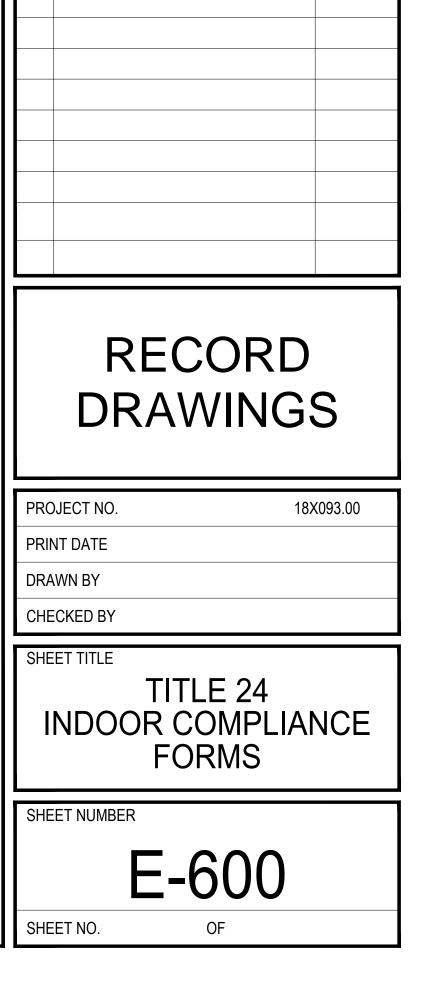

DATE DESCRIPTION AS-BUILT PER CONTRACTOR NOTES 04/22/2022

ENGINEER/ARCHITECT

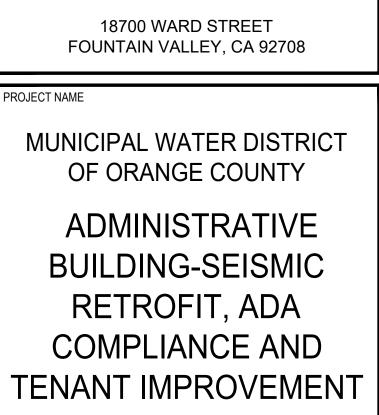

IDS GROUP

1 PETERS CANYON ROAD, SUITE 130 IRVINE, CA 92606 TEL: 949-387-8500, FAX: 949-387-0800

MWDOC

GENERAL NOTES									PLUMBING LEGEND		PLUMBING SHEET INDEX		
LOCATIONS, ELEVATIONS AND CHARACTERISTICS OF ALL UTILITIES AND PIPING, WI	ISTING PIPING DAMAGED DURING CONSTRUCTION SHALL BE RE TH MATERIALS TO MATCH EXISTING BY THE CONTRACTOR.	PAIRED	ABBREV		DESCRIPTIC				SYMBOL	DESCRIPTION	SHEET NUMBER	SHEET TITLE	
	ISTING PIPING, FIXTURES AND EQUIPMENT THAT IS REMOVED S SPOSED OF AS DIRECTED BY THE OWNER'S REPRESENTATIVE.	HALL BE							=	WASTE PIPING (BELOW)	1 P-001 2 P-401	PLUMBING GENERAL NOTES PLUMBING ENLARGED PLAN	
SEE ARCHITECTURAL DRAWINGS FOR HANDICAP FIXTURE LOCATIONS AND MOUNTING 19. PIF HEIGHTS. INSULATE ALL EXPOSED WATER AND DRAIN PIPING BELOW LAVATORIES SY	PING THROUGH FIRE RATED WALLS SHALL BE PER U.L. FIRE RES STEM NO. WL1001. SEE ARCHITECTURAL PLANS FOR ALL LOCA		ABV AFF		ABOVE ABOVE FINISH	IED FLOOR				WASTE PIPING (ABOVE)			
AND SINKS WITH TRUEBRO NO. 103 E-Z INSULATION KIT AND OFFSET P-TRAP TO WALL. ALL WATER CLOSET FLUSHING LEVERS SHALL BE TO THE WIDE SIDE OF THE STALL	CHORAGE DETAILS FOR EQUIPMENT WHICH ARE NOT APPROVE VIEW ARE SUBJECT TO APPROVAL OF THE STRUCTURAL ENGIN	EER OF RECORD	AVG BEL		AVERAGE BELOW					VENT PIPING			
TRAPS FOR ALL SINKS SHALL TRAP STRAIGHT BACK TO WALL WITH ALL REQUIRED	D STRUCTURAL ENGINEER PRIOR TO INSTALLATION AND INSPE OJECT INSPECTOR. T WATER PIPING SHALL BE INSULATED IN ACCORDANCE WITH		BLDG CD		BUILDING CONDENSATE	DRAIN				COLD WATER PIPING			
PLUMBING WORK SHALL BE INSTALLED SO AS TO AVOID INTERFERENCE	CTION 123, TABLE 1-G OF THE TITLE 24 REGULATIONS.		CLG CFH		CEILING CUBIC FEET P	ER HOUR							
THE CONTRACTOR SHALL COORDINATE THE LOCATION OF ALL CEILING ACCESS BU PANELS WITH THE ARCHITECTURAL REFLECTED CEILING PLAN AND THE ELECTR. CO	T NECESSARY FOR THE COMPLETE CODE APPROVED INSTALLA MPLETE OPERATION OF THE SYSTEM/INSTALLATION SHALL BE QUIRED AT NO ADDED COST TO THE OWNER.	TION OR FOR	CW DN		COLD WATER DOWN					HOT WATER PIPING			
	E SIZES SHALL BE THE SAME AS THE UPSTREAM PIPE SIZES LESS OTHERWISE INDICATED ON PLAN.		DWG FA		DRAWING FROM ABOVE					HOT WATER PIPING RETURN	CALIFORNIA GRI	EEN CODE NOTES	
AND THE ARCHITECT PRIOR TO ANY INSTALLATION. 26. UN VALVES LINIONS ETC. TO BE SAME SIZE AS PIPE LINI ESS OTHERWISE AS	LESS SPECIFIED ON STRUCTURAL DRAWINGS, ANY ALTERATION TRUCTURAL ELEMENTS BY CUTTING, DRILLING, BORING, BRAC	NG, WELDING ETC.	FB FLR		FROM BELOW FLOOR				()	RISER			
INDICATED ON DRAWINGS. WORK AND MATERIAL SHALL BE PERFORMED AND INSTALLED IN COMPLIANCE	ALL HAVE WRITTEN APPROVAL STRUCTURAL ENGINEER OR REGIOR START WORK. EANOUTS SHALL BE INSTALLED AS PER SECTION 707.0 AND 719.		FT		FEET GALLONS PER	R MINUTE			O	ELBOW UP	OF CALIFORNIA GREEN		
AUTHORITY. NOTHING IN THESE DRAWINGS IS TO BE CONSTRUED TO PERMIT WORK	JMBING CODE. CH PLUMBING VENT SHALL TERMINATE NOT LESS THAN TEN FE		HW		HOT WATER HOT WATER F	RETURN			C	ELBOW DOWN	· WATER REDUCTIONSERV	VING PLUMBING FIXTURES AND FITTINGS 5.303.3	
BEFORE FABRICATION OR INSTALLATION THIS CONTRACTOR SHALL VERIFY EXACT LOCATIONS OF ALL EQUIPMENT PROVIDED UNDER ANOTHER SECTION OF 29.	REE FEET ABOVE ANY WINDOW, DOOR, OPENING, AIR INTAKE, C TER CLOSET BOWLS FOR PUBLIC USE SHALL BE OF THE ELONG		I.E.		INVERT ELEVA	ATION				TEE PIPING DOWN	· WATER CLOSETS		
31. PO	OVIDE TRAP PRIMERS AT FLOOR DRAINS AND SINKS TO MAINTA TABLE WATER SYSTEMS ON THIS PROJECT SHALL BE DISINFEC	TED PRIOR TO USE	LBS		POUNDS QUANTITY				2	BREAKLINE	· URINALS 5.303.3.2		
INDICATED. 32. PLU	CORDING TO THE METHOD SET IN SECTION 609.9 OF THE PLUM JMBING DRAWINGS ARE DIAGRAMMATIC. THE LOCATION AND EI ING IS APPROXIMATE AND SHALL BE VERIFIED AND COORDINAT	EVATION OF ALL PLUMBING	SD/RD		STORM DRAIN				φ	BALL VALVE	WASTEWATER REDUCTION 5.303.4 STANDARDS FOR PLUMBING FIXTURES AND FITTINGS 5.303.6		
EQUIPMENT SHOWN IN WALLS OR ABOVE NON-ACCESSIBLE CEILINGSSTRSHALL BE INSTALLED BEHIND AN ACCESS PANEL.33. CO	RUCTURAL CONDITIONS, AND BUILDING CONSTRUCTION PRIOR NTRACTOR SHALL PROVIDE A COMPLETE SET OF AS BUILT DRA			OVERFLOW D SHUT-OFF VA	RAIN				PRESSURE REDUCING VALVE	. CPC CHAPTER 14			
AREAS DAMAGED BY HIS OPERATIONS.	NER AT END OF PROJECT COMPLETION.	ENT OF BUILING PERMITS.	SOV SQFT		SQUARE FEET	Г			74	PRESSURE RELIEF VALVE	APPLICABLE CO	DES	
	ON COMPLETIONS OF CONSTRUCTION WORK THIS CONTRACTO AWING INDICATING ACTUAL INSTALLATION WORK PLUMBING WO		SS TEMP		TEMPERATUR					UNION	2016 CALIFORNIA BI		
			TYP WV		TYPICAL WASTE/VENT						 2016 CALIFORNIA EI 2016 CALIFORNIA FI 2016 CALIFORNIA EI 2016 CALIFORNIA EI 	IRE CODE INERGY CODE (TITLE 24)	
N CHECK NOTES		D LOW RATES	- ^w		WASTE					CLEAN OUT		LUMBING CODE WITH ALL APPLICABLE AMENDMENTS GREEN CODE WITH ALL APPLICABLE AMENDMENTS GREEN BUILDING CODE	
APPLIANCE AND PLUMBING VENTS AND THE DISCHARGE OUTLET OF EXHAUST FANS SHALL BE AT LEAST TEN (10) FEET IN A HORIZONTAL DIRECTION, OR THREE (3) FEET ABOVE THE OUTSIDE-AIR INTAKES FOR THE HVAC UNITS.	FIXTORE F	MAXIMUM FLOW RATE	1						— —	FLOOR CLEAN OUT			
CLEANOUTS FOR HORIZONTAL BUILDING STORM DRAINS SHALL COMPLY WITH THE REQUIREMENTS OF SECTION 719 OF THE CALIFORNIA PLUMBING CODE	SHOWERHEADS (LOW FLOW)	2 GPM @ 60 PSI 0.4 GPM @ 60 PSI	-						VALVE_NO	CIRCUIT SOLVER		G STANDARD NOTES	
EACH VENT SHALL RISE VERTICALLY TO A POINT OF NOT LESS THAN SIX (6) INCHES IN HEIGHT ABOVE THE FLOOD LEVEL RIM OF THE FIXTURE BEFORE BEING CONNECTED TO ANY OTHER VENT.	KITCHEN FAUCETS	1.8 GPM @ 60 PSI	1							DETAIL CALL OUT	1. MINIMUM OF 50% O	F NON HAZARDOUS CONSTRUCTION WASTE TO BE RECYCLE. CGC 5.713.8.1.	
PLUMBING FIXTURES, EQUIPMENT AND COMPONENT SHALL BE APPROVED AND COMPLY WITH AB1953.	WASH FOUNTAINS METERING FAUCETS	1.8 [RIM SPACE (IN.) / 20 GPM @ 60 PSI] 0.2 GALLONS / CYCLE			RE AND F		IT SCHFI	DULE			2. TESTING AND ADJU 5.713.10.4.2.	MAINTENANCE SCHEDULE (O&M) AS LISTED IN CGC SECTION 5.713.10.4.5 SHALL	
THE INSTALLATION OF ABS/PVC SHALL COMPLY WITH THE 2016 C.P.C. 604.1.1.	METERING FAUCETS FOR WASH FOUNTAINS	0.20 [RIM SPACE (IN.) / 20 GPM @ 60 PSI]									BE DELIVERED TO T 4. DURING CONSTRUC	THE BUILDING OWNER OR REPRESENTATIVE AND THE FACILITIES OPERATOR. CTION, ENDS OF DUCT OPENING ARE TO BE SEALED, AND MECHANICAL 3E COVERED. CGC 5.714.4.3.	
E MATERIAL SCHEDULE	GRAVITY TANK TYPE WATER CLOSETS	1.28 GALLONS / FLUSH 1 1.28 GALLONS / FLUSH 1	ITEM	FIXTURE	OIL/ ASTE ENT	40T ATER	OLD ATER		DESCRIPTION		5. VOC'S MUST COMP 5.504.4.1, 5.504.4.2,	5-504.4.3 AND 5-504.4.5 FOR: ADHESIVES, SEALANTS, PAINTS, AND COATINGS, POSITION WOOD PRODUCTS. CGC 5.714.4.4.	
RVICE LOCATION MATERIAL	FLUSHOMETER VALVE WATER CLOSETS	1.28 GALLONS / FLUSH (1)			> >	<u> </u>	0 §					-USITION WOOD PRODUCTS. CGC 5.7 14.4.4 .	
COLD WATER - PIPING SHALL BE TYPE 'L' COPPER ASTM B88 WITH WROUGHT COPPER SWEAT FITTINGS ANSI B16.22.DOMESTIC WATER.	ELECTROMECHANICAL HYDRAULIC WATER CLOSETS	1.28 GALLONS / FLUSH 1 0.5 GALLONS / FLUSH	<u>WC-1 (E)</u>	(E)WATER CLOSET	4" 2'	·	1" -		BISH EXISTING FIXTURE, FLUSH VALVE AND NG ORDER.	TOILET SEAT AND LEAVE IN OPTIMUM			
ATER - PIPING SHALL BE TYPE 'L' COPPER ASTM B88 WITH WROUGHT COPPER SWEAT HOT WATER FITTINGS ANSI B16.22.DOMESTIC WATER.	(1) INCLUDES SINGLE AND DUAL FLUSH WATER CLOSETS	S WITH AN EFFECTIVE FLUSH OF 1.28 GALLONS OR LESS: ME SHALL NOT EXCEED 1.28 GALLONS (4.8 LITERS). THE	<u>WC-2(E)</u>	(E)WATER CLOSET	4" 2'	·	1" -		BISH EXISTING FIXTURE, FLUSH VALVE AND	TOILET SEAT AND LEAVE IN OPTIMUM	ADA REQUIREM	ENTS	
- PROVIDE INSULATION FOR ALL HOT WATER PIPES. NO HUB CAST IRON PIPE AND FITTINGS, ASPHALTUM COATED, ASTM A-888 OR	EFFECTIVE FLUSH VOLUME IS THE AVERAGE FLUSH V 112.19.233.2.	/OLUME WHEN TESTED IN ACCORDANCE WITH ASME A		(ADA)				AMERIC	AN STANDARD NO. 6590.001, VITREOUS CH	INA WALL HUNG URINAL, COMPLETE WITH	1. WATER CLOSETS:	OF ACCESSIBLE WATER CLOSETS SHALL BE A MINIMUM OF 17"	
ABOVE FLOOR ITARY ABOVE FLOOR ASTM A-74 WITH HUSKY SD-4000 OR MISSION HEAVY DUTY STAINLESS STEEL FOUR-BAND COUPLINGS. ABS OR PVC SCH. 80 (CITY AND OWNER APPROVAL REQUIRED)	EFFECTIVE FLUSH VOLUME IS DEFINED AS THE COMP FLUSHES AND ONE FULL FLUSH. FLUSH VOLUMES WI		<u>U-1</u>	URINAL 0.125 GPF	2" 1 1/	/2"	3/4" -		"ROYAL" NO. 186-0.125 SFSM, ONE PIECE W CT TO EXISTING UTILITIES.	ALL HANGER BRACKET WITH ANCHORS.	(431.8 mm) At TOILET SEAT	ND A MAXIMUM OF 19" (482.6 mm) MEASURED TO THE TOP OF ſ. FLUSH CONTROLS SHALL BE OPERABLE, BE AN OSCILLATING	
TE AND PIPING NO HUB CÁST IRON PIPE AND FITTINGS, ASPHALTUM COATED, ASTM A-888 OR ASTM A-74 WITH HUSKY SD-4000 OR MISSION HEAVY DUTY STAINLESS STEEL	ASME A 112.19.14.		<u>U-2</u>	URINAL (ADA) 0.125 GPF	2" 1 1/	2"	3/4" -		S UR-1 EXCEPT MOUNTED AT ACCESSIBLE DUNTING HEIGHT AND EXACT FIXTURE LOC		REMOTE LOV LOCATED SO	TH A MAXIMUM OPERATING FORCE OF 3 LBS. (.67 N) OR BY A W VOLTAGE BUTTON. THE HANDLE OF THE BUTTON SHALL BE IT IS OPERABLE WITHOUT REQUIRING EXCESSIVE BODY	
BELOW GRADE FOUR-BAND COUPLINGS. ALTERNATE BELOW GRADE : ABS OR PVC SCH. 80 (CITY AND OWNER APPROVAL REQUIRED)	NO LEAD REQUIREMENT							AMERICAN STANDARD NO. 0495.221 "OVALYN", UNDERCOUNTER MOUNTED SINK. COMPLETE WITH BRADLEY POINT OF USE MIXING VALVE MODEL S59-4000. MOEN "TOUCH FREE"		2. LAVATORIES:	(LOCATE ON WIDE SIDE OF WATER CLOSET).		
	ALL MATERIALS, DEVICES, ETCINSTALLED IN THE DOMESTIC HOT AND COLD WATER SYSTEMS SHALL COMPLY WITH CALIFORNIA HEALTH AN SAFETY CODE SECTION 116875- AB1953 SCOPE OF WORK REMOVAL OF EXISTING PLUMBING FIXTURES AND MAKE TOILET ROOM COMPLIANT. REMOVAL OF EXISTING ELECTRICAL WATER COOLER AND INSTALL NEW ADA COMPLIANT WATER COOLER.			LAVATORY	2" 1 1/	2" 1/2"	1/2"	OPERAT		WITH GRID DRAIN, BRASS CRAFT FLEXIBLE	A. LAVATORIES SHALL BE MOUNTED WITH A CLEARANCE OF AT LEAST 29" (736.6 mm) FROM THE FLOOR TO THE BOTTOM OF THE APRON WITH KNEE		
				<u>L-2</u> LAVATORY (ADA) 2" 1 1/2" 1/2" 1/2"			1/2"		S L-1 EXCEPT FOR HANDICAP ACCESS (SE ATED ACCESSIBLE FIXTURE).	E ARCHITECTURAL PLANS FOR	CLEARANCE UNDER THE FRONT LIP EXTENDING A MINIMUM OF 30" (762 mm) IN WIDTH WITH 8" (203.2 mm) MINIMUM OF DEPTH AT THE TOP. TOE CLEARANCE SHALL BE THE SAME WIDTH AND SHALL BE A MINIMUM OF 9"		
				LAVATORY	2" 1 1/	/2" 1/2"	4 /01		AMERICAN STANDARD "LUCERNE" LAVATORY MODEL 0355.012 WITH MOEN "TOUCH FREE" OPERATION ELECTRONIC FAUCET MODEL NO. 8559 WITH GRID DRAIN, BRASS CRAFT		(228.6 mm) HIGH FROM THE FLOOR AND A MINIMUM OF 17" (431.8 mm) DEEP FROM THE FRONT OF THE LAVATORY.	RONT OF THE LAVATORY.	
				(ADA)	2 11/	2 1/2	1/2"		E SUPPLIES, 1/4 TURN STOP. L.A. PATTEN Y POINT OF USE MIXING VALVE MODEL S5			AND DRAIN PIPES UNDER LAVATORIES SHALL BE INSULATED OR COVERED. THERE SHALL BE NO SHARP OR ABRASIVE SURFACES ATORIES.	
				ELECTRIC WATER COOLER	2" 1 1/	2"	1/2" -	- FREE, W	EZH2O MODEL NO. LZWS-LRPBM28K. WALL VASTE STRAINER, BOTTOM PLATE, AND BO		C. FAUCET CONTROLS AND OPERATING MECHANISMS SHALL BE OPERABLE WITH ONE HAND AND SHALL NOT REQUIRE TIGHT GRASPING, PINCHING OR		
				HOSE BIBB			REFRIGERATOR. 3/4" ACORN MODEL 8121 WITH INTEGRAL VACUUM BREAKER			AKER	SHALL BE NO	F THE WRIST. THE FORCE REQUIRED TO ACTIVATE CONTROLS O GREATER THAN 5 LBS. (22.2 N). LEVER-OPERATED PUSH TYPE RONICALLY CONTROLLED MECHANISMS ARE EXAMPLES OF	
							- JR SMITI	TH SERIES 5000, SIZE AND INSTALL PER PD	REQUIREMENTS	ACCEPTABLE DESIGNS. SELF-CLOSING VALVES ARE ALLOWED IF THE FAUCET REMAINS OPEN FOR AT LEAST 10 SECONDS.			
				ARRESTER									
									(

FLOOR PLAN NTS

